ST. JOSEPH'S (NEW) CEMETERY

HAMILTON CO. CINCINNATI

OFFICIAL PROJECT NOS 465-42-3-467 AND 665-42-3-232

LEGEND

(1) REVOLUTIONARY WAR
(10) WAR OF 1812
(16) WAR WITH MEXICO
(19) CIVIL WAR
(25) SPANISH - AM. WAR
(31) WORLD WAR
(32) NATIONAL GUARDS
(33) REGULAR SERVICE

HISTORY

CEMETERY ESTABLISHED NOVEMBER 22 1853 BY THE CATHOLIC ARCHBISHOP OF CINCINNATI JOHN B. PURCELL

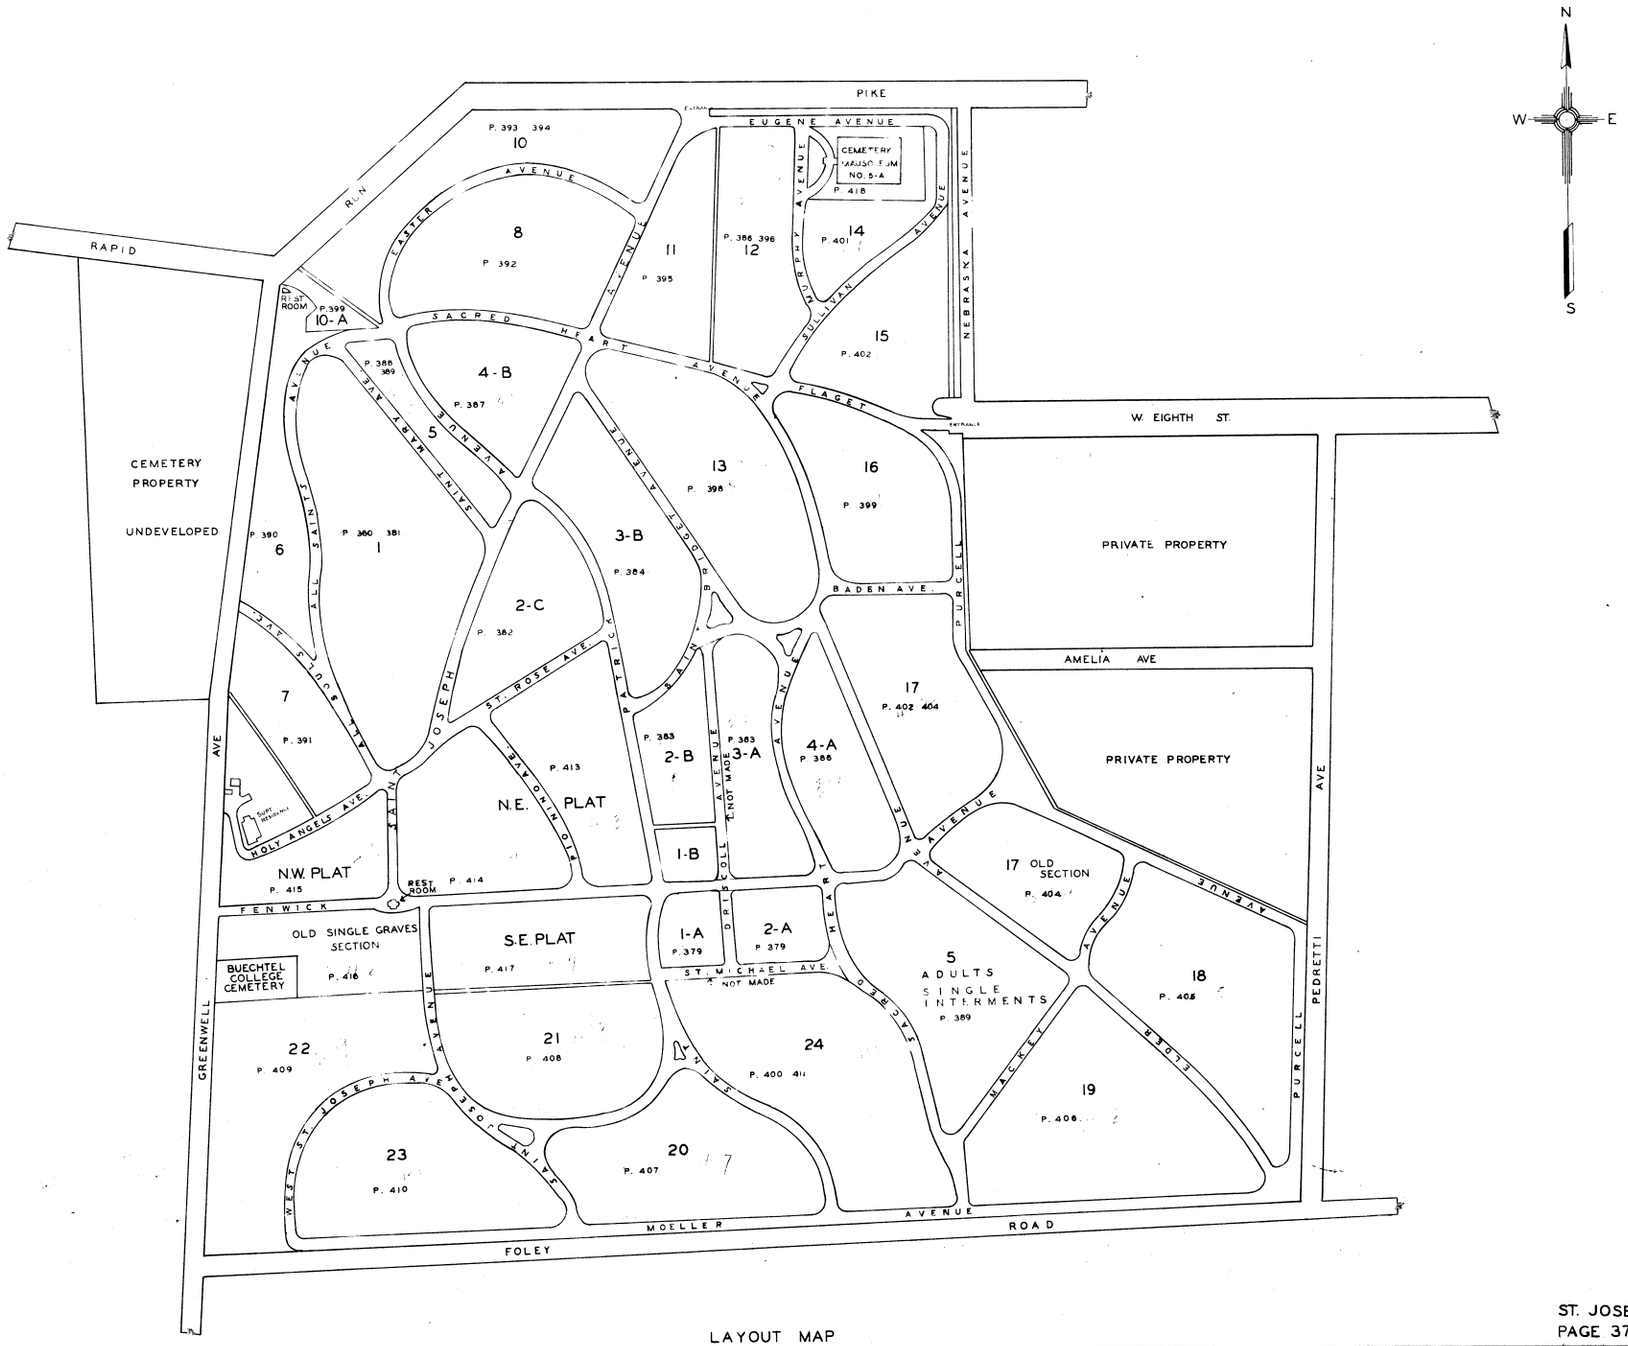

LAYOUT MAP

ST. JOSEPH NEW CEM.
PAGE 377

BURIALS (VETERANS) IN ST. JOSEPH NEW CEMETERY

VERIFIED BY ROSTERS OR HISTORIES

LOCATION UNKNOWN

WAR	NAME
19	BLACKWELL JAS.
31	BOUGHEN DAN'L.
19	CORTE JNO.
19	DAVIS JNO.
25	FAY EDW. A
31	FLANAGAN ROB'T. A.

WAR	NAME
19	GLEASON JNO.
31	GRIMES WM T.
19	GOSS JOS
33	HIGGINS HARRY
19	KEAN JNO.
19	KILLOUGHBY WM.
33	KOVACS FRANK J.
19	LANG FRED'K.
19	LINER CONRAD A

WAR	NAME
19	McKERNE JAS.
19	McGURIN JNO.
31	NEIL MARTIN
19	PERRINE THOS. V.
31	PRINZO ROSONIO
25	RABE LOUIS J.
19	RUDIG JAC. J.

WAR	NAME
19	SCHOTT MARTIN
19	TABERER HOWARD
31	TIBBLES JNO. J.
19	TIERNEY JNO.
19	TIERNEY THOS. G.
33	WOLPERT THOS.

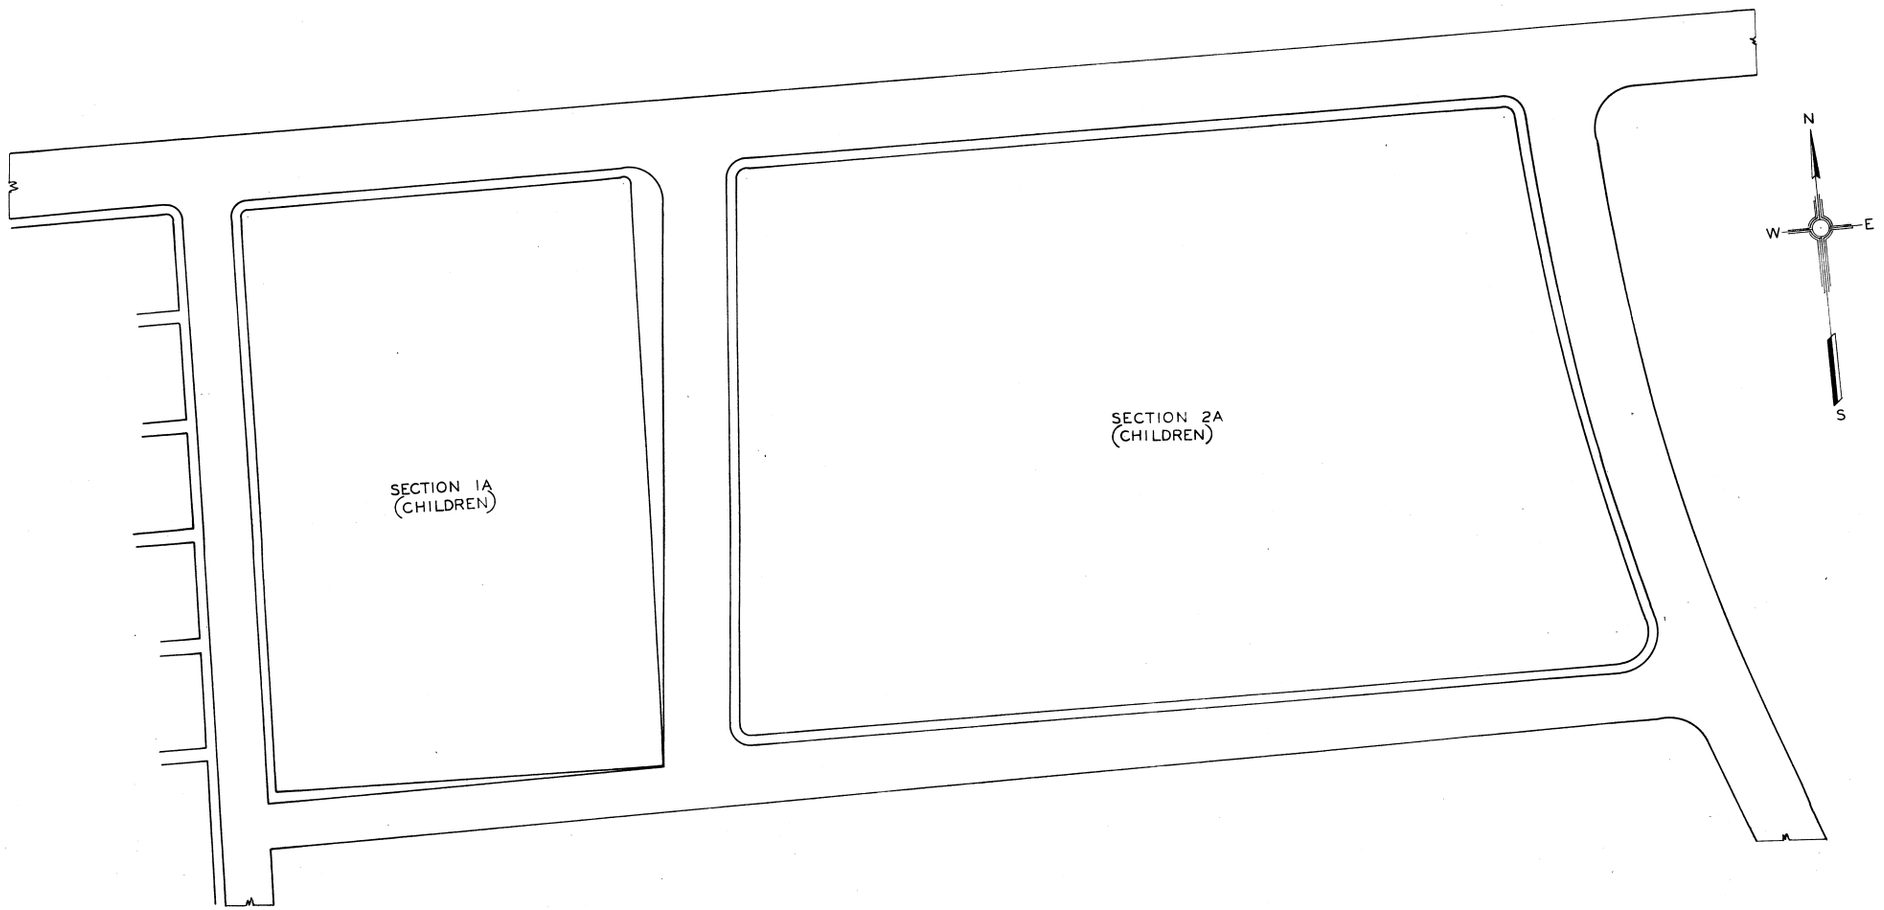

SCALE 1—20'

ST. JOSEPH NEW CEM.
PAGE 379

DIVISION A

LOT	GRAVE	WAR	NAME
12	16	19	WHITE THOS. M.

DIVISION B

LOT	GRAVE	WAR	NAME
92		19	BARNES CHAS.
2	10	19	BEAVER HENRY
104	9	25	BURKE EDW.
38	1	19	CAMPBELL DAN'L.
47	6	19	CONRARD MICH.
45	8	19	CURRAN DENNIS
34	1	19	DEVINE JAS. A.
28	6	19	DUNN PHILIP
71		19	EISELEIN CASPER
12	10	19	HERING CONRAD
32	7	19	HOLLAND JAS.
48	4	19	HOLLAND JNO.
9	12	25	GANNON THOS. E.
5	2	31	KEARNEY WALTER
14	2	19	KRAMER JOS.
39	2	19	LAWLER WM.
88		19	LEONARD THOM.
69	8	19	LOCKWOOD WM.
2	23	19	McCARTY MAT'H.
103	10	19	MAHON PAT.
34	3	19	MURPHY JNO.
51	8	19	MOORE EDW. F.
82		10	MURRAY JNO.
72		19	MURRAY WM. (DR.)
82	8	19	MURRAY EDW.
10	20	19	NAUGHTON JOHN W.
9	20	19	SMITH JNO.
51		19	SPENCER ALEX.
37	3	19	STAPLETON WM.

DIVISION C

LOT	GRAVE	WAR	NAME
9	2	19	CASSILLY JNO
21		19	COSTELLO THOM. E
2	1	19	CRAMSEY CHAS. C.
94	6	19	CUNNINGHAM PAT
109		19	DEE JAS
66	3	19	DWYER THOS
24	9	19	DEMPSEY JNO. SR.
32	6	19	FANNING PAT. F
11		19	FOLEY JAS. W.
9	26	19	GATES-WM.
116	7	19	HARPER JNO
128	34	19	HAYES NICH
128	27	31	HAYES JOHN J
70	1	19	KENNEDY THOS.
40	3	19	MEAGHER JOHN
50		19	MEYERS JNO.
1		19	MILLS LOUIS E
93	4	19	MULLANEY DAN'L J.
107	1	33	MOCKLER PAT K.
16		31	O'SHAUGHNESSY LOU. B.
69	1	19	STAPLETON PAT'K
28	12	19	TRACEY P.

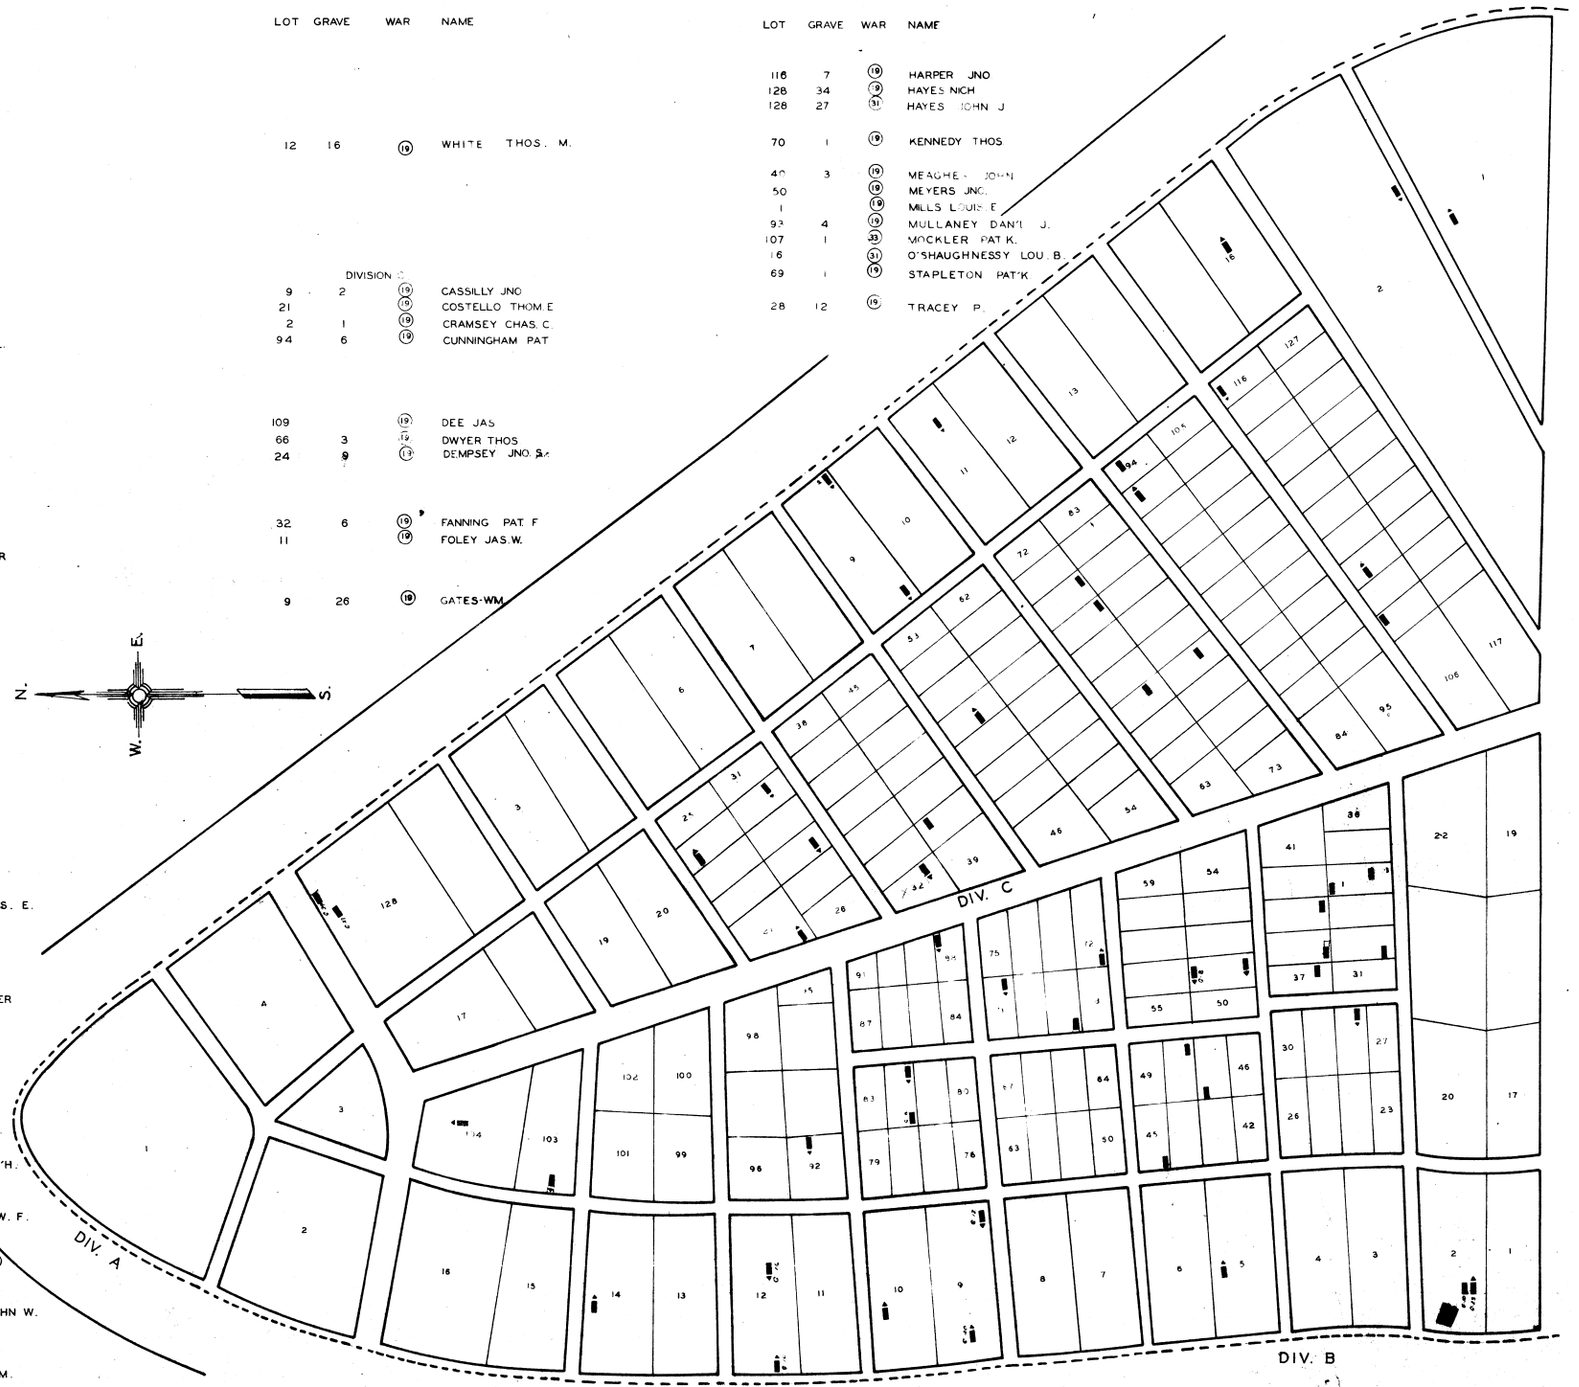

SCALE 1" 20'

NORTH ½ OF SECTION 1

ST. JOSEPH NEW CEM.
PAGE 380

LOT	GRAVE	WAR	NAME
	DIVISION D		
27	27		ADAMS DANIEL
7	28	19	BUTLE RICHARD
29	39	19	CAIN HENRY J.
48	13	19	CANNON IGNATIUS
42	31		CRAIG BEN.J.
49	15	19	DRISCOLL CORNELIUS
49	19	19	DRISCOLL ED. M
41		31	GORRIEN HUBT A
46	29	19	GALLAGHER MICH J.
21		31	HADLEY CHAS.
7	32	31	LEININGER PAUL A.
7	24	19	Mc CUNE. W. JNO.
38	15	19	Mc DONOUGH WM.
7	36	19	McLAUGHLIN ED.
30		19	MULLEN ED.
19	3	19	MURPHY DENNIS
17	1	19	ROGER MICH'L.
6	40	19	SULLIVAN TIM. J

LOT	GRAVE	WAR	NAME
	DIVISION E		
35		19	ARMSTRONG ROBERT G
6	9	31	BISHOP WM.

LOT	GRAVE	WAR	NAME
47		31	CARBIN WM. F
1A	23	31	CONNOLLY LEANDER R
27	9	19	DOLAN JNO
38	31	31	GATTO SAM
48	19	19	GIBBONS PAT.
22		19	GRIFFIN JAMES
20	20	19	HOLLAND JNO.
7	26	19	MOORE JOS.
49		19	MURPHY JOHN.
43		19	O'NEIL WM. J
34	11	19	O' LEARY JEREMIAH J.
17	1	19	OCONNOR JOHN
51		19	SWEENEY GEO.
32		19	SYLVESTER JAS. E
39	22	19	TULLY JOHN
PRIEST	9	19	CORCORAN E.P. (REV.)

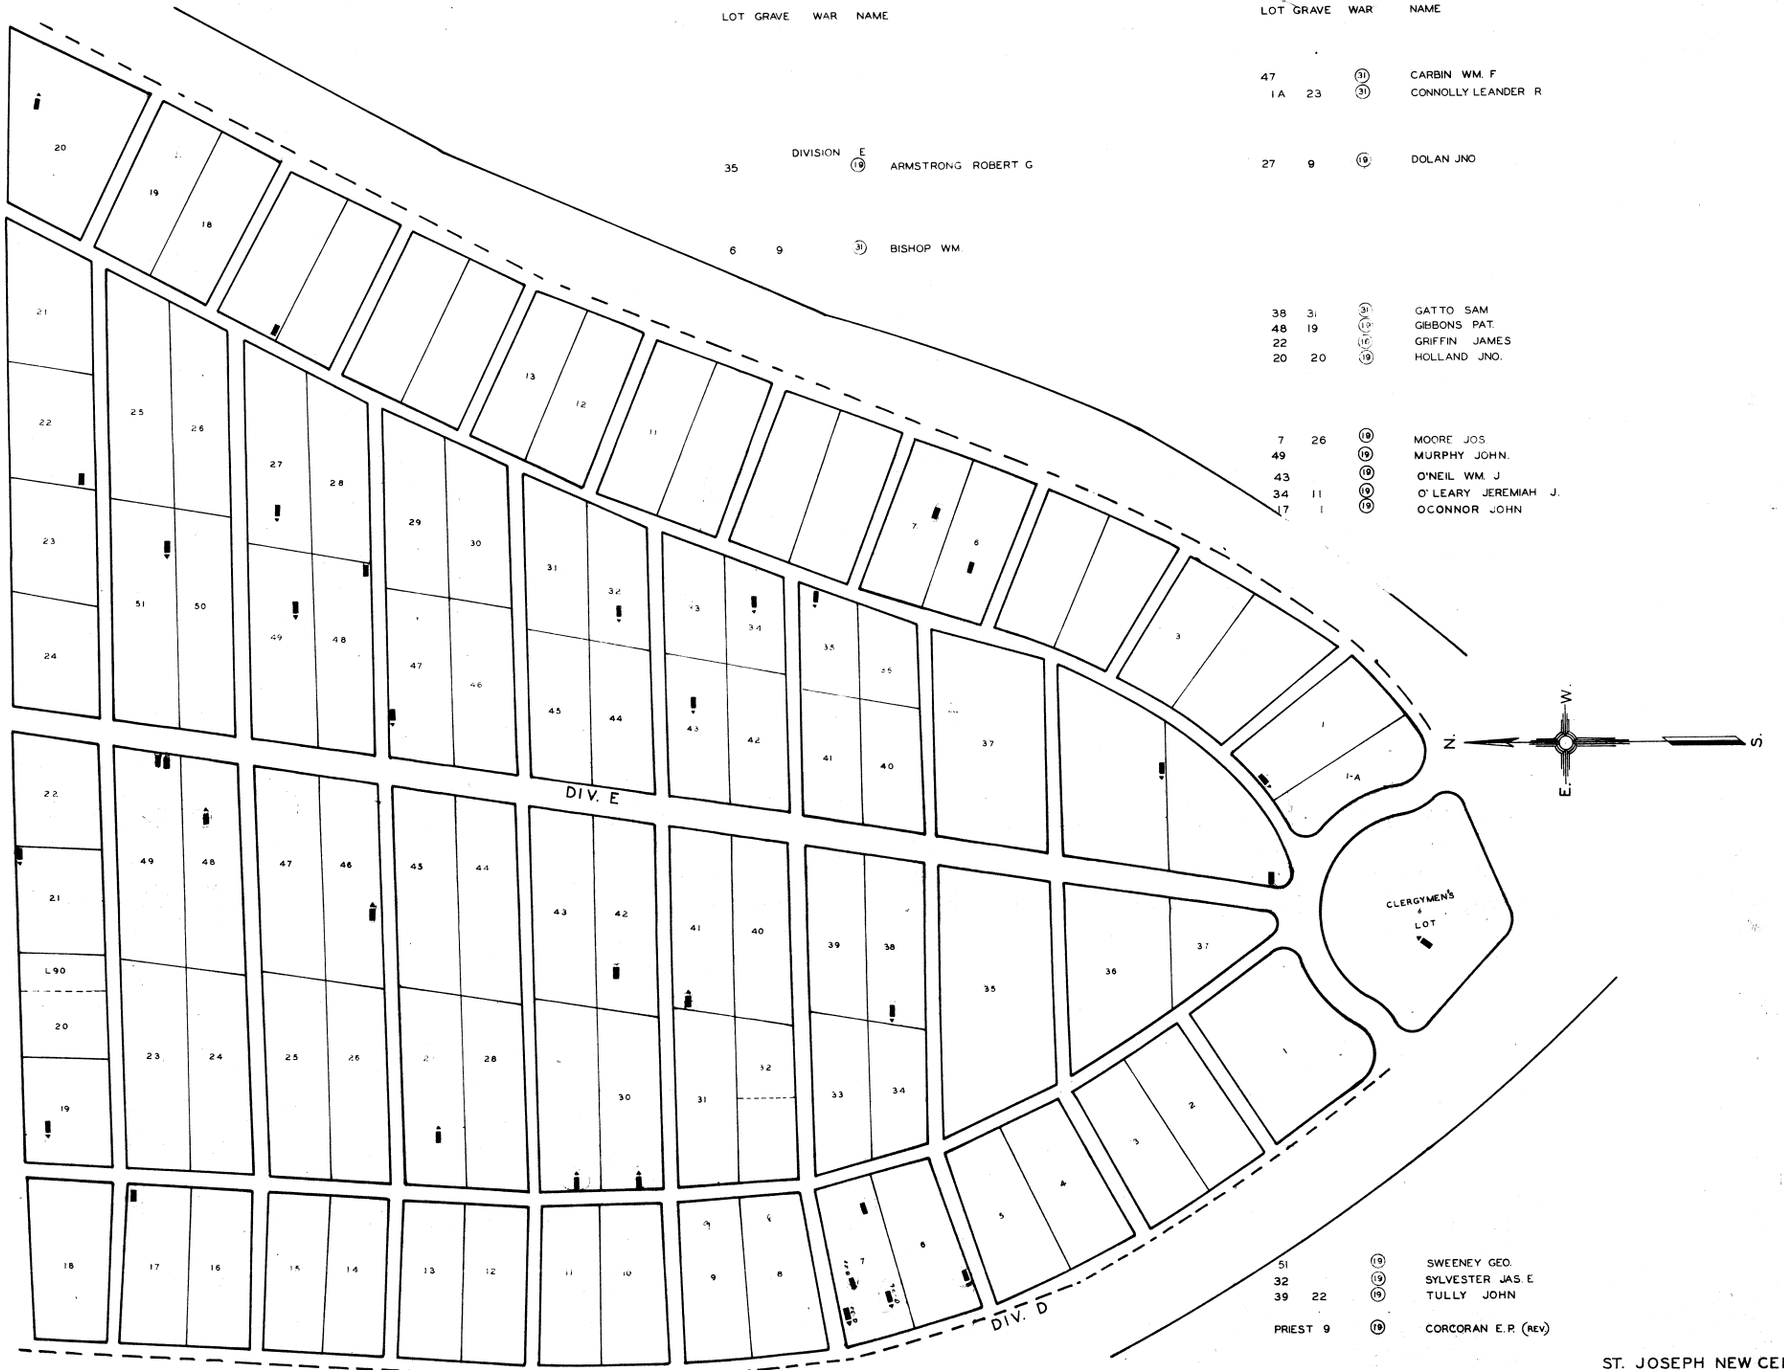

SCALE 1" 20'

SOUTH ½ OF SECTION-1

ST. JOSEPH NEW CEM.
PAGE 381

RANGE	LOT	GRAVE	WAR	NAME
6	25	6	19	ARMSTRONG JAS. A.
9	3	12	25	BENNETT JOHN F.
5	9	1	19	BIRMINGHAM MARTIN
8	11		19	BYARL MATH.
3	29	1	25	CAGNEY JAS.
3	29	6	53	CAGNEY WM.
6	18	1	19	CARNEY MICH. D.
2	23	12	19	CODY JNO.
1	15	9	19	CODY WM.
5	17		19	COOK THOS. M.
9	10		19	CORCORAN R. M
1	22		19	CRESAP ROBT. J
10	2	7	19	CHUCK JOS.
6	23		19	COYNE PAT'K.
10	6	8	19	CRAWFORD WM.
9	2	1	19	CRONAN JOHN
8	5		19	DEVANEY JAS.
4	2	9	19	DOUGERTY THOS.
12	1	6	19	DUFFY JNO.
11	8	12	19	DUGAN THOS.
6	21	11	19	DOOLEY JAS.
8	1	14	19	DECKER JOHN
8	18	9	19	DELANEY JOHN
13	5		19	DOUGHERTY M.
6	17	24	19	DUNN JOS
2	26	10		EGAN TERRENCE
5	12	12	19	FARLEY JAS.
13	4		19	FARLEY WM.
9	2		31	FLEMING CHAS E.
9	2		19	FLEMING PAT.
1	23		19	FOX CHAS.
15	5	1	31	GERWE ROBT.
12	12	10	19	GOODIN JNO.
4	28	7	19	GREGORY JNO.
2	26	2	19	GOLDEN JNO.
4	16	10	19	GILTMAN JAS.

RANGE	LOT	GRAVE	WAR	NAME
8	17		19	HAMMONS MASON
3	22	7	19	HAND JAS
2	21	3	19	HAYES JNO.
5	20		19	HENNESSY JNO. H.
1	14	9	16	HAGGERTY JAS.
11	12	7	25	HIGGINS THOS.
3	22	6	25	HAND WM.
3	15			JANSON CLIFF. H.
7	5		19	KELLY JERMIAH
3	7	2	19	KEARNEY JOS.
4	17		19	KEATING JNO.
13	3	6	16	KELLY JNO.
3	6		19	KING MICH.
4	11		31	KLINE REGIMUS

RANGE	LOT	GRAVE	WAR	NAME
4	3		19	LAHEY JNO
13	5	4	19	LYONS JNO.
1	23	6	19	LANSING DAVID F.
6	3	10	19	MANNING PAT'K.
4	14	4	19	MADDEN JNO.
2	12	1	19	McHUGH JNO.
3	19	6	19	McMANUS CHAS.
14	1		19	MEAD STEPH.
4	3		19	MILLIGAN JNO C
4	14	12	19	MADDEN MARTIN
2	10	2	19	MALONEY COR.
10	17	9	19	McDONALD THOS.
3	28		19	McGRANAHAN JOHN E.
9	19	11	19	MURTAUGH THOS.
7	18		19	MOLONEY JNO. R.
3	23	7	19	MURPHY JAS.

RANGE	LOT	GRAVE	WAR	NAME
9	14	2	19	O'BRIEN DENNIS
10	4	9	19	O'CONNELL JNO.
2	15	7	19	O'DONNELL PHIL.
9	15	12	25	PHARES GEO. C.
11	7	4	19	POWERS THOS.
6	22	6	16	REYNOLDS JAS. R
5	23	8	19	REYNOLDS MICH.
8	21	2	19	RYAN JNO. T.
6	19	12	19	ROACH MICH'L.
8	16	7	19	ROSEMEYER JOHN
13	4	1	19	RYAN MICH'L.
6	7		19	RYAN PAT'K.
7	4	5	25	SMITH ARTH
5	26	12	16	SMITH JNO
12	7	10	25	SULLIVAN JNO.
1	17		19	SAYER LEONARD
7	19	12	19	SHANNON MARTIN
13	9	7	19	SULLIVAN EDW.
5	6		19	SULLIVAN JNO.
3	8	4	19	SULLIVAN JNO.
8	3	6	19	SWEENEY EDW.
9	13		19	TRUSS GEO. W
8	20	10	19	TOBIN RICH.

SECTION 2C (LOTS)
SCALE 1" 20'

SEC. 2-B (SINGLES)

RANGE	LOT	GRAVE	WAR	NAME
D		14	19	BOYD DAVID
C		10	19	BUCKLEY JAS.
U		13	19	CHIDESTER H.
E		39	19	CONROY JAS.
J		39	19	CROGAN DOMINICK
S		16	19	DALEY JAS. W.
V		26	18 19	DAVIS JOHN G.
H		1	19	GALLAGHER JAS
U		21	18	GRAHAM WM.
C		23	19	KELLY JAS.
E		4	19	LILLIS JOHN
I		2	19	LOFTUS MICHL.
F-1		40	19	MEANY P. B.

SEC - 1-B

RANGE	GRAVE	WAR	NAME
7	4	19	BAUM HENRY
11	16	19	BURKE MICH'L
9	19	19	CAIN PATK.
2	40	19	CUNNINGHAM A
3	4	19	DALY JOHN
12	36	19	GIBSON JOS.
1	31	19	HANEY THOS. H.
8	39	19	KENNEDY JAS
15	56	19	KUPFERLE GEO
14	49	19	LANE MICH'L
3	48	19	LYNCH THOS.
2	43	19	LYONS MICH'L
5	10	19	MANNING JAS.
12	45	19	McBRIDE EDW.
3	15	19	McCOY WM.

RANGE	GRAVE	WAR	NAME
14	20	19	McELROY WM.
12	52	19	McGUIRE PAT'K.
7	19	19	MURNIN JAS.
15	53	25	MURPHY JOHN
11	8	19	NORMAN JOHN
8	33	19	REYNOLDS WM.
9	46	19	SHEEHAN C.
4	35	19	SMITH JOS.
9	23	19	HAMILTON JAS.

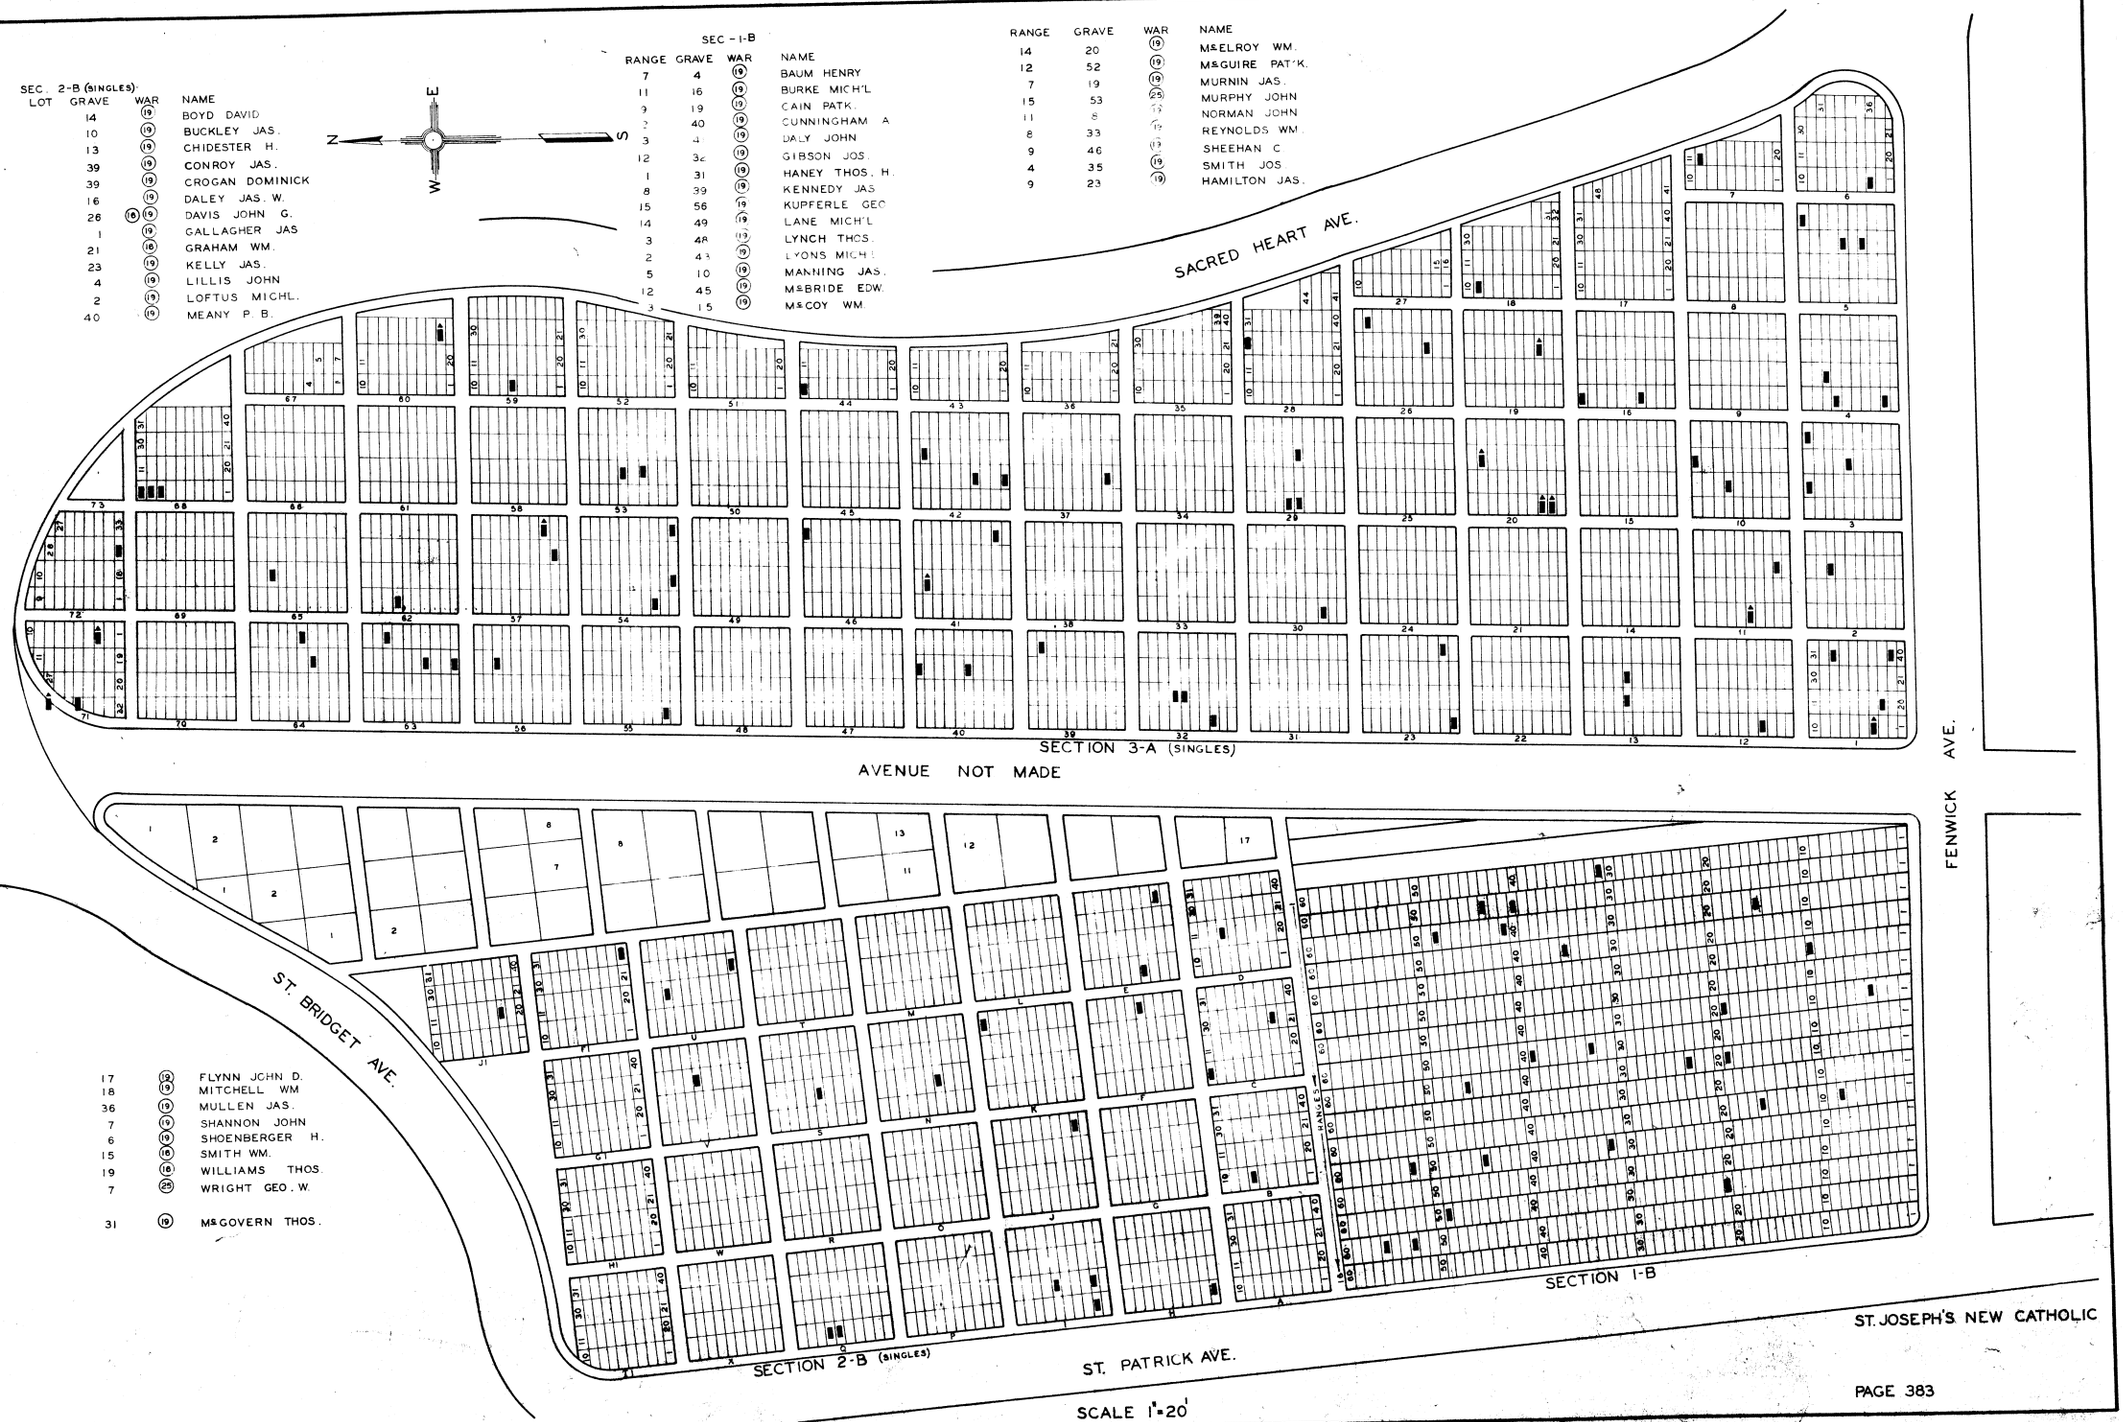

N	17	12	FLYNN JOHN D.
J-1	18	19	MITCHELL WM
F	36	19	MULLEN JAS.
Q	7	19	SHANNON JOHN
Q	6	19	SHOENBERGER H.
I	15	18	SMITH WM.
I	19	18	WILLIAMS THOS.
B	7	25	WRIGHT GEO. W.
K	31	19	McGOVERN THOS.

SCALE 1"=20'

ST. JOSEPH'S NEW CATHOLIC

SECTION 3B (LOTS)
SCALE 1" 20'

RANGE	LOT	GRAVE	WAR	NAME
71		79	19	BENNETT JOHN
8	6		19	BOYLE JOHN
41		12	19	BRASERS JOHN
7	12	11	25	BREEN JOHN P
63		24	19	BROWN HENRY
3	30	3	19	BURDICK CHAS.
61		33	19	CARR WM. M.
18		9	19	CARROLL JOHN
46		31	19	CARROLL MARTIN
5	1	1	19	CARROLL PAT'K.
5	1	7	19	CARROLL MICH'L.
4		2	19	COLEMAN MICHL.
55		2	19	COLLINS JOHN F.
9	7	7	19	CONDON JOHN
11		22	19	CONNELL JOHN
2	28	4	19	CONNELLY JOHN
64		24	33	CONNELLY PAT.
1		39	19	CONNOR HENRY E.
7	8	1	31	CONWAY JAS. L.
53		17	19	COOK JOS. W.
1	27	6	19	CORCORAN THOS. H.
29		25	19	CORRIGAN DAN'L.
13		26	19	COSTELLO THOS.
4	17	1	19	COYNE THOS.
4	14	12	19	CROKER THOS.
4	27	1	19	CORCORAN PAT.
5	14	1	19	DAUGHERTY JAS. M.
54		40	19	DELANEY EUGENE
59		6	19	DENNISON EDW.
9	22		25	DESMOND JOHN J. KILLED IN ACTION DURING COURT HOUSE RIOT
23		39	19	DIGMAN PAT'K.
1		18	19	DORAN FELIX
40		30	19	DUNN THOS.
13		15	19	EVERSMANN HENRY.
32		3	19	FARRELL JOHN
9	11	8	33	FEELY WM. J.
12	7	1	25	FINN JOHN J.
20		3	16	FLYNN JAS.
26		23	19	FLYNN MICH'L.
19		23	19	FODY THOS.
28		30	19	FOSTER RICH.
29		5	16	FRANKLIN BENJ. H.
24		1	19	FRIEND ADAMS.
4	13	3	19	FUREY THOS.
5	17		19	GRADY JNO.

RANGE	LOT	GRAVE	WAR	NAME
56		28	19	GIBBONS JAS
1	36	14	19	GORMAN JOHN
32		14	19	GOULET JOS
8	16		19	HACKETT JOHN
68		10	19	HALEY THOS. J.
54	2	30	19	HARRISON JOHN
4	13		31	HART JOHN T
10	2	18	19	HERRON JOHN
16		4	19	HIGGINS THOS.
11	5		31	HOLLIDAY GEO. G.
4		9	13	HURLEY JAS.
3	19		31	KEAN JAS. E.
64		36	19	KELLEY THOS
10		30	19	KELLEY THOS
10	12	9	19	KENNEDY THOS.
32		15	19	KEOGEN JOHN
10	12		31	KENNEDY JOS T
4	6		31	KILGARIFF JAS. J.
39	39	32	19	LALLY JOHN
8	1	18	16	LEONARD J.S.
5		24	16	LEONARD JAS.
72		19	19	LILLIE WM. D.
57		38	19	LYNCH THOS.
65		14	19	MADISON JAS.
10	24	10	31	MAHER JOS H.
7		12	19	MAHON ROB'T
1	33		19	MALEY JOHN M
5		31	19	MALONE JAS.
3	7		31	MARTIN JOHN
3	17		19	McCARTHY JOHN
9	5	11	19	McCORMICK PAT'K
3	16		31	McCULLOUGH GEO V JR.
6	8	10	16	McDERMOTT JOHN
6		3	19	McGINN PAT'K.
71		3	19	McGRATH EDW.
7	19	10	19	McGUIRE THOS
30		3	19	McNEFF TIM
3	37	6	19	McPHILLIPS JAS.
10	23		19	MEEHAN MARTIN
71	28		19	MILLIGAN WM.
42		17	19	MILLER WM.
54		20	19	MOLTOR GEO.
5		26	19	MOONEY PAT'K.
19		2	19	MORAN JOHN
10	1		19	MORAN JAS.
2	38		19	MORAN THOS
68		6	19	MORAN JAS.
9	19		19	MORAN WM

RANGE	LOT	GRAVE	WAR	NAME
58		22	19	MORGAN LAW'R.
5	5		19	MORGAN THOS.
10		14	19	MORRISON JOHN
1	22		19	MULLEN PET.
5	8	7	19	MURPHY DAN'L.
12	6	5	19	MURRAY M. J.
5	9		19	MILLER WM. W.
2	5		19	NEABREY JOHN H.
11	10		19	NEALON THOS. J.
3		31	19	O'BRIEN MICH'L.
2	4		16	O'BRIEN MICH'L.
9	12		31	O'DOM JOHN E.
3	2	11	19	O'NEILL PAT'K.
68		9	25	O'NEAL MICHL.
29		6	19	PROCTOR CHAS.
9	13	2	19	QUINN JAS.
60		22	19	REANEY MICH'L.
12		4	19	REGAN PAT'K.
42		29	19	RICE JOHN
37		19	19	RILEY MICH'L.
20		29	19	ROBINSON WM. A.
6	12		31	RYAN HUGH J.
8	12		31	SAND WM. G.
26		32	19	SCHRODER CHAS. A.
8	24	4	19	SHERIDAN JOHN
3	28	12	19	SHOTT MARTIN
1		4	33	SIMPSON CHAS. H.
41		39	19	SMITH HENRY
62		7	25	SMITH JOHN H.
53		15	19	SMITH MARTIN
8	24	12	19	SULLIVAN DAN'L.
3		11	19	SULLIVAN PAT'K.
16		10	19	STONE JOHN
12	7	2	19	STRAUSBERGER XAVIER
44		10	19	SHERIDAN WM.

RANGE	LOT	GRAVE	WAR	NAME
2	35	1	19	TOOMEY JOHN
63		21	19	WARD EDW.
26		17	19	WARD JAS. D.
41		25	19	WEIDNER GEO.
3	24	1	25	WELSH JOHN
4	9	11	19	WHALEN MICH'L.
42		20	19	WHITNEY H. F.
2		32	19	WILSON ANDREW
4		7	19	WINTERS JOHN
4		13	16	WYNN THOS.

RANGE	GRAVE	WAR	NAME
16	24	19	BARNETT JOHN
62	5	25	BARNETT MICH'L. G.
43	17	19	BARNUM GEO.
36	31	19	BARTON JOHN
22	33	19	BECK HENRY
15	3	19	BROWN JON. J.
45	40	19	BURNS THOS.
60	34	21	CARR MICHL.
57	15	19	COLLINS DAN'L.
20	26	16	CONNER THOS. O.
36	30	19	CONNOR MICH'L.
10	27	19	CUMMINGS PAT'K.
45	16	19	CUMMINS WM.
6	34	19	DORSEY EDW.
19	5	19	FLETCHER JOHN
1	1	19	HANLEY WM.
12	6	19	HUNT WM. A.
56	8	25	JONES WM.
53	37	19	KELLY JAS.
14	12	19	KENNEDY WM.
67	8	19	LEAHY MICH'L.
6	28	25	LEDDY BERN'D.
48	25	19	MARSHALL SAM'L.
18	2	19	McGRATH PAT'K.
8	1	19	McLAUGHLIN J. W.
38	30	19	MEADER BEN'J.
9	13	19	MEAGHER JOHN
14	10	19	MURRAN PAT'K.
52	37	19	MURRAY JOHN
39	10	25	OKEEFE EDW. J.
12	31	19	ONEIL JAS.
36	3	19	RIGNEY JOHN
35	20	19	ROUSE WM.
55	17	19	SHANNON JOHN
13	16	19	SHAW JOHN
7	17	19	SMITH RICH.
38	34	19	SNIDER HENRY
32	26	19	STEWART JOHN
54	9	19	THOMAS C.W.
29	5	19	TIERNEY JOHN
13	31	19	WAKLYN JOHN C.
35	11	19	WINTERS DAN'L.

RANGE	GRAVE	WAR	NAME
27	4	19	AMBROSE THO
10	20	19	BALL JOS.
19	31	19	BURKE DENNIS
9	16	25	CLEBAN WM. F.
18	13	19	DIXON ALB.
53	39	19	GREEN THOS.
23	14	19	HALEY MARTIN
62	11	19	HURLEY EDW.
34	28	19	JACOBS EDW.
52	27	19	JOHNSON JOHN.
54	24	19	McMAHON WM.
56	38	19	MURPHY THOS.
35	12	19	SHERMAN EDW. S.
11	14	19	SMITH EDW.
52	1	19	SMITH AS. W.
57	34	19	STEINHAUER CONRAD
39	28	25	STITELBERG JOHN
7	20	19	SULLIVAN J.
57	26	19	SYLVESTER F. E.
8	13	19	WITHERBY W. R.
53	36	19	WILSON CHRIS.
3	19	19	WRIGHT JOHN
15	38	19	YOST PH.
16	16	25	MEEHAM AUG.
35	34	19	CORRAN PAT. J.

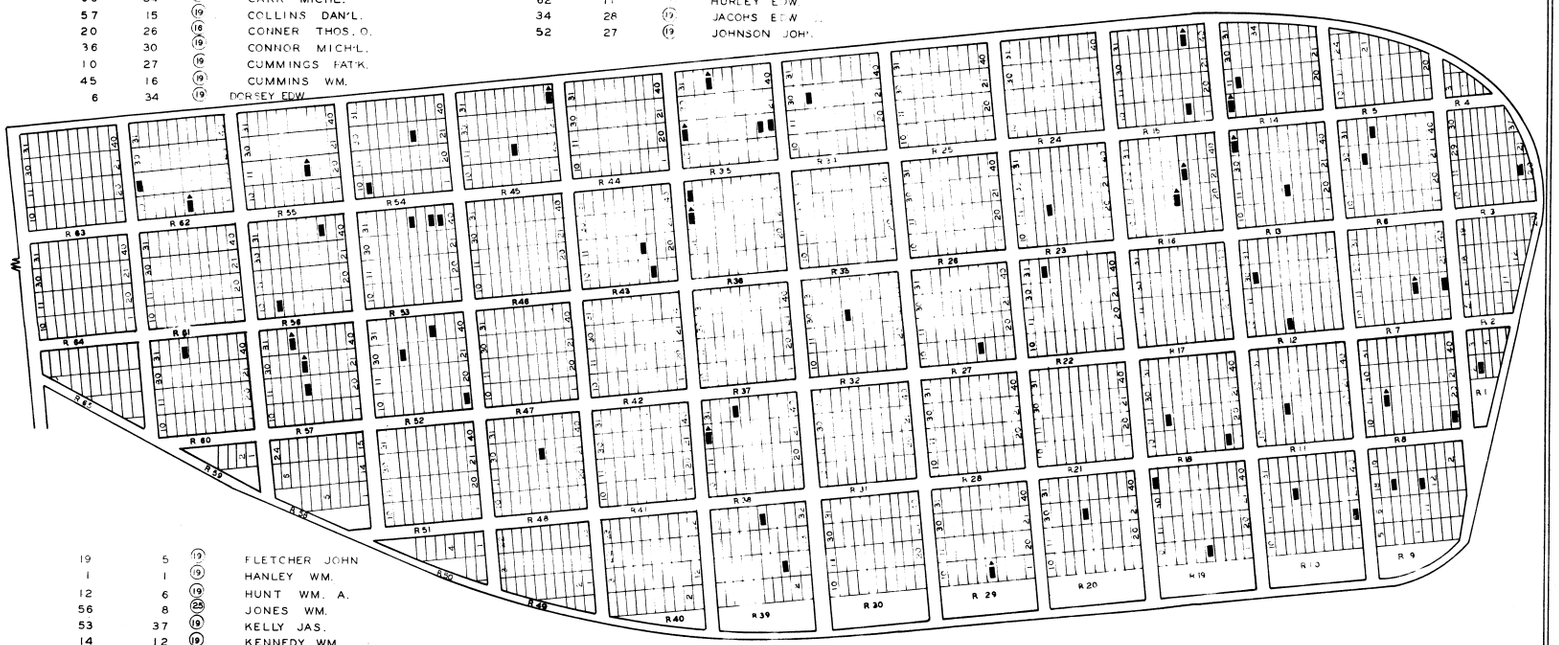

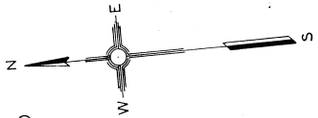

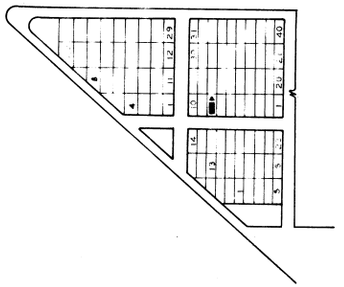

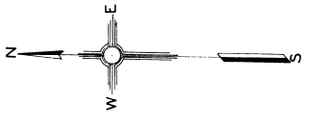

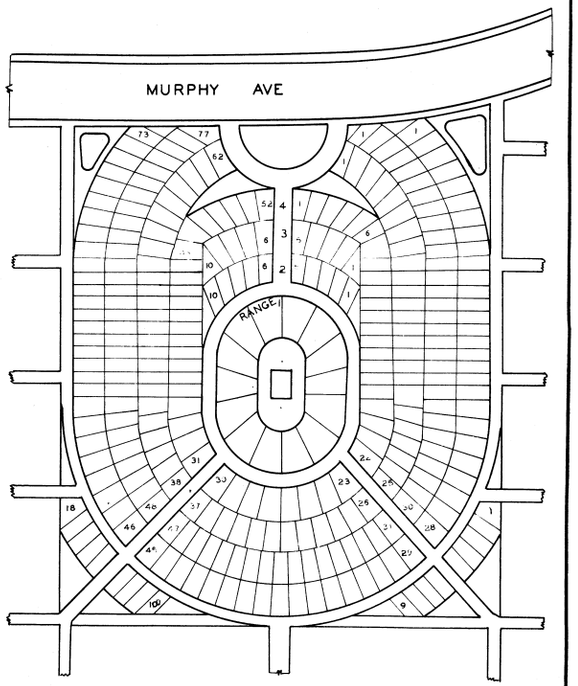

PART OF SECTION 12
(CLERGY LOT)

SEE PAGE 396

SECTION 4 A

RANGE	LOT	GRAVE	WAR	NAME
11	9	1	31	BRADLEY ROBT. M. (BURIAL UNKNOWN)
9	6		19	BUTLER JOHN
5	5	6	19	COLLINS JOHN
10	6	7	31	CORCORAN JAS. M.
4	3	3	19	COX PAT'K.
16	3		19	CRAIG MICH'L.
5	9		13	CROTTY JOHN
3	10	6	19	DEAN CHAS. W.
13	1		25	DORAN JAS. E.
13	1-A		19	DORAN WM.
6	9	7	31	DRISCOLL JOHN F.
15	3		19	GRACE JOHN
6	14		19	GREEN PET. A.
8	7	3	19	HALPIN JOHN
17	2		31	HARRIS CLIFF. S.
14	10	6	31	KELLY NELL (NURSE)
12	12		31	KEUTZ H. L.
6	8		31	LEEN AL'B. A
2	4		19	LILLIS JOHN (BURIAL UNKNOWN)
7	14		19	MAHAN PAT'K.
2	11		19	MALONE JAS.
6	12	7	19	McGILL JOHN
1	9	31	19	MOORE ISAAC. L.
1	13	24	19	MORRISEY PAT'K.
2	2	7	19	MOSSINGTON WALT. J.
1	14		31	MURPHY JOS. R.
10	3	4	19	MURPHY OWEN
9	3		19	SHIELDS JOHN W.
14	7	12	31	SIESS W.L.
2	10		19	STUMP JOHNSON.
14	9	2	19	CLARK JOS. B.
8	12	10	25	DETTERMANN ANDREW
3	12	10	19	DEVINE WM. H.
5	9		19	DWYER RICH.
10	2	11	19	GAUSMAN JOHN G.
5	11	1	19	GAVIN WM.
1	13	12	19	GILLIGAN JOHN
10	5		19	HESTER BERNARD
11	8	12	19	KELLEY M. L.
1	5	3	19	KELLY PAT'K. J.
4	6	7	19	KENNEDY MOSES
4	12	3	19	McCABE THOS.
6	14		25	McCARTHY JOHN
6	14		31	McCARTHY THOS. E.
10	8	1	31	McGUINNESS HUGH
1	2	4	31	O'DOWD WM. F.
15	2		19	PERRY BENJ.
2	3		19	WILEY JAS.
4	4		19	GUILFORD JNO. F.

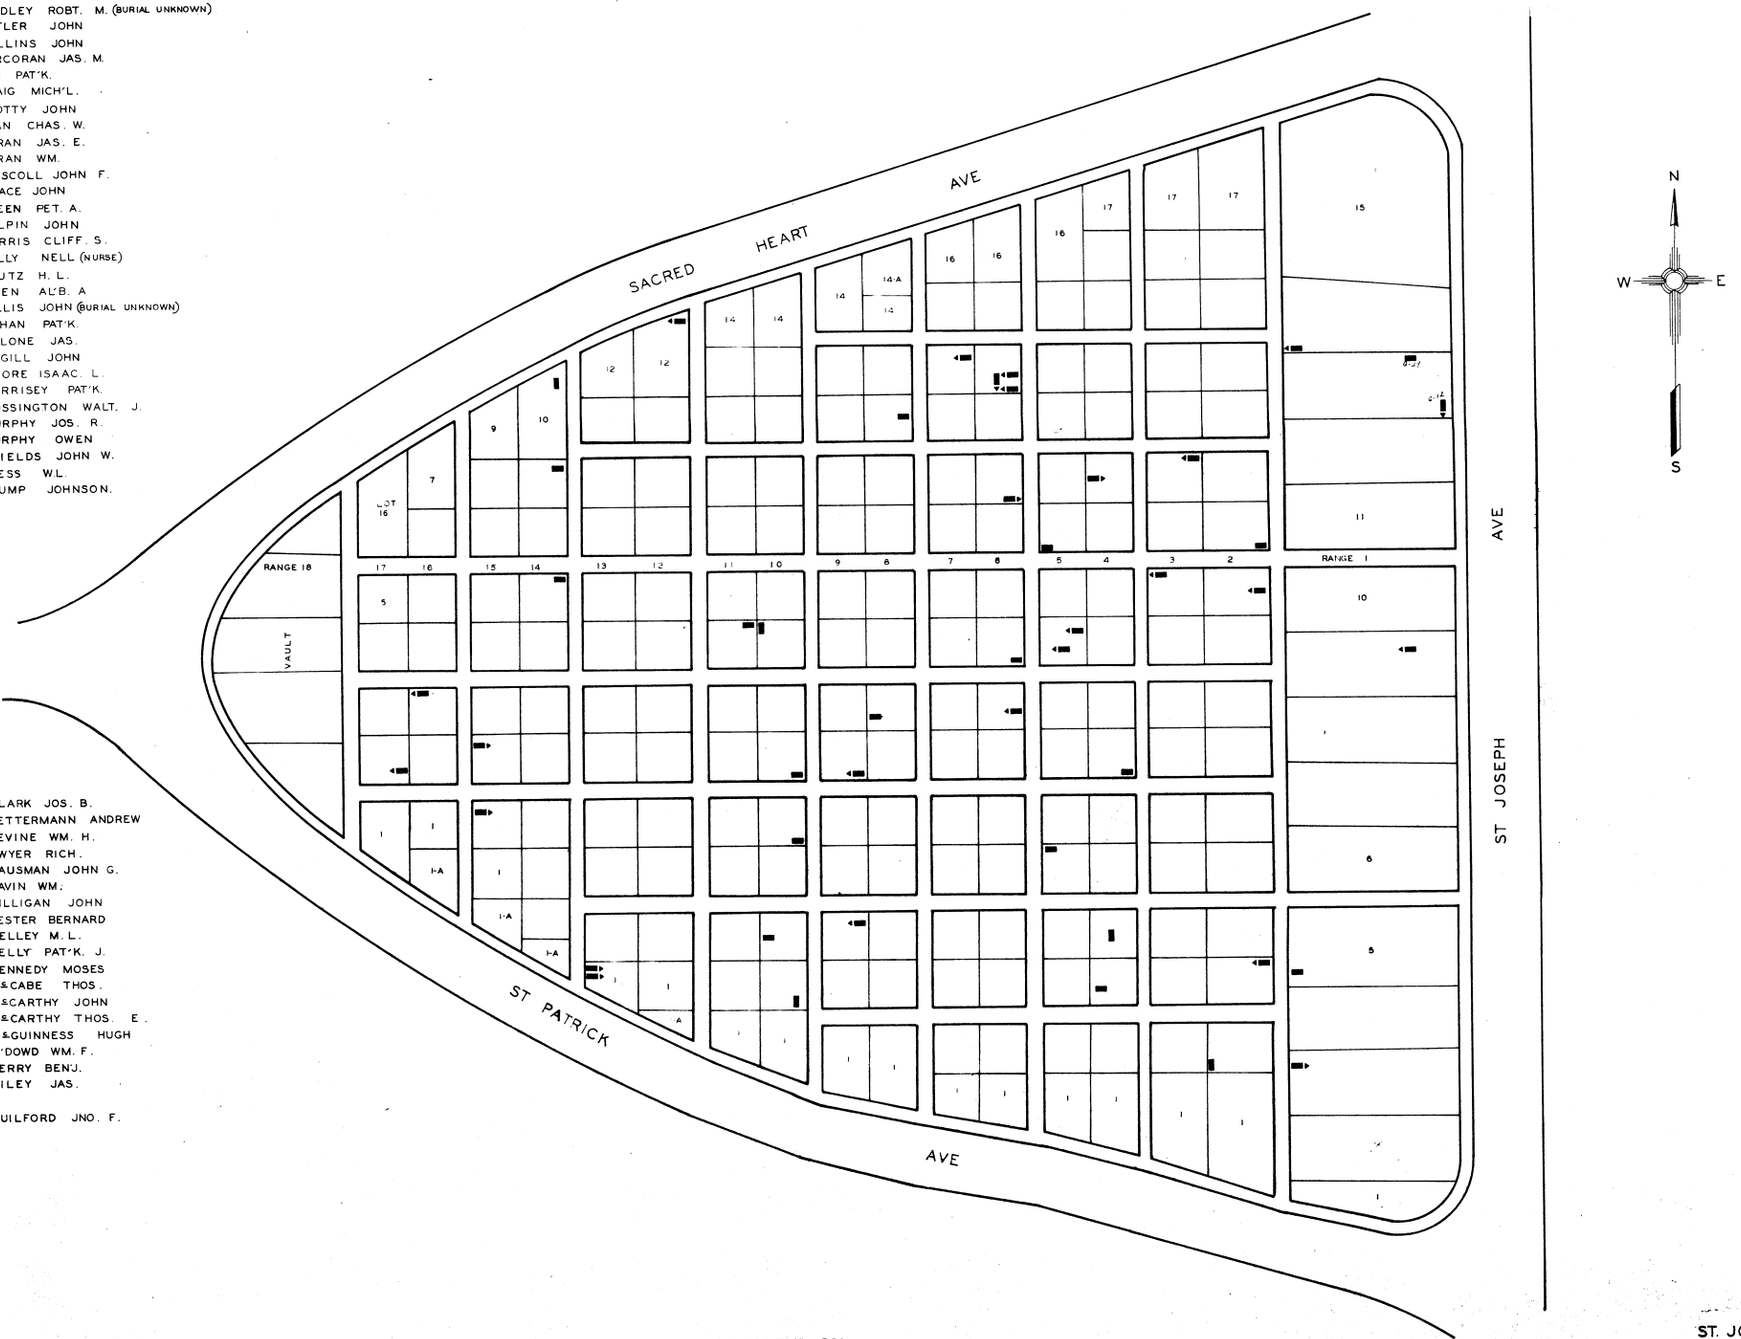

SCALE 1" = 20'
SECTION 4B

ST. JOSEPH NEW CEM.
PAGE 387

R	ROW	GRAVE	WAR	NAME
	5	15	31	ADKINS JOHN C.
	4	12	25	ANDREW MEYERS. SEE MEYERS.
	3	8	31	BERNHARD CHAS.
	6	8	31	BROOKBANK JOS. L.
	6	3	31	BUCKMAN WAL'T. W.
	5	2	31	BURKE THOS. M.
	5	11	31	BALON JOHN R.
	2	5	25	BURNS PAT'K.
	3	2	31	BYRNE WM. L.
	1	12	31	BRAMAN HAROLD L.
	7	1	19	BURNS BARNEY
	1	11	31	BUSKER ELMER F.
	5	3	31	BOSS JOHN
	3	5	31	BUCHMANN WM. H
	2	8	25	BYRNE OLIVER M.
	2	15	33	COSSON C.
	4	5	33	COSS WM.
	4	13	25	CARROLL WM.
	7	2	19	CASEY M.
	2	2	25	CELLA JOS.
	1	4	33	CONLEY C. E.
	1	1	31	COREA STAN.
	2	14	25	DAILY MICH'L.
	6	6	31	DEE WM. M.
	5	7	31	DINEEN JAS.
	5	9	31	DRESMAN GEO. E
	1	15	31	DURY MARTIN J.
	4	10	25	DEARING EDW.
	2	1	25	DRABELLE HARRY B.
	2	11	25	DUESING AUG. T.
	5	4	31	EIBEL IGNEZ J.
	6	1	31	EILERS AL'B. I.
	1	10	31	ERFTENBECK CLEM.
	6	2	31	FRIETSCH EDWIN
	3	11	31	FITZPATRICK JAS.
	1	7	31	FOY ROBT. J.
	4	4	25	FELHAUER RUDOLPH
	4	8	25	GALLAGHER CHAS.
	1	13	31	GALLAGHER F. A.
	5	8	31	GAR GANO ANTHONY
	3	7	31	HANNEKEN EDW. L.
	6	11	31	HARMELING LEO. G.
	3	10	31	HAYES JOS. M.
	4	14	25	HICKEY JOS.
	3	13	31	HOLLIHAN HARRY
	4	11	25	HORNBERGER HENRY P.
	4	15	25	JACOB RUF.

ROW	GRAVE	LOT	WAR	NAME
5	12		31	KOBENGER HARRY A.
3	4		31	KRIEG EDW. W.
2	7		25	KUHN PHIL
2	12		25	KLUMPHER JOS.
1	5		31	KERWICK WM. R.
2	6		25	LEMMON JOHN W.
4	3		25	McDONALD WM. A.
6	12		31	McGOWAN LAW.
5	1		31	MEYER JOHN
4	12		25	MEYERS ANDREW
2	10		25	MURRAY JAS. E
2	4		25	NICHOLS ANDREW
1	9		31	OBRIEN PAUL M.
5	5		31	O'DOWD JAS. P
1	2		31	ORLANDO JOS.
1	14		31	ORR ELLIS A.
6	9		31	PETER JOS
3	14		33	PETRUCCELLI DOM'K.
4	9		33 31	PLOGMAN GEO H.
3	9		31	RANGE PAUL
1	3		31	REAL EDW. JR
3	3		31	REUTER GEO F.
2	3		33 25	RUMPKE C
UNKNOWN			31	ROSS JNO.
6	5		31	SALUPPO TITTO
5	13		31	SCHUMACHER TONEY
5	6		31	STANTRIDGE ROB'T.
5	14		31	STOCKMAN EDW. J
3	6		25 31	STRATTHAN FRANK L.
1	8		31	SURNBROCK FRED.
4	6		25	SMITH CHAS

ROW	GRAVE	WAR	NAME
4	2	31	TAMME NIC. L.
4	7	25	TRACY JAS. J
3	1	31	WAUGH GEO F.
3	12	31	WEGHORST HARRY G.
6	10	31	WELSH THOS.
3	15	31	WOLFF DAV'D. L.
		31	WORLEY JAS. M.
2	13	33 25	YARMARENE GEO.
1	6	31	YGLESIAS EUG.
6	4	33	ZIEVERINK FRANK F.
2	9	25	KUEHNEY JOS.
4	1	25	CARTER WM. L.
		31	KYLE JAS.

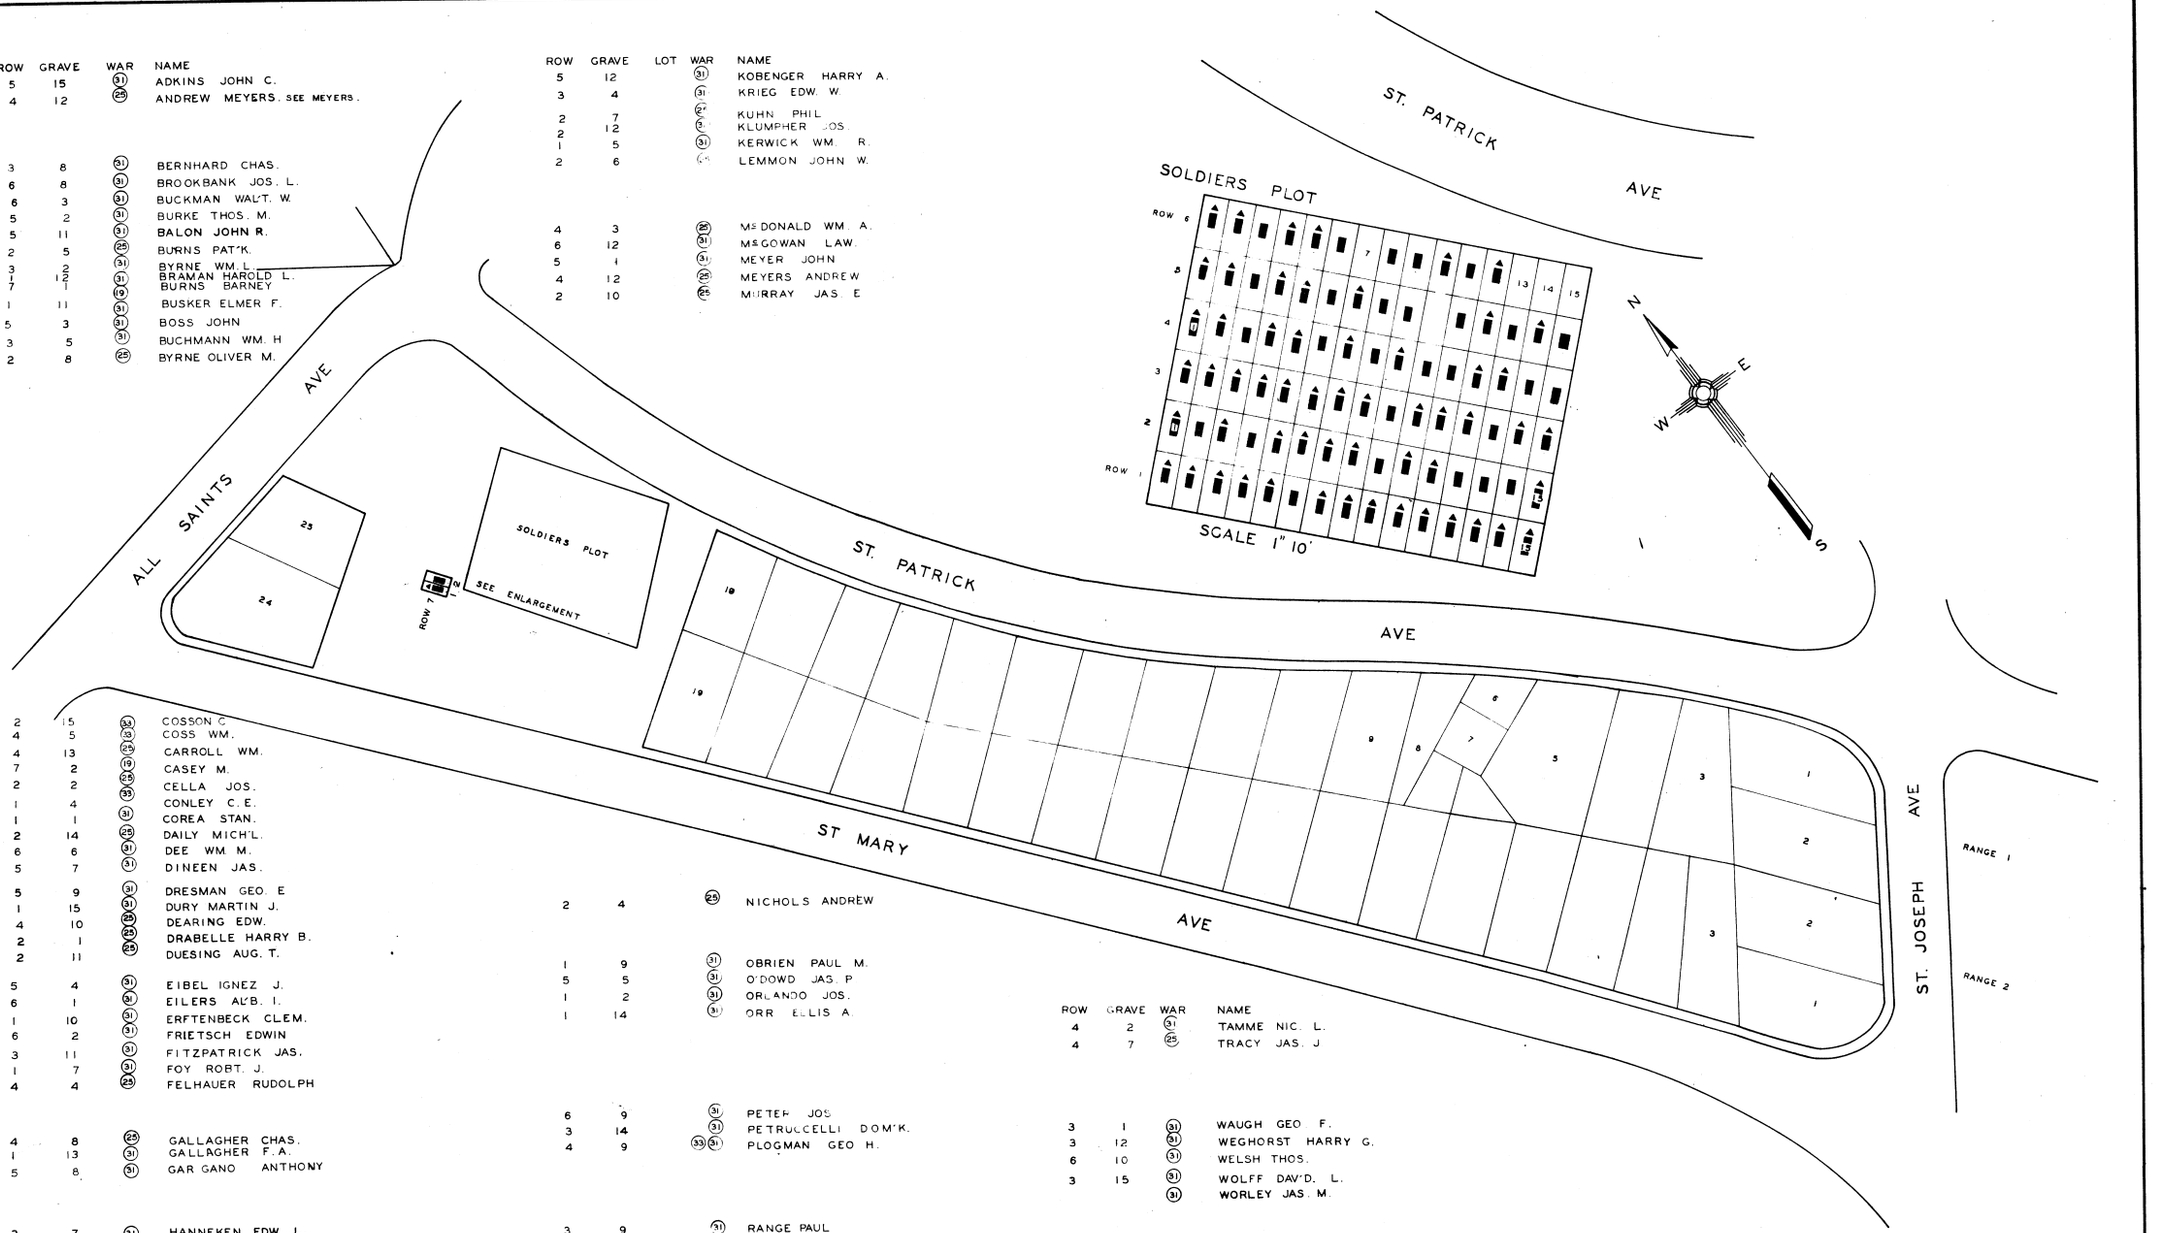

SECTION 5
SCALE 1" 20'

ST. JOSEPH NEW CEM
PAGE 388

RANGE	GRAVE	WAR	NAME
65	4	28	BRUCHE EUGENE H.
6	23	31	CASSERLY THOS. W.
58	34	19	CASSIDY JAS.
59	36	19	COAN WM.
13	8	31	COLLINS THOS. W.
34	12	31	CUNNINGHAM CORN'L.
1	8	19	DELANEY DENIS
39	25	19	FOX JOHN
72	5	31	GALLAGHER WM. D.
47	12	19	GREGORY GEO.
55	33	19	HIGGINS JOHN W.
79	27	31	KAIN M. J.
52	24	19	LEE JOHN
5	37	31	LENGROSS ANTHONY (ALIAS A. LINGROSS)
45	10	31	LYONS JAS. M.
15	19	19	MAHONEY JAS.
41	22	31	MALEY EDW. J.
48	36	19	MANNING BRYAN
20	19	31	MUELLER E. J.
14	28	31	OCCHIPINTI ANGELO
25	39	31	ROTHRING ROB'T.
58	25	28	SCHODELL JOHN. E.
28	12	19	SHANNON JOHN
33	28	19	WEGLAGE HENRY
75	5	28	WELLS CHAS. J.
27	4	31	WRIGHT JOS. F.

RANGE	GRAVE	WAR	NAME
68	18	31	ARNOLD FRANK
62	1	28	BOWMAN SAM'L.
63	11	19	BURKE THOS.
55	14	19	CANNON JAS. J.
51	10	28	CRESAP ALB. W.
48	39	31	D'ARESTA DOMENIC
SEE	SEC. 5		DRESMAN GEO. E.
55	23	31	ENNIS JOS. J.
24	4	31	McGARRY JOHN
36	23	31	POST ALB. L.
20	35	28	REDD WM.
38	32	31	SIMMS JOHN
44	9	19	WARWICK JOHN ALIAS GEO JENNINGS

RANGE	GRAVE	WAR	NAME
23	31	19	SCOTT JNO.

36	34	31	ACITO RALPH
45	45	33	BROWN JAS.
15	3	31	FISCUS WM. F.
60	11	19	SCOTT JOHN
1	35	28	COYLE FRANK G.

SINGLE GRAVES
SECTION-5

ST. JOSEPH NEW CEM.
PAGE 389

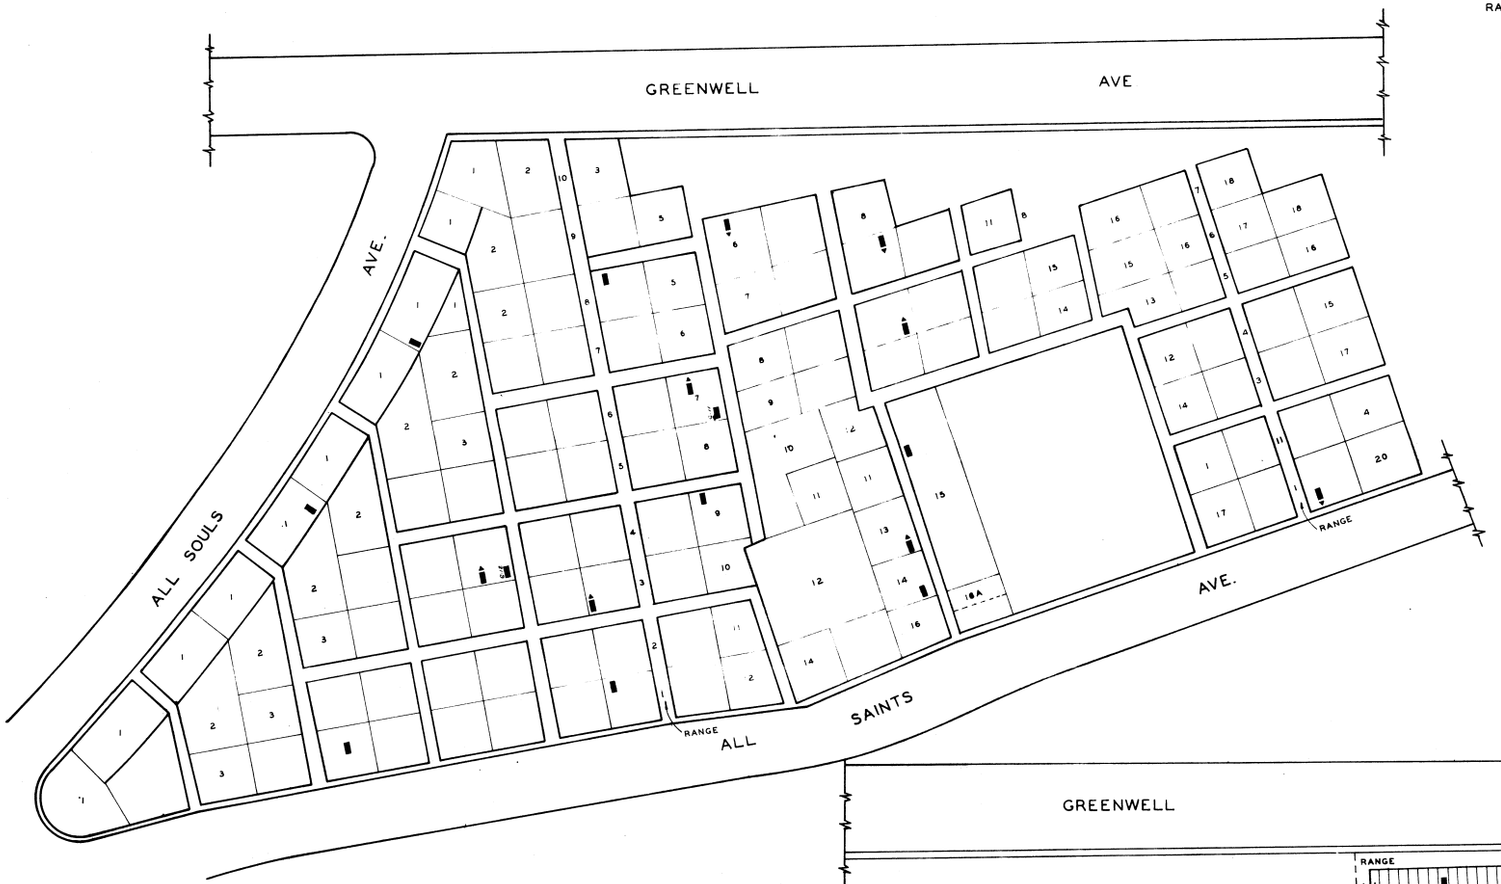

RANGE	LOT	GRAVE	WAR	NAME
	U.C.G.	UNKNOWN	19	CLARK ANDREW J.
8	1	5	19	CONNELLY MICH'L.
11	11	4	19	COOK JOHN D.
	U.C.G.	UNKNOWN	19	CRAIG JAS.
6	7	11	19	DREIN WM.
	U.C.G.	UNKNOWN	19	HELLER JOS.
	U.C.G.	UNKNOWN	19	KEATING THOS.
5	U.C.G.	21	19	MILLER ZEBULON
3	U.C.G.	22	19	MOHNS F.
4	5		19	OMEARA JOHN
1	25		31	ONEIL M. A.
3	30	2	19	SHEA JOHN
1	10	2	19	CONNELL EDW. J.
5	18	8	19	KENNEDY RICH.
1	5		19	LAURIE ARCHIBALD

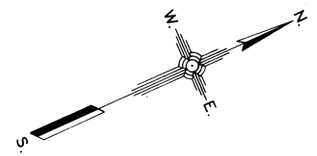

RANGE	LOT	GRAVE	WAR	NAME
8	6		19	BUCKLEY MICH'L.
8	U.C.G.	18	21	BURGER CHRIS. J.
1	19	8	19	BURKE JAS.
8	4	2	19	CONDON DAV.
3	13		19	COSTELLO WM.
11	15	8	19	DAVIS WM. A.
6	7		19	DRAIN JOS.
2	14	11	19	ENRIGHT JOHN.
4	9	3	28	FRIEL ANTHONY
1	U.C.G.	8	19	GLEASON JOHN
5	1	1	19	HALPIN J. F.
4	15		31	HOWELL GEO. W.
1	31		31	IRELAND JOHN J.
4	5	12	19	JENNINGS JOHN
3	22	10	31	LONG DAV. T.
5	U.C.G.	1	19	McNAMARA JOHN
1	27		31	MURRAY EDW. L.
3	8		31	SCANLON JOS. M.
3	U.C.G.	1	19	SLATER GEO. W.
7	9		31	STRATTON CLARENCE
3	20		28	WEINIG J. W.
6	10		19	WELSH JAS.

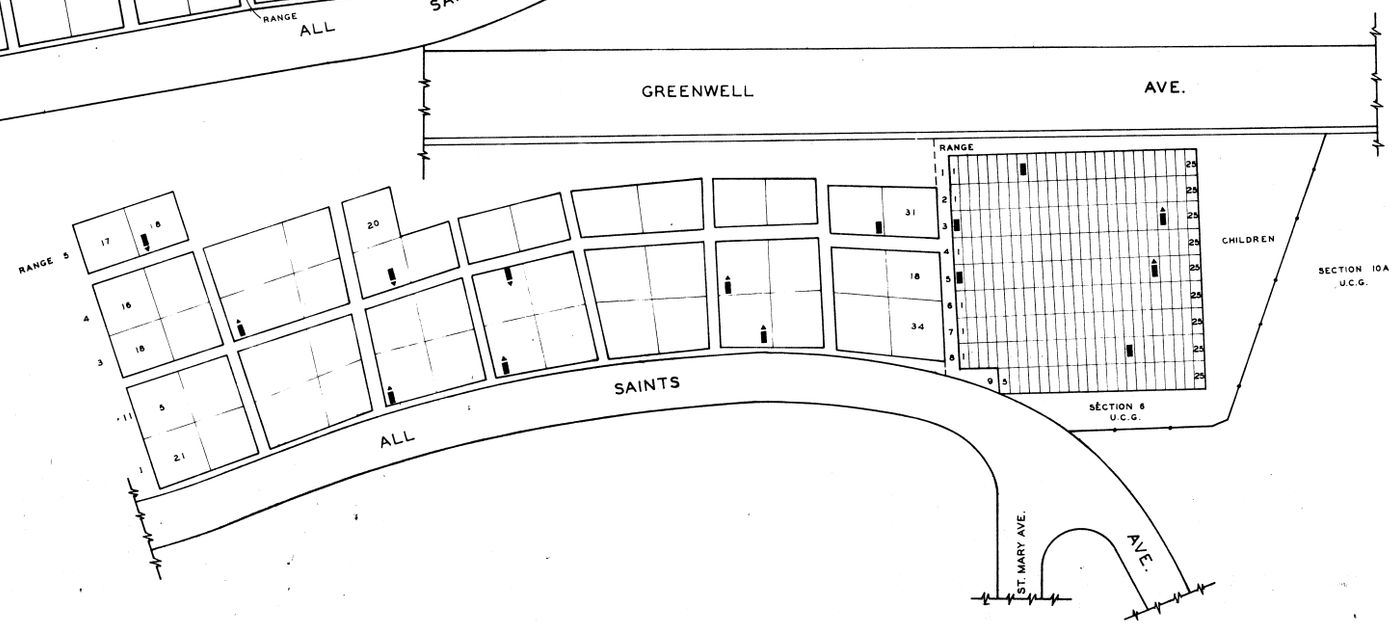

SECTION 6
SCALE 1"- 20'

ST. JOSEPH NEW CEM.
PAGE. 390

RANGE	LOT	GRAVE	WAR	NAME
3	7		19	BUTLER WM. C.
6	14		19	CAHILL JOHN.
3	6	5	19	CALVERT WM.
4	4	10	19	CARNEY JOHN
6	11		31	CARVILLE JOHN J.
7	10	1	31	CASTELLINI WALT. C.
8	5	11	31	COLE JOHN W.
8	7	7	19	DELANEY JOHN
6	19		31	DELANEY THOS. E.
2	12	3	19	EARLEY JAS. ALIAS JAMES CARNEY
1	11	10	19	FERGUSON ROB'T. J.
6	4		19	FLANAGAN THO'S.
7	2	4	31	FOGARTY LAW.
5	3		19	GLEASON PAT'K.
8	8	10	19	HEFFERMAN WM.
1	22	9	19	KELLY MARTIN
3	18	7	19	KELLY WM.
1	7		19	LUNEM DENNIS JOHN
3	21	8	19	LYONS MICHAEL

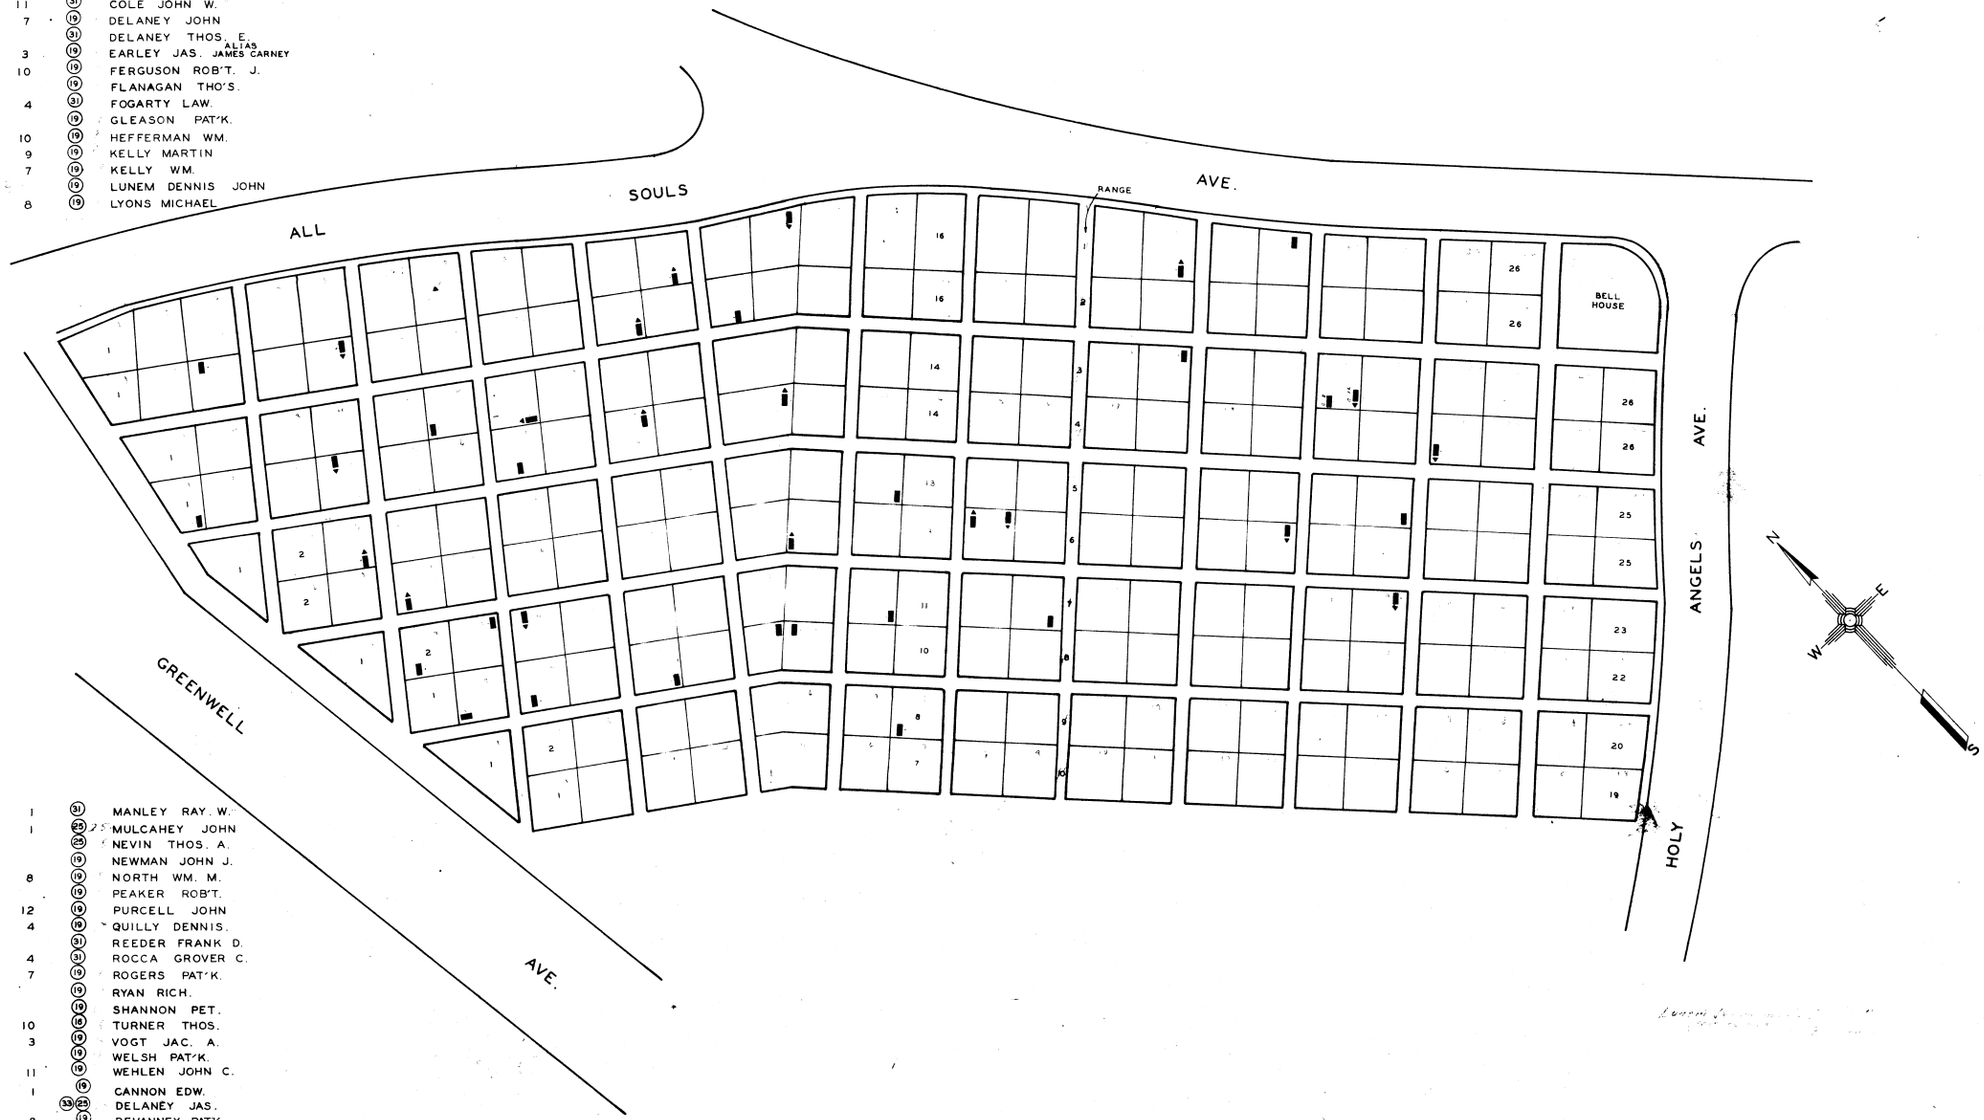

6	21	1	31	MANLEY RAY. W.
5	12	1	25	MULCAHEY JOHN
2	10		25	NEVIN THOS. A.
1	13		19	NEWMAN JOHN J.
4	9	8	19	NORTH WM. M.
2	5		19	PEAKER ROB'T.
3	21	12	19	PURCELL JOHN
4	7	4	19	QUILLY DENNIS.
4	23		31	REEDER FRANK D.
8	3	4	31	ROCCA GROVER C.
7	3	7	19	ROGERS PAT'K.
1	20		19	RYAN RICH.
6	14		19	SHANNON PET.
2	3	10	16	TURNER THOS.
7	13	3	19	VOGT JAC. A.
7	19		19	WELSH PAT'K.
7	4	11	19	WEHLEN JOHN C.
4	1	1	19	CANNON EDW.
8	2		33 25	DELANEY JAS.
4	11	8	19	DEVANNEY PATK.
9	8	4	19	HEENEY PET.

SECTION 7
SCALE 1' 20"

RANGE	LOT	GRAVE	WAR	NAME
3	33		19	BRANNAN LUKE
4	10		31	BREARTON EDW. J.
6	29		19	CAIN PAT'K.
17	7	9	31	CLARK W. T.
6	27	1	19	CALLAGHAN EDM.
6	27	8	31	CALLAGHAN JOS. B.
17	7	6	31	CLARK WES. E.
15	16		19	CONRAD JOHN
16	19		31	COOK WM. H.
13	26	4	31	COSTELLO RAY. H.
13	26	3	31 33	COSTELLO THOS. J.
3	23		19	COUGHLIN JOHN
1	14		31	DAVIS J. M.
4	24	11	26	DELANEY JOHN A.
2	32	10	31	DERMODY DAN'L.
2	32	9	31	DERMODY H. W.
2	32		31	DERMODY JOS. D.
2	18		31	DIVER JAS. F.
17	14		31	DOBB WM. H.
16	35	7	31	DUGAN MARTIN S.
17	1		31	DUNCAN RICH.
4	9-A		25	DUNNE JOHN
3	25		25	DWYRE DAN'L.
18	17		31	FARRELL JOHN J.
17	15		25	GLEASON THOS. A
16	15		31	GRADY J. J.
1	13.		31	HALPIN WM.
16	16		31	HARRIGAN CHAS.
16	11		31	HERING AL. G.
6	15		31	HUNT J.E.

RANGE	LOT	GRAVE	WAR	NAME
1	19		31	MULLEN JAS J.
14	23		31	MURPHY FRANK D.
18	23	12	31	MURPHY MICH'L. J.
3	20		19	MURRAY DAV.
3	9		19	NEY FRED'K
4	10	4	19	NOLAN DAN
8	27	8	19	PARIS ALEX. S.
2	15	8	31	PARKER THOS.
6	16		31	PLUCKEBAUM C. L
15	32	8	31	RYAN MARTIN
14	20	17	31	SARRAINO PASQUALE

RANGE	LOT	GRAVE	WAR	NAME
13	24		31	BRODERICK JAS. E.
17	26		33	MAYER LEO
3	13		19	MUGAVIN THOS.
18	26		31	FORTUNE W. J.

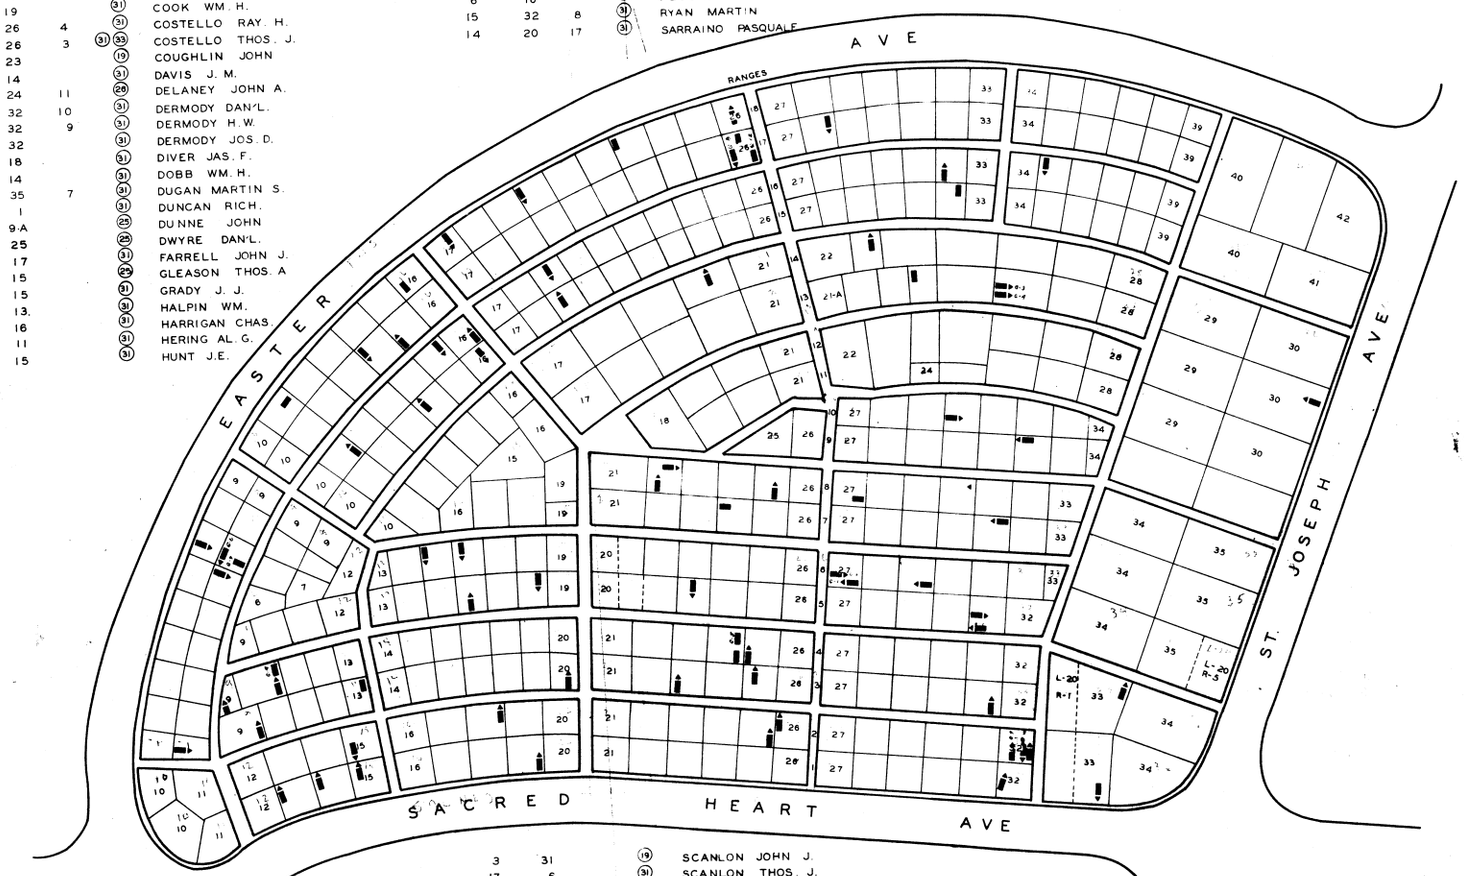

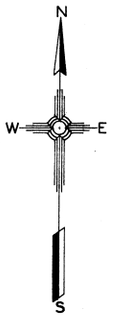

3	31		19	SCANLON JOHN J.
17	6		31	SCANLON THOS. J.
9	32		25	SCHENK C J.
2	25		31	SMITH JOHN P.
10	30		31	TRACEY THOS J.
2	26		31	TRAINOR ALB. F.
18	16	5	19	WRIGHT J W.
17	26	12	25	WUEST GEO

8	30	MEMO.	31	KAVENEY ALF.
12	30		19	LEONARD LUKE
1	15		31	LORRIGAN J. F.
8	22		31	MAISENHALTER JOHN J.
1	32		19	MAKAR JOHN
18	20		31	MALONE J. M
17	28	8	19	MALONEY MICHL.
5	16		31	MALONEY WM. A.
17	26	8	19	MARONEY JOHN
16	32	8	19	MARTIN JOHN T.
4	25		19	McCABE PAT.
5	23		31	McGINNIS CHAS. J.
15	14	7	19	McGUIRE JAS.

18	7		31	AUFDERHEIDER JOS.
5	31		31	BAEHR LEO. R.
8	25		31	BARTLEY DAN'L. JR.
5	18		31	BERNING FRANK P.
5	31	1	31	BAEHR ALLEN M.
7	24	5	31	BRODERICK WALT.
15	19	8	31	CLOUD JOS. F.
4	24	5	19	HIGGINS THOS.
1	33	15	19	SCULLY M. P.
8	22	11	31	SCHONEFELD WALT. P.
18	11	10	31	SULLIVAN EDW.
7	31	2	31	McHUGHES JAS.

SECTION 8
SCALE 1"=20'

ST. JOSEPH NEW CEM.
PAGE 392

RANGE	LOT	GRAVE	WAR	NAME
5	13		31	AGNESS JOHN A.
4	21		31	BEIS HOWARD J.
6	49		31	BRADHOLD WM.
6		118	31	BRANDHORST ALB.
5	42	6	31	CAHILL WM. P
6	12		25	CHATTEN H. B.
6		142	31	CHEEVERS FRANCIS
4	52	6	31	COLLINS ART. W. J.
5	10	1	31	CORCORAN FRANK F.
6		68	31	CURTIN WM. H.
3	33		31	DE'ANGELO ROSARIO
5	52		19	DIEMAR CONRAD
5	29	8	33	DONNELLON JAS.
6	23		31	EVANS JOS. J.
4	34		31	FINLEY JOHN P.
4	17		31	FINLEY JOS. T.
6		128	31	FRANCIS WM. J.
6		298	25	GUERTLER GEO. J.
3	6	8	31	HARRINGTON JOHN P.
3	12		25	HAVLIN JOS. F.
5	37	9	31	HENRY CARL T.
6		336	31	HENNIGEN JACOB F.
4	50	2	31	HOGAN RAY.
5	12	12	31	HUGHES JAMES
4	49		31	KAYATO THOS.
5	56	6	31	KEEFE ELM. J.
3	15	2	31	LEONARD B. E.
5	23	5	31	MACK EDW.
6		227	31	McDONALD DAN'L. W.
5	31	8	31	McGUFF JOHN
6	53	9	31	McGUIRE JOHN W.
6		45	31	McKENZIE JOS.
3	15		31	MULLEN PAT'K.
5	9		31	MULVANEY EDW. H.
4	6	2	19	MURRAY JOHN
6	34		25	MYLOR PAT'K.
5	19		31	NORTON GEO. C.
2	8		31	O'BRIEN C.
4	44	1	31	O'LEARY JOS. C.
4	4	12	31	PRENDERGAST M. T.
4	28	11	31	ROSS NICH. C.
3	5		31	ROWAN JOHN P.
3	8		31	SCOTT WM. C.
4	14		31	SCULLY ADOLPH
4	9	4	25	SULLIVAN DAN'L.
3	32	5	25	SULLIVAN MICH'L.
6		168	31	SYLVESTER ALB'T. F.
4	22		31	TODD JOHN J.
6	5	6	31	VEID ALB'T.
6	14	4	31	VOSS JOHN C.
4	52	4	31	WALKER ALB'T.
5	50		31	WESSLING EDWIN F.
5	25	8	28	WALSH EDW. P.
5	38	1	31	CLANCY JOHN W.
6	23	5	31	EVANS JOHN E.
5	52	2	31	HERBORT EDW. M.
6	34		31	KRUSE WM. A.
5	32	2	25	McDONALD JNO. P.
5	22	6	31	McGRATH EDM.
5	50	5	31	MEYER ALB. R.
5	19	8	31	NORTON LAW.
5	28		19	PODESTA BARTHOLOMEW
4	6	4	31	KANE JAS.

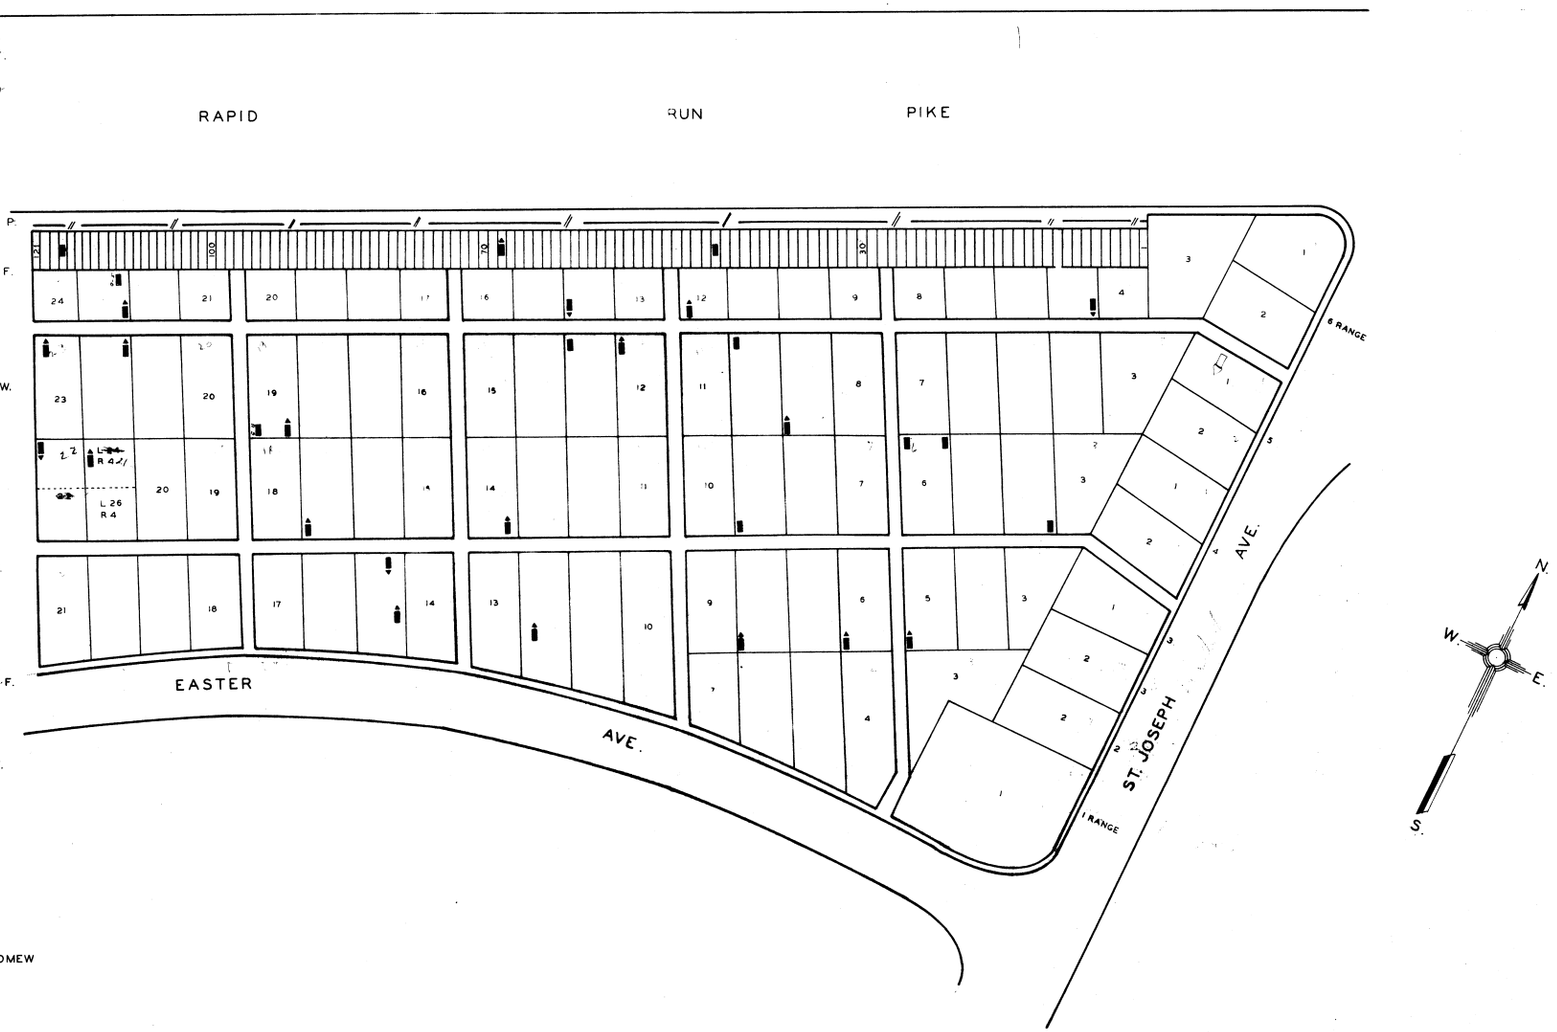

PART OF SECTION 10
SCALE 1" = 20'

ST. JOSEPH NEW CEM.
PAGE 393

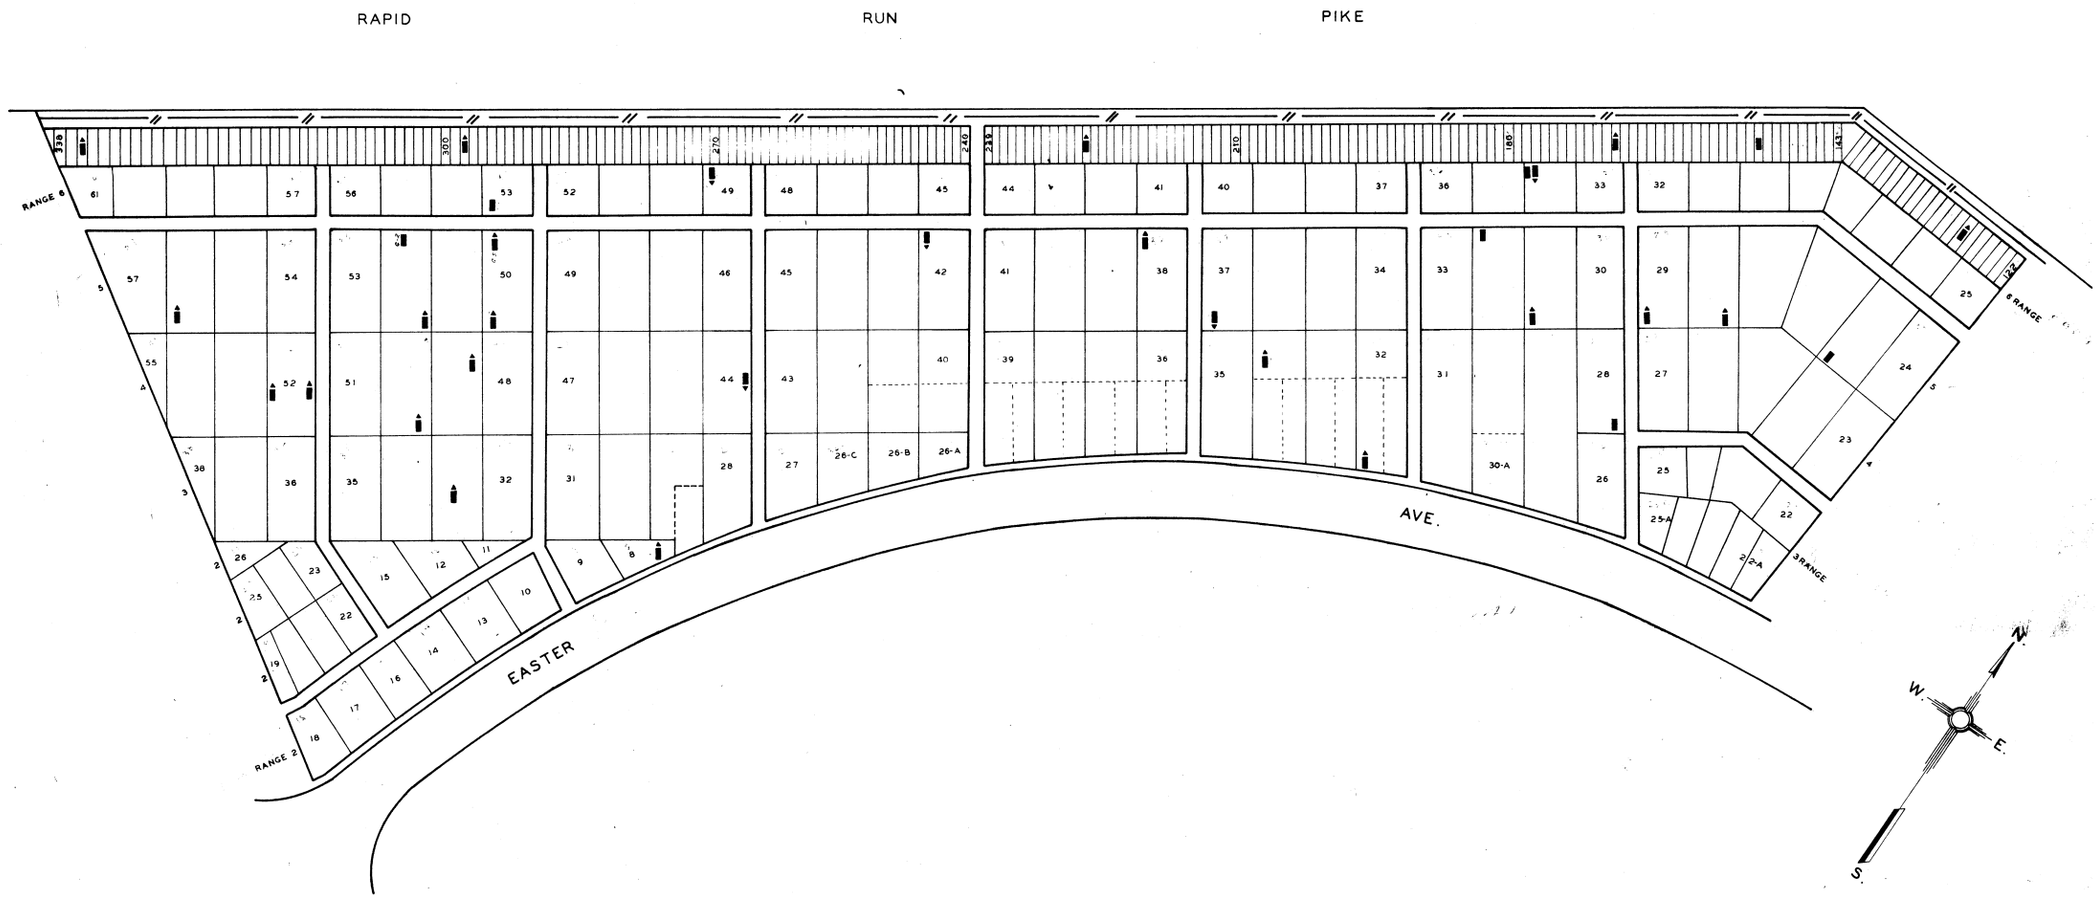

PART OF SECTION 10
SCALE 1" = 20'

ST. JOSEPH NEW CEM.
PAGE 394

RANGE	LOT	GRAVE	WAR	NAME
11	6	7	18	ADAMS HENRY
6	2		31	BEEKLEY C. JOS.
7	3		31	BILLOW FRANCIS A.
3	4		31	BOHAN DAN'L. P.
12	19	3	19	BUCKLEY JAS.
8	5	8	19	BUSCH CHRIS.
13	27	7	31	BYRNE JOHN F.
6	9	11	31	CALLABRO STE'P.
7	12		19	CHILL JAS.
6	13		19	CONNELLY JOHN K.
6	16	12	19	CONROY FRANK
9	11		19	DECKER WM.
8	23		31	DOWLING EDW. J.

RANGE	LOT	GRAVE	WAR	NAME
4	4	11	31	BRITT JAS. J.
9	6	7	31	BUTLER MICHL.
9	12		33	ROACH JOS. E.
9	10	8	31	CARROLL CECELIA ANNA (NURSE)
7	8	11	19	CRAMBERT JOHN G.
8	22	12	26	McNAMARA THOS.

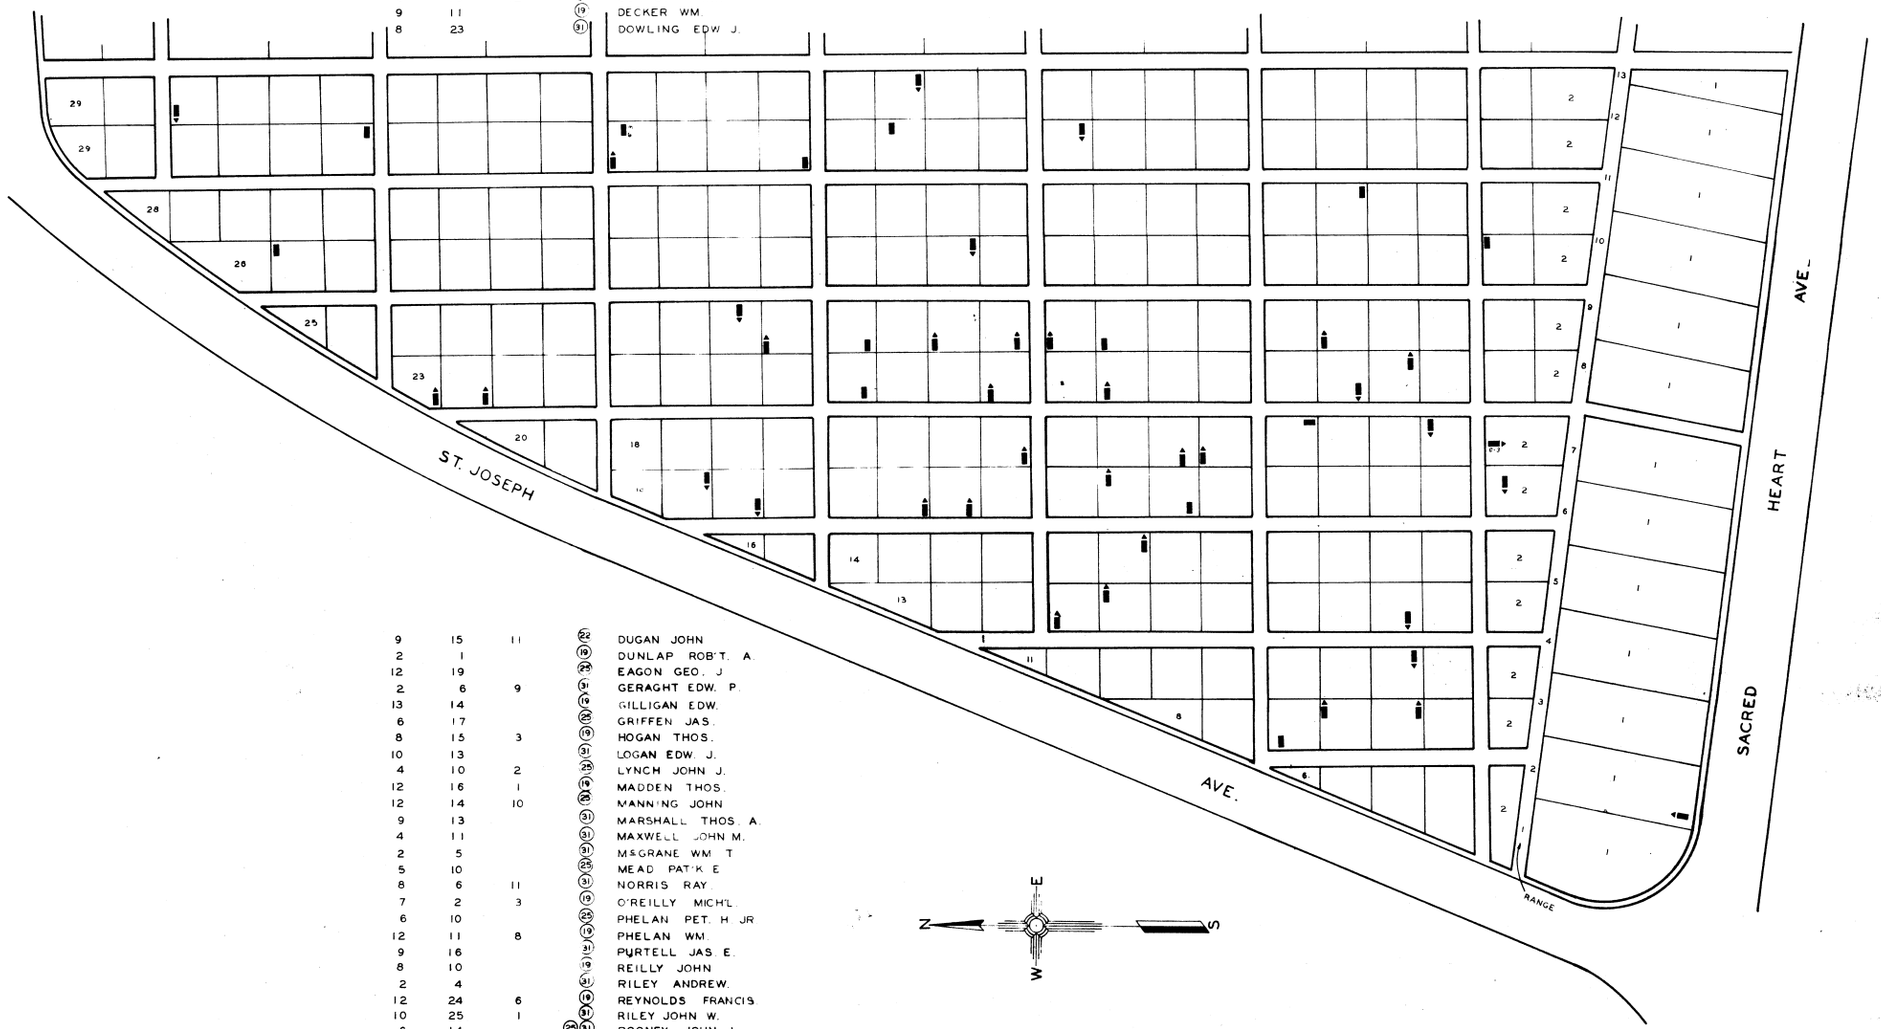

9	15	11	22	DUGAN JOHN
2	1		19	DUNLAP ROB'T. A.
12	19		22	EAGON GEO. J
2	6	9	31	GERAGHT EDW. P.
13	14		22	GILLIGAN EDW.
6	17		22	GRIFFEN JAS.
8	15	3	19	HOGAN THOS.
10	13		31	LOGAN EDW. J.
4	10	2	31	LYNCH JOHN J.
12	16	1	19	MADDEN THOS.
12	14	10	20	MANN'NG JOHN
9	13		31	MARSHALL THOS. A.
4	11		31	MAXWELL JOHN M.
2	5		31	McGRANE WM. T
5	10		25	MEAD PAT'K E
8	6	11	31	NORRIS RAY
7	2	3	19	O'REILLY MICH'L.
6	10		25	PHELAN PET. H. JR
12	11	8	19	PHELAN WM.
9	16		21	PURTELL JAS. E.
8	10		19	REILLY JOHN
2	4		31	RILEY ANDREW.
12	24	6	19	REYNOLDS FRANCIS
10	25	1	31	RILEY JOHN W.
6	14		28 31	ROONEY JOHN J.
9	17		31	ROSS THOS. J.
8	12		19	SHAY JOHN
10	3	1	19	VENTURINO DOM'K. J.
7	6	2	19	WALKER CHAS.
7	7	7	19	WATSON JOHN

SECTION 11
SCALE 1" 20'

RANGE	LOT	GRAVE	WAR	NANE
5	27	12	31	ALT JOS. A.
4	9		19	BECK CHAS. H.
2	13		31	BOYLE JOHN A.
6	7		19	BRIGEMAN GEO.
1	24	3	31	CAMPION WM. L.
5	27	3	31	CASSIDY EDW. J.
6	27		31	CASSIDY MICH'L. J.
9	10	8	19	CLARK JAS. J.
4	4		19	CRIPPS JOHN
1	17		19	CROWLEY MICH'L.
9	11	4	19	FARRELL JAS.
3	9	4	19	FLANAGAN THOS.
3	9	6	33 31	FLANAGAN THOS. J.
11	6		29	GORMLEY THOS.
6	9	12	31	GOUGH J. E.
2	16		19	GRAHAM ART. A.
1	9	4	31	HALPIN J. G.

RANGE	LOT	GRAVE	WAR	NAME
8	11	6	25	O'KEEFE WM. C.
7	8		31	ORAWE H. J.
2	7		31	PETIT EDW.
9	11	3	31	PHARES CHAS. M.
4	8	8	25	REGAN C. J.
8	23	12	25	ROBERTSON WM. W.
5	4	12	31	RYAN FRANK
5	4	11	31	RYAN WM. P.
5	21		31	SCAHILL JOHN W.
7	4		25	SIMMONS CHAS. C.
4	26		31	SMITH THOS.
3	11	4	31	STANLEY JOS.
7	21	1	19	STAPELTON JAS.
8	29		19	THOMAS WM. H.
9	8	6	31	TIERNEY PHIL. R.
6	5		31	WELSH JOHN JR.

RANGE	LOT	GRAVE	WAR	NAME
8	21	9	33	GILLICE CHAS.
1	7	4	33	O'CONNELL JAS.
2	5		33 25	HARRIGAN JNO.
2	15		19	LE GENDRE JOS. A.
5	10		33	WILLIAMS WM.
8	2		25	O'HARA THOS.

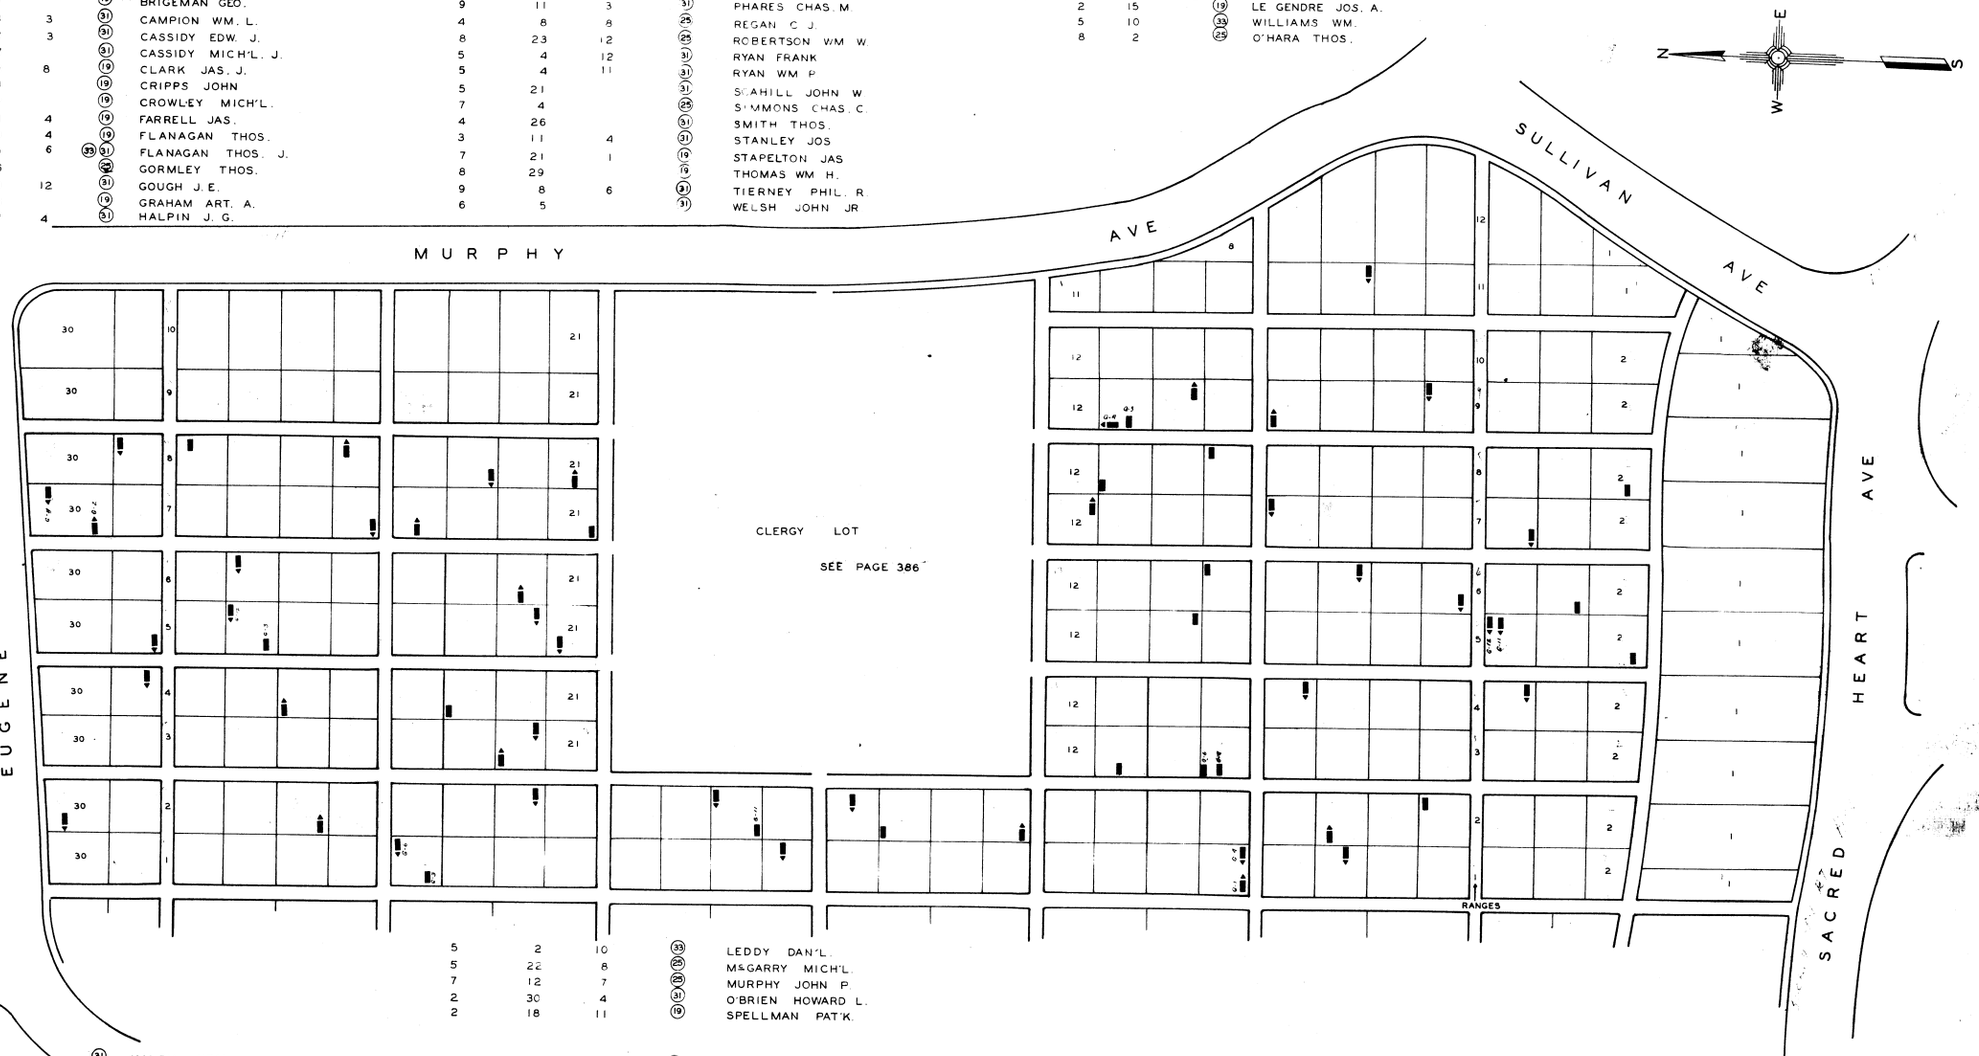

5	2	10	33	LEDDY DAN'L.
5	22	8	29	McGARRY MICH'L.
7	12	7	29	MURPHY JOHN P.
2	30	4	31	O'BRIEN HOWARD L.
2	18	11	19	SPELLMAN PAT'K.

1	9		31	HALPIN NEAL J.
2	22		19	HOWARD MICH'L.
6	22		19	HOWARD THOS.
7	25		19	JACOBS CHAS. E.
5	29		19	KENNEY PATK. J.
8	28	10	19	LINEHAN JOHN
7	30	11	31	McCORMICK M. J.
7	30	2	31	McCORMICK PATK.
8	9	1	19	McCOY HUGH
1	24	6	31	McGUIRE STEP'H.
2	26		31	MURPHY THOS. J.
7	24		31	NELSON CLIFF. J.
6	3	3	19	O'BRIEN PAT'K.
9	5		19	O'CONNELL EDM.
2	18		31	O'CONNELL DAN'L. C.

5	2	10	33	~~LEDDY DAN'L.~~
5	22	8	29	~~McGARRY MICH'L~~ Shep
7	12	7	29	~~MURPHY J.C.~~
2	30	4	31	~~OBRIEN H.L.~~
2	18	11	19	~~SPELLMAN~~ PAT.

4	23	6	31	COPPINGER PAUL A.
8	25	10	19	SEXTON PAT'K.
3	22	7	31	SCHELKEUS CLIFF.

SECTION 12
SCALE 1"–20'

RANGE	LOT	GRAVE	WAR	NAME
1	24	5	19	ANDERSON WM.
4	28		19	BARRETT JAS.
16	2	6	19	BOLAN MICH'L.
16	2	3	19	BOLAN PAT.
6	41		19	BOUGHAN MALACHI
4	29		19	BRADY JAS.
15	5	1	19	BRINKERT HENRY
10	13		31	BURNS ROB'T. J.
1	29	8	19	CAIN JACK.
8	14	8	19	CANNON TIM.
5	36	2	16	CASSIDY JAS.
16	6		19	CHRIST JAS. E.
2	10	2	19	CLANCEY JAS.
6	1-A		19	COGAN J. H.
4	35		19	COMER JOHN H.
9	37		19	CONWAY A. J.
5	32	3	19	COSTELLO MICH'L.
14	22	2	19	CRAWFORD ALF. W.
13	19	6	19	CRONIN ANDREW
16	13	10	19	CUNNINGHAM WM
3	2		19	DAUGHERTY PAT'K.
5	21		19	DAVIS WM. M.
8	39	13	19	DONOHUE MICH'L.
1	35	1	19	DRURY JOHN
8	25	2	19	DUFFY JAS.
5	24	1	19	EGAN JOHN
3	15		19	ETTER LAWR.
4	41		31	EVERSFIELD EDWIN J.
9	7	3	31	FALLON JAS. W.
6	23	10	19	FARRELL FRANK
15	3		25	FAY JAS. M.
9	8		19	GALLAGHER PAT'K.
5	2		19	GILLESPIE ROB'T. L.
12	10		25	GRAHAM JOS. A.
1	40		31	GRIFFIN HOWARD. J.
5	13	5	19	HARNEY JOHN
4	31	5	19	HARRISON JOHN S.
5	34	12	19	HESTER THOS.
1	28		19	HOWARD THOS.
15	10		19	KINSELLA JOHN
2	2		19	LISTON JOHN
9	10	3	19	LONG WM.
6	25	5	19	LYONS JOHN
14	5	7	19	MADDEN JAS.
12	18	4	19	MANIX PET.
4	9		19	MANNS JOHN A.
10	32		25	McCUE WM.
13	23	4	19	McDONALD MICH'L.
10	32		19	McHUGH MICH'L.
16	14	1	19	McLAUGHLIN JOHN
6	11		31	McMANAMAN HARRY
12	21	3	19	McNALLY JOHN
1	41		16	MOORE JOS.
12	13	6	25	WADE THOS. J.
6	37		31	MOORHEAD GEO.
4	4		31	MORIARTY ALF. J.
7	3	2	31	MULCAHY JAS.
7	3		31	MULCAHY JOHN
4	42	12	31	OCONNOR FRED'K.
8	30		31	PURCELL P. J.
10	24	10	31	QUIGLEY JAS. A
			31	QUIGLEY WM. P.
14	1-A		31	REDDINGTON MARTIN
6	25	8	19	REDMOND M. J.
5	23		19	REED JOHN
15	6		19	RICE JOHN
9	2	2	25	SCHULTE GEO. H.
1	33		31	SPILLE E. W.
1	33		31	SPILLE JOHN C.
3	21	4	31	SULLIVAN JOHN D.
5	11	5	16	TRACY WM.
10	36		31	TYRRELL RICH.
3	14		31	VALE JOHN L.
10	22	2	19	WADE JAS.
7	38		19	WARD JAS.
2	26		19	WENTWORTH WM. A.

RANGE	LOT	GRAVE	WAR	NAME
10	9		19	CONWAY JOHN
9	20		19	HALEY JOHN
4	23	12	19	KENNEDY JAS.
11	29	7	31	McANDREWS T. F.
9	28	1	31	MONAHAN EARL
12	29	3	19	MOORE JOHN
7	16	9	31	MORTHORST LAW. B.
7	9	4	19	O'NEILL JOHN
3	34	8	19	REYNOLDS JAS.
8	34	10	19	RUSSELL JAS.
8	27	5	19	RYAN JOHN
8	15	5	19	SMALLWOOD SAM'L. N.
11	10	9	19	WOODS JAS.
12	16	2	19	WYNNE JOHN
10	34	4	19	BICKET FRANCIS
7	23	7	19	BURNS GEO. H
2	40		31	CONNETT RAY. E.
15	8	6	25	CRIBBINS JOHN P.
11	11	7	19	GALLAGHER HUGH
11	14	4	19	GALLAGHER JOHN
9	33		16 19	HARRINGTON DAN'L.
9	6	7	19	KELLEY EDW.
12	29	1	19	KINSELLA WM.
6	30	11	19	LEE DAV'D.
2	5	1	19	MALONEY MICH'L.
2	39	4	19	MARSHALL JAS.
7	5	7	19	SHERIDAN JAS.
10	31		25	WHITNEY WM.
2	22		25	CRIPPS JOS. C.
4	7	12	31	MAHAN PAT. F.
16	10	12	31	RIGNEY WM. T.
13	6	11	31	SHARKEY EDG. P.
6	1-A	3	25	COGAN JOHN T.
1	32	12	33	KOCH JULIUS J.
11	23-27	?	25	CONWAY EDW.
3	32	?	19	MEHAN EDG. B.
10	2		19	COSGROVE PAT'K.
2	3	10	31	MITCHELL JNO. R.
			25	ANDREWS JNO

SECTION 13
SCALE 1-20'

ST. JOSEPH NEW CEM.
PAGE 397

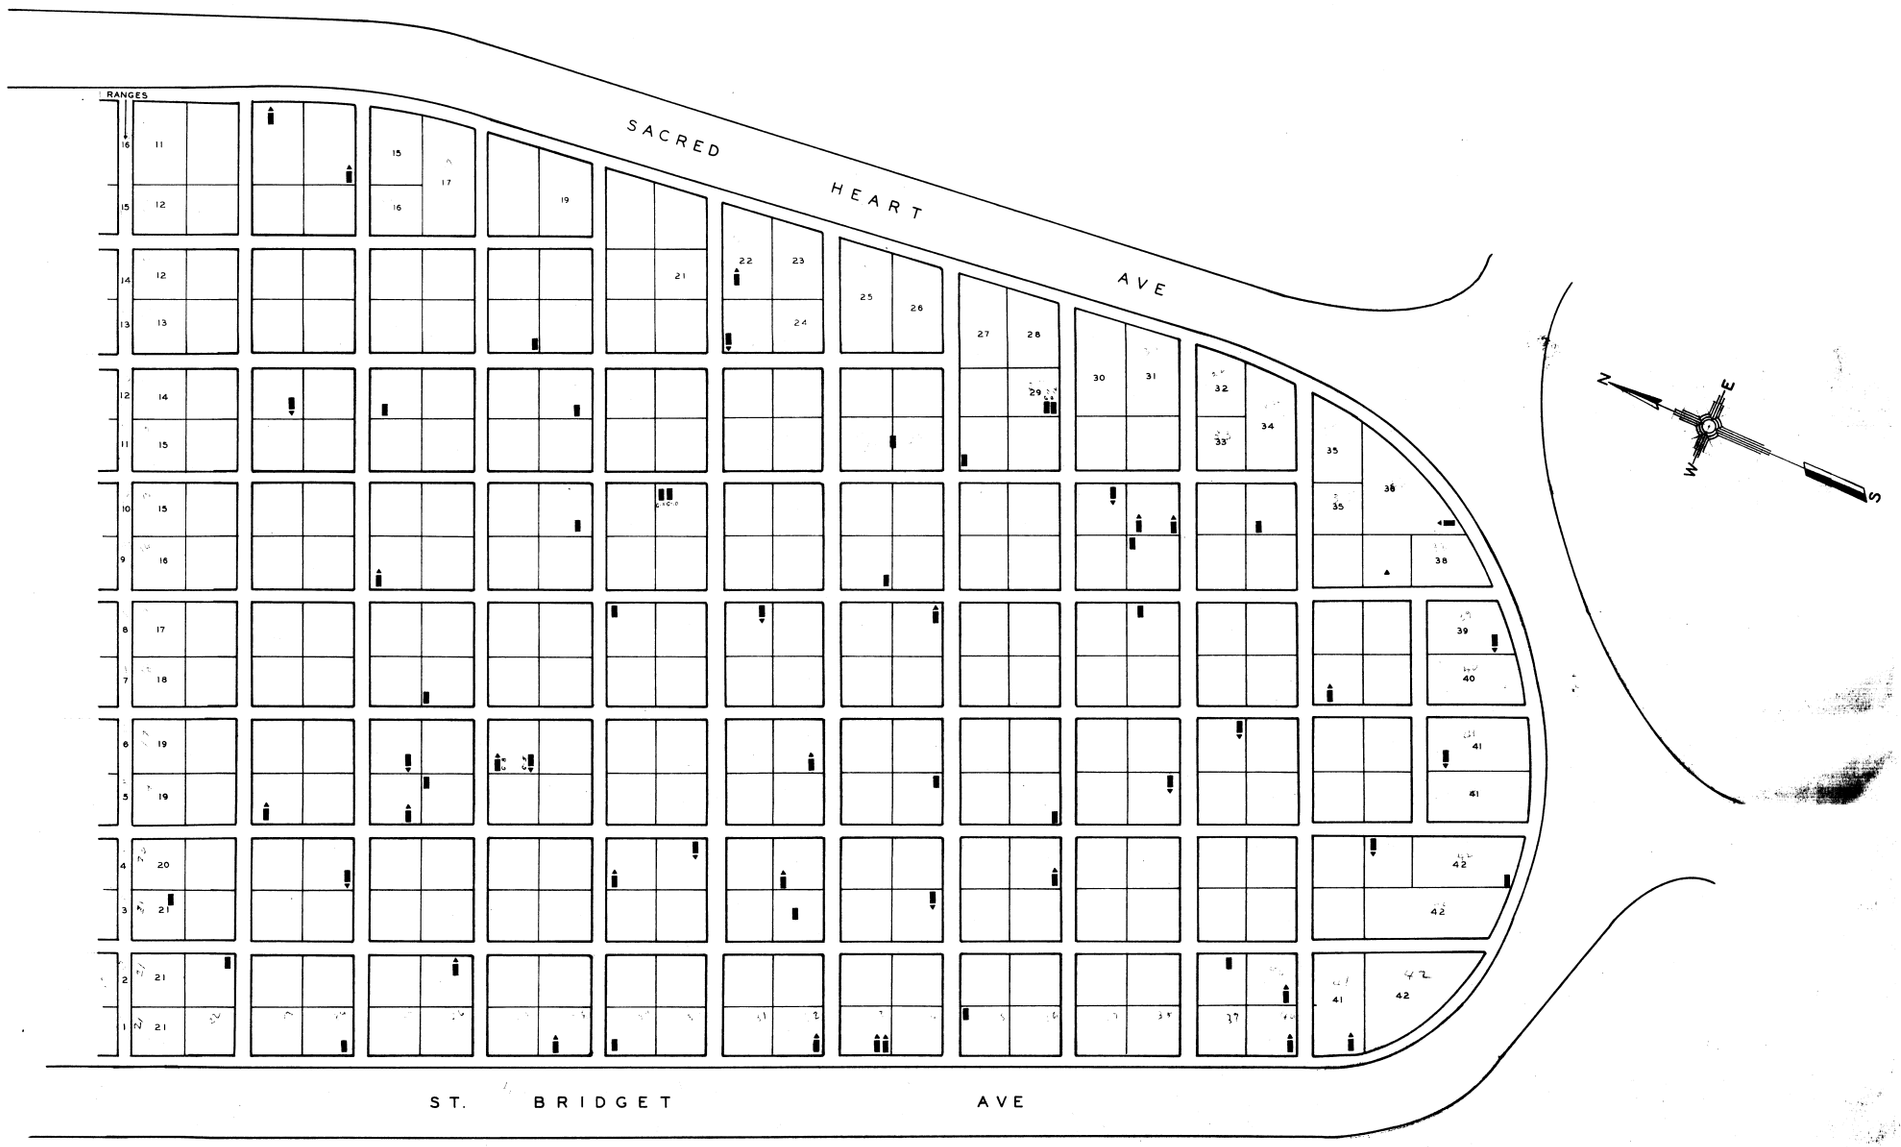

SECTION 13
SCALE 1"=20'

ST. JOSEPH NEW CEMETERY
PAGE 398

RANGE	LOT	GRAVE	WAR	NAME
24	3	3	19	ABBOTT THOS. D.
6	11	10	19	BARRETT FIRMAN
1	3		25	BENN THOS.
16	2		19	BOYLE JOHN
17	17		31	BREEN EDW. J.
1	3-A		19	BRENNAN MICHL.
13	15		19	BURKE PAT.
7	1-A	3	19	BURKE WM. J.
6	4	9	19	BUTLER WM.
18	14		19	CAIN WM. F.
20	7	8	19	CARNEY JAS.
16	8	7	19	CONNERS MICH'L.
10	5	8	19	COSGROVE JOHN
14	3	8	19	CRAFT JOHN
15	14	7	19	CRANE JOHN B.
13	21		19	DONNELLY JAS. P
14	4		31	DORSEY JOS. M.
16	15		19	FALLS JOHN
16	9		19	FEENY JOHN
11	15		19	FLAHERTY JOHN
10	17		31	GEERIN JOHN
17	6	1	19	GLENN PAT.
13	10		19	GRAHAN JOHN
8	3		19	GREYHAM MARTIN
17	4	11	19	HART JOHN
8	16		19	HASSELLHOFF FERD. R
8	7		19	HAYES JAS.
5	14		19	HERBERT ALEX.
5	14		19	HERBERT CHAS.
17	3	10	19	JOHNSON SAM'L.
3	2		19	LAND WM.
8	2	3	19	LYNCH MICH'L.
17	13	10	19	MAHLER ANTON
13	16	5	25 31	MALLOY DAN'L.
13	3	10	25	MARTIN HARRY
23	4		19	McDERMOTT PET.
5	7	1	19	McDONOUGH JOHN
5	7	8	19	McFADDEN JOHN
12	5	7	31	McKEON M. J.
9	11		19	MULKERN THOS.
9	7	1	19	MULLARKY FRANK.
3	5	8	19	MURPHY FRANK
4	7	8	19	MURRAY JOHN
6	13	7	19	NICHOLAS R. L.

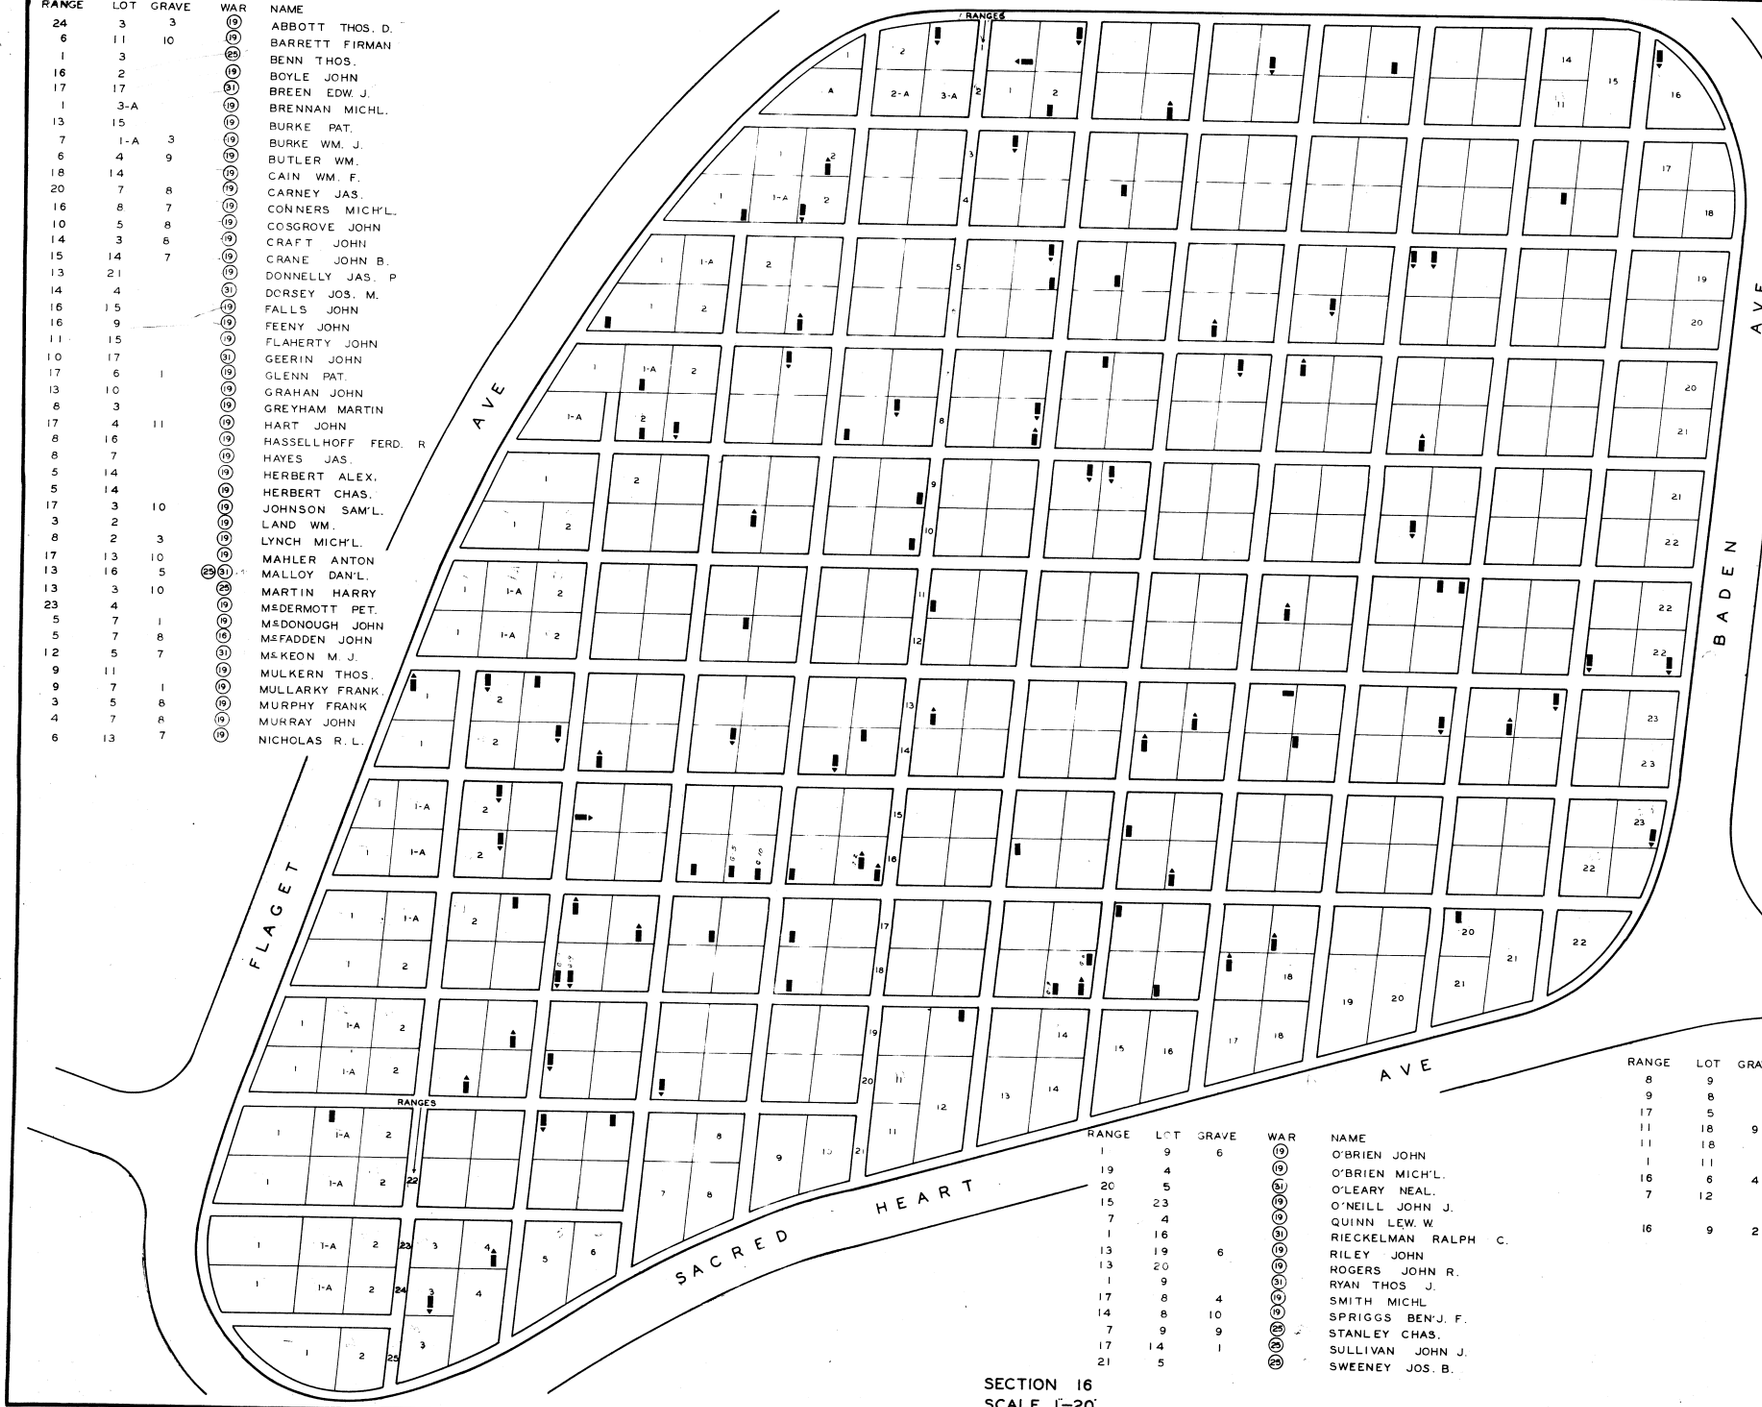

RANGE	LOT	GRAVE	WAR	NAME
16	7	10	31	ANDERSON JOHN
18	9	9	19	BRENNAN PAT.
21	1-A	9	19	DUNLENY PAT.
16	7	5	19	DUNN THOS.
6	1	4	33	FARAGHER EDW.
4	15	8	19	HUDSON JOHN
14	6		19	LYSAGHT PAT'K.
10	8	7	19	MULLEN BARTLEY
17	20	3	33	NEAGLE THOS.
18	14	6	25	WALSH MICH'L. F.
18	14	9	25	WALSH WM. J.

RANGE	LOT	GRAVE	WAR	NAME
2	1	3	31	BAIL FRANK
15	2	8	19	BLEVINS REIL
4	1	1	33	DICKMAN BERNARD
20	3		19	DUNNING WM. P.
18	5	9	25	DWYER DAN'L. F.
18	5	7	25	DWYER WM. F. ALIAS WM. ADAMS
5	14	2	19	GREEN B.
19	12	9	25	HALL JOHN
12	21		19	HEARNE JOHN J.
4	2	7	31	KENNEDY JOHN J.
18	17		31	MAHONEY EDW. J.
14	17	1	19	MAHON PAT'K.
13	2	11	19	MARTIN PHIL.
15	4		19	McCARREN JOHN H.
13	1	12	31	McDONOUGH JOS. E.
2	4		31	McHALE DAN'L.
18	16		33	McNEEVE MICH'L.
12	22	11	31	REYNOLD HOWARD
21	6	4	19	SCHAEFER WM. M.
5	8	1	31	TOBIN WM. J.
14	9	10	25	TOMPKINS HARRY L.
8	6	5	31	WASHBURN WM.
1	5		25	BULMER JNO. H.
9	10		31	HIGGINS HARRY M.
16	12		19	CONNERS PAT'K.

RANGE	LOT	GRAVE	WAR	NAME
1	9	6	19	O'BRIEN JOHN
19	4		19	O'BRIEN MICH'L.
20	5		31	O'LEARY NEAL.
15	23		19	O'NEILL JOHN J.
7	4		19	QUINN LEW. W.
1	16		31	RIECKELMAN RALPH C.
13	19	6	19	RILEY JOHN
13	20		19	ROGERS JOHN R.
1	9		31	RYAN THOS J.
17	8	4	19	SMITH MICHL
14	8	10	19	SPRIGGS BEN'J. F.
7	9	9	25	STANLEY CHAS.
17	14	1	25	SULLIVAN JOHN J.
21	5		25	SWEENEY JOS. B.

RANGE	LOT	GRAVE	WAR	NAME
8	9		31	TAGGART MICHL. J.
9	8		31	TIGHE JOHN
17	5		25	WALK JOS.
11	18	9	19	WALSH MICH'L.
11	18		25	WALSH WM. J
1	11		19	WARNOCK JOHN
16	6	4	19	WATERS JOHN H.
7	12		19	ZEH FRANK
16	9	2	19	FEENEY GEO.

SECTION 16
SCALE 1"–20'

ST. JOSEPH NEW CEM.
PAGE 399

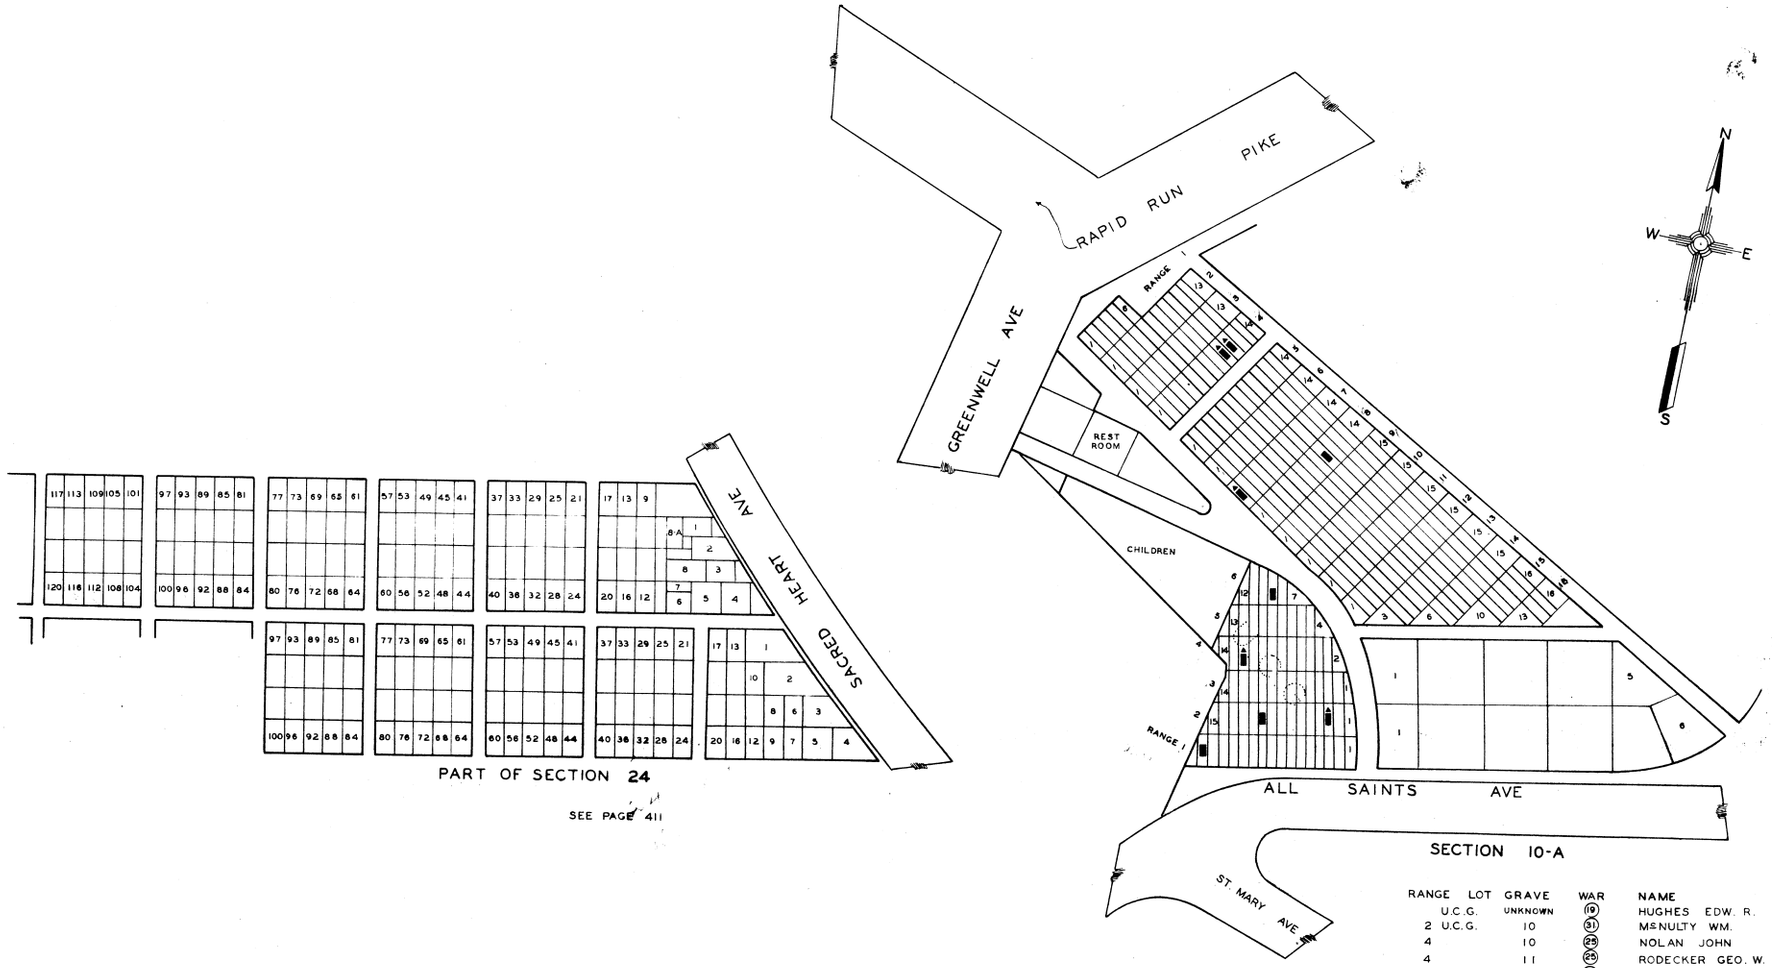

PART OF SECTION 24

SEE PAGE 411

SECTION 10-A

RANGE	LOT	GRAVE	WAR	NAME
	U.C.G.	UNKNOWN	19	HUGHES EDW. R.
2	U.C.G.	10	31	McNULTY WM.
4		10	25	NOLAN JOHN
4		11	25	RODECKER GEO. W.
2	U.C.G.	3	31	SCHERER FRANK L.
7		1	31	FROMMEL WM. M
6	U.C.G.	9	31	HOLLMAN RAY
1	U.C.G	16	31	LAWSON ALF.
8		10	31	ARRIGO CHAS.
4	U.C.G.	12	31	BATCHELOR GEO.

SCALE 1" 20'

RANGE	LOT	GRAVE	WAR	NAME
14	32	6	31	ABELING HARRY
5	16		31	BURNS ROB'T. P.
4	7	8	31	CLARK LEO F.
4	14		31	D'ONOFRIO ALVIN
2	8		31	GARVEY JOS. M.
2	8	8	29	GARVEY M. E.
1	9		31	GERKAN W. J.
5	16	1	31	GILLIGAN JOHN J.
3	21	8	19	HOPE JOHN E.
1	18		31	KRATZ WM. J.
4	18	7	19	MADDEN WM.
2	13		31	PECHINEY WM. A.
10	18	8	29	REINHARDT CHAS. R.
12	16		31	SHANNON JOHN B.
14	22		31	VONDOHRE ART.
14	31	4	31	HINES JOHN J.
2	14		31	LEONARD GEO.
15	34	5	33	SCACCARELLI P. J.

SECTION 14
SCALE 1" 20'

ST. JOSEPH NEW CEM.
PAGE 401

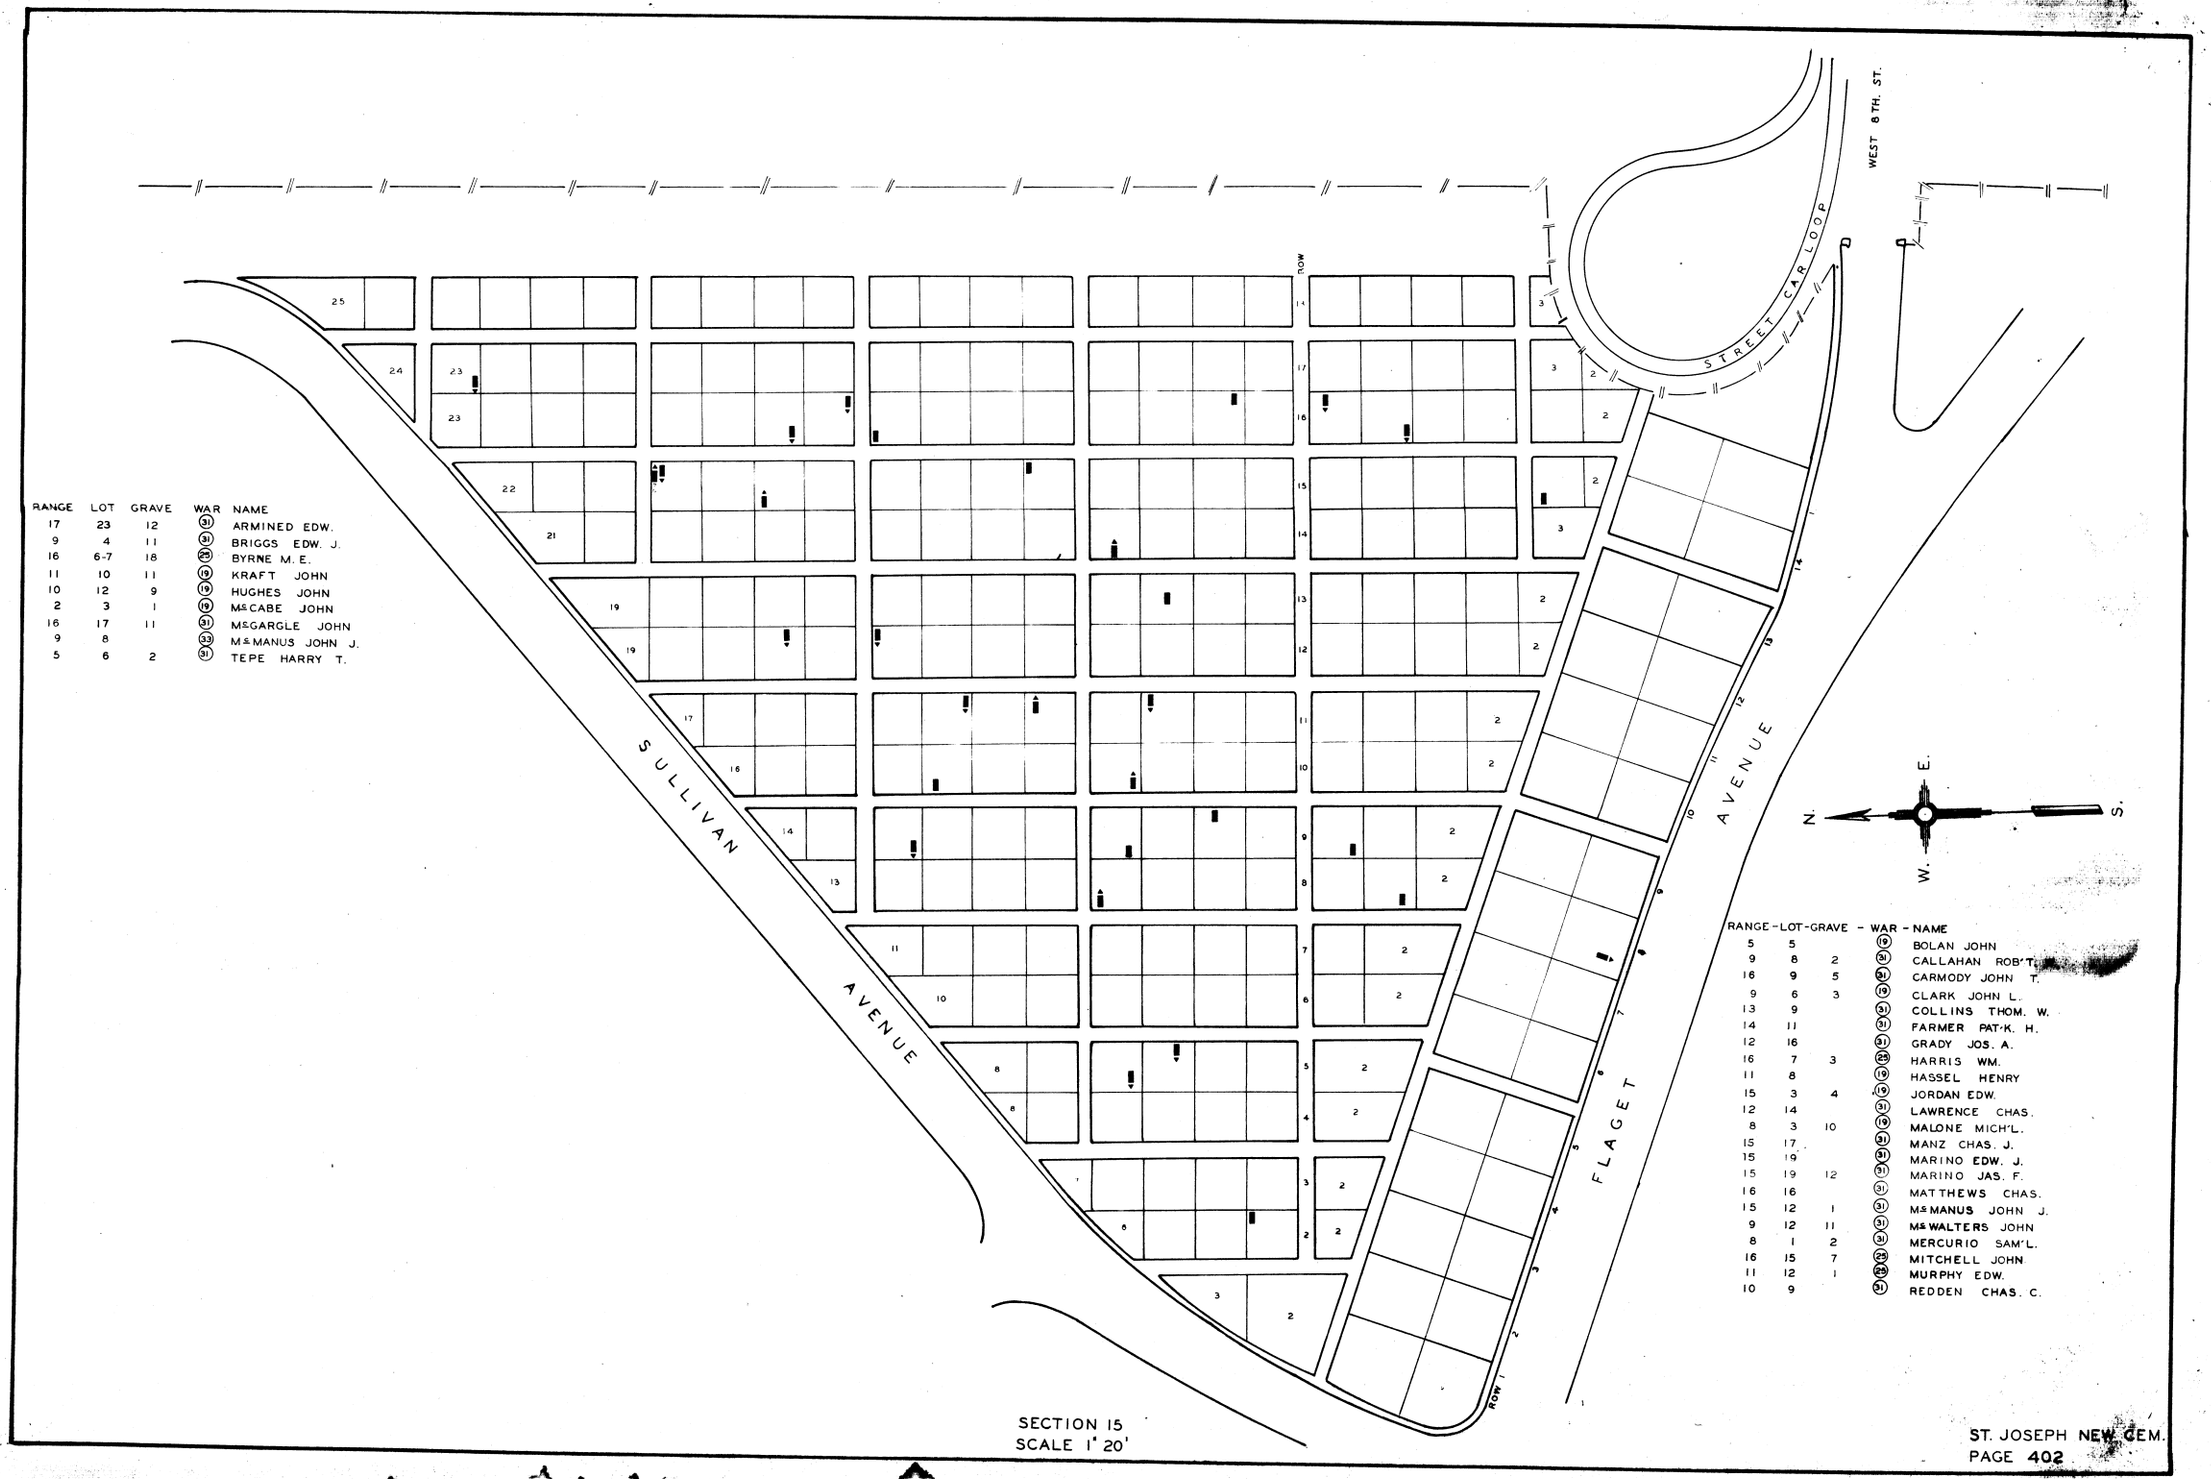

RANGE	LOT	GRAVE	WAR	NAME
17	23	12	31	ARMINED EDW.
9	4	11	31	BRIGGS EDW. J.
16	6-7	18	25	BYRNE M. E.
11	10	11	19	KRAFT JOHN
10	12	9	19	HUGHES JOHN
2	3	1	19	McCABE JOHN
16	17	11	31	McGARGLE JOHN
9	8		33	McMANUS JOHN J.
5	6	2	31	TEPE HARRY T.

RANGE	LOT	GRAVE	WAR	NAME
5	5		19	BOLAN JOHN
9	8	2	31	CALLAHAN ROB'T.
16	9	5	31	CARMODY JOHN T.
9	6	3	19	CLARK JOHN L.
13	9		31	COLLINS THOM. W.
14	11		31	FARMER PAT'K. H.
12	16		31	GRADY JOS. A.
16	7	3	25	HARRIS WM.
11	8		19	HASSEL HENRY
15	3	4	19	JORDAN EDW.
12	14		31	LAWRENCE CHAS.
8	3	10	19	MALONE MICH'L.
15	17		31	MANZ CHAS. J.
15	19		31	MARINO EDW. J.
15	19	12	31	MARINO JAS. F.
16	16		31	MATTHEWS CHAS.
15	12	1	31	McMANUS JOHN J.
9	12	11	31	McWALTERS JOHN
8	1	2	31	MERCURIO SAM'L.
16	15	7	25	MITCHELL JOHN
11	12	1	25	MURPHY EDW.
10	9		31	REDDEN CHAS. C.

SECTION 15
SCALE 1" 20'

ST. JOSEPH NEW CEM.
PAGE 402

402

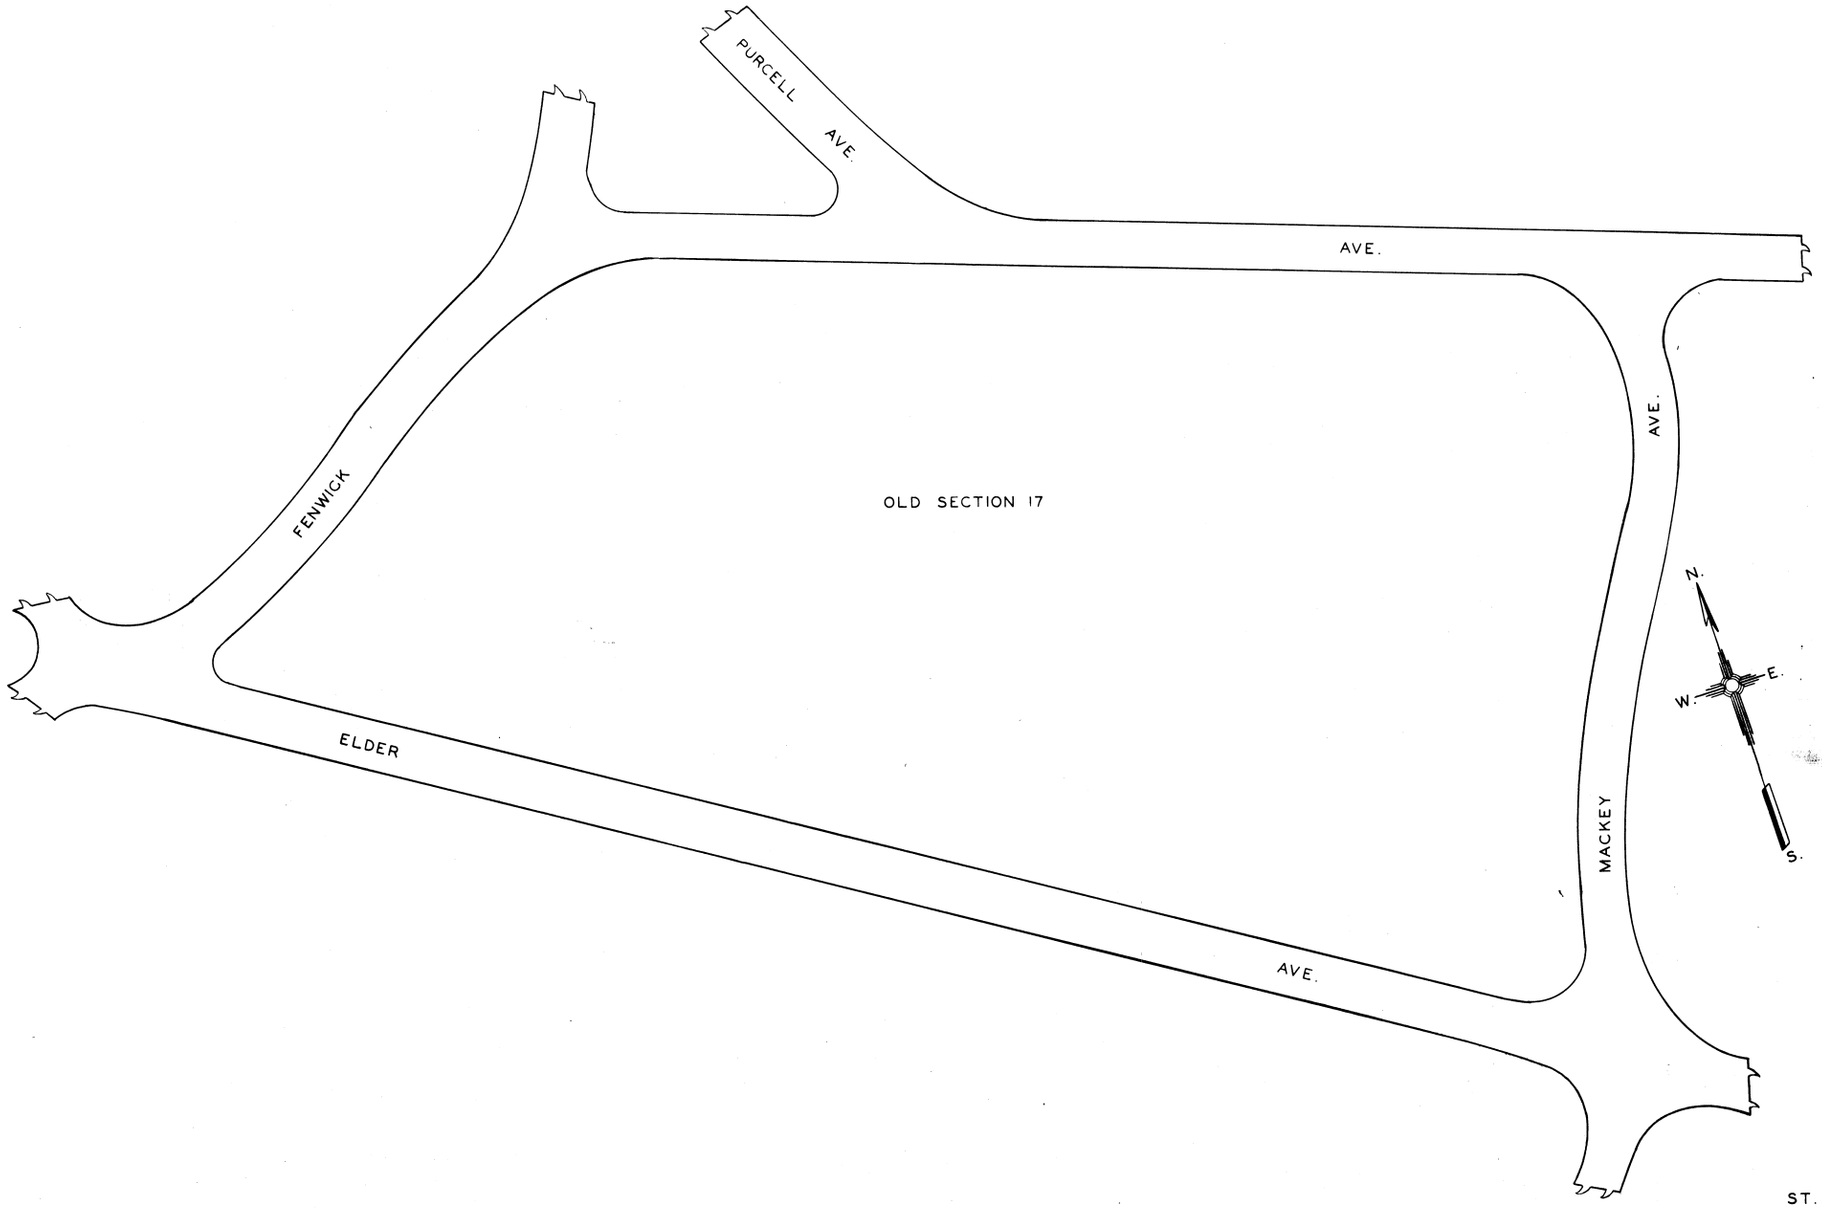

SCALE 1"=20'

ST. JOSEPH
NEW CEMETERY
PAGE 403

RANGE	LOT	GRAVE	WAR	NAME
7	3	4	31	CONCANNON EDW. C.
3	4	2	31	DAVITT WM. M.
9	4	8	31	MAROULES FRED. J.
7	4		28	NORRIS AL'B. V.
5	2		31	ROCKWELL EDW. T.
15	8	2	31	DUFFY JOS. A.
16	68	2	31	SCHEBRAT THEO. H.

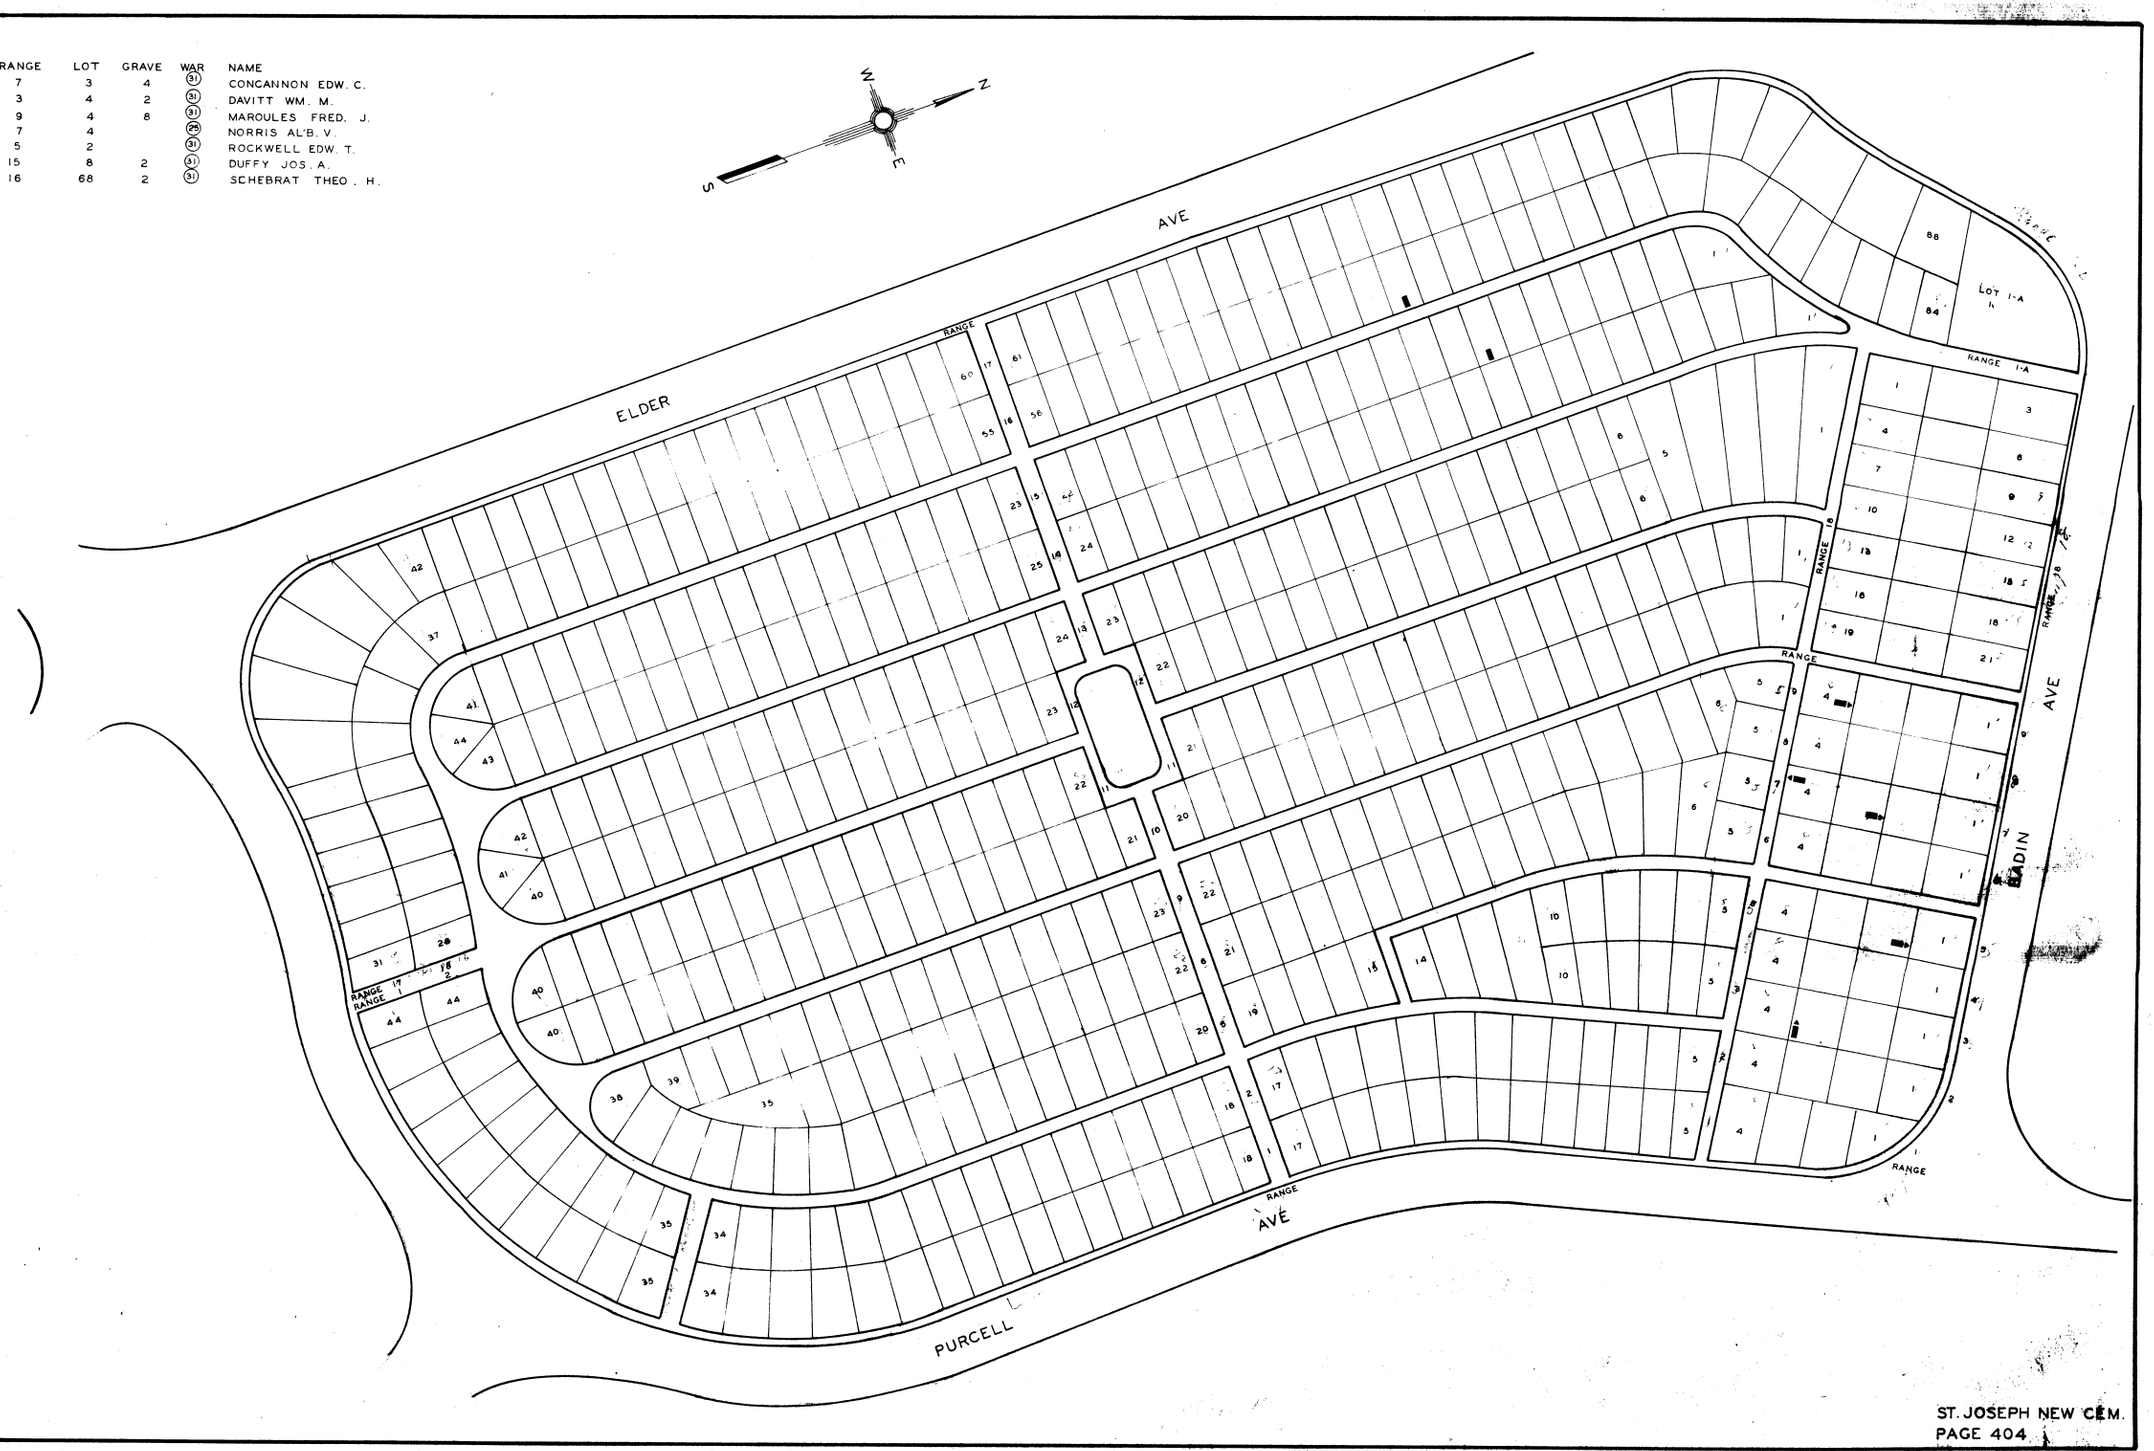

ST. JOSEPH NEW CEM.
PAGE 404

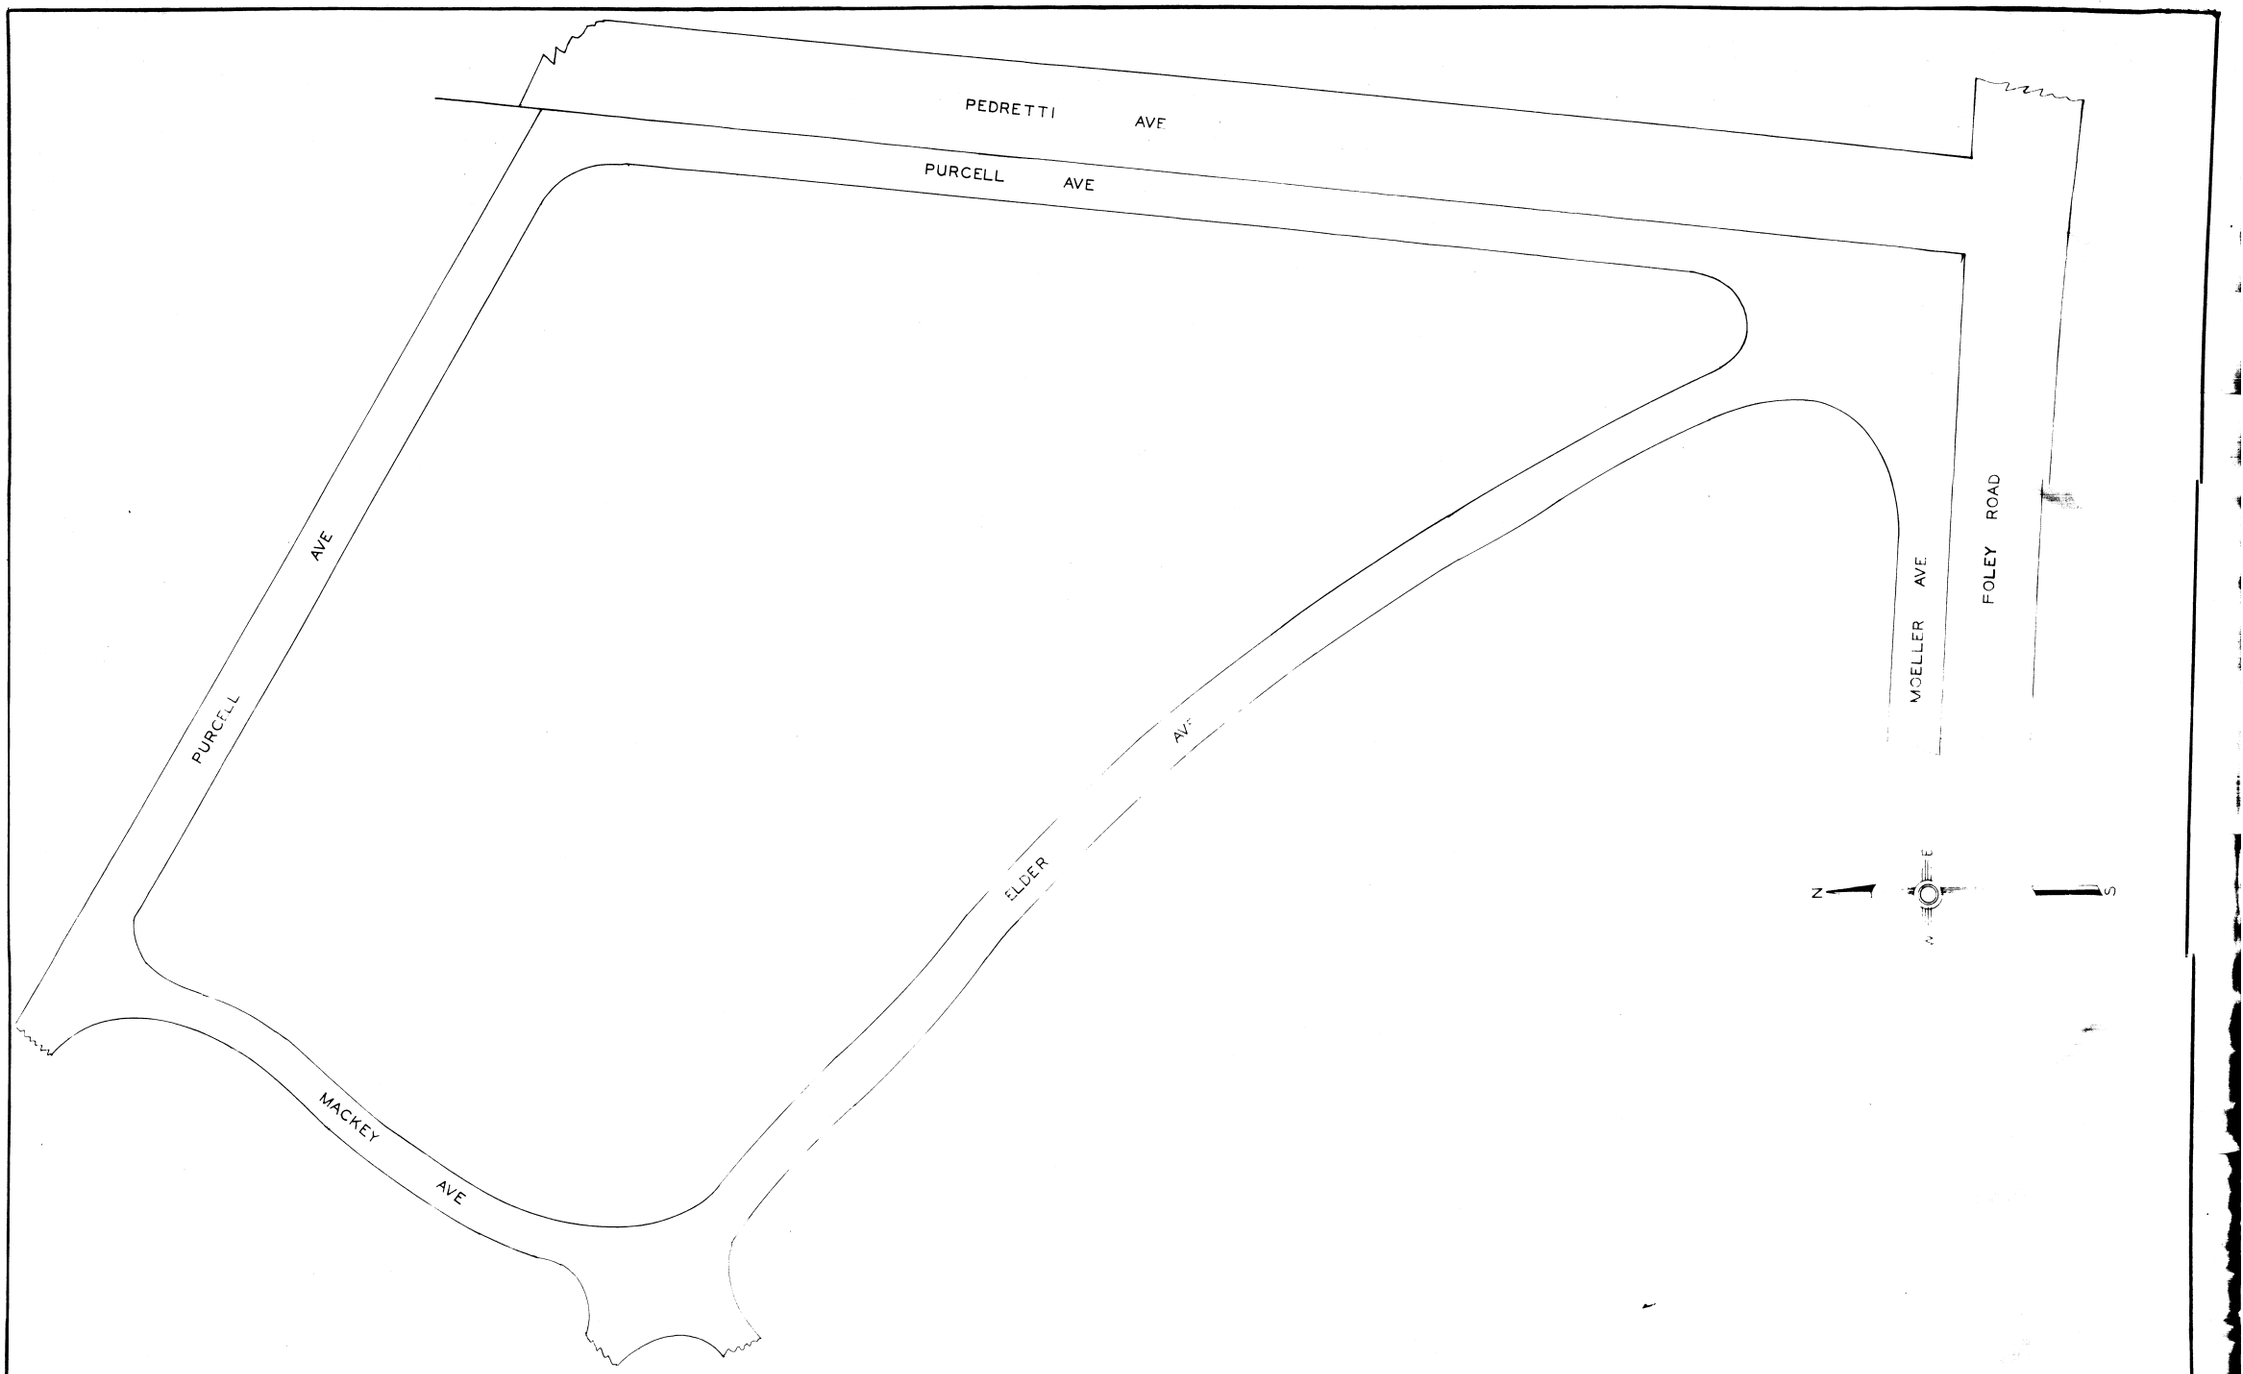

SEC. 18
SCALE 1-30'

ST JOSEPH NEW
PAGE 405

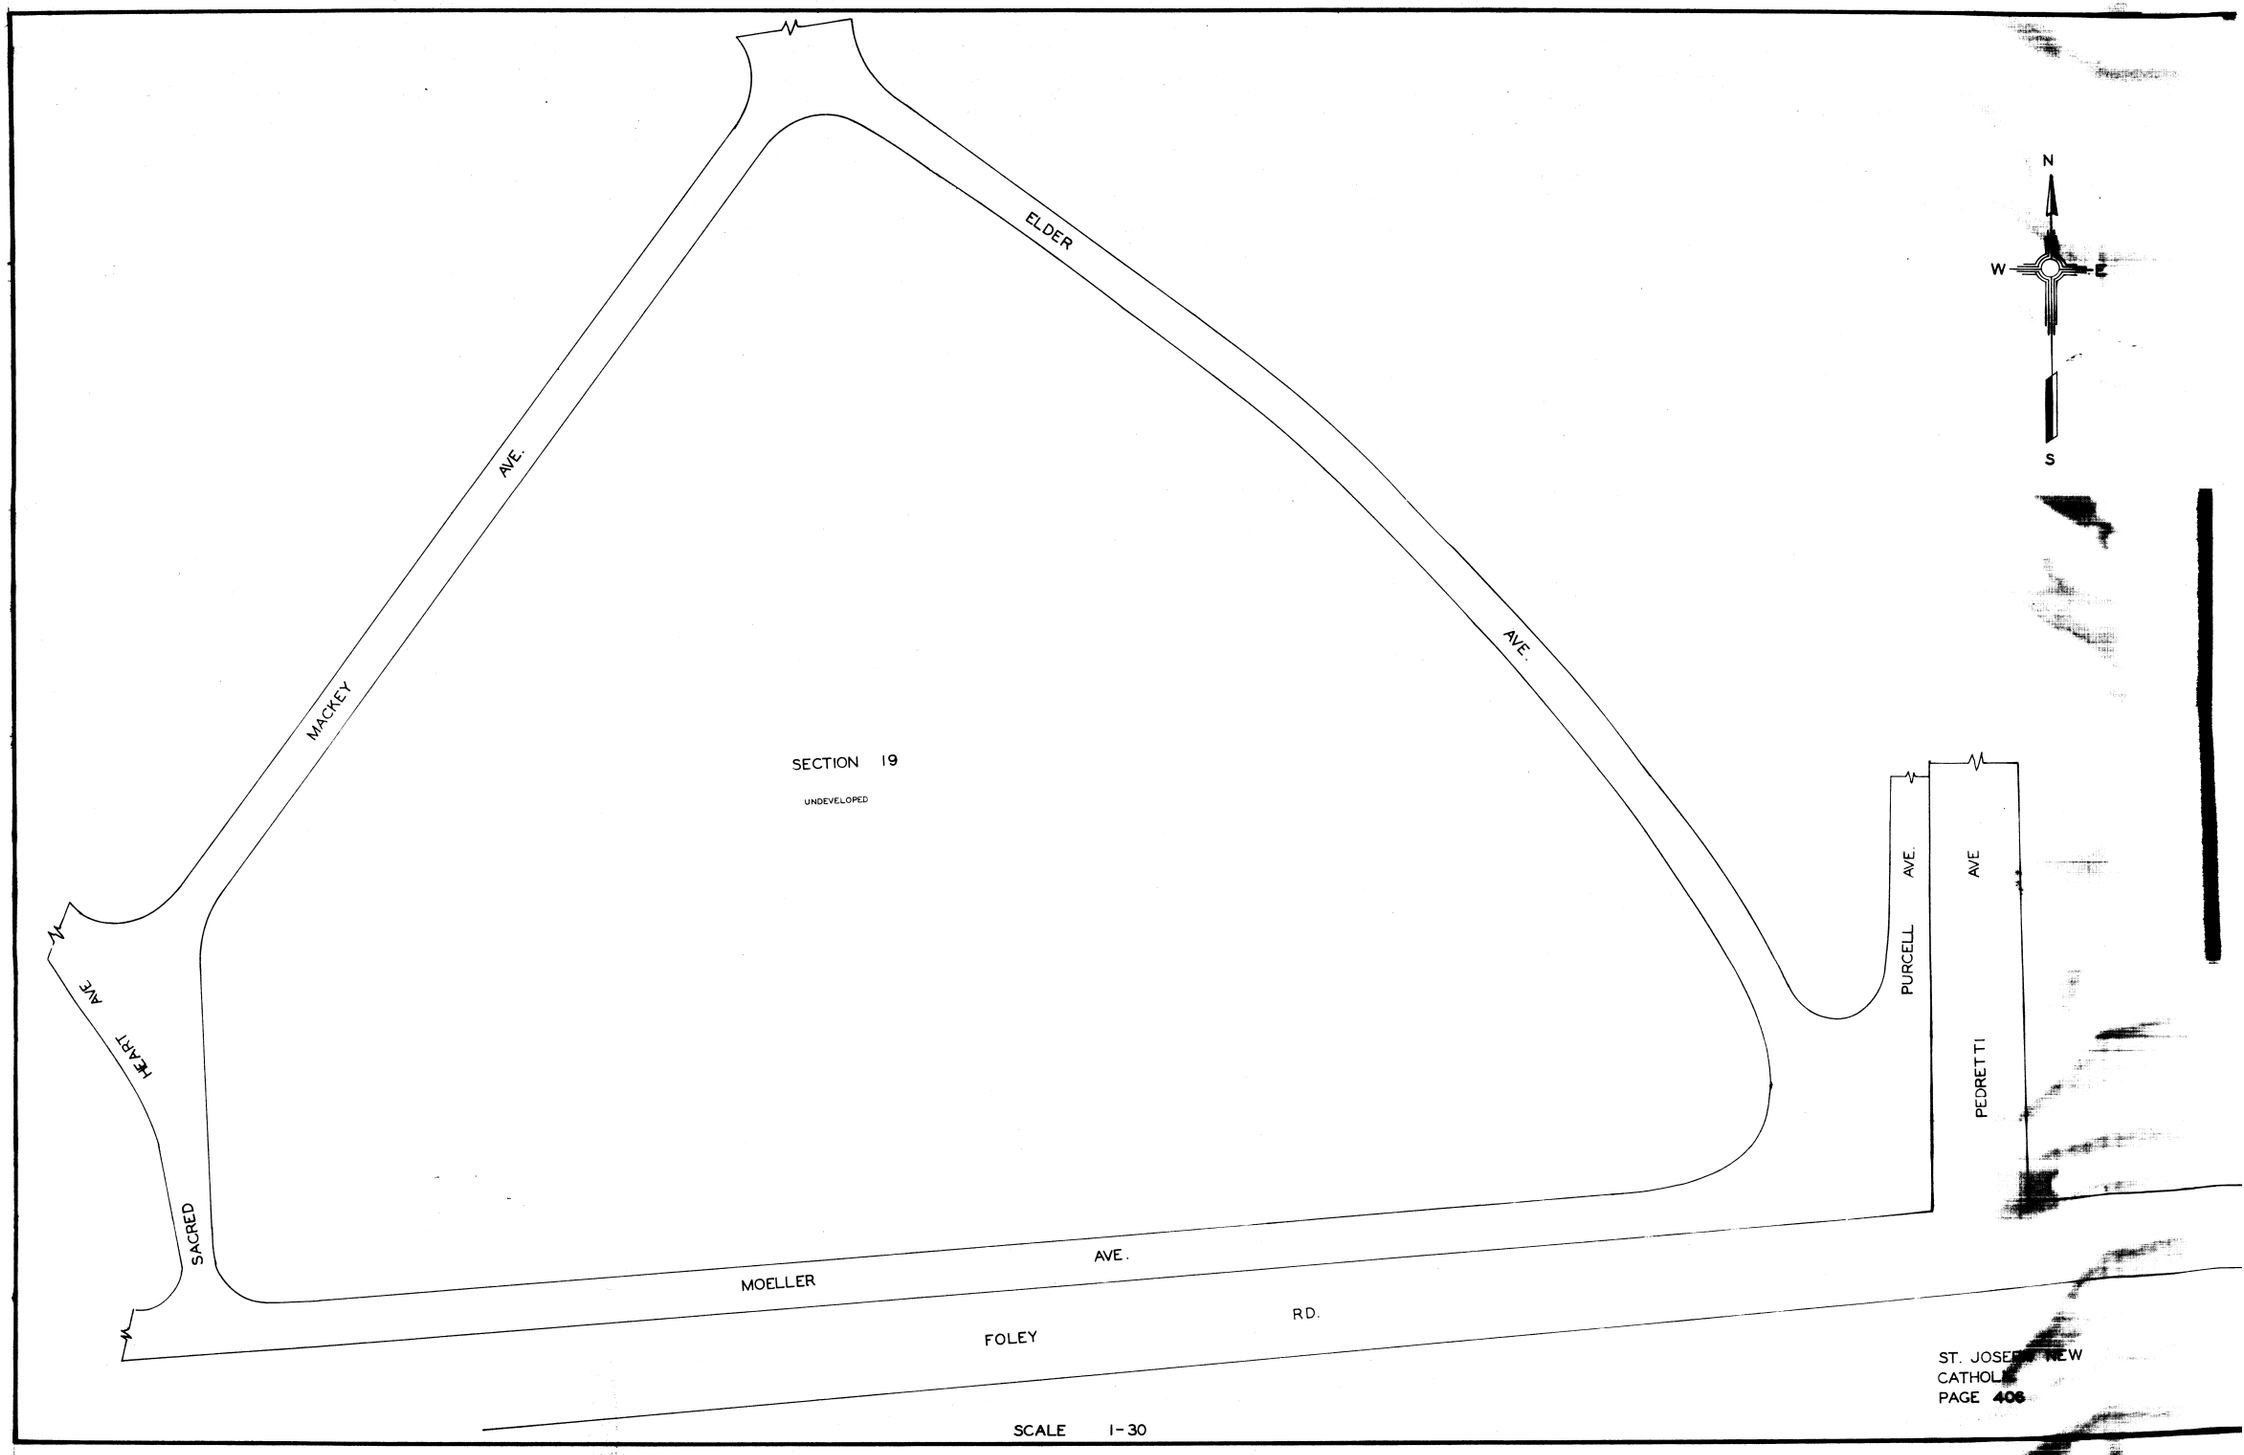

ST. JOSEPH NEW
CATHOLIC
PAGE 406

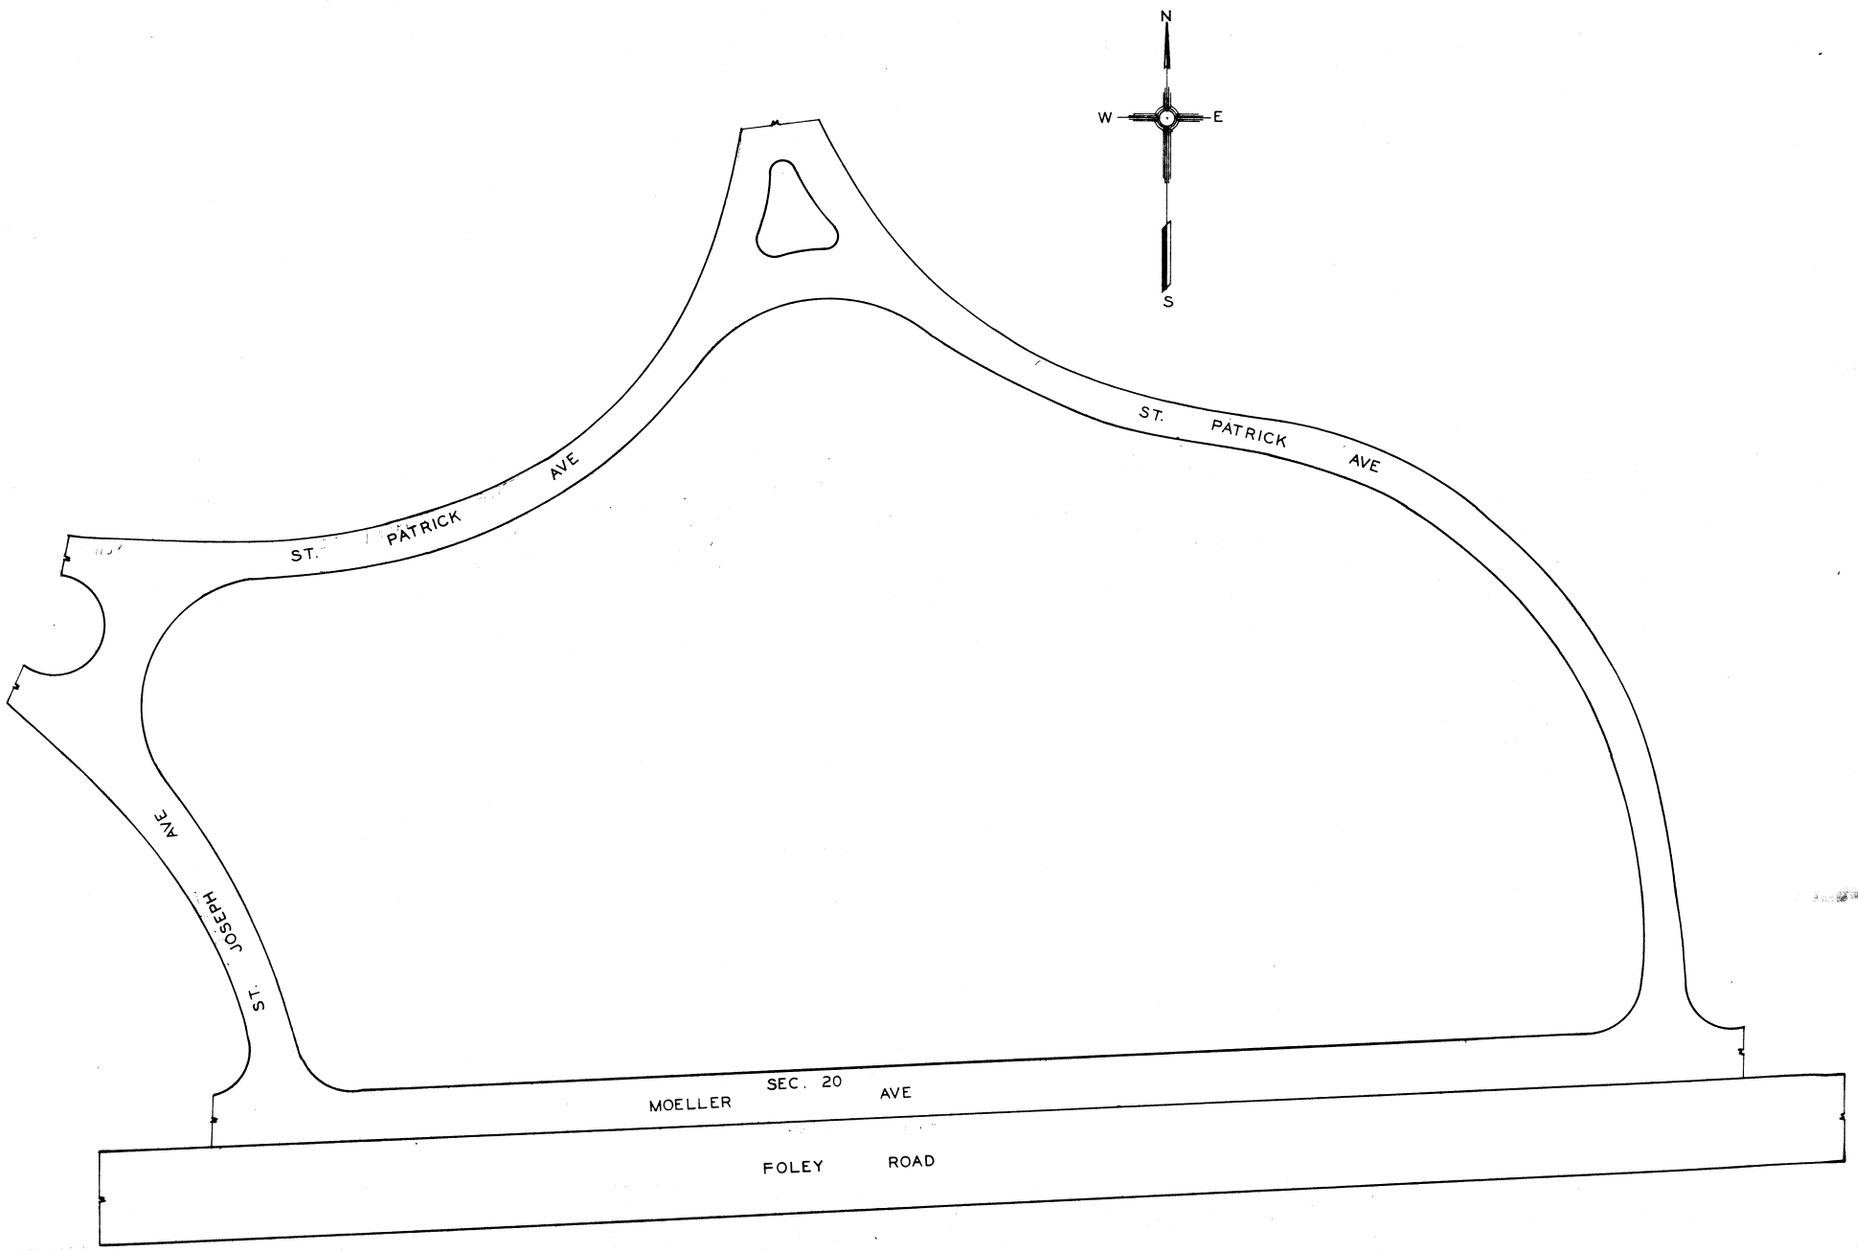

SCALE 1"–30'

ST. JOS ATHOLIC (NEW)
PAGE

RANGE	LOT	GRAVE	WAR	NAME
10	3	2	31	BAUMANN LAW.
9	4	7	31	CONNOLLY WALTER J.
12	24	3	31	DELFAVERO CRISPINO
1	24	1	31	FISHER FRANK
7	33		31	GARDNER FRANK J.
16	16		25	HEALY F. R.
4	21		31	HOERNSCHEMEYER WM. J.
1	5	6	31	LOHMAN F. F.
14	23	5	31	McELLERY JAS. B.
8	5	4	31	MONAHAN PET. P.
11	23	1	31	MORAN MARTIN
7	19	8	31	MORRIS EARL F.
4	23	2	31	REARDON DENNIS M.
10	27	1	31	RUSSO NICOLA
13	23	6	31	RYAN JNO. J.
8	8	6	31	RYAN ROB'T. A.
9	23	5	31	SING CLIFF. J.
9	50		31	STALF GEO.
12	31	2	31	SWEENY PAUL D. A.
7	43		26	REYNOLDS JOS. A.
1	7		31	CASSIDY EDW.
8	41	2	33	CRUSE THOS. F.
8	16	2	24	LEWIS EDW.
7	3		31	MIELE JOS.

SECTION 21
SCALE 1-20'

ST. JOSEPH
PAGE 408

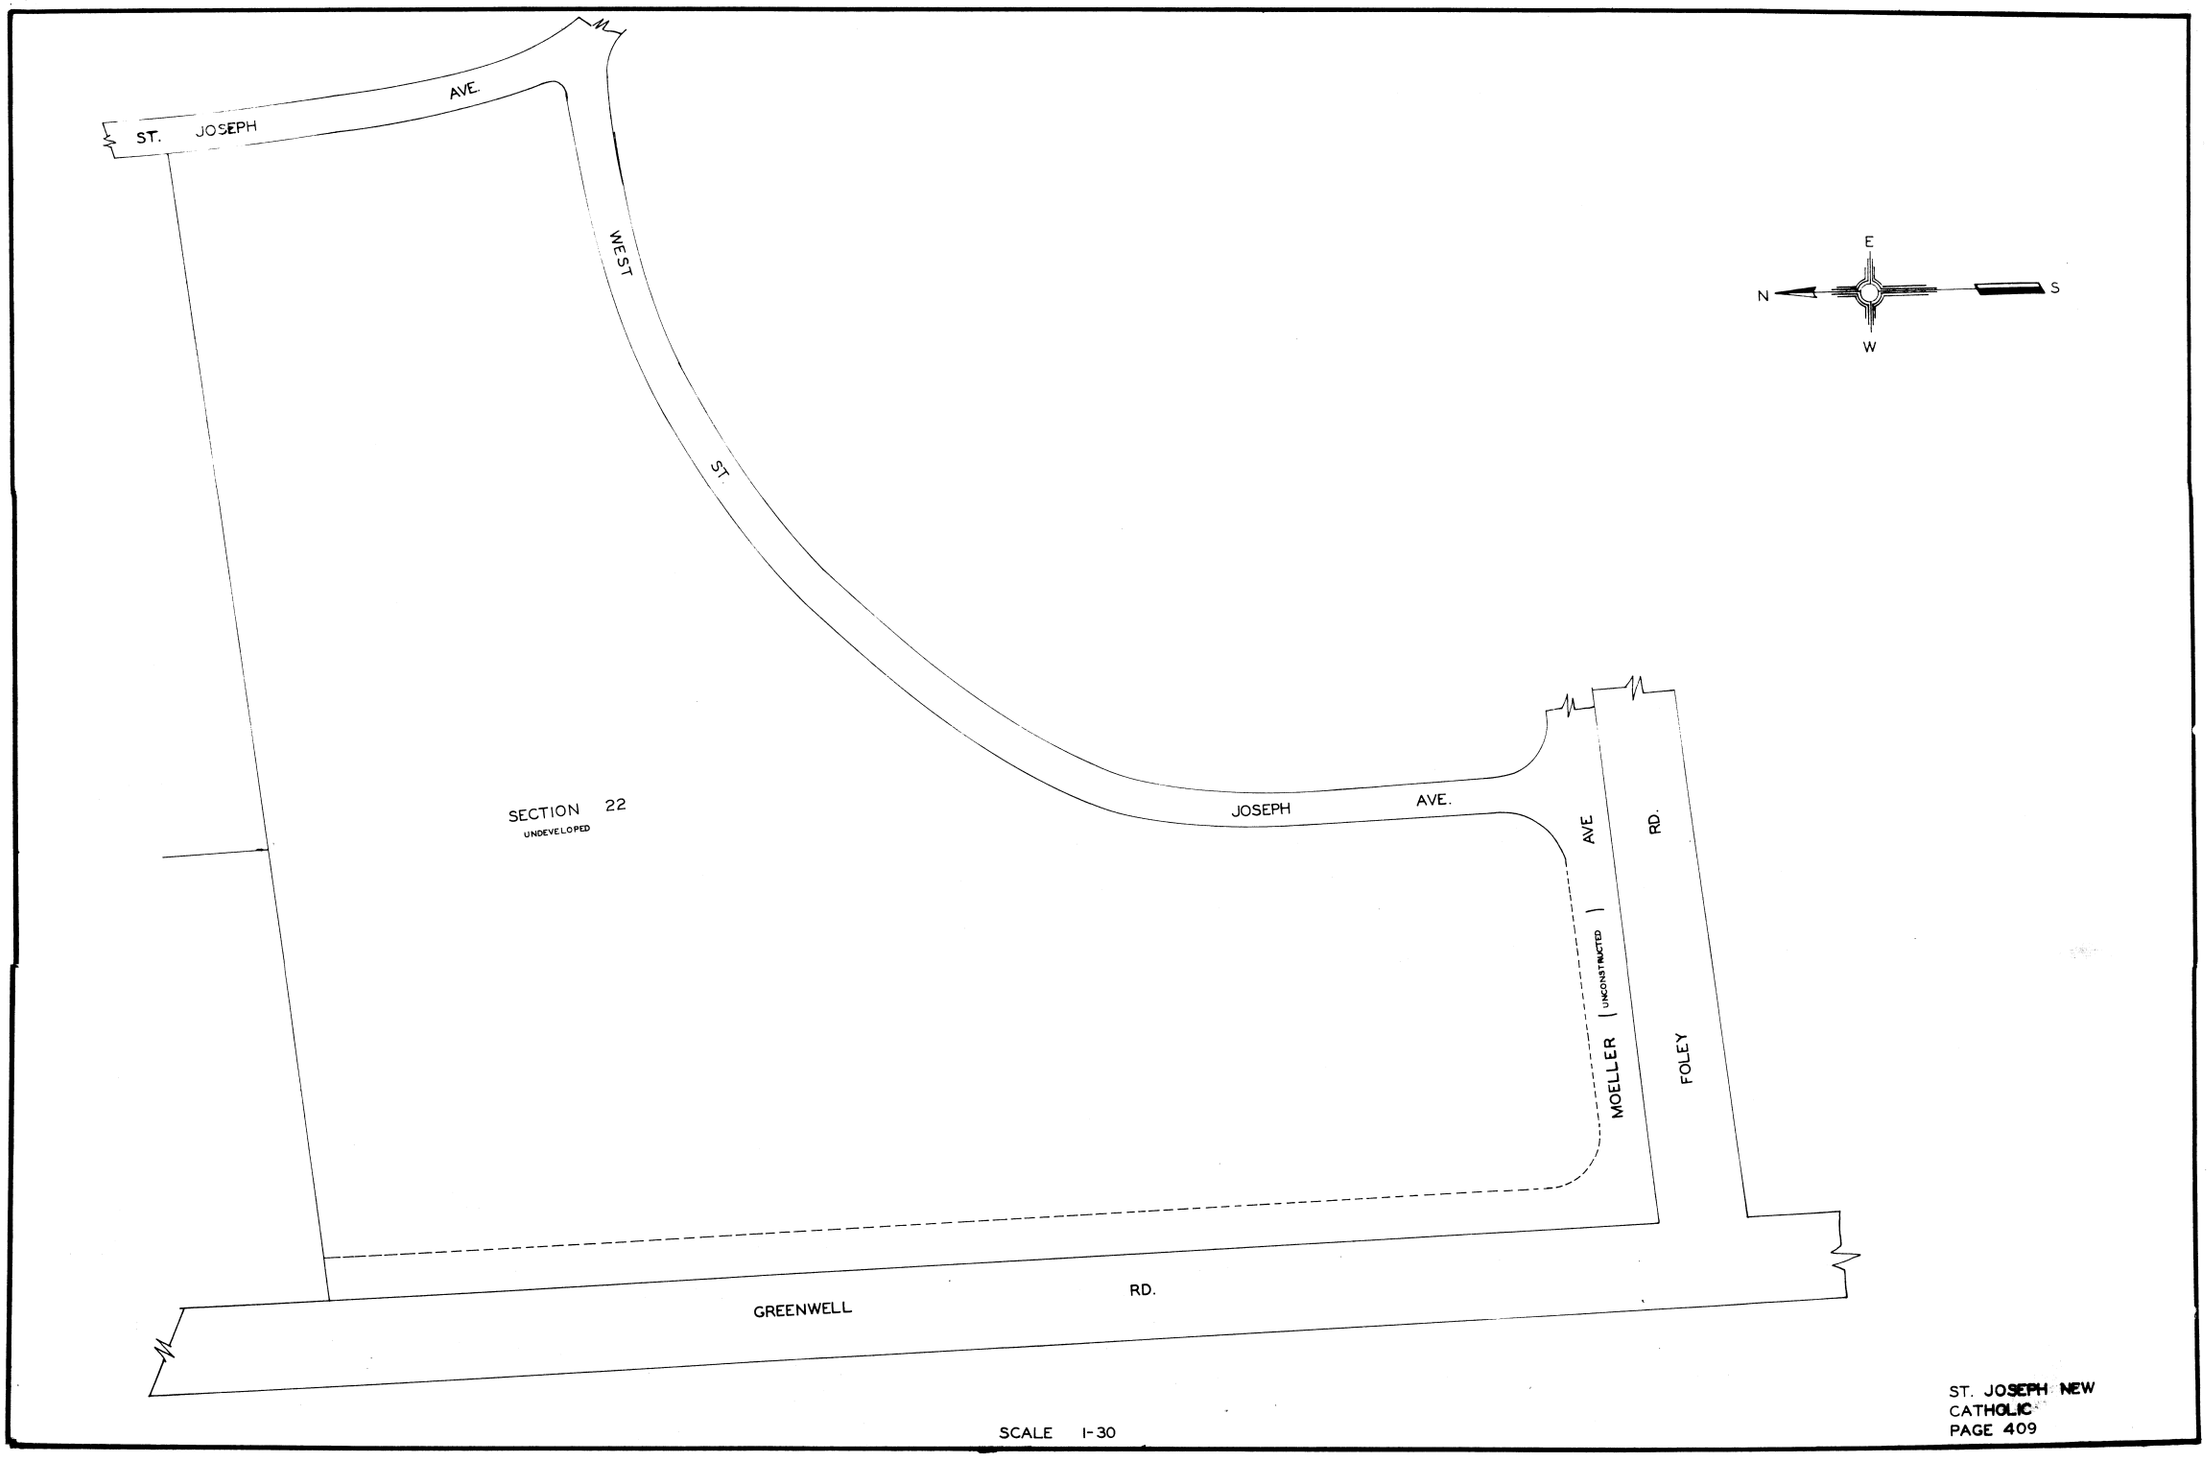

ST. JOSEPH NEW
CATHOLIC
PAGE 409

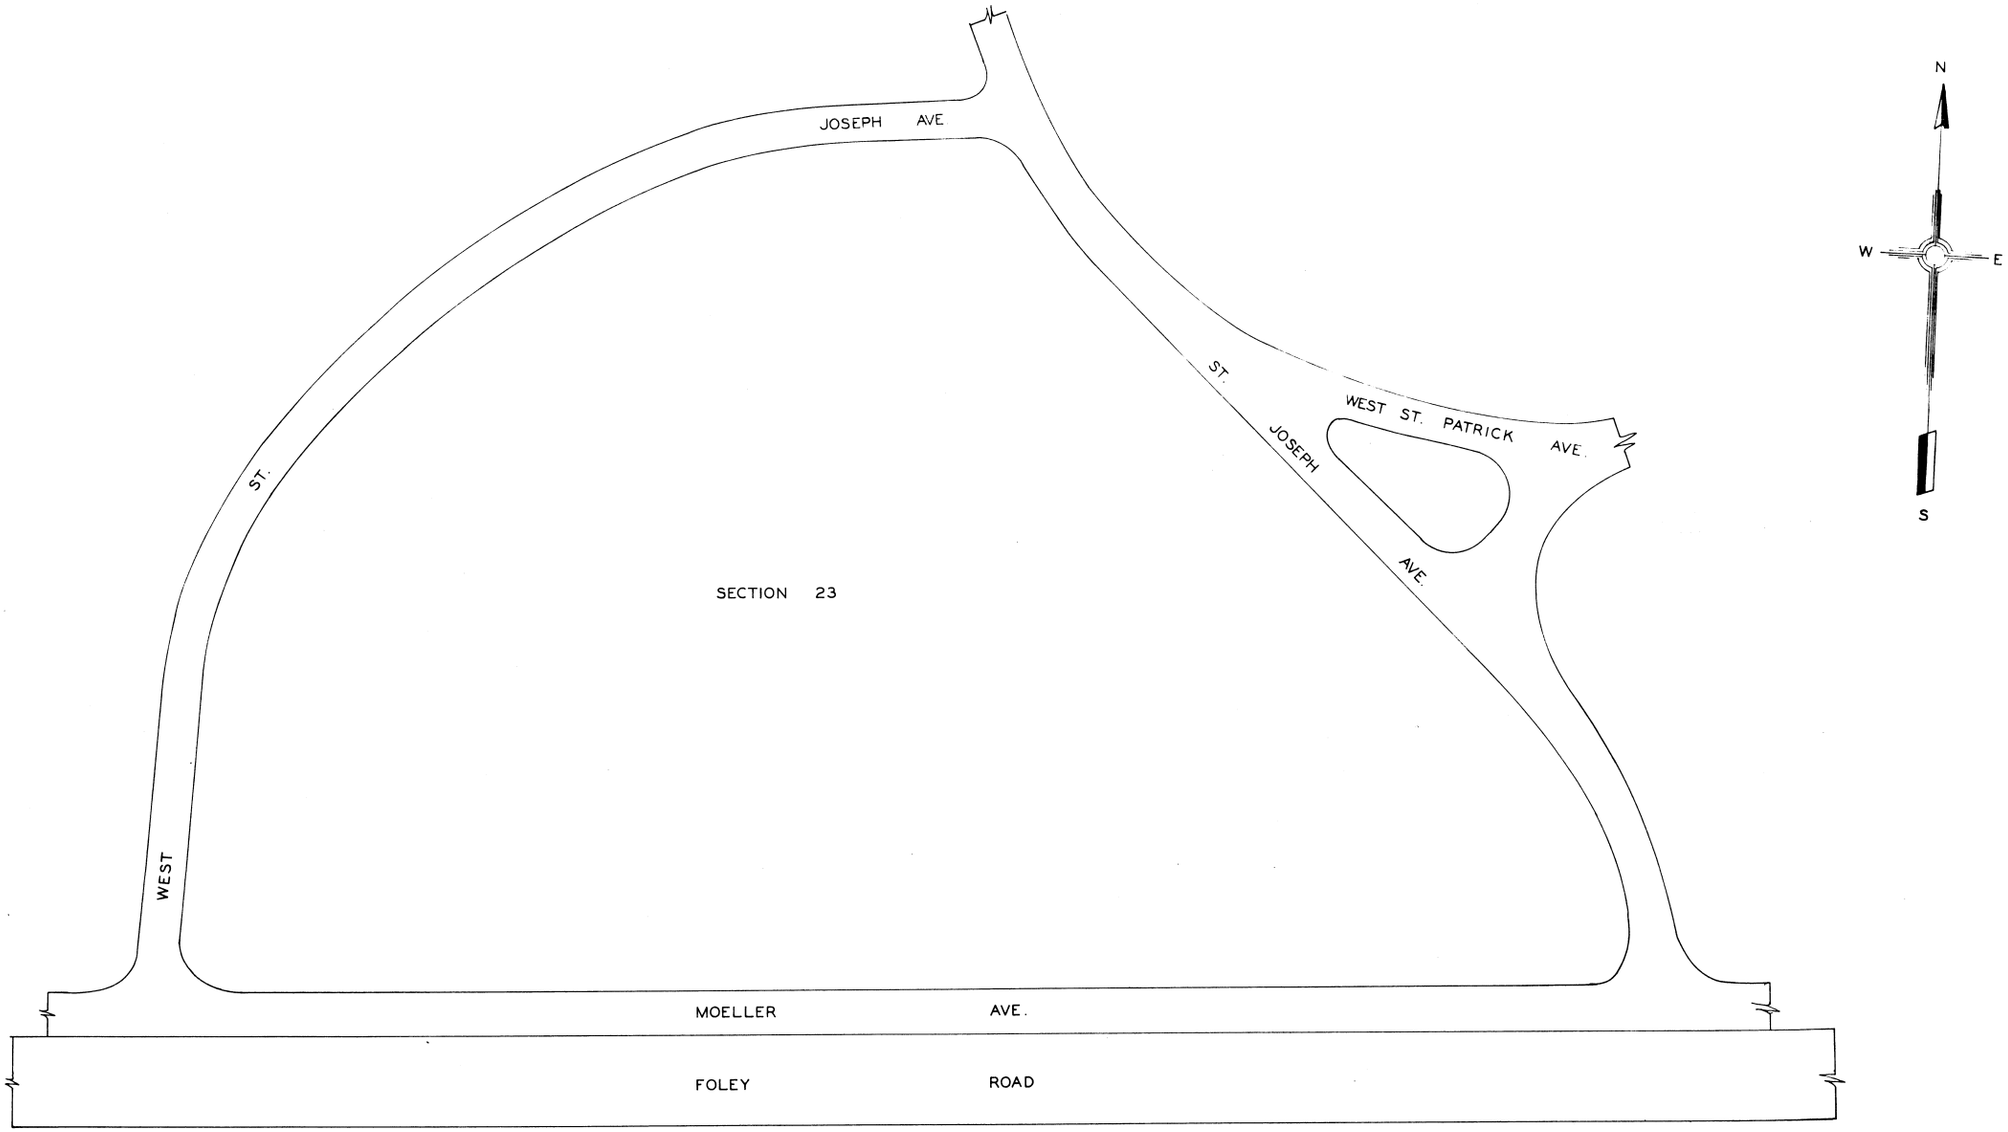

ST. JOSEPH NEW
CATHOLIC
PAGE 410

SCALE 1-30

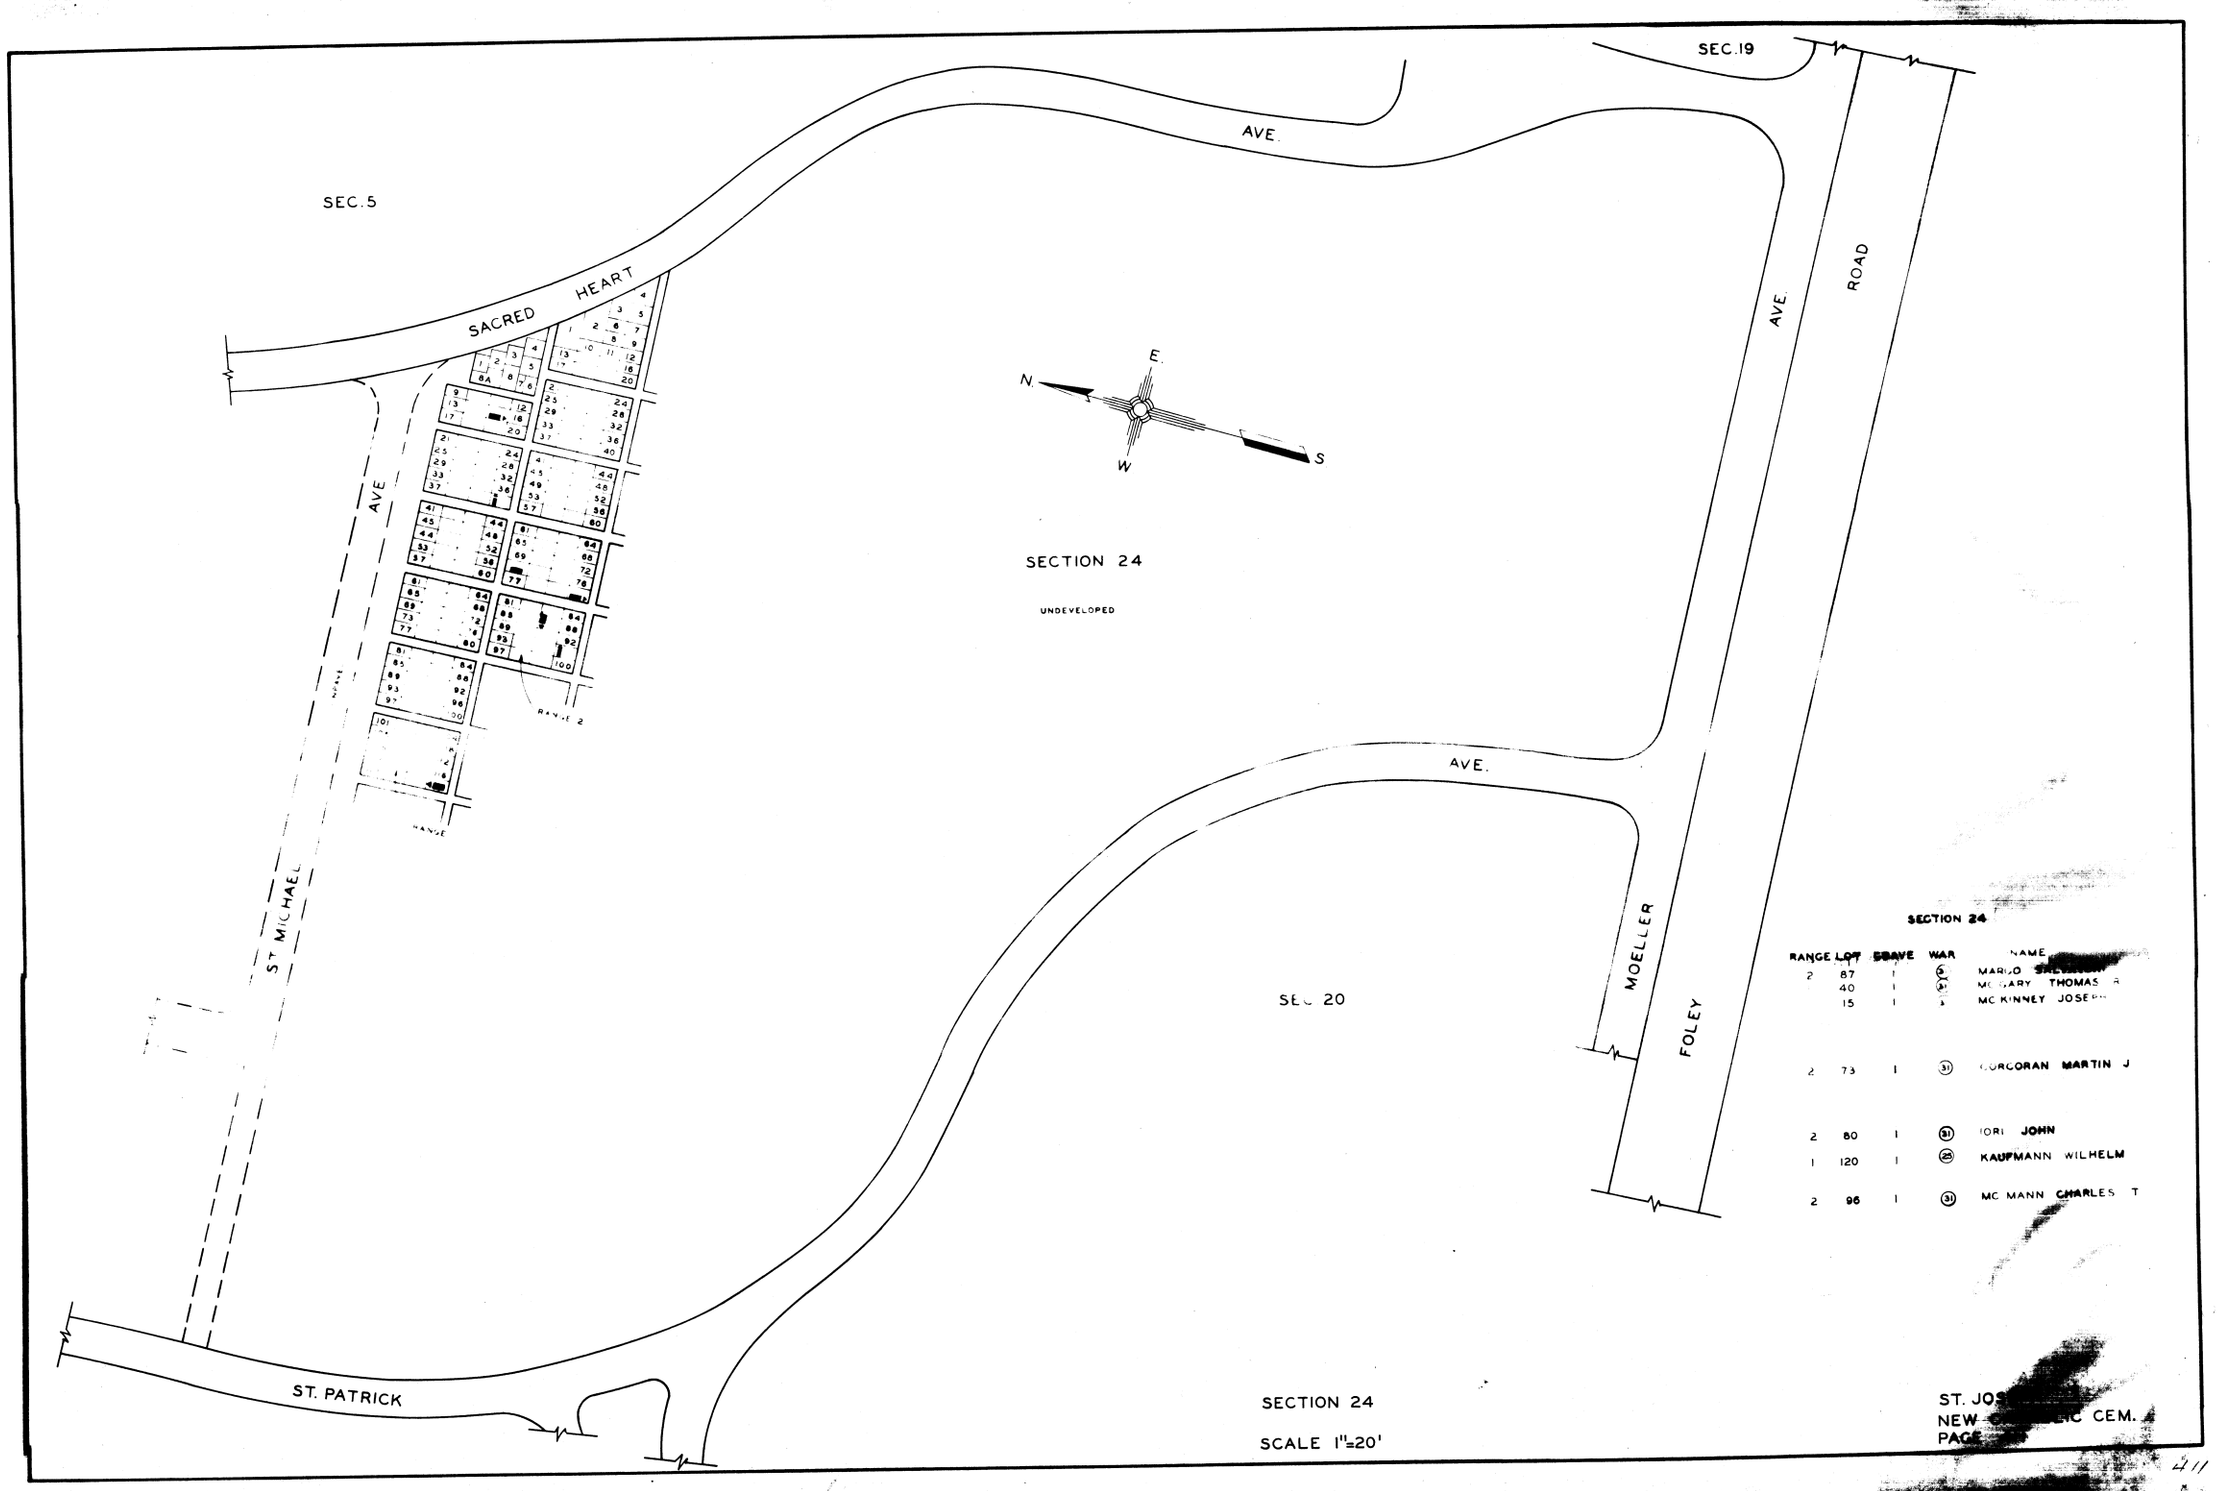

SECTION 24

RANGE	LOT	SPACE	WAR	NAME
2	87	1		MARIO [redacted]
	40	1		MC GARY THOMAS R
	15	1		MC KINNEY JOSEPH
2	73	1	31	CORCORAN MARTIN J
2	80	1	31	IORI JOHN
1	120	1	26	KAUFMANN WILHELM
2	96	1	31	MC MANN CHARLES T

ST. JOSEPH CEMETERY

SECTION N.E. PLAT

RANGE	LOT	GRAVE	WAR	NAME
11	6	4	19	ABBOTT JAS.
10	24	4	19	AMBROSE JOHN
22	30	1	19	ARMSTRONG JOHN
20	20	4	19	BAIN JOHN
2	21	6	19	BARRETT PAT.
8	27	1	19	BARRY THOM.
16	15	11	25	BLAND JAS. W.
13	16	12	19	BOLAND MICHL.
13	7	3	19	BOYLE CHAS.
20	28	12	19	BRADLEY JOHN
7	7	4	19	BURKE PAT'K.
27	26		19	BURKE PAT'K.
28	27	9	19	BRANNAN PAT'K.
12	27	5	33	BROWN JAS. E.
11	25	7	19	CAREY JOHN
17	7	3	19	CAMPBELL JAS.
15	13		19	CAMPBELL JOS. W.
14	6	6	19	CAREY PHIL.
7	29	11	19	CARNEY THOS.
23	32		19	CARROLL CHAS.
30	7	2	19	CARROLL PAT. JR.
27	28	5	19	CARROLL WM.
19	29		19	CARSON JAS.
13	18	11	16	CLINE WM.
10	19	8	19	CONNELLY JOHN
13	16	11	19	CONNELLY JOS
16	32	1	19	CONROY JOHN
12	15	1	19	COPELAND ARC'H.
18	31	4	19	COSTELLO EDW.
9	1	1	19	COWAN JAS.
16	15		19	CROSSEN H.
13	32	11	19	CUFF JAS. H.
16	2	[illegible]	19	CUMMINS JOHN
16	2	12	19	CUMMINS PAT.
9	19	7	19	CUNNINGHAM THOS
7	29	9	19	CARNEY JOHN
1	15	7	19	CLIFFORD JOHN
13	31	3	19	CONNELLY JAS.
8	9	4	19	CALLIGHAN JAS.
17	27	10	19	COGAN JOHN
25	33	12	19	CRONAN TIM. J.
16	2	3	31	CUMMINGS JNO. J.
22	32	8	19	DAVIDSON GEO.
5	13		19	DEFFLEY DAN'E.
19	9	8	19	DEVINE FELIX
9	12	6	19	DOHERTY WM.
17	28		19	DORAN JOHN
5	13		19	DOWD JOHN
5	13	1	19	DOWD PAT.
21	25	10	19	DRENNAN JAS.
8	33		19	DUNCAN DAN'L.
20	31	2	19	DONOVAN EDW.
8	30	9	19	DOYLE WM. E.
14	30	8	19	DOUGHERTY M.
20	32	5	19	DOWD PAT'K.
20	27	7	19	FARMER PAT'K. H.
25	32		19	FINN THOS. J.
17	22	8	19	FLANAGAN PAT.
14	3	6	19	FOLEY MICH'L.
21	33	4	31	FLAHERTY OLIVER
13	33	10	19	GAMBLE DAN'L.
16	23	5	19	GEISEL MICH'L.
2	13	3	19	GLERSON JOHN
5	26		19	GLEESON JOHN
2	17	7	19	GORMAN JOHN
18	7	4	19	GRADY TIM.

RANGE	LOT	GRAVE	WAR	NAME
16	26	4	19	HANRAHAN EDW.
16	26	9	25	HANRAHAN EDW.
27	32	3	25	HARRINGTON WM.
26	24	4	19	HART THOS.
26	29	3	19	HARTIGAN DAV.
11	12	10	19	HAYDEN T.
15	13	2	25	HAYES WM. W.
13	23	6	19	HAYES JOHN
6	15	3	19	HEALY M.
15	26	5	19	HENRY JAS.
6	8	1	19	HIGGINS JOHN
8	11	10	19	HOWARD JOHN
13	25	3	19	HOWE MARTIN
8	16	3	19	HUGHES JAS
22	22	8	19	HURLEY HUGH
23	22	15	19	HOGAN P. J.
15	11	8	16	JACKSON JOHN
1	1	1	19	JOHNSON JOHN W.
10	20	4	31	KERWICK MORGAN
2	17	12	19	KEAN JOHN
30	29	5	16	KENNEDY JOHN
2	4		19	KENNY B.
16	10	4	19	KILGOUR GEO.
27	27		19	KELLEY THOS.
10	15		19	KELLEY JAS.
12	28	12	19	KENNEDY THOS.
7	25	1	19	LAWLER JAS.
2	18	6	31	LANG FRANK J.
6	2		31	LENNON E. T.
25	20		16	LEONARD JOHN
2	18	12	31	LONG FRANK J.
12	15	1	19	LEONARD PAT'K.
12	17	1	19	MARTIN EDW.
7	8	6	19	MAXWELL JOHN
22	31		19	McALESE JOHN
4	15	1	19	McCANN JAS.
4	15	1	19	McCANN WM.
14	16	8	19	McCARTHY PAT
17	30	1	19	McCOLLOUGH JOHN
14	10	6	19	McDERMOTT THOS
17	5		19	MC DONALD THOS
6	26		19	McDONALD WM
26	27	9	19	McGRATH JOHN
28	29	11	19	McGREVEY DAN'L.
21	23	12	19	McLAUGHLIN JAS.
21	23	1	19	McLAUGHLIN JOHN.
23	23	4	19	McMAHON MICH'L.
8	27	4	19	McTAGUE MICH'L
15	22		19	MILLER LEW C.
14	18	7	19	MITCHELL JAS
14	29	4	19	MOLLOY CHAS.
6	28	11	19	MOLLOY JOHN
4	19	12	19	MOLLOY PAT.
2	23	11	16	MOORE PET.
4	21	5	19	MOORE WM. E.
14	31	7	19	MORAN JOHN
9	5	4	19	MORAN MICH'L.
19	33		31	MORRIS RAY. E.
15	28	8	19	MULLARKEY JOHN
20	12	8	19	MULLEN JAS.
12	29	6	19	MULVEY BERNARD
15	24	7	19	MULYAHILL MICHL.
12	13	11	19	MURPHY CORNELIUS
18	1		25	MURPHY JEROME R.

RANGE	LOT	GRAVE	WAR	NAME
6	13	8	19	NADAND JOS. M.
12	10	4	19	NORTON THOS.
11	30	1	19	OBRIEN JOHN
17	10	6	19	OBRIEN THOS.
11	29	8	19	O'DOWD JOHN
5	30	12	19	OWENS PAT. JR.
5	30	7	19	OWENS THOS.
9	26	4	19	OBRIEN MARTIN
13	11	7	19	OBRIEN THOS. J.
14	7	3	19	PATTON WM.
11	16		19	PICKETT DAV.
10	6	5	19	POWERS MICH'L.
10	31	11	19	POWERS ROB'T.
19	4	6	19	QUINLAN JAS.
26	24	1	19	QUINN JAS. J.
10	21		25	REGAN WM. J.
16	17	6	19	RILEY THOS. ALIAS JAS SHEPARD
1	14	12	16	RICHARDSON WM P.
27	22	6	19	ROACH JAS. M.
2	9		19	ROONEY H.
9	31		19	RYAN JAS.
10	4		19	RYAN PAT.
28	23	10	19	RICE JOHN
5	12	1	19	RIGNEY BERNARD
15	27	7	19	RIGNEY WM.
33	33	[illegible]	19	RUSSELL JOHN
12	15	12	19	SEERY C. J.
15	12	5	19	SEERY A. J.
32	32	1	19	SHERIDAN JOHN
11	4		19	SIMPSON THOS.
16	18		31	SKELLY CHAS.
11	1	7	19	SMITH PAT.
11	10	7	19	SMITH THOS
21	28		19	SULLIVAN ROB'T
21	9		19	SWIFT WM
32	32	1	25	SHERIDAN JOHN
2	30	1	19	SULLIVAN JOHN F.
1	21	1	19	SULLIVAN PAT'K.
12	15	7	19	TERRY JOHN
9	10	2	19	TULLY JOHN
15	14	3	19	TIGHE JAS.
12	33		19	TWOHIG DAN'L
25	25	6	19	USHER PAT.

RANGE	LOT	GRAVE	WAR	NAME
3	13	7	19	WALLACE THOS.
22	6	1	31	WARD JAS. A.
21	8	4	16	WHITE JOHN
16	17	1	19	WHITEHEAD EDW.
22	22	11	19	WALSH RICH.
3	3	5	19	WILSON JOHN
21	6	11	33	WING JOS.
1	1	10	19	WINSTON HUBERT.
21	24	12	33	WALSH EDW.

412

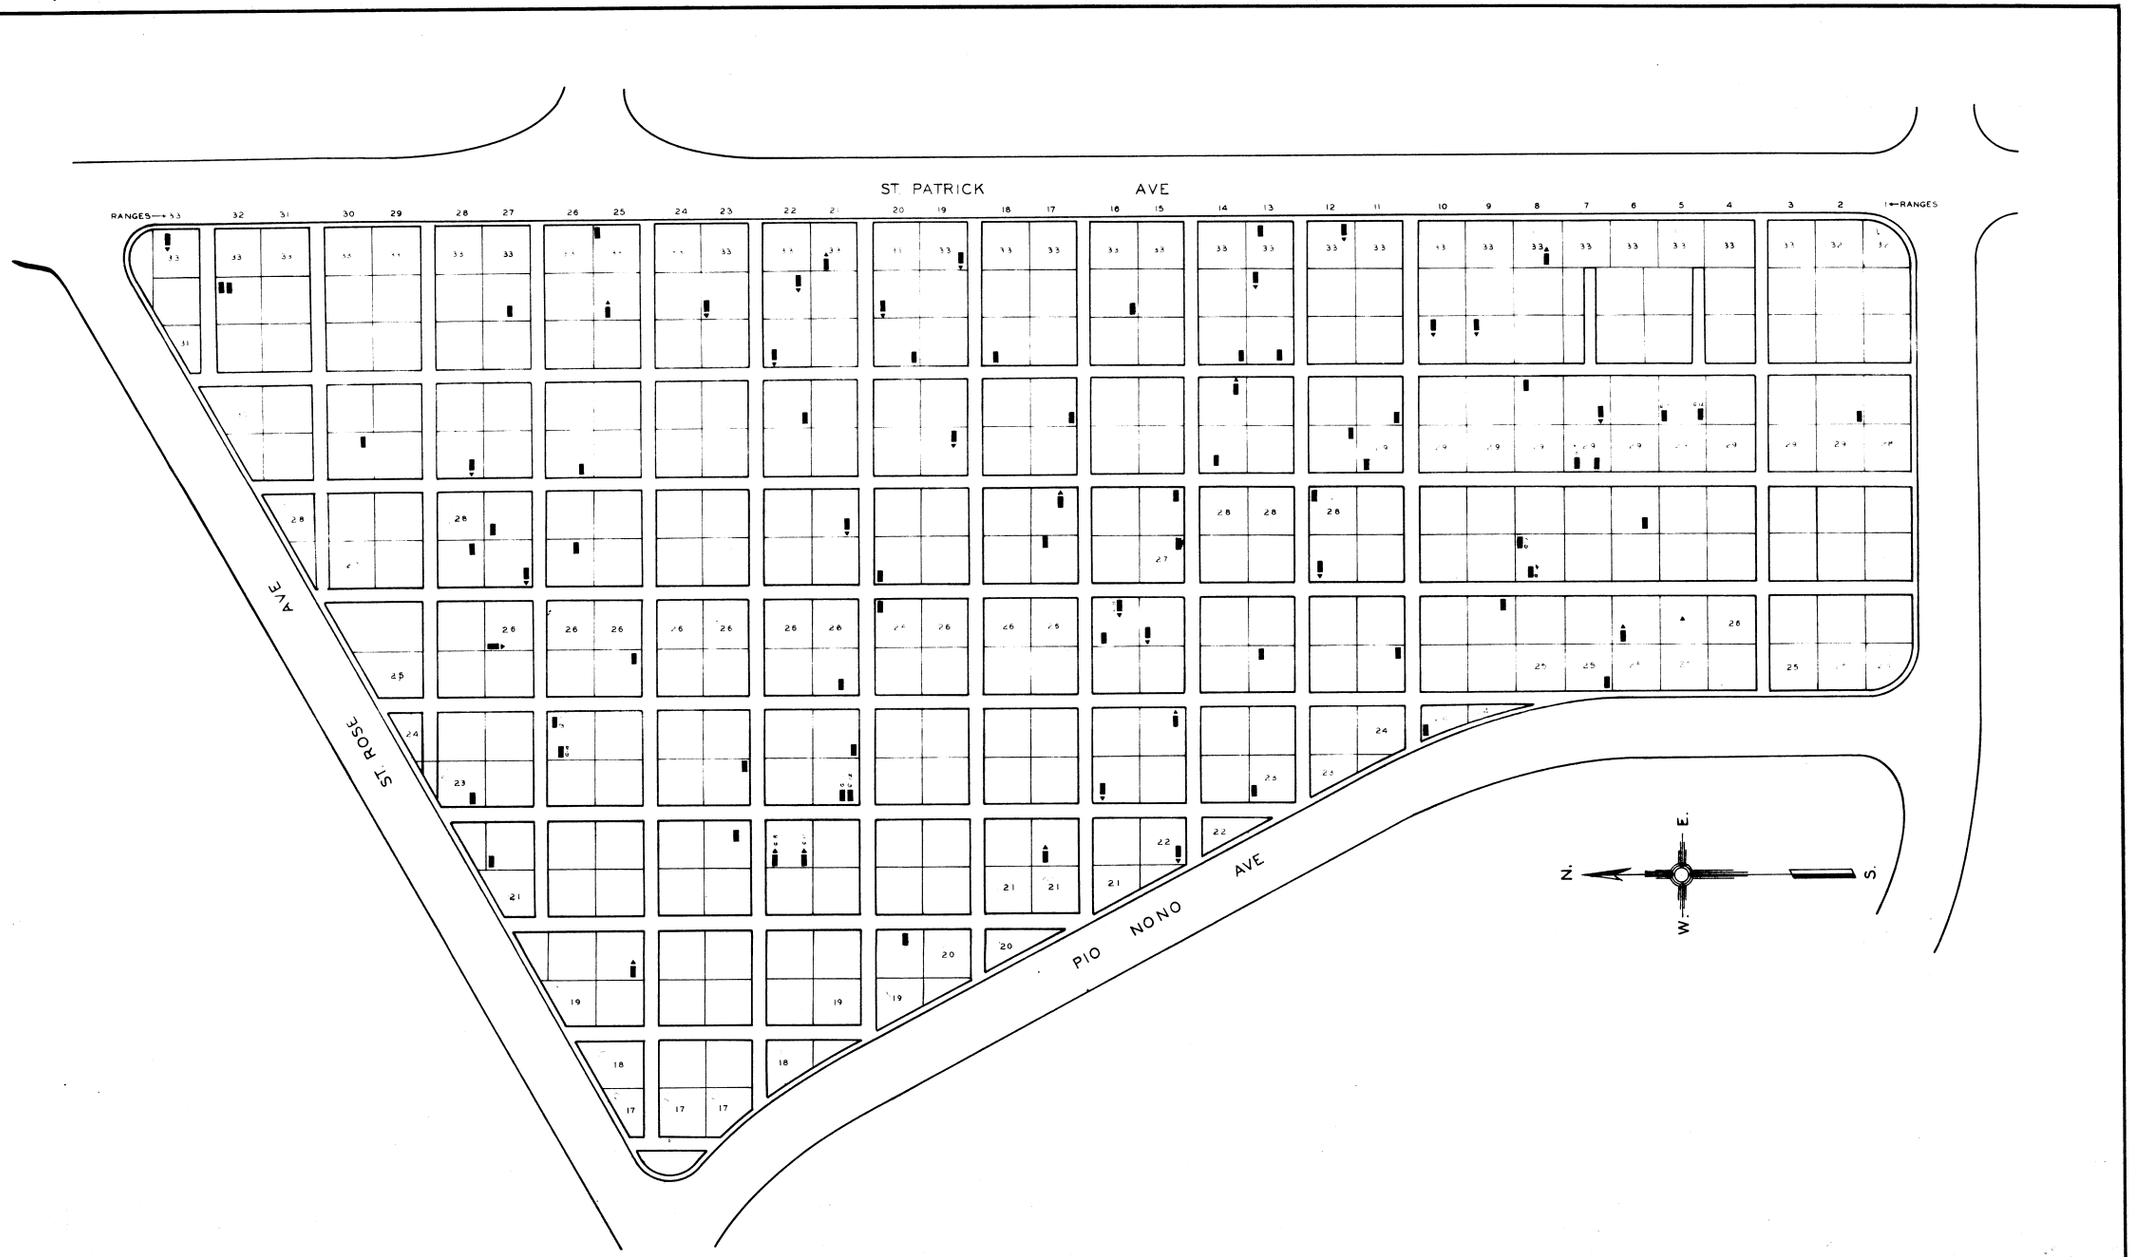

EAST ½ OF N.E. PLAT
SCALE 1" 20'

ST. JOSEPH NEW CEM.
PAGE 413

WEST ½ OF N.E. PLAT
SCALE 1' 20"

ST. JOSEPH NEW CEM.
PAGE 414

RANGE	LOT	GRAVE	WAR	NAME
10	3	12	19	BAIN JOHN F.
4	17		19	BRUCE JAS.
1	16		19	BURK THOS.
4	2	6	19	CALLAHAN MICH'L.
2	9	1	19	CAVANAUGH PAT'K.
7	6	7	19	CHAMBERS GEO. M.
8	11	4	19	CONWAY JOHN
5	8	8	19	CORBETT B. C.
9	7	3	19	COUGHLIN JOS. B.
6	4	4	19	COVALT JOHN S.
4	1		35 31	CRANE MARTIN
4	21	9	19	CRONIN MARTIN
4	1		25	CRYNES JOS.
12	1	10	19	CUMINGS JAS. JR.
5	3	8	19	CUNNINGHAM EDW.
5	9	10	19	DEMRIDY DOM'K. DENNEDY DOM'K.
2	5	1	19	DESMOND CORN'S.
1	5	15	19	DEVINE JOHN
8	5	12	19	DONOHOE JOHN
1	2	2	19	DORAN JAS.
5	8	1	19	DORAN MICH'L.
6	2		19	DORAN RICH.
10	7		19	FITZPATRICK JOHN
3	5		19	FOX THOS. B.
7	7	9	19	HARRINGTON TIM
	18		19	HARWOOD FRED'K.
2	3	12	19	HAYES JOHN
3	22	4	19	HEENAN JOHN C.
1	17	5	19	JACOBS JOHN P.
2	4		19	KENNEY B. J.
3	8		19	KIRWIN THOS.
8	12	2	19	LACY NICH.
4	5	7	19	MAXWELL WM.
7	12	4	19	McDERMOTT JOHN.
11	4	3	19	MURPHY DAV.
6	17	5	19	MURRAY JOHN B.
8	7	2	19	O'BRIEN WM.
13	3	8	19	O'CONNELL JOHN
13	3	7	19	O'CONNELL DAN'L
1	11	7	19	O'CONNELL DAN'L.
4	12	3	19	O'CONNER JAS.
4	18	4	19	PECHENEY PET. F.
4	11	7	19	REGAN THOS.
3	14	6	19	RUSSEL WM.
3	14	5	19	RUSSELL P. J.
2	13		31	SWEENEY CHAS. S.
9	2		19	TROY JOHN
10	6	11	19	VALE JOHN F.
2	17		19	WALL EDW.
1	9	2	19	WATTERSON JOHN
1	16	11	19	BURKE MARTIN
2	2	4	25	SHAFER CHAS. W.
6	16		33	GORMAN JAS.

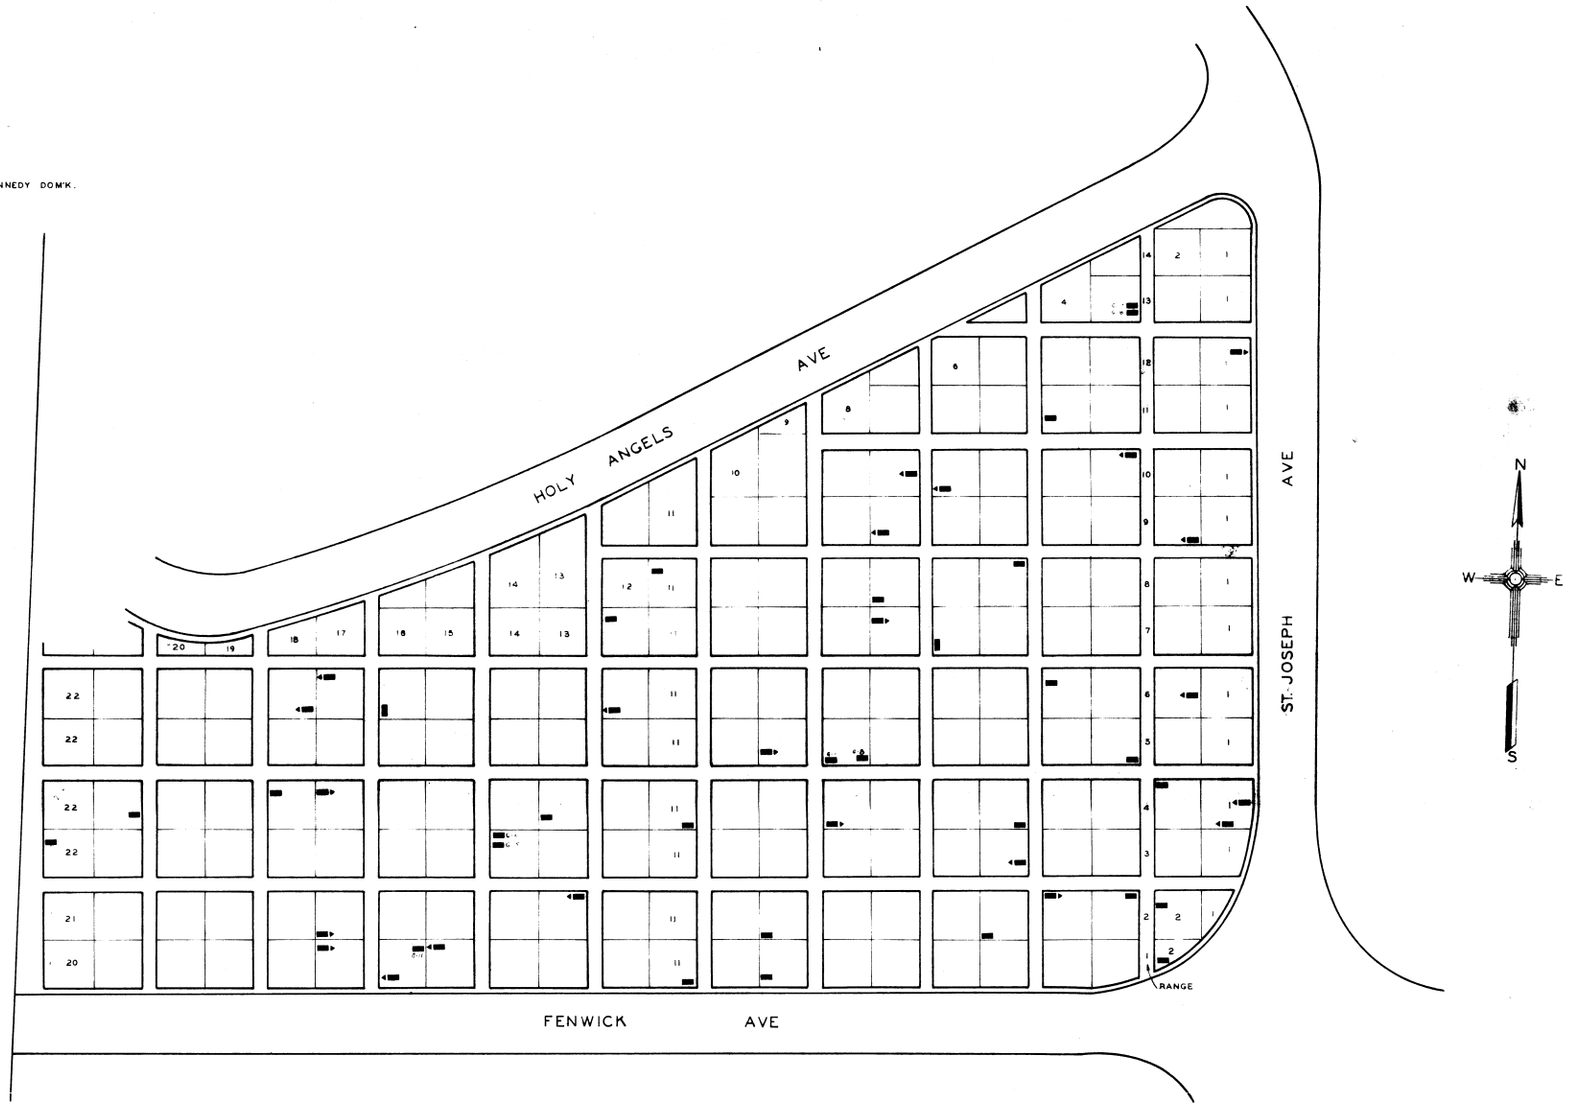

N.W. PLOT
SCALE 1" 20'

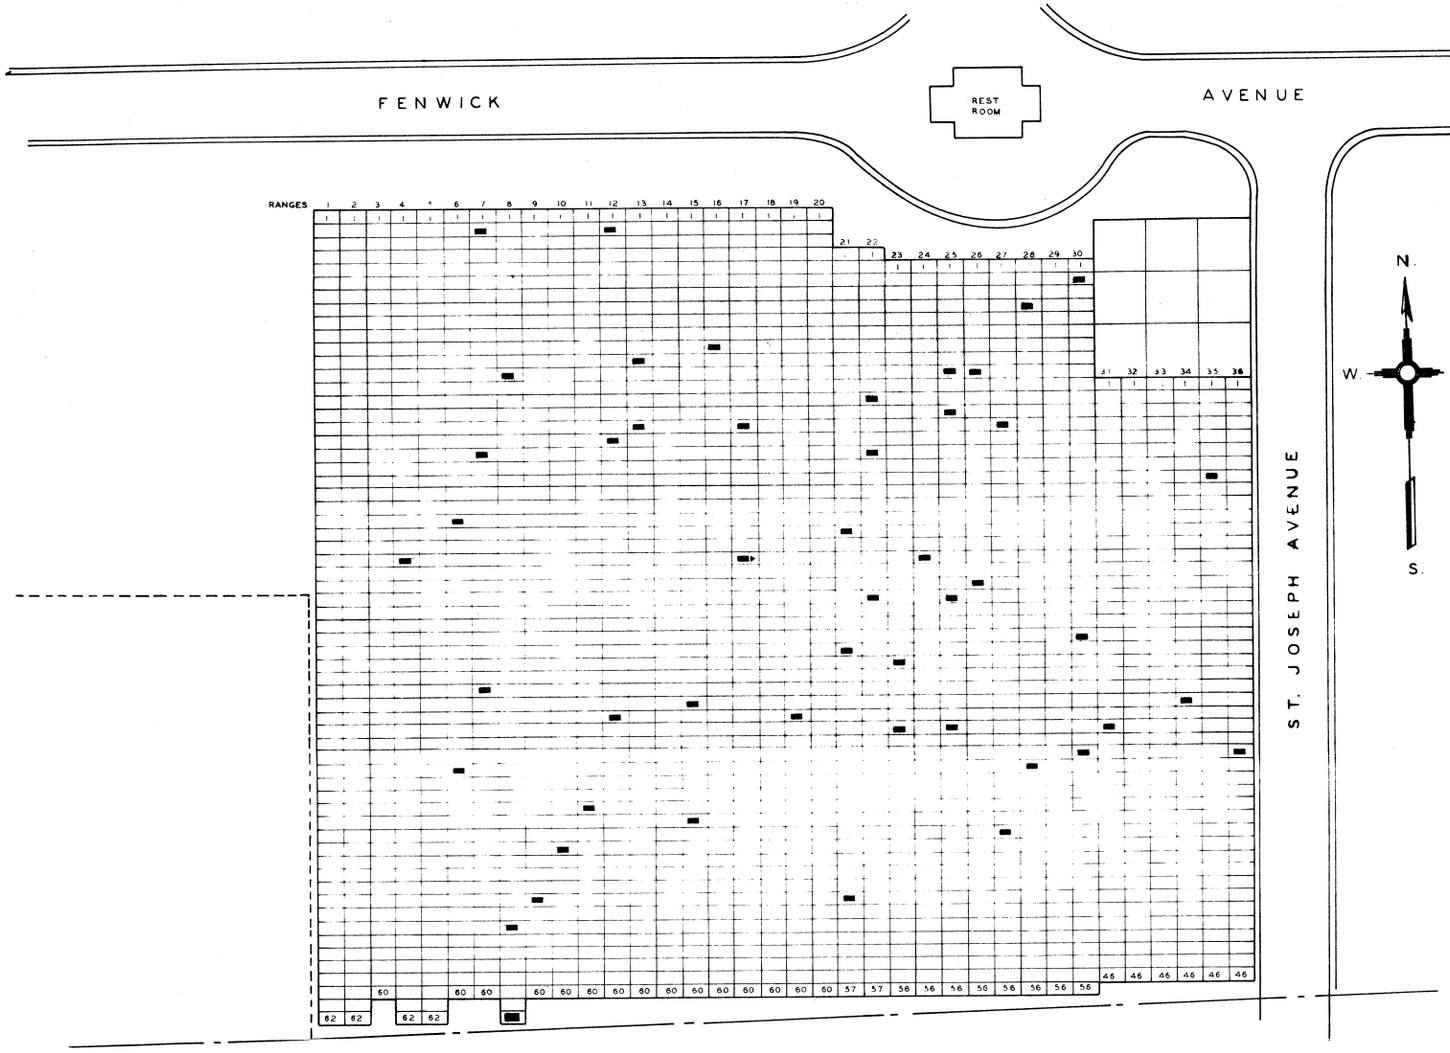

RANGE	GRAVE	WAR	NAME
25	26	19	BATES FRANCIS M.
8	55	19	BERRY LAW.
9	53	19	BROWN CHAS.
21	31	19	BROWN WM.
22	12	19	BURNS JOHN
34	25	19	CAHILL JAS.
27	44	19	CARROLL TIM.
27	13	19	CONROY JOHN
8	13	19	COONEY JOHN
25	36	19	CUNNINGHAM JOHN W.
22	16	19	DAVIS JOHN
11	46	19	DOYLE TIM.
15	47	19	DWYER JOHN
7	19	19	FINNEY JAS.
13	12	19	FITZGERALD JAS.
4	27	16	FOX JOHN L. B.
10	49	19	GAINEY WM.
23	31	19	GOODWIN WM.
25	9	19	HALL JAS.
BURIAL UNKNOWN		19	HAYES WM. T.
26	25	19	HEAD WM. J.
21	22	19	HORAN JAS.
16	11	19	KAVANAUGH EDW. J.
22	27	19	KENNEDY WM.
12	2	19	KERR JAS.
23	36	19	KING THOS.
30	29	19	LEE JOHN
30	2	16	MAGUIRE MICH'L.
25	12	19	MAHONEY JOHN
12	18	19	MARTIN JOHN
31	27	19	McCARTHY JOHN
13	17	19	McCARTHY JOHN
19	39	19	McCLAIN THOS.
21	50	19	McCORMICK ALF.
28	40	19	McLAUGHLIN JOHN
12	39	19	McLAUGHLIN THOS.
36	29	19	MORGAN JOHN
30	38	19	MUNN ROB'T.
24	23	19	O'BRIEN THOS.
8	62	19	PRATT JOHN
35	8	19	RAY JOHN W.
BURIAL UNKNOWN		19	RUSSELL JAS.
17	17	19	SOUTHARD JOHN
26	9	51	STEELE WM.
28	4	19	TOBIN JOHN
6	24	19	TOOHEY JAS.
17	27	19	WALSH JAS.
BURIAL UNKNOWN		19	JOHNSON JAS.
7	2	19	CLANCY MICH'L.
15	38	19	DOOLAN MICH'L.
7	37	19	[illegible]GARA PAT'K.
6	[illegible]	19	[illegible]EVIN PA[illegible]

OLD SINGLES
SCALE 1" 20'

RANGE	LOT	GRAVE	WAR	NAME
9	22	11	19	BONNY JOS. M.
4	16	10	19	BRAY JOHN T.
10	18	10	19	BROWN MAURICE D.
4	16		19	BRAY JERRY
4	7	12	19	BROPHY MICH'L.
9	30	6	19	BYRNE WM. S.
7	18	3	19	BURNS THOS.
9	10	5	19	BUTLER THOS.
3	9	8	19	BRADY DESALES (SISTER) (NURSE)
2	9	12	19	BONNER ETIENNE (SISTER) (NURSE)
3-4	HOLY FAMILY	8	19	CLARK WM. J.
9	19	6	19	CUNNINGHAM JOHN
10	11	1	19	CLARKIN JOHN
4	23		19	CLEARY MICH'L.
10	20	6	19	DAVIS THOS.
9	17	5	31	DELANEY JOS. F.
7	27	9	19	DONOVAN TIM. S.
1	15	10	31	DOWNS WM.
6	8	2	33	DONOHUE JOHN
2	7	12	19	

RANGE	LOT	GRAVE	WAR	NAME
1	6	11	19	FINN DANIEL
8	31	2	25	FLANAGAN MICH.
10	6	6	19	GRIFFIN PAT.
6	30	5	19	HART ANTHONY
7	8	5	19	HART JAMES
5	17	1	19	HOLDEN JNO.
1	4	3	19	HUGHES JNO. C.
5	19	7	19	HYLAND JNO.
7	10	11	25	HOAR JAS. M.
2	29	1	31	HUGHES ALB.
9	20	4	19	HYLAND KERNS
3	17	4	19	JOYCE JOHN
8	19	5	19	KENNEDY PAT.
3	16	4	19	LEARY TIM.
1	6	1	19	MALONEY PAT.
4	21	33	19	MANNING THOS.
3	31	1	19	MARTIN EDW.
4	6	4	19	MARTIN JNO.
1	25	6	19	McCLOSKEY PAT.

RANGE	LOT	GRAVE	WAR	NAME
10	31	6	19	McFADDEN CHAS.
2	28	11	19	MOSS WM. T.
3	21	3	19	MURRAY JAS.
6	10	4	19	MULLIGAN C.
10	19	1	33	MURPHY JAS. W.
1	7	9	19	MURPHY JAS.
8	27		31	McDONALD GEO. W.
5	22	10	19	NEALON PAT.
7	25	10	31	O'CONNOR WM.
5	10	7	19	O'DONNELL PAT.
8	17	5	19	O'NEIL JAS.
6	28		19	PURTELL JAS.
3	19	4	19	QUINN MATHEW J.
4	24		19	RYAN DENNIS
8	31	12	25	SCHAEFER JOHN
2	4	1	19	SHEA JNO.
8	21	1	33	SULLIVAN H.
9	9	6	25	TOBIN PET.
5	33	6	19	WILL HENRY

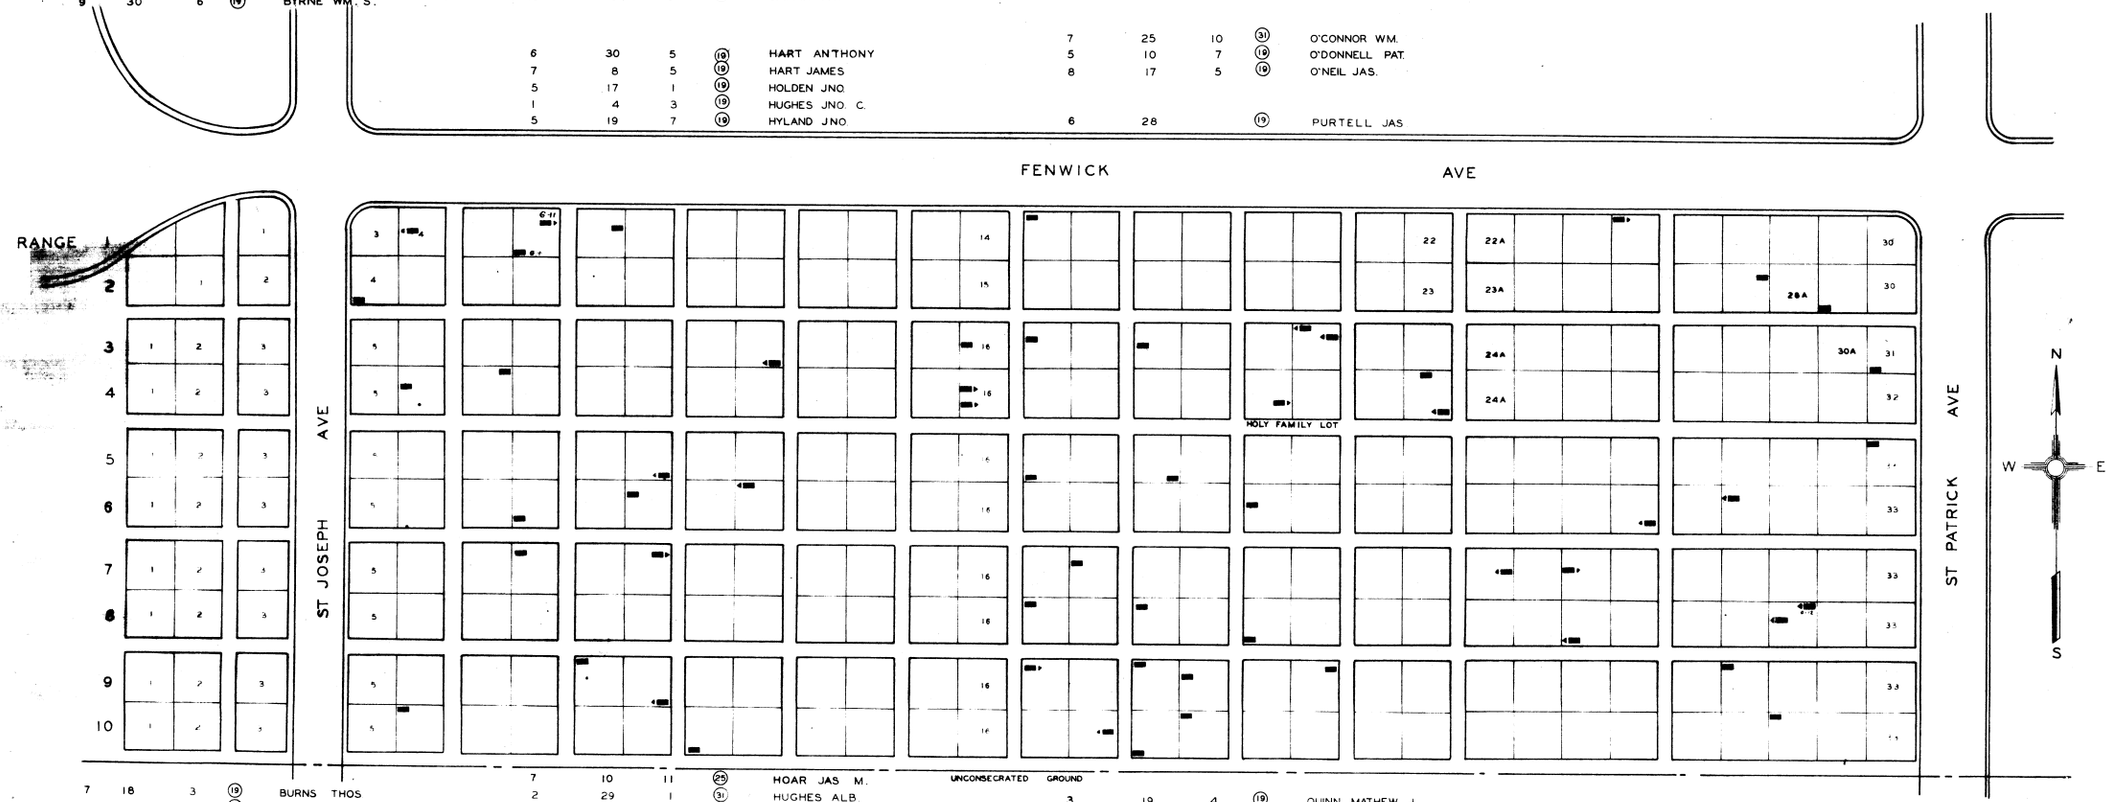

S.E. PLAT
SCALE 1" 20'

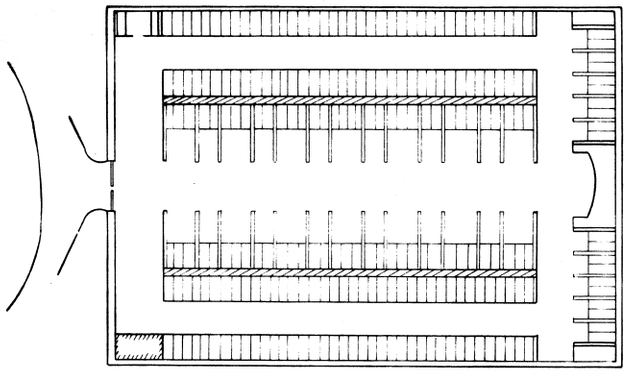

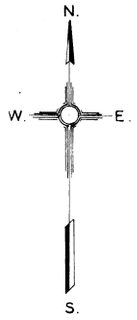

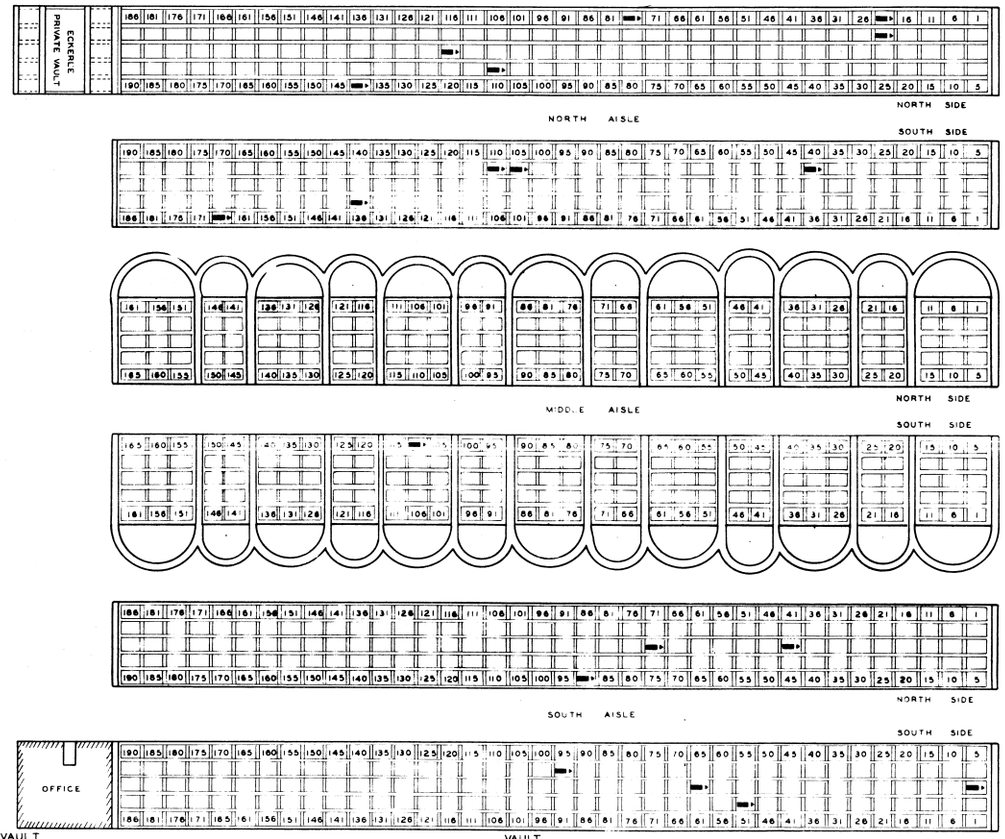

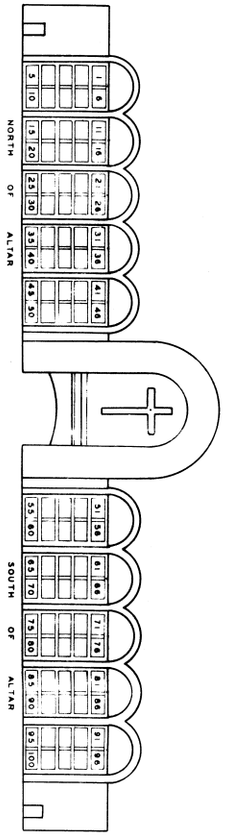

SECTION	VAULT NO.	WAR	NAME
NA	104SS	31	BRENNAN JOSEPH JR.
NA	118 NS	31	CATALANO ANTHONY J.
NA	109NS	31	CATALANO CHARLES
NA	137 SS	31	CONWAY JOHN G. JR.
SA	63 SS	31	FLAMM GUSTAVE A.
NA	21 NS	29	FROEHLICH PHILLIP
NA	22NS	19	FROEHLICH KARL
SA	52SS	31	GERHARDUS LEO PETER
NA	140NS	31	HACKMAN EDWARD
SA	73NS	19	HUMMELL JOSEPH
NA	76NS	19	KELLEY JOHN H.
SA	90NS	31	KNECHT CHARLES J.
SA	43NS	19	MIDDENDORF FRANK
SA	3SS	29	MC HALE THOMAS
CA	110SS	31	RE LEONARD
NA	166SS	31	RILEY EDWARD G.
NA	39SS	34	ROTH MARCELLUS
NA	109SS	31	SCHWAB ANTHONY J.
SA	94SS	31	WHITE JOHN

CINCINNATI CATHOLIC MAUSOLEUM

ST. JOSEPH CEMETERY (NEW)

LEGEND

1 REVOLUTIONARY WAR
10 WAR OF 1812
16 WAR WITH MEXICO
19 CIVIL WAR
29 SPANISH WAR
31 WORLD WAR

HISTORY

ESTABLISHED 1913

SCALE 1"-20'