SPRING GROVE CEMETERY

CINCINNATI HAMILTON CO.

OFFICIAL PROJECT NOS 465-42-3-467 AND 665-42-3-232

LEGEND

(1) REVOLUTIONARY WAR
(2) GEN SULLIVANS EXPEDITION AGAINST SENECA INDIANS
(3) WARFARE WITH INDIANS ON FRONTIER
(4) WHISKEY REBELLION OF PENN
(5) WAR WITH FRANCE
(6) WAR WITH ALGIERS (FIRST NAVAL DEMONSTRATION)
(7) WAR WITH TRIPOLI
(8) GEN HARRISONS CAMPAIGN AGAINST TECUMSEH & LEGUE
(9) INTERVENTION OF WEST FLORIDA
(10) WAR OF 1812
(11) CREEK INDIAN WAR
(12) FINAL WAR WAR WITH ALGIERS
(13) FIRST SEMINOLE WAR
(14) BLACK HAWK WAR IN ILLINOIS
(15) SECOND SEMINOLE WAR
(16) MEXICAN WAR
(17) TROUBLE WITH INDIANS IN THE NORTHWEST. SIOUX WAR
(18) EXPEDITION AGAINST THE COEUR D'ALENE AND CHEYENNES INDIANS
(19) CIVIL WAR
(20) SIOUX-CHEYENNE WAR
(21) INDIAN UPRISING OVER 200 BATTLES FOUGHT BETWEEN U.S. & INDIANS (DURING THIS PERIOD)
(22) BATTLE LITTLE BIG HORN (CUSTERS LAST STAND) SIOUX WAR
(23) EXPEDITION IN TEXAS
(24) INDIAN WAR
(25) WAR WITH SPAIN
(26) PHILLIPPINE INSURRECTION
(27) BOXER REBELLION
(28) OCCUPATION OF VERA CRUZ
(29) OCCUPATION OF HAITI
(30) U.S. PUNITIVE EXP. INTO MEXICO
(31) WORLD WAR
(32) NATIONAL GUARD
(33) REGULAR SERVICE (ARMY - NAVY ECT.)

HISTORY

CEMETERY GROUNDS WAS FIRST PURCHASED FROM JOSIAH AND ELIZA LAWERENCE DECEMBER 26 1844 167 ACRES

CEMETERY OFFICIALY ESTABLISHED JANUARY 25 1845

FIRST BOARD OF TRUSTEES WERE WM NEFF A H ERNST A G V POWELL DAVID LORING NATHAND WRIGHT J.C CULBERTSON CHAS STETSON AND GRIFFIN TAYLOR

LANDSCAPING WAS CONSTRUCTED UNDER THE SUPERVISION OF PROF ADOLPH STAUCH

FIRST INTERMEN WAS MARY JULIA BRISBANE SEPTEMBER 1 1845

SPRING GROVE CEMETERY IN 1940 COVERS AN AREA OF 1100 ACRES AND IS ONE OF THE LARGEST IN THE WORLD


GRAY ROAD
WINTON ROAD
SPRING GROVE AVE
UNUSED GROUND
PAGE 448

BURIALS (VETERANS) IN SPRING GROVE CEMETERY
VERIFIED BY ROSTERS OR HISTORIES
LOCATION UNKNOWN

WAR	NAME
19	ALEXANDER NICHOLAS ALLENDER NICK.
	AMES SPENCER B
19	ARMSTRONG WILBUR F.
31	ANDRESS FRANK J
19	BAILEY JOS. OR JOSIAH
	BAKER JESSE P
	BALDING JACKSON
	BARKA JOHN
	BARTON LEVI J
	BEATTY JAS. H
	BE GLE [illegible]
	BE HER [illegible] HAS [illegible]
	BEL HENRY
	BENNETT WM [illegible]
	BENT[illegible] AB'R
	BID[illegible] E
	[illegible]
	[illegible] PETE[illegible]
	[illegible] JOHN A
	B[illegible] HERMAN
	B[illegible] JOHN
	BOND JOHN
	BREWER AUST[illegible]
	BR[illegible] SAM
	BROWNE HARRY
	BUCHANAN AAC
	BUCHANAN JAS
	BURTON JOHN
19	BUSHNELL SHERMAN
	BROWN DAV'D
19	BROWN GEO.
	BRUNSTUTTER H.
31	BELZ ELM.

WAR	NAME
19	CALDER JOHN A.
	CALDWELL WM. A.
	CARMODY JOHN
19	CARRY TIM F.
1	COOPER SPENCER
19	EDGINGTON JOHN
19	EVANS DAVID E
19	FAIR LEONARD
19	HANSELMAN CHAS.
31	HINES JOS
19	HOER HENRY
19	HUGHES PAT'K.
19	HUDSON MILTON
19	HELMAN MAT'H.
31	HILL JOS. E.

WAR	NAME
19	JOHNSTON ISAIAH R
19	JONES JAS. W.
19	KAPPES [illegible]
19	KENNETT [illegible]
19	KETTLEBERG LOU A
31	LONG GRANT
19	MILLER [illegible]
19	PINGIR CHAS.
19	PIPER HENRY

WAR	NAME
1	TODD WM
19	TIMBERMAN JAS. C.
31	WILLYS DALE

GRAVE	SECTION WAR	NAME
2304	31	ARCKEL TONY
2087	31	BAGEL ROGT E.
716	19	BELL JAS. L.
1464	19	CARROLL THOMS. H.
1951	31	CLAUNCH CLEVE.
499	19	CLEMENT AUG.
2432	19	COOK WM. H.
400	31	DEAN FRANCIS
2334	31	DIECKMAN OSCAR
1682	31	ESTERLING CARL
1207	31	FISHER CLINT.
1905	31	FISHER GEO.
489	31	GESSMAN JOS. H.
406	19	HALL WM.
184	19	JONES JOHN S.
1814	31	KANTTEL GEO. H
364	31	KIEFEL OLIVER E.
1284	31	KINKEAD GRAY
562	19	KOEHNE THEO. K.
2226	31	KUHN GEO. J.
1277	31	LANDENBERGER W. A
865	31	McKAY ART. H.
137	31	NOLTE CLARENCE R.

GRAVE	SECTION WAR	NAME
563	19	PAGE JAS E
2487	31	POOLE CLIFF G
551	19	RIKER SAM. M.
373	19	ROBERTSON REV PETER
773	31	SCHOENFELD WM P.
2027	31	SIMPSON ARCHIBALD
470	19	STAFFORD JOHN
282	19	STANTON BYRON
2262	31	THEOBALD ART J.
1830	31	TUERCK ROGT.
512	31	WILSON ANDUS
974	19	WOLF JOSIAH

GRAVE	SECTION WAR	NAME
225	25	BARKHURST CHAS W
2014	31	GRUEN JOHN F.
2407	25	HOHLANDER F M
261	25	LOHMEYER MENOLF
2483	31	LOTZ JOHN
1044	19	POOR WM W
596	25	WHITE HARRY
1939	25	YOUNG FRANK

GRAVE	SECTION WAR	NAME
1730	23	KATHEDER MICHAEL J.
74	23	KILGOUR HARRY C.
442	19	LOCHNER CHAS.
629	19	PARKER BEN.
1764	25	REDMOND JOHN
1411	25	RUDD WM.
1935	19	SNYDER OLIVER
1391	23	WARD GUY
624	19	McGUIRE MICH'L. A.
2309	25	TIETZ CHAS. F.
1870	33	WENDE BRUNO
734	25	BATZNER CHAS. M.
1678	25	VAN ARNAM FRANK. M
407	19	FURNESS HENRY B.
2125	31	SEEWALD ALB. C.
1735	31	OWRY FRANKLIN J.

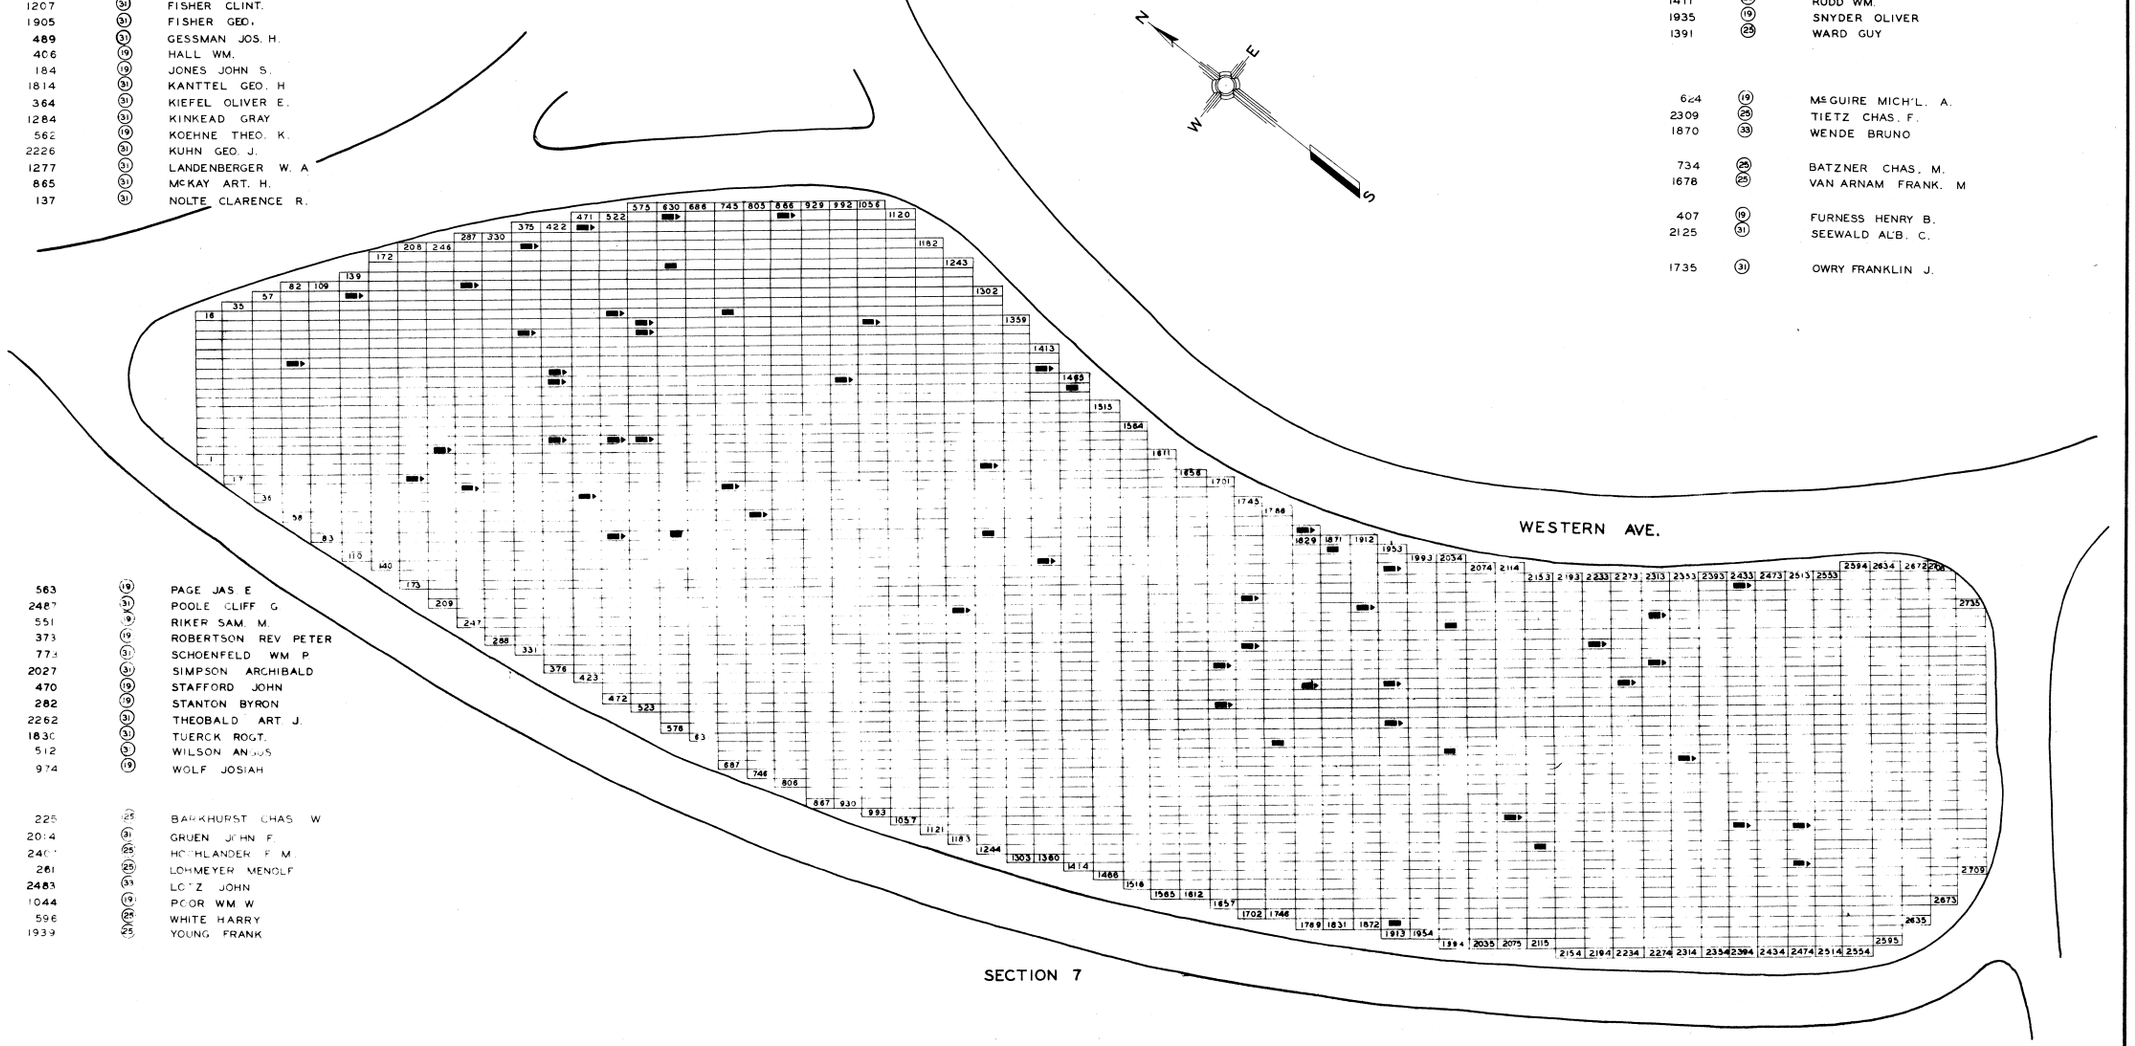

SECTION 7

SCALE 1" = 20'

SPRING GROVE
PAGE 450



GRAVE 3302 WAR 19 NAME CHALK JOHN H (ASHES)

SECTION 9 CHILDREN
SCALE 1"-20'

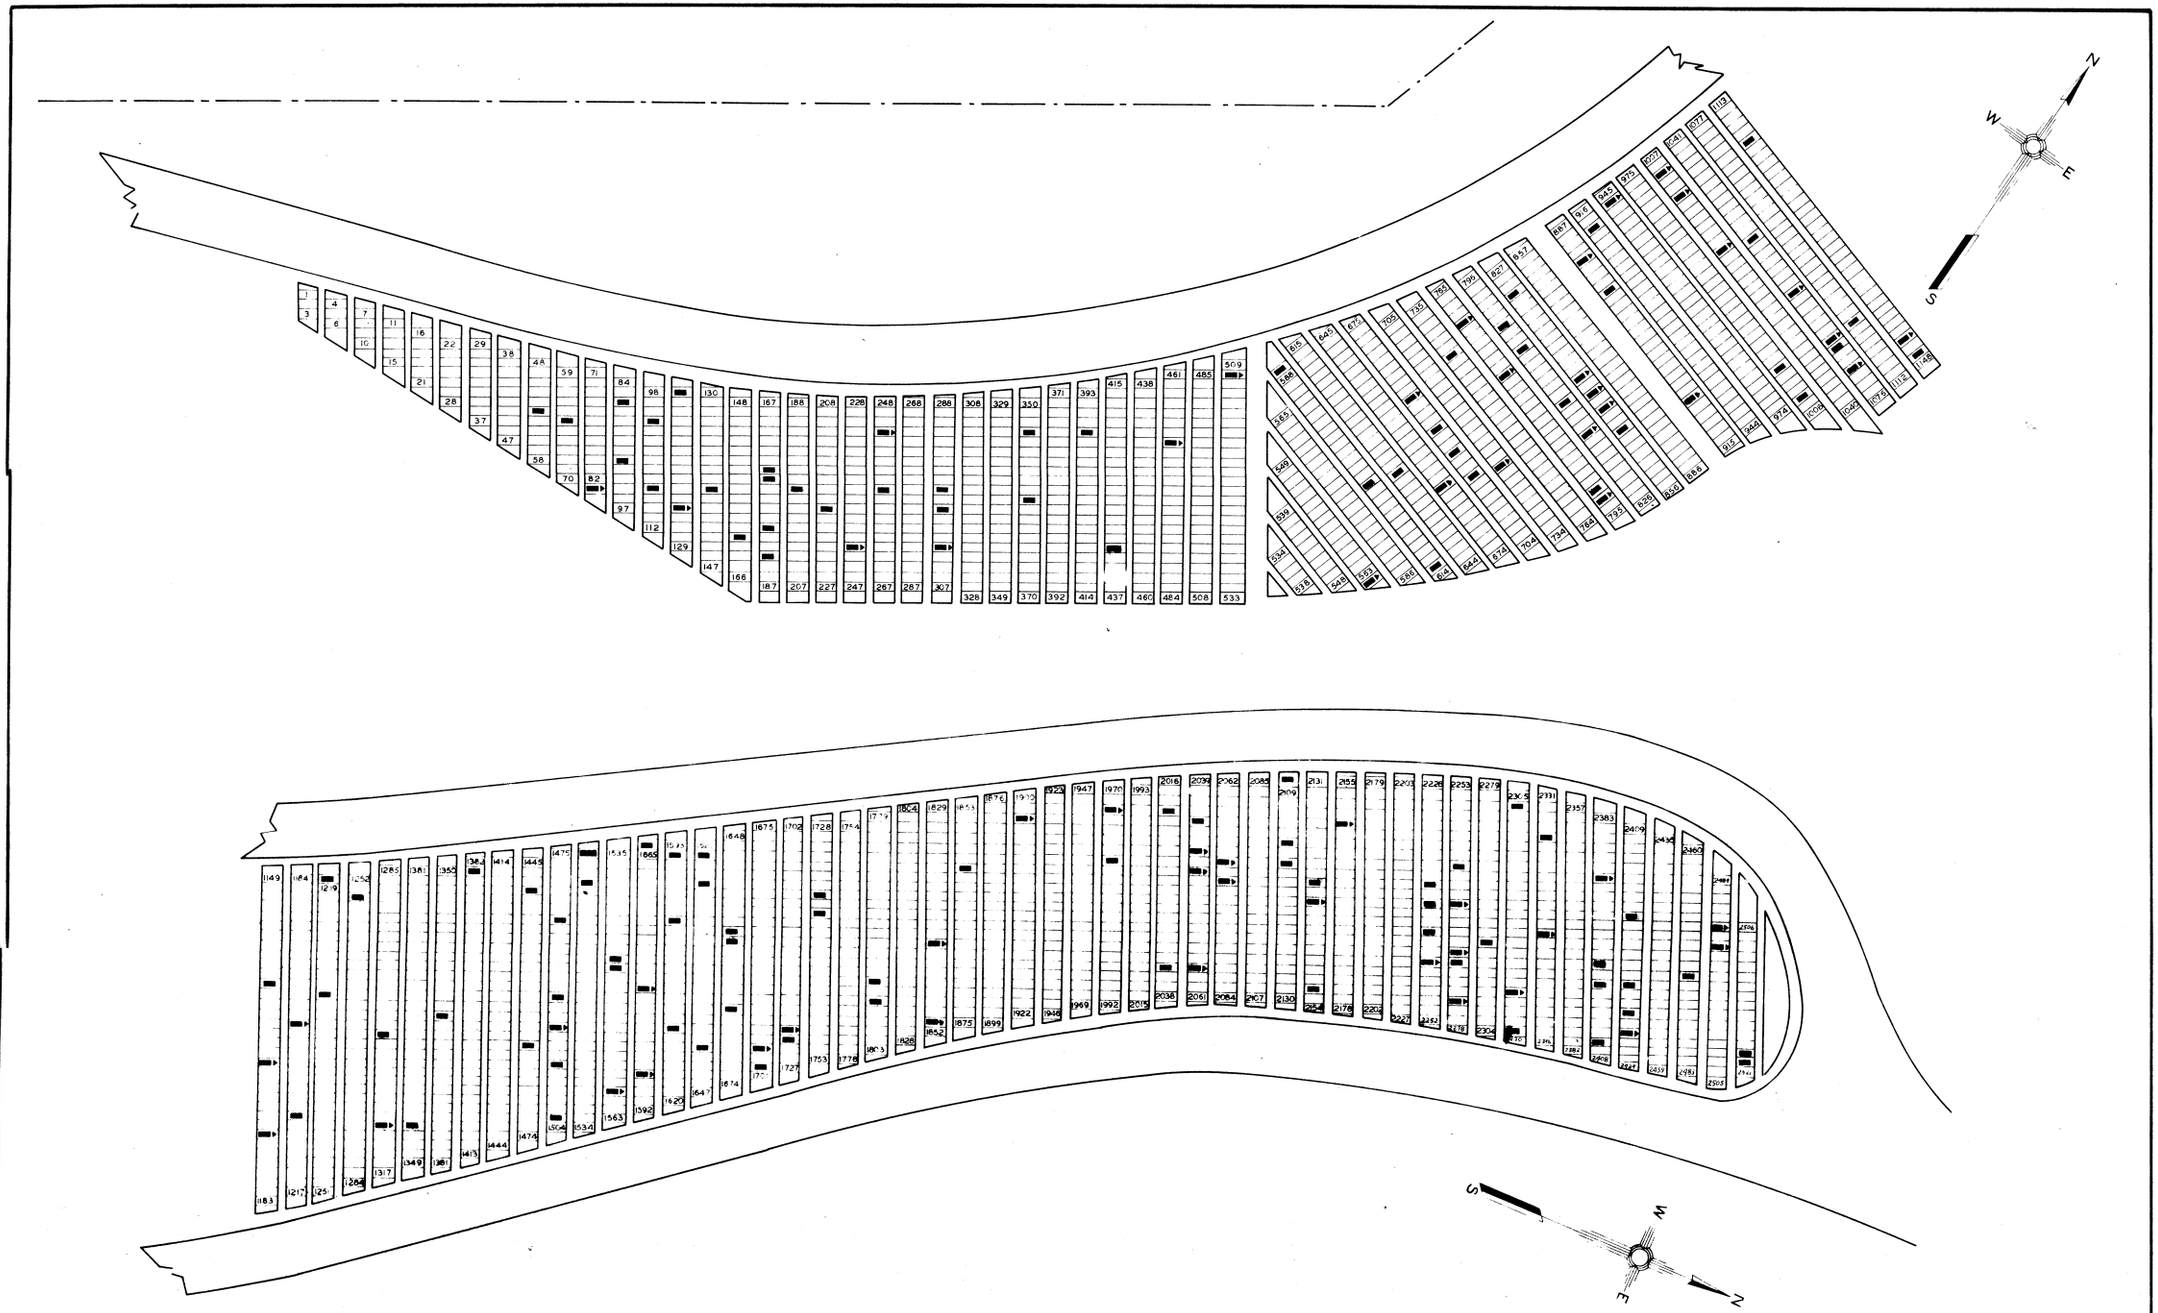

SECTION 9
SCALE 1"-20'

SPRING GROVE
PAGE 452

GRAVE	WAR	NAME
1666	(16)	ANDERSON JAS. H
1493	(19)	ANDERSON WM. H.
918	(19)	APPLEGATE ISRAEL
769	(19)	ARCHIBALD WM. A.
695	(19)	ASSMAN CONRAD
830	(33)	AUPKE HENRY
2335	(19)	BAILEY JOS.
1312	(16)	BAEHR RUD.
1843	(19)	BAUER JOHN
613	(19)	BARNES GEO. R.
1723	(19)	BASSETT JAS. A
251	(19)	BEIGEL MARTIN
685	(19)	BELLER JACOB
2489	(19)	BOGGS R. M.
140	(19)	BOLTZ WM.
1579	(19)	BORN GEO.
108	(19)	BRIGGS JAS.
1176	(19)	BRISTOL DORMAN
113	(19)	BULLARD WM. H.
380	(19)	BUTCHER JAS.
432	(25)	BRENNER PHIL. C.
1068	(19)	BEGGS JAS.
1735	(19)	BELL CHAS.
2400	(19)	BLACK ROB'T. A.
1659	(19)	BLAND GEO. W.
2141	(19)	BOWEN GEO.
510	(19)	CHAPMAN LAFAYETTE
53	(19)	CHRISTIE WM. C.
946	(25)	CLARK CHAS. P.
848	(19)	CLEMENT JOHN D.
2418	(19)	COLLINS CHAS.
792	(19)	COPE THOM.
3302	(19)	CHALK J. H.
1448	(33)	CONRAD GEO.
587	(19)	DEARING GEO. W.
1588	(19)	DECHARMES WM.
1737	(19)	DIETRICH FRANK
841	(19)	DRAKE RUSH
741	(19)	DAY HENRY
2329	(19)	DAIBER HENRY
1798	(19)	ELDER WM. H
1547	(19)	EVANS HENRY C.
1724	(19)	EVANS EDGAR
909	(19)	EBERHARD GEO.
2046	(19)	EBERLE JOS.
1230	(25)	FARMER DAV. C.
101	(19)	FISHER EBEN F.
564	(19)	FLEMING WM. A.
696	(19)	FORBES J. B.
2108	(19)	FOSTER JAS. B
2473	(19)	FRANZMAN JACOB
1564	(19)	FOWLER ADDISON W
1118	(19)	GAILEY CLIFF S
2246	(19)	GAMBLE WM.
835	(19)	GILLESPIE [illegible] W
[illegible]	(19)	GILPIN BEN F
17[illegible]	(19)	GOETZ JACOB
812	(19)	GRANNAN JOS. C.
19[illegible]		HENRY CHAS.
[illegible]14	(19)	HALF CHAS. A.
[illegible]43	(19)	HELBING [illegible] B.
2265	(19)	HELLER CHAS.
2245	(19)	HAYS ALONZO
[illegible]41	(19)	HEINRICH MATTHIAS
[illegible]	(19)	HUPPERT [illegible]
[illegible]6	(19)	HECK MICH'L
724	(19)	HEINTZE JAC'S.
665	(19)	HUBER LUDWIG
56	(19)	IRWIN JOHN
1902	(19)	JACOB DUPPE
1648	(19)	JACKSON WM.
2428	(19)	JOHNSON JAS. E.
136[illegible]	(19)	JOHNSON THOM.
325	(19)	KEIFER WM.
29[illegible]	(19)	KNOWDEN MARK A.
80[illegible]	(19)	KRIEG ERNEST
01[illegible]	(19)	KROMMER MARTIN
47	(19)	KUHN JOHN W.
198	(19)	KENNEDY LYONS
2170	(19)	KIMBALL HENRY H.
2240	(19)	KINSLEY P. W.
622	(19)	KOLDER JOHN
2389	(19)	LANGENBACH J. S.
1460	(19)	LAFRABEE MONTRAVILLE
199	(19)	LARKCOM FREDK.
303	(19)	LEWIS JOHN
1054	(19)	LONG HENRY
81[illegible]	(19)	LONG MARION
464	(25)	LEWIS FRANK
80[illegible]	(19)	LEBKICHER [illegible]
22[illegible]8	(19)	LENTZ HENRY
16	(19)	MURPHY HAMILTON B
2076	(19)	MEYERS WM.
1503	(19)	MANNING ABRAHAM D.
175	(19)	MDDOCK PHIL. C.
174	(19)	MASON JAS.
10[illegible]	(19)	MENSHA[illegible] H.
[illegible]5	(19)	MCGLONE CHAS W.
2035	(19)	MILLER JOS.
149	(19)	MILLER RICH.
162	(19)	MILLER WM.
1145	(19)	MOORE GE.
1560	(19)	MOORE WM. S.
2[illegible]2	(19)	MORRIS PETE.
1218	(19)	MURPHY WM.
1009	(19)	MYERS WM.
1545	(19)	MAYER FRANK
2261	(19)	McELROY DAVID
972	(19)	McMILLEN SAM. M.
1312	(19)	MURRAY TERRENCE
2306	(19)	NORTON CHAS.
1505	(19)	MEISCHKE CHAS.
257	(19)	NORTON JOHN H.
1977	(19)	PARRY JAS.
83	(19)	PERKINS WM.
602	(19)	PONTIUS ANDREW
1508	(16)	REEDER JOHN
1061	(19)	REIGDOR JAC.
2275	(19)	RIDDLE THOM.
1209	(19)	ROBERTS JAS.
219	(19)	ROOS JOHN
2019	(19)	ROSER CHAS.
468	(19)	RUNCKEL JACOB
1851	(19)	ROLLISTER THOM. C.
1497	(25)	SACHS WM. F.
64	(19)	SAMPSON GEO. W.
690	(19)	SCHWAB AUG. F.
2270	(19)	SCHWARTE JOS.
1594	(19)	SHALTER LEVI
1482	(19)	SHANNON ROB.
793	(19)	SHAW JAS.
2345	(19)	SIEGFRIED FRANK
845	(19)	SMITH BENJ. B.
1601	(25)	SMITH HARRY W.
1067	(19)	SMITH JOHN K.
2430	(19)	SPECK EGNATZ
1254	(19)	STEINER CHRISTIAN
2519	(19)	STEWART DAN'L.
2520	(19)	STEWART JOHN
776	(19)	SUNDERMANN HENRY
2295	(19)	SHAW FREEMAN
92	(19)	SIMOND JOHN G.
2271	(19)	SOLON RICH.
1796	(19)	SCHUTTENHELM JAC.
1658	(19)	SMITH GILBERT
1546	(19)	STILES ROBT.
1625	(19)	SELLINS JOHN
072	(19)	TILLET WM.
843	(19)	THILL ADOLPH
2406	(19)	THOMAS WM.
353	(19)	TITUS FRACIS M.
184	(19)	TURNER THOM. H.
174	(19)	VALENTINE JOHN
1490	(19)	VARNER CHAMBERS
243	(19)	VANZANT JAS.
1000	(19)	VANZANT MORRIS
2048	(25)	VOEGELI CHAS.
632	(19)	WALTERS THOM.
2159	(16)	WEBB WM.
1612	(25)	WILLIAMS GEO. H.
1859	(19)	WILLIAMS WM. H.
2058	(19)	WEBBER CHAS.
2043	(19)	WEAVER JOHN
1365	(19)	WILEY ROBT.
1642	(25)	YOUNG WM.
2425	(19)	LONG VERNON



SPRING GROVE SECTION 8

LOT	GRAVE	WAR	NAME
6		(19)	ALMS WM.

SPRING GROVE SECTION 12

LOT	GRAVE	WAR	NAME
3	B28	(31)	SELLEW TIMOTHY G.

SECTION 14
SCALE 1-20

SPRING GROVE
PAGE 454

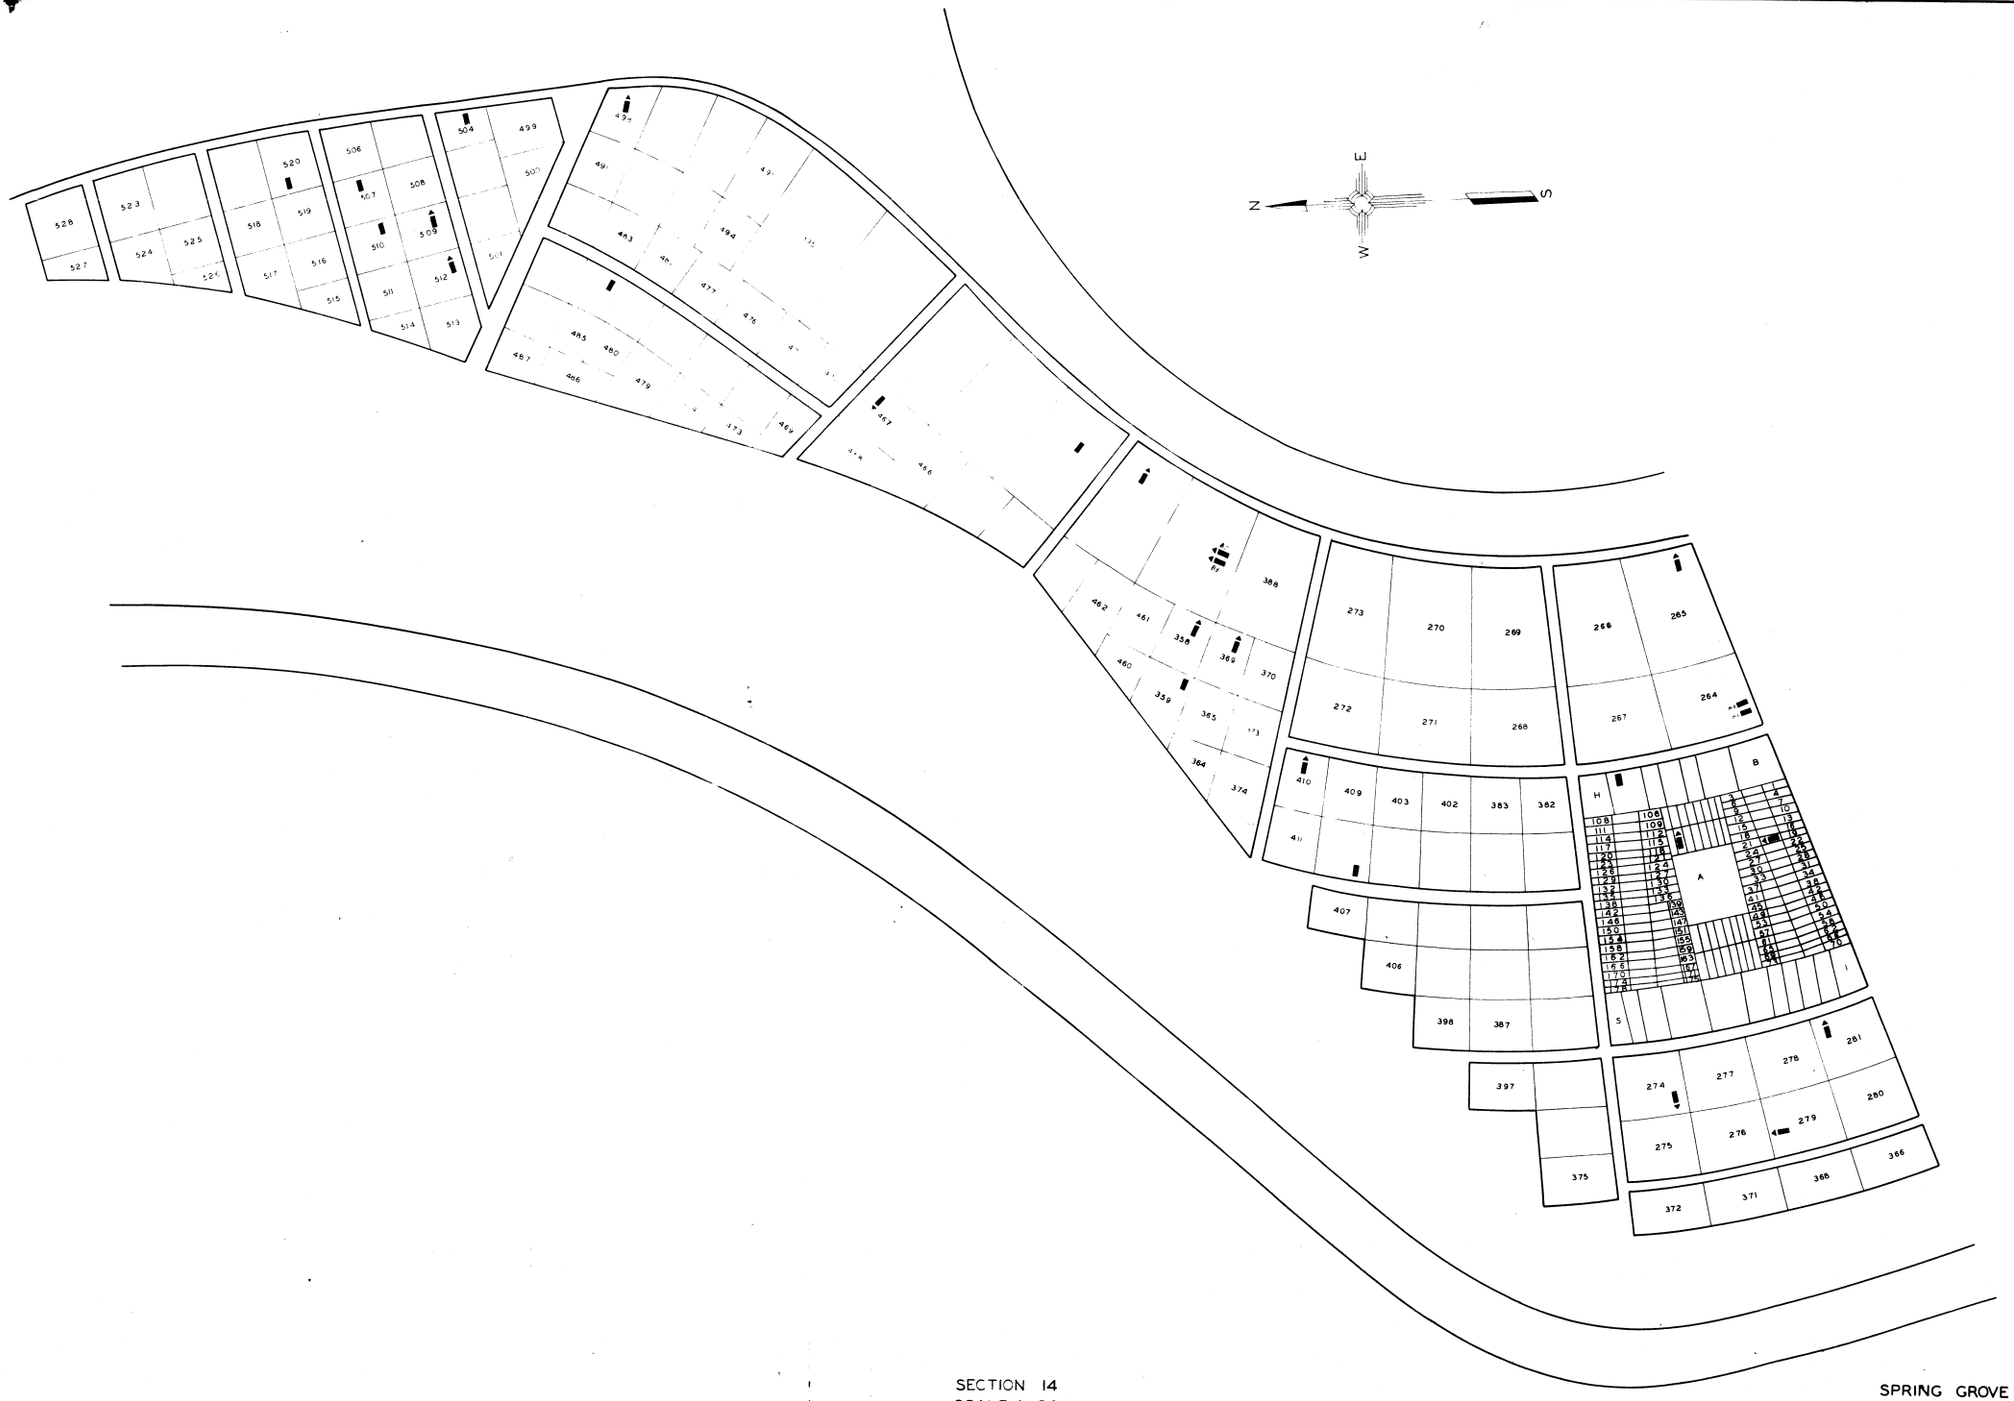

SECTION 14
SCALE 1-20

SPRING GROVE
PAGE 455

LOT	GRAVES	WAR	NAME
	565	(19)	ACKLEY MONTREVELL
369	B1	(19)	ALLEN J.M.
78	B10	(19)	ALLISON JAS.
43	B8	(19)	ANDREWS ALB.
82	B14	(19)	ANNIS CHAS.
1	B2	(19)	ATTEE JOHN
A	20	(19)	ANDERSON JOHN A.
172	6	(19)	BAKER JOHN
		(31)	BENTLEY ROBT. (BURIED IN FRANCE)
335	820	(19)	BANYARD GEO.
	814	(19)	BELL JOSHUA
23	B6	(19)	BENDER HENRY D.
335	B3	(31)	BENTLEY JAS. M.
200	B4	(31)	BLACKBURN CHURCHILL
29	B10	(19)	BOAKE JOHN L.
391	B4	(19)	BOLANDER WM.
281	B8	(19)	BOSWELL JOHN
447	B3	(19)	BROWNE JAS. A.
	298	(16)	BROWN JOS.
135	B12	(19)	BROOKS PHILIP H.
	759	(16)	BRUNS HENRY
155	B6	(31)	BUNS HARRY F.
58	B3	(33)	BURBANK SIDNEY
282	B6	(29)	BURRUS JOHN W.
467	B4	(31)	BUTLER LESTER M.
135	B16	(19)	BROOKS DAVID T.
749	749	(33)	BISHOP J. W.
509	B1	(19)	CAMPBELL JOS. W.
	303	(19)	CHAMBERLAIN HENRY
	560	(19)	CHARLES WM. H.
31	B2	(19)	CHERRY ELIAS V.
	848	(19)	CHRISTOPHER WM.
	891	(19)	COOK GEO.
25	B15	(25)	CONRAD CHAS.
60	B4	(19)	CAREY SAML. D.
116	B8	(19)	CORDES HY.
119	B1	(19)	DAMMERT WM.
	872	(19)	DAY DAV. L.
224	B3	(19)	DAVID CHAS. S
16	B1	(19)	DAVIS WM. B.
504	B6	(19)	DAVIS WM.
13	B19	(19)	DECAMP W.F.
	695	(19)	DORNBUSCH WM.
103	B10	(19)	DOTY JOHN
37	B5	(19)	DAVIDSON HY. C.
198	B4	(19)	DINKELMANN AUG. H.
216	B6	(19)	DOERR JOS.
294	B9	(20)	DAWE CORTLAND W.

LOT	GRAVE	WAR	NAME
389	B 7	(19)	EBERSOLE GEO. R
389	B 9	(19)	EBERSOLE GEO. C
	762	(19)	ENGEL MATHIAS
97	B 8	(19)	ESCHMAN JACOB
227	B 6	(19)	EVERHARD THEO. G (ALIAS BENJ. F. ABRAMS)
234	B 2	(19)	FABER JOHN
166	B 6	(19)	FINCH HENRY
	54	(19)	FISCHER JOHN
91	B 3	(19)	FISHER AS
158	B 7	(19)	FOSTER CHRISTOPHER
342	B 1	(19)	FREYTAG FREDERICK
111	B 3	(19)	FRITZ JACOB
233	B 8	(19)	FROST JOHN
	897	(19)	FRY JOSIAH M
309	B 7	(19)	FURRY WM
458	B 3	(19)	FORBES CHAS. P
111	B 8	(19)	FRITZ LOU
232	B 5	(19)	GAY JOHN M
	322	(19)	GARWOOD RICHARD
261	B 3	(19)	GEILFUS LOUIS
453	B 4	(31)	GIEHL LOUIS P.
170	B 1	(19)	GLASSER FREDERICK
390	B 8	(19)	GOSHORN EDWIN C.
	253	(19)	GRAHAM MICHAEL
327	B 1	(19)	GRIFFIN JOHN W.
149	B 9	(19)	GEHRING CHAS
	949	(19)	GUERTLER PETER
309	B 3	(19)	GUDBERLET GEO
39	B 9	(19)	HAGEMAN LEWIS M.
96	B 9	(19)	HAHN PETER
313	B 8	(19)	HALL WM
	821	(19)	HARRIS LAWS
194	B10	(19)	HARTMAN WM. H.
305	B10	(19)	HAZARD ROBERT P.
99	6	(19)	HEATH THOMAS T.
	135	(19)	HECKMANN PETER SR
164	B 8		HIDEBRANDT ART M.
40	B 5	(19)	HILL WM. H.H.
	482	(19)	HILTON SAM'L.
435	B 4	(31)	HOFFMAN EDWIN V.
	334	(19)	HOLMES HENRY
20	B 4	(19)	HOPPER GEO. W
335	B11	(19)	HORNICKLE CHRISTIAN
84	B 3	(19)	HOWDEN ROB'T.
	257	(19)	HUBER FREDERICK
18	B 8	(19)	HUNT CHAS. B
165	B 6	(19)	HUNTER JAS.
	784	(19)	HANES PERRY
295	B 5	(19)	HARMS RICH
95	B11	(25)	HEARTH LOUIS
418	5	(19)	HOFFMAN VALENTINE
520	B 6	(19)	ISHMAEL GEO
18	B 7	(19)	JACKSON RUFUS
35	B 5	(19)	JOBSON FRANK G
167	B 4	(19)	JOHNSON JOHN
	37	(19)	JOHNSON SAM'L.
167	B 5	(19)	JOHNSON WM. M.

LOT	GRAVE	WAR	NAME
38	B16	(19)	KING CHAS.
50	B 1	(19)	KLEEMAN NICHOLAS
358	B 4	(19)	KLUG JOHN W.
117	B 2	(19)	KOCH LOUIS
	970	(19)	KORNMANN SIMON
	343	(19)	KRUSE L.
208	B 1	(19)	KUHN DAV.
	112	(19)	KERNS LOUIS
1	B 8	(19)	LANE SAM'L.
[illegible]	B 8	(19)	LEIVE HERMAN
348	B 3	(19)	LONG JAS. P.
64	B15	(19)	LORENTZ FRANK
48	B 5	(19)	LYONS DAV. H.
147	B10	(19)	LOYD WM.
498	B 1	(19)	LONGNECKER A
44	B 1	(19)	MANSBERGER CHRIST
216	B 4	(19)	MAYER JOSEPH F.
223	B12	(19)	McCAMMON CHAS. E.
	772	(19)	MELROSE MARK
	311	(19)	MEYER JACOB
	826	(19)	McGOWAN ELLIOT
359	B 5	(19)	MILLER GEO.
178	B 6	(19)	McLACHLON JOHN
178	B 5	(19)	McLACHLIN W.S.
310	B 9	(19)	MOSER GEO.
31	B 9	(19)	MURDOCK GEO. A.
29	B 4	(19)	MULLER THOS.
49	B 1	(19)	MURPHY JAS.
247	B 4	(19)	MOSELEY JOHN B.
81	B16	(19)	MYERS JACOB
30	B11	(19)	MYERS JOHN
265	B 4	(19)	NEALENS JOHN
	494	(19)	NELSON BENJ. F.
	938	(19)	NELSON THOMAS
510	B 2	(19)	NICHOLSON GABRIEL L.
263	B 3	(31)	NIPPERT KARL R.
189	B 3	(19)	OBERKLINE GEO.
	266	(19)	OCHS CONRAD
223	B 3	(19)	O-DONNELL NORMAN
63	B 4	(19)	OGDEN ALEXANDER
	754	(19)	OVERMAN HENRY
	130	(19)	O'DONNELL GEO.
	796	(19)	PARNELL HENRY
	57	(19)	PETERS HENRY
168	B12	(19)	PETERS SYLVESTER
	836	(19)	PFLUG AUGUST
321	B 2	(19)	PHILLIPS CHAS.
321	B 4	(19)	PHILLIPS GEO. N.
321	B 8	(19)	PHILLIPS THEOPHOLIS
484	B 2	(19)	PIERSON DAV.
264	B 2	(19)	PORTER CHAS. F.
	44	(19)	PRICE THOMAS
	868		POWELL GEO. W.
264	B 1	(19)	PORTER JAS. T.

LOT	GRAVE	WAR	NAME
156	B 7	(19)	RADABAUGH JOHN
	576	(19)	READY BENJAMIN L.
123	B10	(19)	REINHART JOHN
106	B10	(19)	REINHART THEODORE
141	B 3	(19)	ROLLER GEO. N.
141	B 7	(19)	ROLLER JOHN M
141	B13	(19)	ROLLER EPHRIAM B.
123	B 2	(19)	ROSE GEO. W.
	770	(19)	ROUSE JAS. LC.
106	B15	(19)	RUNYAN JOHN
A	96	(19)	REDMOND THOS. J.
	966	(25)	SCHAFER JNO.
410	B 2	(19)	SCHAEFER WM.
284	B22	(19)	SCHMIDT CHAS.
279	B 8	(19)	SCHOENEBERGER PHILIP
183	B 6	(19)	SCHORLE JOHN
39	B 1	(19)	SKINNER JAS.
328	B 4	(19)	SLACK GEO. WM.
287	B 1	(19)	SMITH JOHN S.
	736	(19)	STANNA MENT
199	B 9	(19)	STRASSER KILLIAN W.
303	B 1	(19)	STEELE WM. H
	288	(19)	STULZ HERMANN
173	B 4	(19)	STUROW LOUIS
429	B 2	(19)	SULLIVAN JOHN
79	B 1	(19)	SWIFT CHAS.
	331	(19)	SEEGER FRANK
24	B 2	(19)	SAVAGE JOS. A.
211	B16	(19)	SRY RAND.
149	B 4	(19)	STRASSEL JOHN
	780	(19)	STATEN ENOCH E.
68	B 9	(19)	TAYLOR W. N.
415	B 5	(19)	THOMPSON JOHN
55	B 3	(19)	THOMPSON JAS. A.
	87	(19)	TOTTON GEO. W.
21	B 6	(19)	TUCKER JOHNSON M.
	78	(19)	TAYLOR ALEX M.
	799	(19)	TOTTEN AARON J.
	520	(19)	VOEGELI GEO.
408	B 2	(25)	VAN PELT EDW. R.
297	B 5	(19)	VOLHARDT GEO.
14	B-10	(31)	VON KAENEL FLORIAN O.
145	B11	(19)	WALKER WM.
100	B 2	(19)	WALKER WM.
7	B16	(19)	WEBER GEO.
6	B13	(19)	WEBER MARTIN
22	B 9	(19)	WELLS SAM'L.
196	B 7	(31)	WESCHKE LEO
137	B 1	(19)	WEST JAS.
120	B 6	(31)	WHEELER ELBERT
120	B 3	(19)	WHEELER ROBERT H.H.
512	B 1	(19)	WILLIAMS JESSE F.
244	B 3	(19)	WISE JAS. S.
244	B12	(19)	WISE WM.
445	B 2	(19)	WOODRUFF DAV. T.
110	B 7	(19)	WOOLEY RICHARD
8	B 6	(19)	WEBBER WM.
7	B 15	(25)	WESSLING GEO. W.
8	B 20	(19)	WRIGHT CHAS. O.
702		(19)	ZIMMERMAN LOUIS

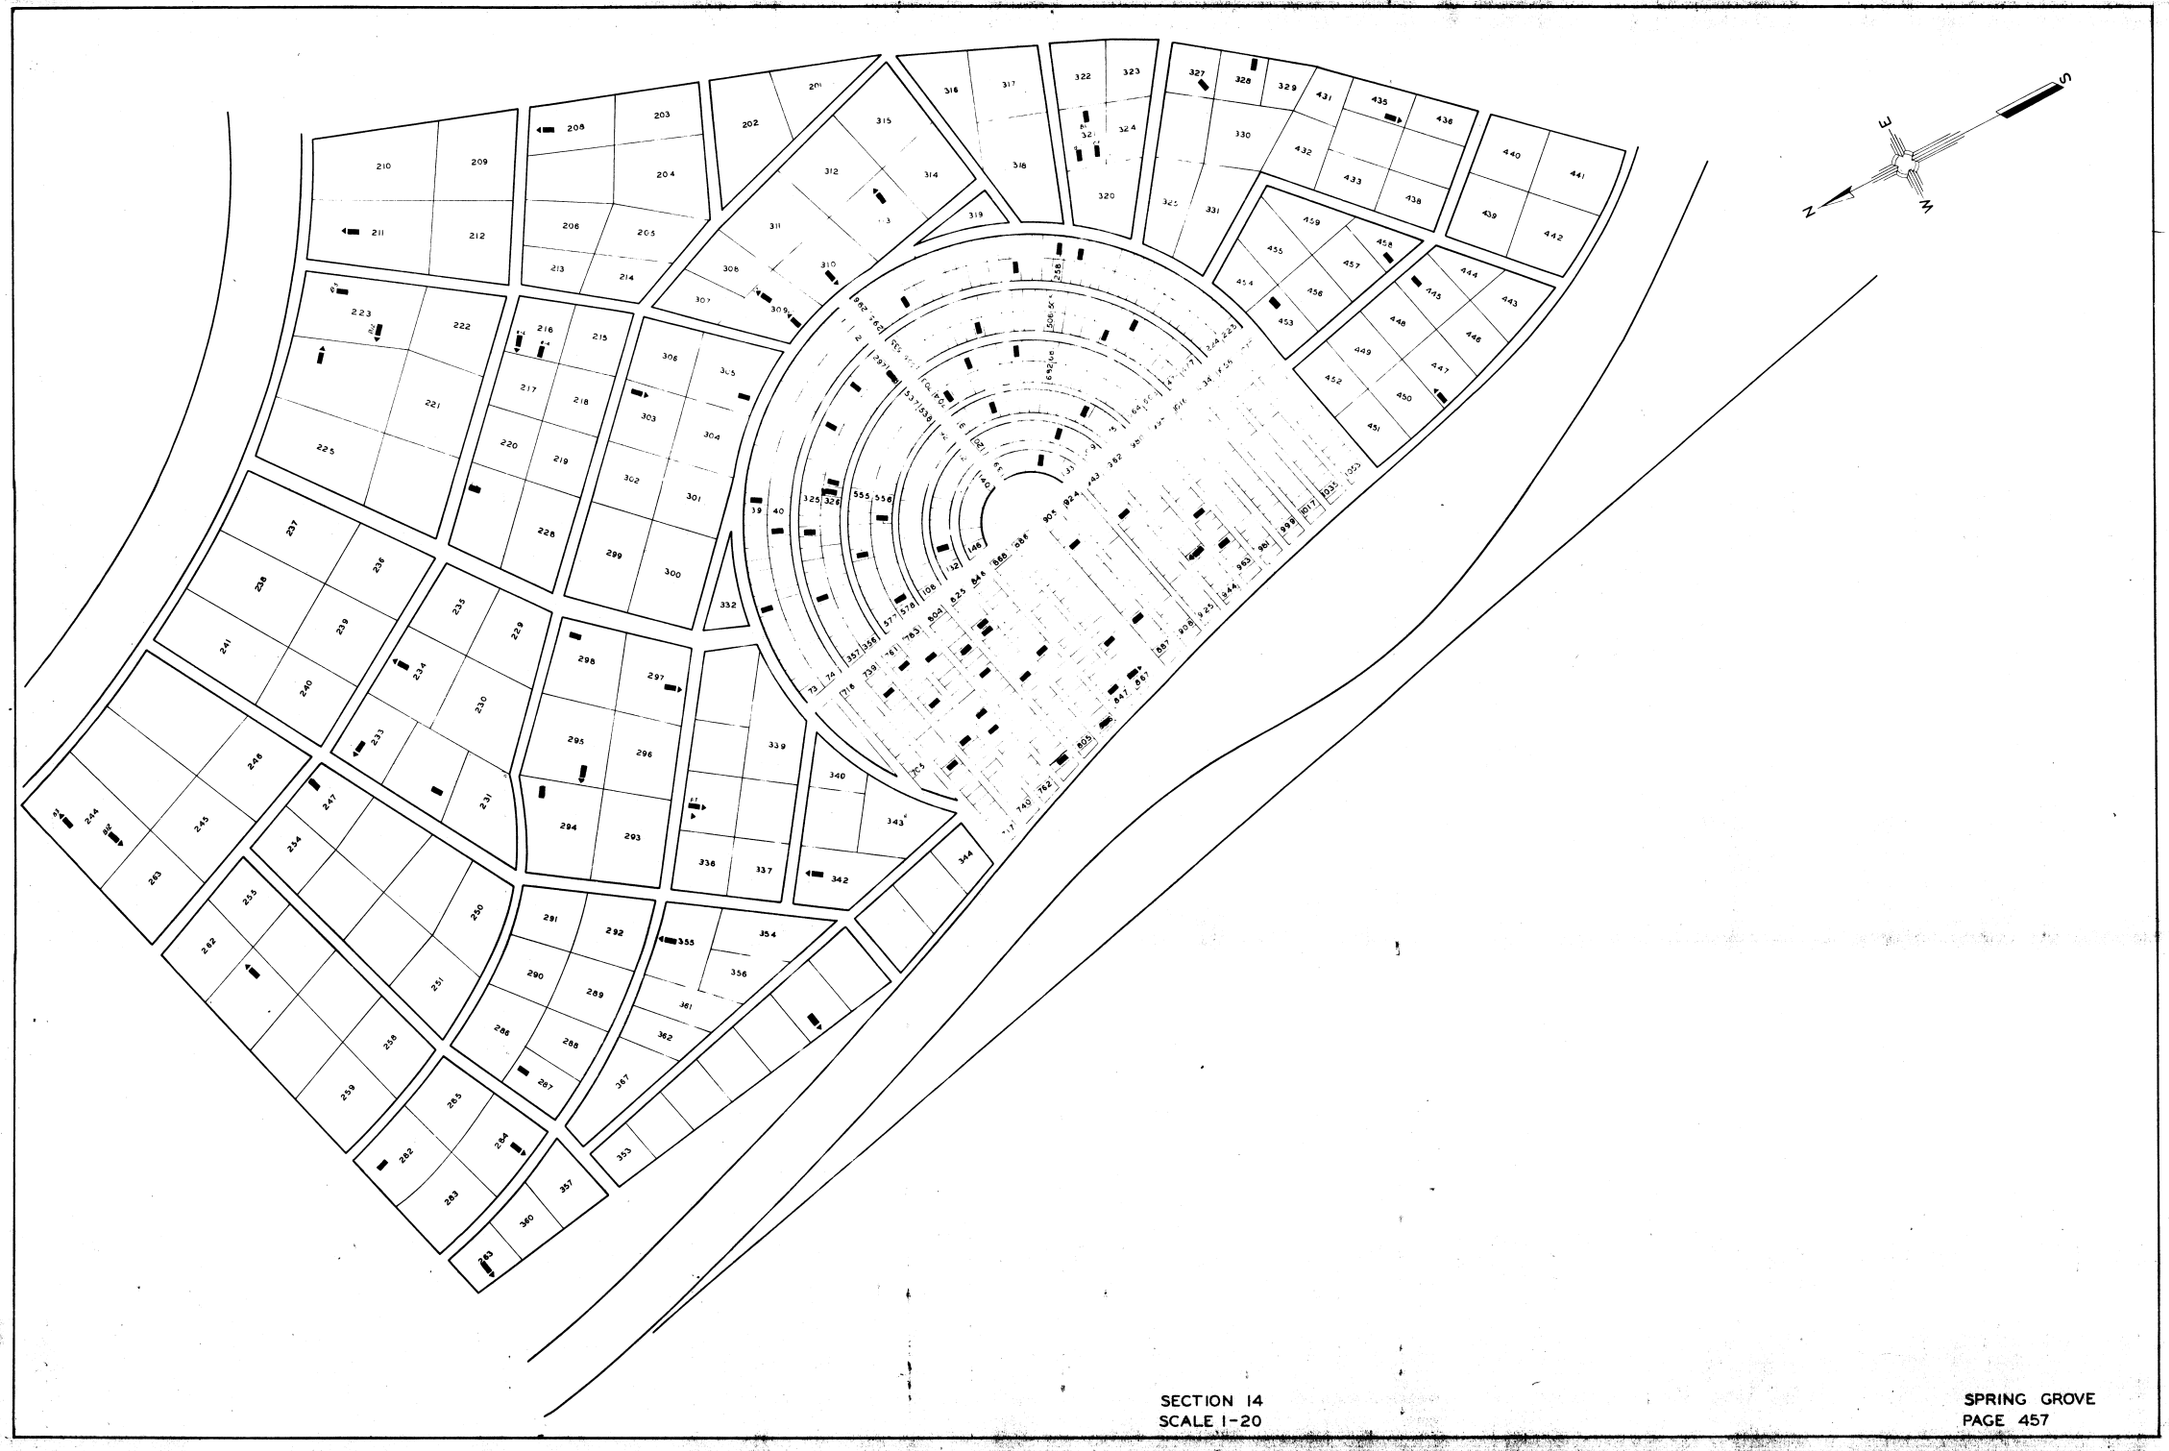

SECTION 14
SCALE 1-20

SPRING GROVE
PAGE 457

SECTION 15

LOT	GRAVE	WAR	NAME
48	B-1	19	BAILEY JOS. B.
49	B-24	19	BARRATT WM.
12	B-3	31	BAUER ALB. A.
	327	19	BIRGLER JOHN
	183	19	BOAKE WM.
	193	19	BOHRER HENRY
	129	19	BUEHREN HENRY
2	43	19	BOOBY HENRY
2	B-45	19	CAMPBELL ROBT.
	208	19	CHERRINGTON JAS. W.
6	5	19	DECKER JOHN
24	5	19	DUFFIELD JOSIAH
4	B-13	19	FOX JAS.
26	B-32	19	FAGIN JOS.
44	B-33	19	FEENEY WM. H.
44	B-40	19	FISHER ROLANDERS E.
	195	19	HALLAM CHAS. G.
	191	19	HARRIS JOHN
49	B-4	19	HAUSER DAN.
41	B-1	19	HILL GEO.
48	B-3	19	HUNGER THEO.
20	B-52	19	HUTT CHRISTIAN
48	B-22	19	HUNT JOHN V.
1	B-77	19	JENKINS WM.
21	B-10	19	KOCH BALTHASAR
29	B-4	19	KOLBE JOHN
27	B-1	19	KOLBE JOS. H.
	124	19	KUHN PETER
25	B-8	19	LEONARD JOHN W.
	171	19	LEININGER GEO J.
20	B-41	19	LONG ORLANDO
	132	25	MACCREADY JOHN H.
5	6	19	McDONALD SAM.
6	2	19	McMILLAN ALEX
7	B-2	19	MILLER CHAS. A.
42	B-2	19	NADAND J. W.
25	B-4	19	NICHOLS AUG.
22	B-2	19	OFFENBACHER MICHAEL
19	B-4	19	OUTTER WM.
20	B-64	19	PARR JAS.
16	B-5	19	QUERNER HENRY
	16	19	SCOTT JAS. F.
	295	19	SEYLER CHAS.
	95	31	SHARMAN RALPH E.
	70	19	SHARP OLIVER P.
	57	19	SCHUSTER CHAS.
6	B-1	19	THAYER HENRY N.
18	B-26	19	VINCENT ANDREW J.
23	B-1	19	WILLIAMS WM. H.
	213	25	WINTER GEO.

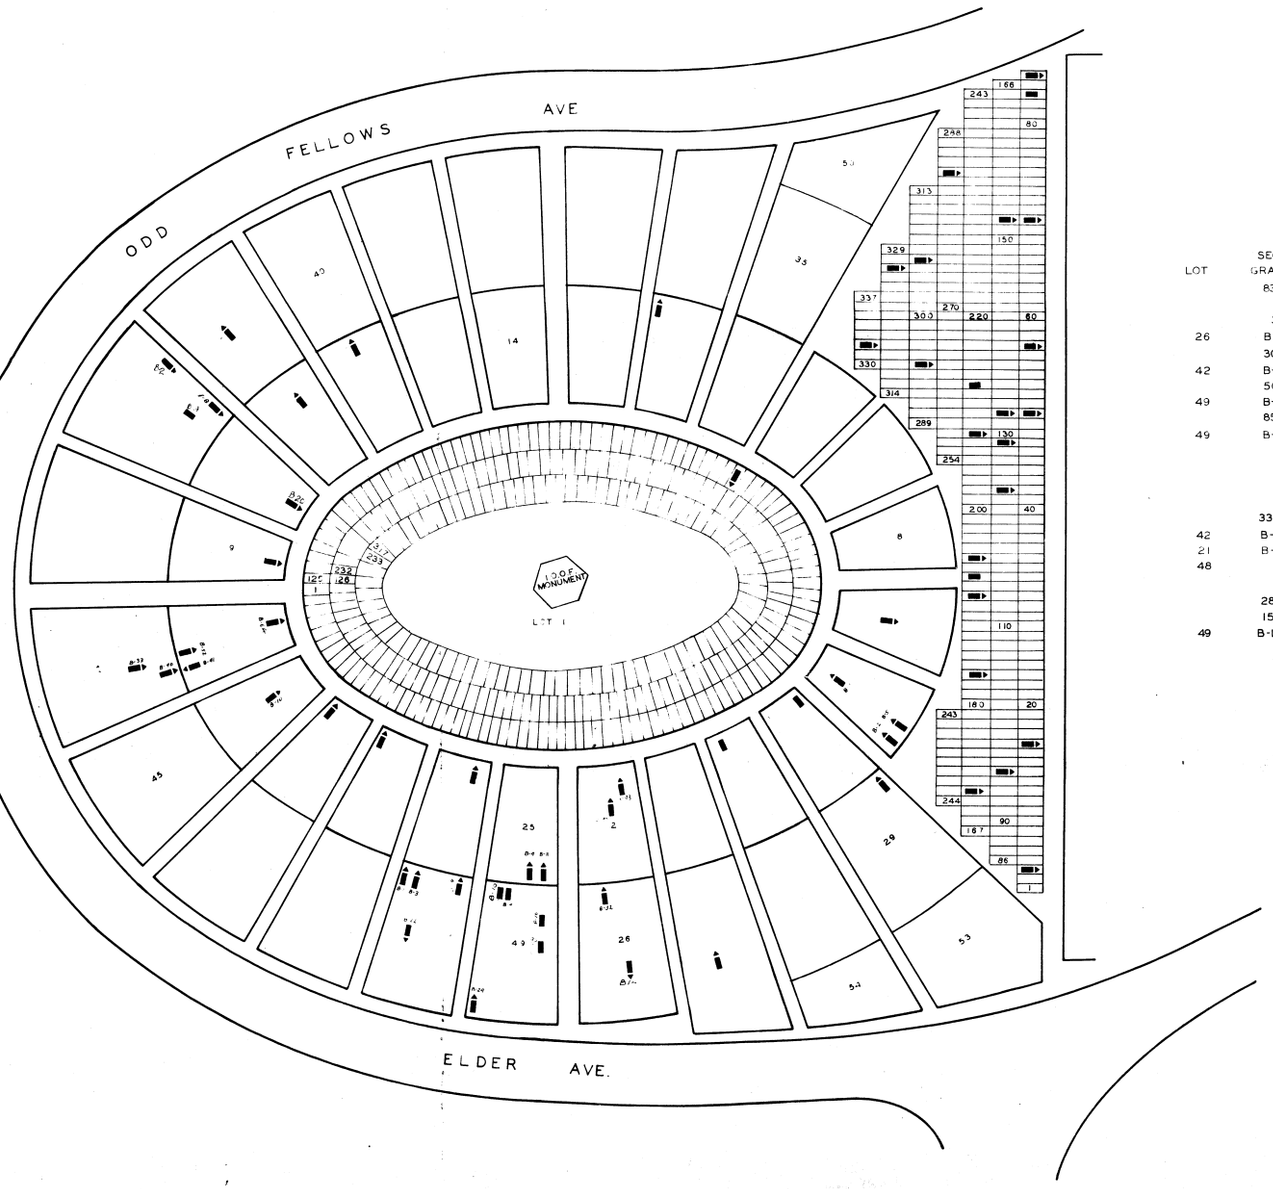

SECTION 15 CONT.

LOT	GRAVE	WAR	NAME
	83	19	DUNCAN JOHN H.
	3	19	GOEHRINGER JACOB
26	B-14	16	HALL EDWIN R.
	306	25	HUGO CONRAD
42	B-1	16	HUGHES CHAS.
	50	19	RICHTER CHAS. W.
49	B-10	19	SWEET CHAS.
	85	19	VANCE JAS. M.
49	B-18	16	WILSON ANDREW
	332	33	HARTMAN ROBT. J.
42	B-19	19	HARVEY JOHN
21	B-17	16 19	HOFFMANN PET.
48	9	19	WALL WM. E.
	284	33	CURTIS CHAS. H.
	152	25	GRAY FLETCHER B.
49	B-16	19	STRUMP WESLEY

SECTION 15
SCALE 1"-20'

SPRING GROVE
PAGE 458

SECTION 16

LOT	GRAVE	WAR	NAME
224	B-11	19	ANDERSON GEO. W.
216	B-11	19	ARLETH ERNST
36	B-1	19	BARRY THOMS.
26	B-3	19	BEARD THEO. A
156	B-4	19	BERTLING PH.
246	B-12	19	BINGHAM THOMS.
246	B-1	19	BINGHAM WM.
179	B-16	19	BOWMAN JOHN L.
280	B-7	19	BROWN CHAS. E.
260	B-2	19	BROWN LEW. G.
285	B-9	19	BROMWELL ANDREW J.
182	B-3	19	BRUNER MARTIN
193	B-3	19	BUCHTMAN LEW.
252	B-5	19	BUSS JACOB
43	B-8	19	CARSON GEO.
	123	19	COLLINS JOHN
32	B-9	19	COOPER SAM.
262	B-7	19	COULTER JOHN
215	B-3	19	COVERDALE JOHN F.
264	B-3	19	DATER GEO
140	B-3	19	DAVIS WM. H.
270	B-15	31	DIEMER OTTO
149	B-7	33	DOAN CLIFF. H.
149	B-8	19	DOAN JAS. B.
242	B-6	19	EBERLE MARTIN
180	B-1	19	EDWARDS JOHN
206	B-17	19	EFFINGER JACOB
177	B-8	19	EMERSON HENRY B.
152	B-4	19	EVANS EDW.
15	B-2	19	EVANS EDW.
15	B-4	19	EVANS THOM.
156	B-3	19	EYSER DANL.
130	B-7	19	FAY WM. E.
186	B-1	19	FINK JAS.
17	B-11	19	GAULT WM. P.
148	B-4	19	HAAS JOHN
268	B-12	19	HAFNER JOHN
310	B-4	19	HARMEYER HENRY
	50	19	HILL JACOB.
96	B-1	19	HOPKINS EDM. S.
125	B-4	19	HORTON HARRY K.
63	B-12	19	JACKSON ANDREW.
107	B-6	19	JOHNSON JAS. F.
220	B-8	19	JOHNSON WM.
200	B-4	19	KECK GUSTAN
200	B-2	19	KECK OTTO
11	B-5	19	KELSEY JAS.
71	B-5	19	KIRK JOHN
196	B-5	19	KIRK WM.
134	B-11	31	KNIGHT HARRY W.
134	B-1	19	KNIGHT RICH.
199	B-6	19	KRUM JOS.
194	B-6	19	KUHN CHRISAN H.
173	B-13	19	KUHN WM. E.
287	B-1	19	KYLE WM. H.
269	B-1	19	LAPP JOHN
217	B-6	19	LOWRY HENRY W.
13	B-4	31	LUPTON HAROLD M.
188	B-3	19	MARTIN CHAS. C.
233	B-5	19	MARTIN JAS.
255	B-7	19	MATSON JOHN
86	B-9	19	METZ GEO.
181	B-2	19	MILLER THEO.
69	B-3	19	MILLER S.J. FERGUS MD.
202	B-3	19	MONTAGNIER FRANCIS G.
202	B-1	19	MONTAGNIER THEO.
	88	19	MURPHY PAT
158	B-5	19	PARRY JOHN
211	B-8	19	PFANKUCHUER GEO.
126	B-15	19	RANDALL THOM.
137	B-11	19	REYNOLDS WM.
81	B-5	19	RUSSELL CHAS. B.
77	B-6	19	SEIBERT PHIL.
	106	19	SHERRON DANL.
210	B-7	19	SHORT JOHN
128	B-7	19	SINCLAIR WM. B.
109	B-1	19	SKINNER SAML. A
21	B-7	19	SPILLARD MORRIS H
17	B-16	19	STANSBURY WM.
84	B-9	19	STEVENS EDWIN
168	B-1	19	STILLWELL JAS.
90	B-4	19	STOKES FREEMAN
90	B-8	19	STOKES ISSAC
90	B-3	19	STOKES JOHN S.
105	B-5	19	WILLIS JAS. H.



SECTION 16
SCALE 1"-20'

SECTION 16

LOT	GRAVE	WAR	NAME
63	B-2	19	DUNLAP JOHN
80	B-5	19	SALZMAN FRANK
100	B-10	19	SCHMIDT JOHN
66	B-4	19	SMITH JAMES S.
34	B-3	19	SPENCE JAMES
30	B-3	19	TAYLOR JOHN
89	B-16	19	WITHENBURY CHAS. W.
89	B-14	19	WITHENBURY THOM. W.
38	B-4	19	WOELFER CHAS.
131	B-10	19	YOUNG ALEX.
140	B-11	19	BEALL WM. H.
139	B-8	19	BICKELL GEO. P.
122	B-5	19	BLUM FRED'R.
	98	19	BRENNER JOHN
42	B-4	19	BROADWELL WM. H.
180	B-5	19	BROOKS REUBEN B.
215	B-8	19	COVERDALE ROB'T. T.
1	B-17	33	DEHAVEN DAVID.
218	B-8	19	DE LONG ALF.
141	B-10	19	EMERSON LOWE
177	B-2	19	EMERSON WM.
15	B-10	19	EVANS JAS.
25	B-4	19	FELIX JOHN
133	B-19	19	HARCOURT THOM. J.
131	B-12	19	HARVEY JAS.
163	B-4	19	JE'TNER PET.
254	B-13	31	LEIBOLT JOS. L.
181	B-15	19	LINDSY FRANK
142	B-4	19	MAYBERRY SAM. V.
86	B-1	19	METZ HENRY
40	B-7	19	OBERLY VIC.
44	B-8	19	PONDER GEO.
	104	19	SANTMYER JOS. P.
212	B-12	19	SCHOEPFLIN WM.
89	B-2	19	SWAIN GEO. S.
114	B-2	19	WHELAN MARTIN
17	B-7	19	WINANS ISAAC C.
274	B-2	19	WITTE CHAS.
243	B-10	19	ZUMSTEIN GEO.
243	B-11	33	ZUMSTEIN GEO. L.
193	B-16	33	BECK ANDREW J.
199	B-11	19	KRUM HENRY

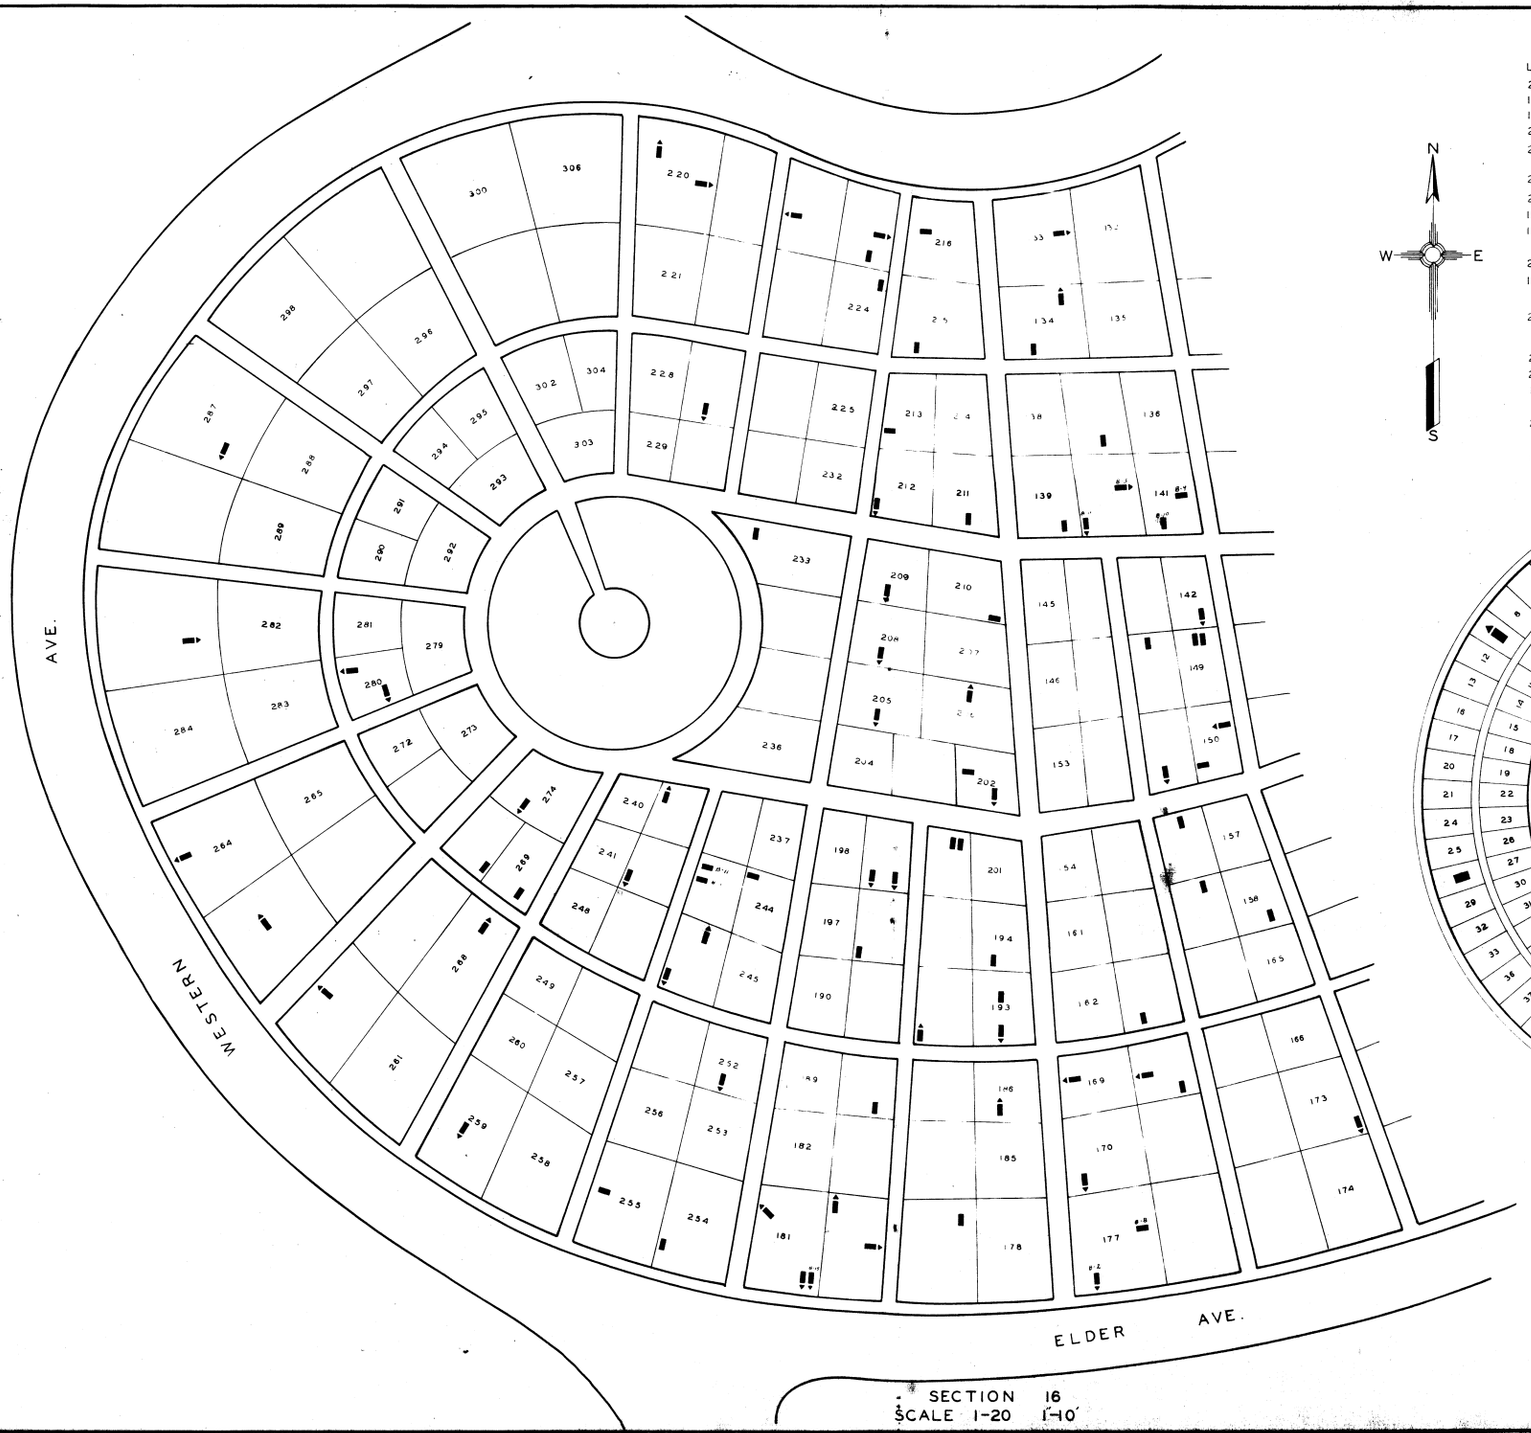

SECTION 16 CONT.

LOT	GRAVE	WAR	NAME
205	B-6	(16)	CLARK JOHN
141	B-9	(29)	EMERSON LOWE K.
168	B-15	(19)	KUNTZ GEO.
209	B-9	(19)	MEREDITH WM.
227	B-7	(19)	SPAETH JOHN G.
	9	(19)	SPRINGMEYER WM.
220	B-6	(19)	SWIFT THEO.
263	B-4	(19)	THOMPSON EDWIN L.
150	B-1	(19)	TODD JAS.
150	B-6	(19)	TODD SAM.
	164	(19)	WENZ JACOB
244	B-12	(19)	WILLIAMS HENRY L.
170	B-11	(19)	WOODRUFF CHAS.
	B-28	(19)	BEINHARD DAV.
259	B-5	(19)	BOCHNING WM. H.
208	B-14	(19)	ALLEN HAM
239	B-6	(19)	BUSH LOUIS W.
128	B-26	(33)	RANDALL CHAS.
29	B-6	(19)	WIELERT H.
213	B-10	(19)	TANGHERT CHAS.
192	B-1	(19)	HARMONY JOS. H.

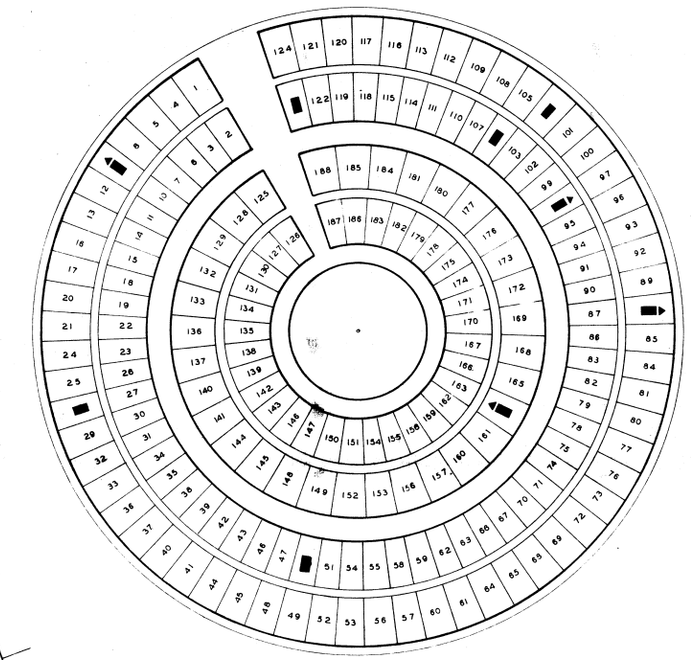

SECTION 16
SCALE 1-20 1"=40'

SPRING GROVE
PAGE 460



SECTION 17
SCALE 1"-20'

SPRING GROVE
PAGE 461

LOT	GRAVE	WAR	NAME
46	B 13	(19)	ANDERSON ALONZO W.
168	B 5	(19)	ARMSTRONG JOHN M.
		(19)	
110	B 14	(16)	BAILEY JAS.
91	B 7	(19)	BALDWIN WM. H.
16	B 23	(19)	BARR JOHN
221	B 5	(19)	BINDLEY JAS.
122	B 7	(19)	BRAEDLER WENDELIN
64	B 9	(19)	BROGAN JAS.
64	B 4	(19)	BROGAN SAM. H.
34	B 1	(16)	BROWN JOS.
194	B 3	(19)	BURLEY CHAS.
194	B 1	(19)	BURLEY ROBT.
205	B-17	(19)	BORGMAN BERNARD B.
76	B-14	(19)	BOYD CHAS. W.
158	B- 2	(19)	BRIDGEMAN A. H.
140	B-12	(19)	BRITENBACK BENJ.
-	749	(33)	BISHOP, J.W.
171	B-4	(19)	CARLIN JOS. P.
4	B-5	(19)	CHASE ISAAC L.
104	B- 8	(19)	CLEMMER CHAS.
104	B 1	(19)	CLEMMER EDG. K.
164	B 13	(19)	COATES JAS. P.
108	B 9	(19)	CROSS WILSON
6	B 13	(31)	CURLEY THOM. B.
133	B 5	(19)	CURTIS ALONZO
121	B- 5	(19)	CARRUTH AND'R. S.
215	B 2	(19)	DEITZ FRANK
100	B 1	(19)	DICKS WM. W.
52	B 5	(19)	DOBSON JAS.
195	B 17	(31)	DRYDEN JOHN H.
138	B-14	(19)	EBERLING JOHN
59	B 3	(19)	ENGEL JOHN
217	B 17	(19)	FARLING CHRIS.
46	B 2	(16)	FRAZER HIRAM
58	B- 4	(19)	GARRETSON GEO. C.
107	B-10	(19)	GESSERT JAC.
225	B 7	(19)	HARBESON BENJ.
181	B 4	(16)	HARRIS WM. B.
183	B 13	(31)	HEIS ROMAN J.
68	B 4	(19)	HENRY JAS.
225	B 8	(19)	HITCH FRANCIS A.
149	B 10	(19)	HOFFMAN CHAS.
149	B 24	(19)	HOFFMANN JOS.
90	B 4	(19)	HOFFMAN LOUIS
39	B 7	(20)	HOPPER ALB.
199	B 17	(19)	HUBER JAC.
87	B 7	(19)	HUSSEY LUTELLUS
65	B 10	(19)	HECKERT FRED'R.
57	B 8	(19)	HOPPER GEO.

LOT	GRAVE	WAR	NAME
172	B 8	(19)	ISHAM CHAS. C.
80	B 3	(19)	JONES HENRY
14	B 28	(19)	KAUFFMANN V.C.
14	B 9	(19)	KUFFMAN HENRY
150	B 9	(19)	KOEHLER HENR
136	B 4	(19)	KORTE ALF.
136	B 3	(19)	KORTE HENRY
135	B 7	(19)	KREBS FREDR.
138	B 18	(33)	KUHN LOUIS O.
27	12	(19)	LEGNER JOHN
143	B 7	(19)	LEWIS ROBT. K.
		(19)	
196	B 8	(19)	MARQUA JAC.
63	B 3	(19)	MARTIN DANL.
157	B 1	(19)	MARTIN ROBT.
147	B 2	(19)	MIDDLETON GEO. A.
78	B 5	(19)	MOORE ALB.
206	B 12	(19)	MORIN SAM
222	B 10	(19)	MURPHY CHAS.
67	B 4	(19)	MITCHEL JOHN B.
227	B 2	(19)	NOYES EDW. F.
143	B 12	(19)	OLIVER BURRIS W.
204	B 23	(19)	OTTE WM. C.
80	B 2	(19)	PAYNE JOHN R.
189	B 6	(19)	POORMAN SAML. F.
68	B 6	(19)	PINNEY MARTIN

LOT	GRAVE	WAR	NAME
26	B 6	(19)	RALSTON ROBT. B.
35	B 4	(19)	RAVIE ALEX.
63	B 2	(19)	ROBINSON JAS. S.
89	B 5	(19)	ROEBLING HENRY C. P.
2-	B 11	(19)	REIF FRANK
31	B 11	(19)	ROSE JOHN O.
16	B 17	(19)	SCHATZMAN JAC.
105	B 5	(19)	SCOBEY TIM. E.
69	B 9	(19)	SEARLS J. W. H.
182	B 3	(19)	SKINNER CHAS. H.
153	B 9	(31)	STANLEY HORTON C.
153	B 6	(19)	STANLEY JOHN
163	B 8	(19)	STEGNER LOUIS
106	B 15	(19)	STORY ADAM
166	B 2	(19)	TATEM HARRY H.
17	B 4	(19)	TAXIS OTTO
224	B 8	(19)	TROUT WM. S.
70	B 2	(19)	TITTLE CHRIS. C. H.
216	B 7	(19)	VAN CLEVE ELIJAH
215	B 11	(33)	VETTER NICH. J.
25	B 6	(19)	WEBER DANL.
167	B 10	(19)	WILLIAMS WM.
143	B 3	(19)	WILKINSON ROBT.
212	B 1	(19)	WOCHER LOUIS
217	B 22	(19)	ZIMMERMAN FREDR.



MAUSOLEUM LOT 12

CATACOMB LOT 32

SECTION 13

LOT	GRAVE	WAR	NAME
2	B-7	(19)	ANDREWS WM. J.
8	B-5	(19)	DUHME J. J.
1	B-8	(19)	HILL FRANKLIN M.
1	B-16	(19)	HILL JOS.

SECTION 18

LOT	GRAVE	WAR	NAME
17	B-7	(25)	CUTTER ALPHEUS JR.
32	CATACOMB 10	(16)	• HALL JOS.
9	B-10	(19)	WAYNE JACOB L.
31	B-4	(19)	CUNNINGHAM BRIGGS S.
30	B-9	(19)	DOEPKE WM. F.
68	B-3	(31)	• GATES JOHN JR.
19	B-12	(19)	GLENN OMER T.
23-A	B-5	(31)	HOWARD HOWELL H.
22-B	B-2	(19)	JONES FRANK J.
25	B-1	(19)	LUTHY RICH.
20	B-8	(19)	MORRIS JOS.
57	B-1	(19)	MUHLHAUSER HENRY.
5	B-9	(19)	NEFF JAS. M. W.
47	B-1	(31)	NIPPERT JAS. G.
12	7	(19)	PALMER THOM.
45	B-2	(31)	ROWE EUG. F
25	B-9	(19)	BAENINGER CHAS.
43	B-2	(19)	HAFFNER CHRISTIAN
22	B-3	(19)	HEWETT HERB'T. M
3	B-6	(19)	HINKLE FRANCIS
25	B-14	(19)	ALLEN PAT.
49	B-1	(19)	TULLIDGE F. G.
62	B-1	(31)	MEACHAM ROBT. D

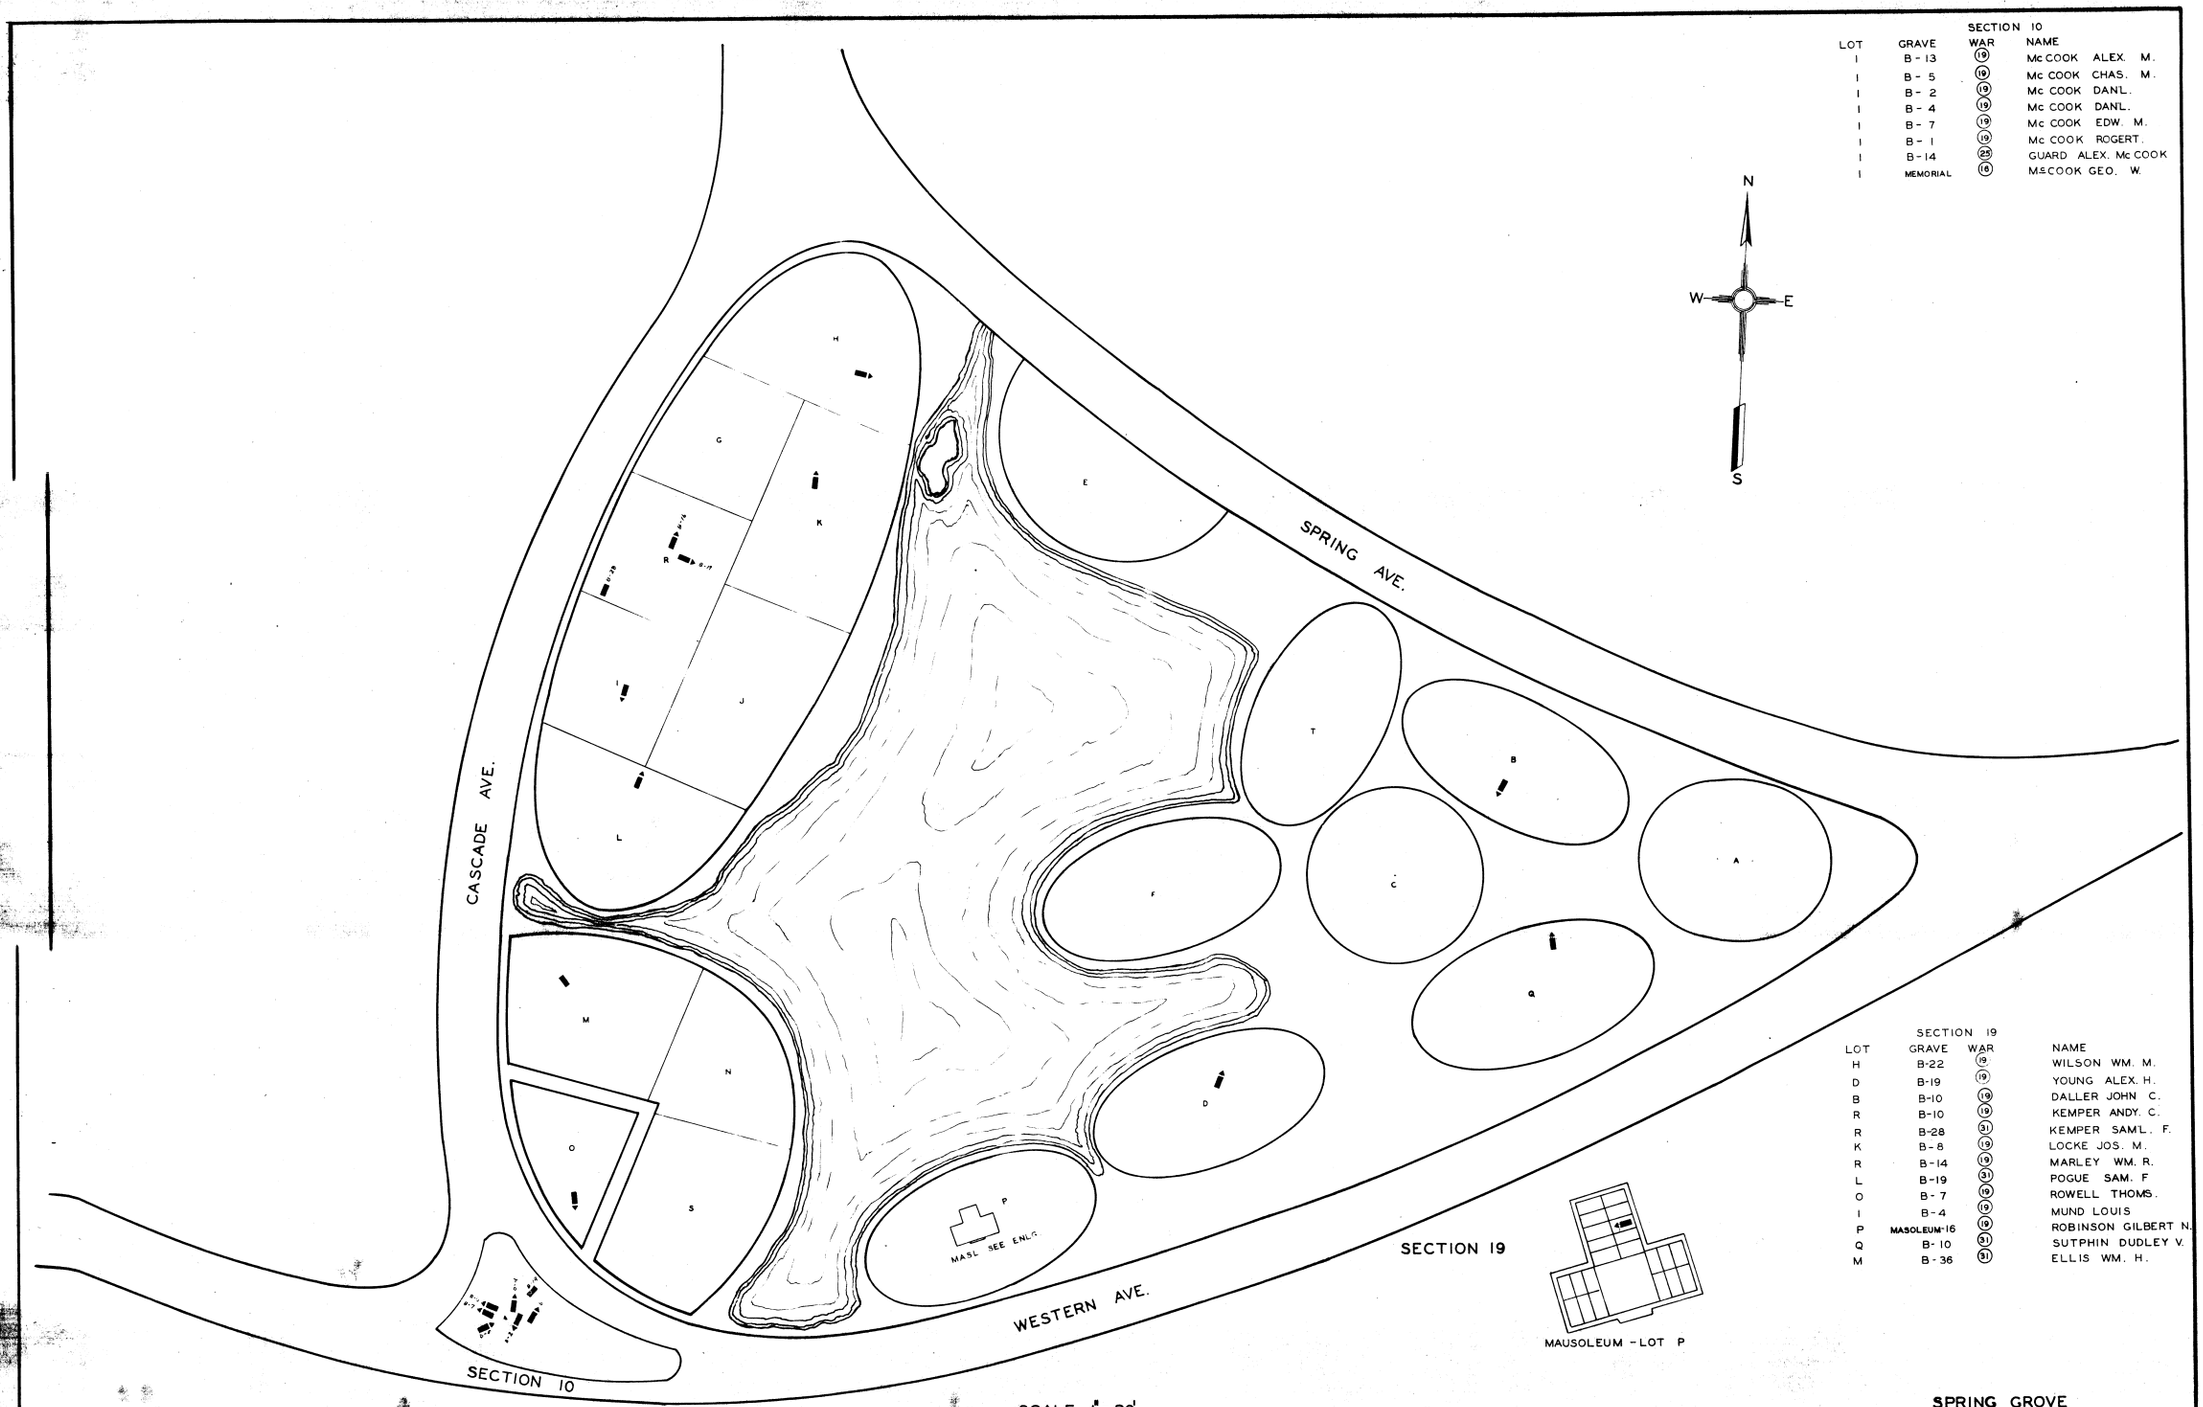

SECTION 10

LOT	GRAVE	WAR	NAME
I	B-13	(19)	McCOOK ALEX. M.
I	B-5	(19)	McCOOK CHAS. M.
I	B-2	(19)	McCOOK DANL.
I	B-4	(19)	McCOOK DANL.
I	B-7	(19)	McCOOK EDW. M.
I	B-1	(19)	McCOOK ROGERT.
I	B-14	(25)	GUARD ALEX. McCOOK
I	MEMORIAL	(16)	McCOOK GEO. W.

SECTION 19

LOT	GRAVE	WAR	NAME
H	B-22	(19)	WILSON WM. M.
D	B-19	(19)	YOUNG ALEX. H.
B	B-10	(19)	DALLER JOHN C.
R	B-10	(19)	KEMPER ANDY. C.
R	B-28	(31)	KEMPER SAM'L. F.
K	B-8	(19)	LOCKE JOS. M.
R	B-14	(19)	MARLEY WM. R.
L	B-19	(31)	POGUE SAM. F
O	B-7	(19)	ROWELL THOMS.
I	B-4	(19)	MUND LOUIS
P	MASOLEUM-16	(19)	ROBINSON GILBERT N.
Q	B-10	(31)	SUTPHIN DUDLEY V.
M	B-36	(31)	ELLIS WM. H.

SPRING GROVE
PAGE 464

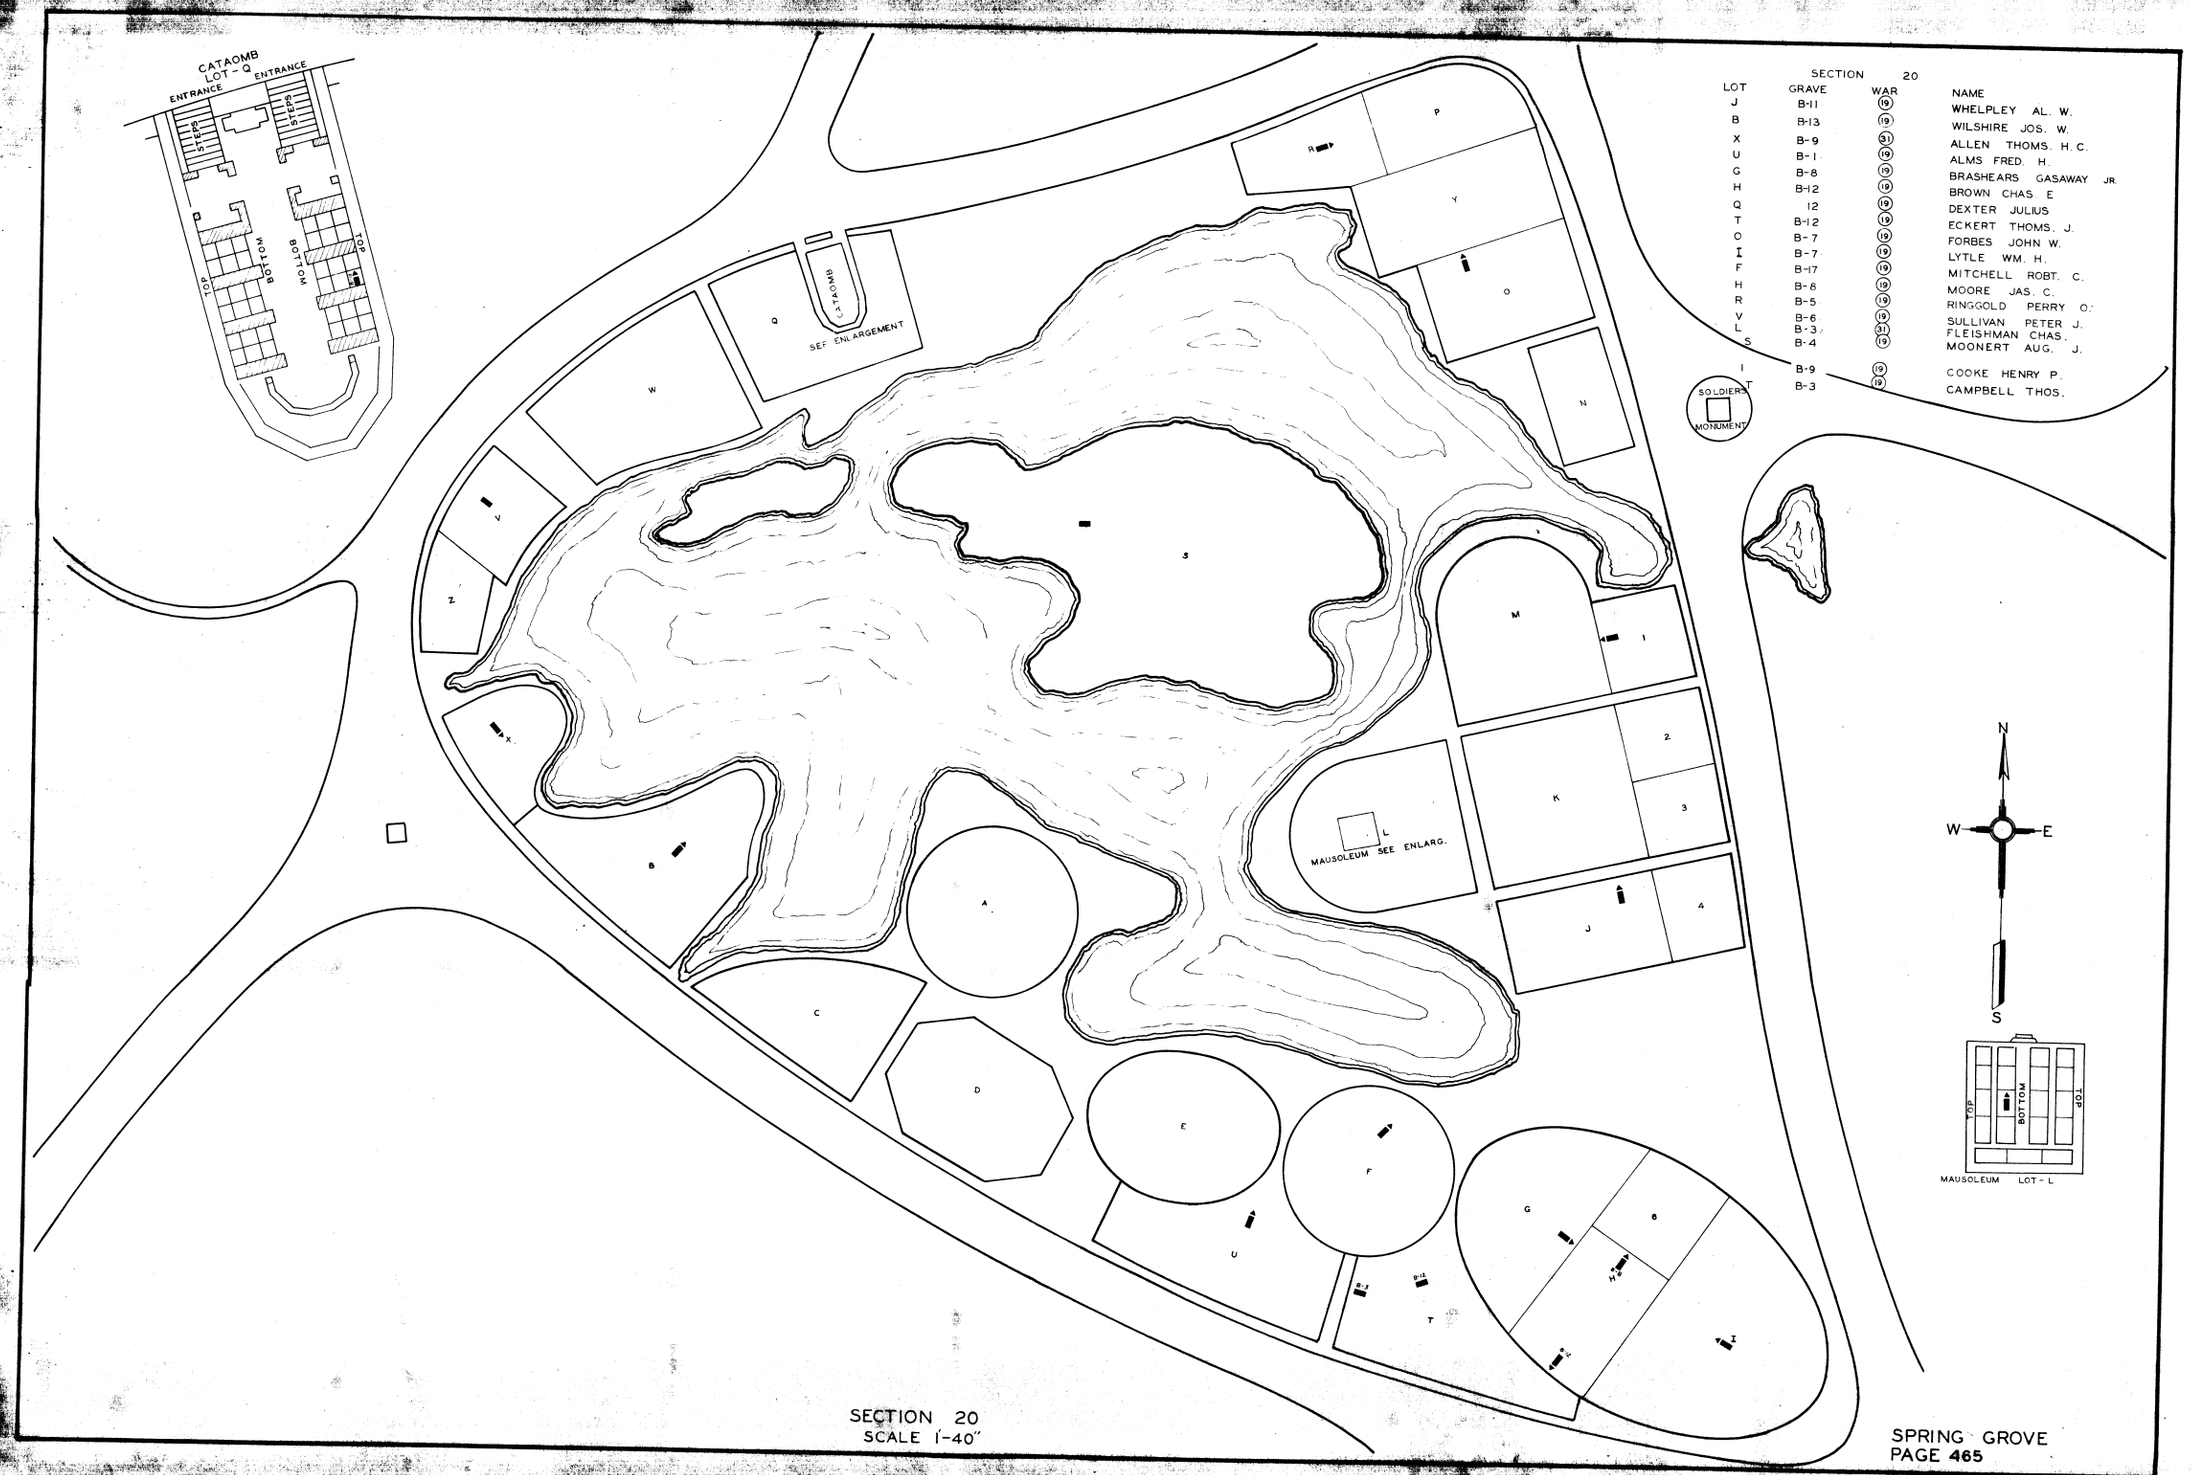

SECTION 20

LOT	GRAVE	WAR	NAME
J	B-11	(19)	WHELPLEY AL. W.
B	B-13	(19)	WILSHIRE JOS. W.
X	B-9	(31)	ALLEN THOMS. H. C.
U	B-1	(19)	ALMS FRED. H.
G	B-8	(19)	BRASHEARS GASAWAY JR
H	B-12	(19)	BROWN CHAS. E
Q	12	(19)	DEXTER JULIUS
T	B-12	(19)	ECKERT THOMS. J.
O	B-7	(19)	FORBES JOHN W.
I	B-7	(19)	LYTLE WM. H.
F	B-17	(19)	MITCHELL ROBT. C.
H	B-8	(19)	MOORE JAS. C.
R	B-5	(19)	RINGGOLD PERRY O.
V	B-6	(19)	SULLIVAN PETER J.
L	B-3	(31)	FLEISHMAN CHAS.
S	B-4	(19)	MOONERT AUG. J.
I	B-9	(19)	COOKE HENRY P.
T	B-3	(19)	CAMPBELL THOS.

SECTION 20
SCALE 1-40"

SPRING GROVE
PAGE 465

SECTION 21

LOT	GRAVE	WAR	NAME
M	B-9	31	BATES ETHAN S.
N	B-4	19	FOX GEO.
P	B-3	19	HUBBELL WAKEMAN WM.

SECTION 21 CONT.

LOT	GRAVE	WAR	NAME
M	B-7	19	BATES ISAAC
P	B-5	19	HUBBELL GEO. N.
O	B-9	19	MEGRUE JOS. R.
G	B-9	19	WEEKS STEPHEN H.

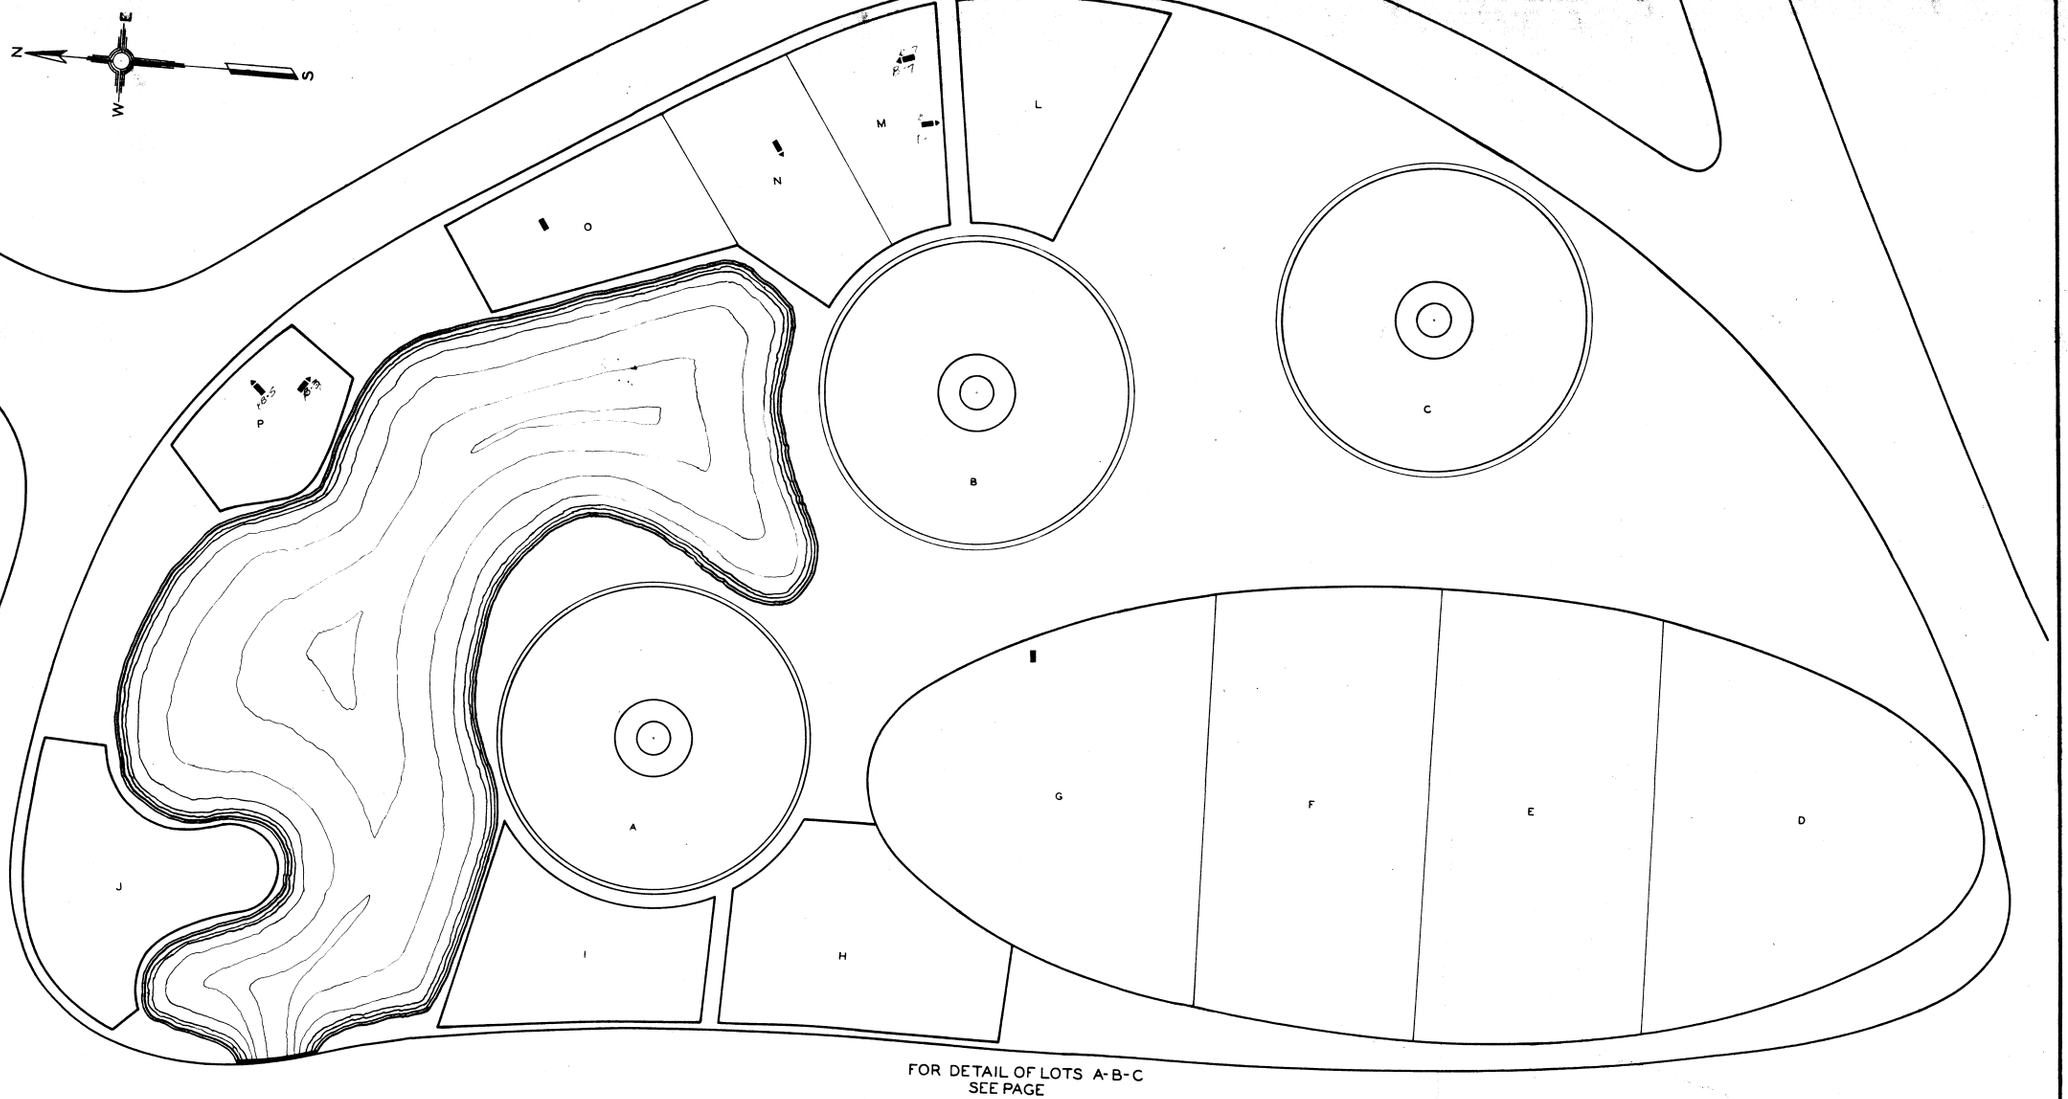

FOR DETAIL OF LOTS A-B-C
SEE PAGE

SECTION-21
SCALE 1" = 20'

SPRING GROVE
PAGE 466

B

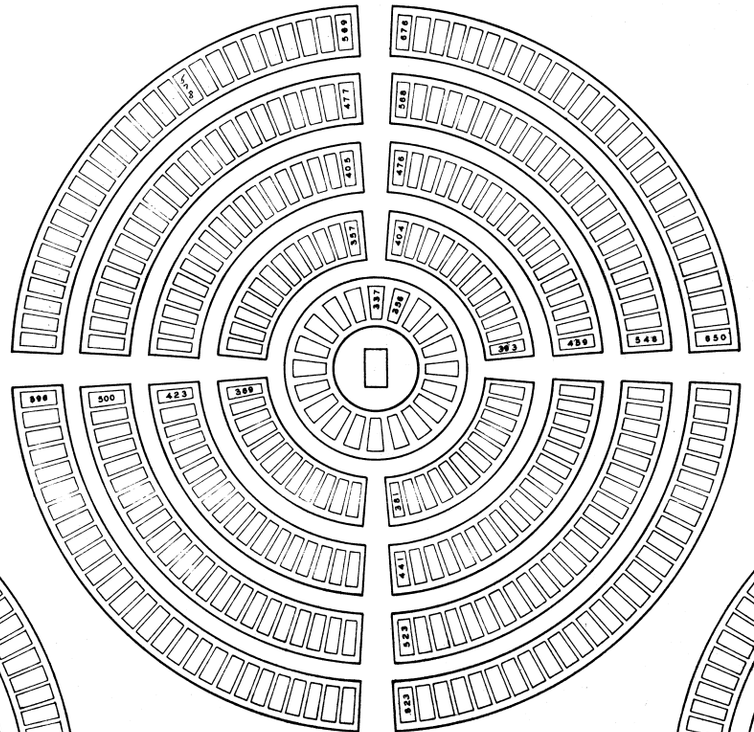

A

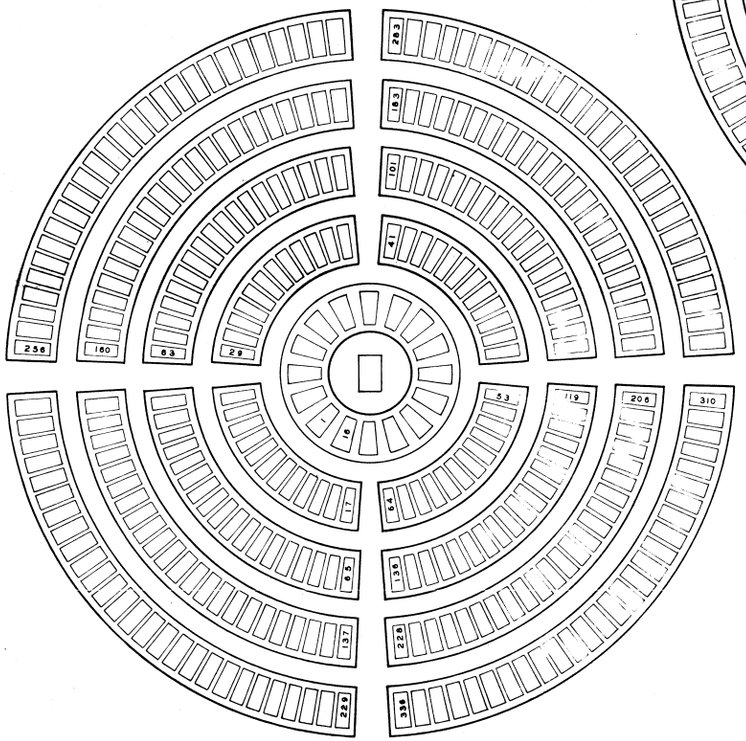

C

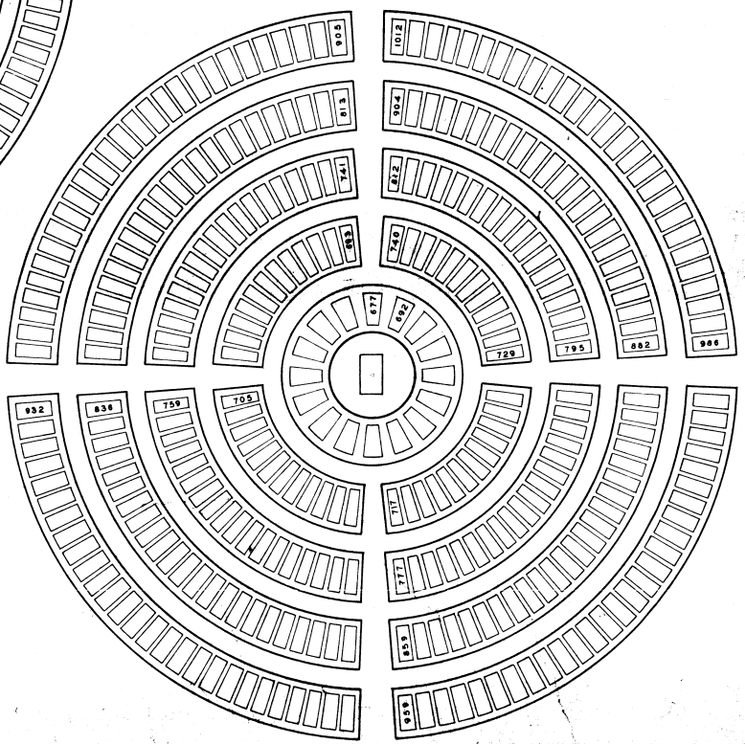

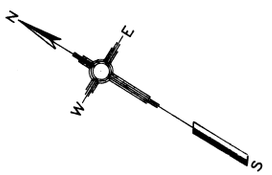

DETAIL OF LOTS A-B-C
SECTION-21
SCALE 1"=10'

A

SECTION	LOT	GRAVE	WAR	NAME
21	C	877	(19)	AANESON SIMON
	A	278		ADAMS MORTIMER
	C	939		ADAMS WM
	C	707		ADAMS WILLIAM
	C	736		AGENS CHRISTOPHER
	C	787		AGER ALFRED T
	A	24		AIKER NICHOLAS
	C	753		AKINS ALEXANDER
	A	195		ALDE ADOLPHE
	A	151		ALEXANDER CHRISTOPHER
	B	670		ALLEN DANIEL W
	A	159		ALLEN JAMES B
	A	104		AMBROSE CHARLES
	C	869		ANDERSON SAMUEL
	C	759		ANDERSON WILLIAM B
	C	777		ANDREWS JAMES P
	A	327		ANDREWS NEWTON
	A	81		AN INDIAN SOLDIER
	A	231		ARMSTRONG THOMPSON
	C	891		ARNST SAMUEL
	A	55		ASHBY DANIEL
	A	232		AUSTIN HORATIO G
	A	288		AUSTIN JAMES
	B	362		AVERY ALONZA
	A	275		AVERY H O
21	A	142	(19)	AXTELL SAMUEL A

B

SECTION	LOT	GRAVE	WAR	NAME
21	A	47	(19)	BABBITT J W
	B	529		BABCOCK KINGSLEY A
	A	196		BACKISTARS WILLIAM
	A	122		BAILEY PHILANDER
	A	333		BAIN ROBERT J
	B	558		BAKER ALMON
	A	76		BAKER DAVID
	A	95		BAKER OSCAR
	B	608		BAKER WILLIARD
	A	188		BALL THOMAS
	A	336		BALSER SAMUEL A
	B	365		BARKER W W
	C	752		BARNES FRANK E
	B	417		BARNES JOHN
	C	937		BARNES JOHN
	A	310		BARNES MICHAEL P
	C	780		BARNETT GEORGE
	A	206		BARNUM NOAH
	C	887		BARRICK JOHN H
	A	37		BARRICK WILLIAM H
	B	401		BARTELL HORACE
	A	35		BASSETT LOREN R
	B	521		BATTY HIRAM
	B	635		BAUGHER CHRISTIAN
	C	966		BAUGHMAN LEVI
	A	117		BAY DAVID
	C	730		BEACH GEORGE W
	C	835		BEALE ANDREW J
	C	834		BEAN COLUMBUS
	C	945		BEARD WM H
	A	14		BEECHER GEORGE
	A	102		BEEDY OTHANIEL
	A	20		BELFARD JOHN
	C	731		BELT G A
	A	9		BENDLE WILLIAM
	B	403		BENNETT HENRY A
	C	952		BENNETT ORIN
	B	637		BENZINGER AUGUST
	C	819		BERRY STEPHEN
	C	820		BEVERSTINE DAVID
	B	547		BICK I
21	A	6	(19)	BIDWELL SOLOMON

B

SECTION	LOT	GRAVE	WAR	NAME
21	A	62	(19)	BIGGS FRANK
	B	511		BIRD GEORGE
	C	862		BIRD JOHN
	A	103		BISHOP JAMES
	B	36		BIXLER GEORGE S
	C	838		BLACK WILLIAM
	B	442		BLACK PETER K
	B	355		BLACKMAN ELISHA M
	A	216		BLACKMAN RANSOM G
	B	501		BLITTON THOMAS
	C	722		BOGART WM D
	A	228		BORTON IRA
	C	920		BOLTON JOSEPH
	C	729		BOTTER GEORGE
	A	10		BOTTIN JOSEPH M
	B	407		BOWEN ABNER
	B	498		BOWMAN ELISHA
	C	677		BOWN WILLIAM H H COL
	B	468		BOYER EDWARD
	B	346		BOYLE EPHRIAM D
	C	766		BRANDON JOHN T
	C	695		BRANNAN JAMES F
	C	960		BRANNAN JOHN
	C	689		BRANNAN PATRICK
	A	46		BRATSTROM G M
	B	444		BREAZEALE W M
	C	821		BREBINGER C N
	A	308		BREEN HUGH
	C	804		BREWER CHARLES W
	C	983		BREWER EDMUND
	C	1000		BRIDGEHOUSE TIMOTHY
	B	415		BRIDGEWATER ELISHA
	B	421		BRINER JOHN
	C	711		BRITZ JOS
	B	347		BROCKSMITH WILLIAM H
	C	1005		BROFMAN GEORGE
	A	7		BRONTON JOSEPH
	B	617		BROWN CHARLES M
	C	876		BROWN DAVID C
	B	994		BROWN JAMES
	E	424		BROWN JOHN
	C	878		BROWN J L
	C	908		BROWN SAMUEL G
	B	628		BROWN THOMAS
	A	186		BROYLES WILLIAM
	A	7		BRUCE ROBERT
	B	656		BUCHANAN HARRY
	C	725		BUELER MARVIN H
	A	21		BULLARD WILLIAM N
	A	294		BURGER CHARLES
	A	38		BURKE JOHN
	B	520		BURT HENRY H
	B	582		BUSCHER LOUIS
	B	393		BUSHONG JACOB H
	A	32		BUTCHER JOHN
2	A	184	(19)	BUTLER CHARLES

C

SECTION	LOT	GRAVE	WAR	NAME
21	A	246	(19)	CAHILL JOHN
	B	588		CAHILL THOMAS
	B	672		CALAHILL NICHOLAS
	A	236		CAMPBELL ALEXANDER
	B	583		CAMPBELL DANIEL
	C	963		CAMPBELL DANIEL
	C	808		CAMPBELL JOHN T
	A	233		CAMPBELL WILLIAM
	C	738		CAMBREL JAMES L
	B	516		CAPRON ED P
	B	604		CARBOUGH T M
	C	955		CARMICHAL JOHN
	C	755		CARPENTER JOS
	C	867		CARPENTER WILLARD
	C	864		CARRELL JAMES M
	A	106		CARROLL GEORGE
	C	832		CARTWRIGHT CHARLES E
	C	758		CARUTH ENOCH
	B	491		CASE DAVID
	C	705		CASE GEORGE SARGT
	C	981		CASHDOLLAR LEVI
	C	851		CASKIN NICHOLAS
	B	483		CASTLE CURRAN H
	B	523		CAVANAUGH JOHN
	C	788		CHADBOURN JOHN
	A	53		CHANDLER ISAAC K
	A	198		CHESTER NICHOLAS C
	C	871		CHRISTIAN LORENZO R
	B	476		CHRISTOPERSON OLE
	C	694		CHUCKNIMER PETER
	A	98		CHURCH DANIEL H
	B	545		CLARK GALVIN E
	C	812		CLARKSON WILLIAM
	C	691		CLIFTON DANIEL
	B	430		COCHRAN SIMON
	C	697		COLLINS ALLEN
	B	405		COLLINS JOHN
	B	567		CONKLIN AMSEY
	C	984		CONNER ALEX
	A	243		CONNER PATRICK
	A	54		COOK JOHN
	A	100		COONEY J
	C	977		COPPER RALPH
	B	649		CORBIT MARTIN
	C	973		CORDIAL THOMAS
	C	837		COREY CHARLES H
	C	768		CORNWALL FRANK F
	C	709		COVER PETER
	B	367		COWAN FRANCIS
	A	177		COWDEN DANIEL A
	C	935		COX JAMES
	C	807		COX JOSEPH
	B	647		CRANE JOHN
	C	998		CRANE WILLIAM
	B	406		CRANKITE C M
	C	996		CRAWLEY CHARLES H
	C	911		CRAZEN LEMAN H
	B	655		CRIPPEN JOHN A
	A	164		CUMMINGS GEORGE
	C	918		CUPP SAMUEL S
	B	658		CURRIN SCHUYLER M
21	A	50	(19)	CUTTING CHARLES H

D

SECTION	LOT	GRAVE	WAR	NAME
21	A	16	(19)	DAHAUKE WILLIAM
	A	280		DAILEY PATRICK
	A	22		DALEY JAMES
	B	619		DANBURY AARON
	B	665		DANIELS ALVA H
	A	63		DAVIS CHARLES
	B	667		DAVIS JAMES
	B	397		DAVIS LEWIS A
	B	390		DAWSON NATHAN C
	A	237		DEAL ALONZO
	C	795		DEAN STEWELL G
21	A	279	(19)	DEBILBLISS GEO

D

SECTION	LOT	GRAVE	WAR	NAME
21	B	474	(19)	DECKHAUT FREDERICK
	B	639		DEINLEIN DANKUTZ
	C	983		DELL JOHN
	C	852		DEMPSEY JEREMIAH
	A	68		DE PEY JOHN
	B	443		DETERMAN HARMAN
	C	809		DEWAL EDWARD P
	B	358		DEVOLLE LEWIS
	B	651		DICKSON JOSEPH H
	C	925		DICKSON ROBERT
	B	526		DIGBY WILLIAM
	C	779		DIGGS WM C
	C	743		DILLEY CLINTON
	A	251		DILLEY JONATHAN
	B	477		DIVINE SILAS D
	C	749		DOBIE JAMES C
	B	548		DOLAN BERNARD
	C	904		DONAHUE THOMAS
	B	674		DONALDSON BENJIMAN
	C	916		DOOLITTLE NORMAN
	A	249		DOUGLAS NATHAN
	C	792		DOWNER THOMAS B
	C	818		DOWNING JOSHUA D
	C	951		DOYLE THOMAS
	B	384		DRAPER ONDI
	A	287		DRECKER B J
	B	659		DRITERLIN FREDERICK
	A	221		DUBOIS ABRAM E
	B	644		DUDLEY JOHN
	A	194		DUER THOMAS D
	C	1011		DUERR BERNHARD
	B	533		DUFFEY WILLIAM
	A	135		DUNN AMMON
	B	507		DUNSHEE WM N
	C	997		DURHAM ALLEN C
	C	948		DUSENBERRY MARTIN
	B	395		DUSK JOHN
	B	352		DYE DAVID T
21	C	702	(19)	DYE HENRY

E

SECTION	LOT	GRAVE	WAR	NAME
21	A	133	(19)	EAGLE JOHN
	A	209		EANGLE ALEXANDER
	B	621		EAREHEART SAMUEL M
	B	340		EDELMAN THOMAS
	A	168		EDWARDS A J
	B	427		EGGLESTON GEORGE
	A	2		EHRHARDT THEODORE
	C	771		EICHER ABRAHAM
	A	75		EIS PETER
	A	289		ELDERKIN SAMUEL
	C	684		ELLIOTT DANIEL M
	C	762		ELLIS JOHN Q
	A	268		ELSEA WILLIAM
	A	230		ELY M
	A	84		EMERY ALFRED
	B	554		ENGELBRECHT AUGUST
	C	898		ENNES FRANKLIN V
	A	300		ERELAND A
	A	244		ERVIN LEWIS
	C	693		ESSIG WILLIAM
	C	744		EVANS WILLIAM JACKSON
21	A	148	(19)	EVERLY F M

F

SECTION	LOT	GRAVE	WAR	NAME
21	C	910	(19)	FACKLER GEORGE
	A	191		FARRELL JOHN E
	C	847		FAUSEY WILLIAM C
	B	475		FEDISON CHRISTOPHER
	C	888		FEENEY PATRICK
	B	391		FEIRBACH JACOB
	C	856		FELTON AMBROSE
	A	167		FERGUSON WILLIAM
	B	338		FERRIS JOSHUA A
	C	826		FISHER JOHN
	A	326		FISHER SIMON
	C	810		FISHER WILLIAM O
	C	933		FLETCHER JOHN
	A	212		FLIGOR ANDREW J
	C	987		FLOWERS HARRISON B
	B	614		FLOWERS WILLIAM
	C	717		FLYNN THOMAS
	B	564		FORTE JAMES
	B	605		FOWLER JOSEPH J
	A	43		FOWLER PETER
	B	629		FOWLER WM H
	C	923		FOX WILLIAM F
	C	961		FRANKES LEONARD
	A	155		FRECH CONRAD
	B	454		FREMAN JAMES N
	C	893		FRIERSTAIN JACOB
	A	112		FRITZ HENRY
	B	410		FROEBE NICHOLAS
	C	690		FROST JOHN H
	A	311		FRYAR JAMES
21	B	383	(19)	FULLER JAMES

G

SECTION	LOT	GRAVE	WAR	NAME
21	A	57	(19)	GAILS JOHN G
	B	671		GALBRETH GEORGE W
	B	561		GALES WILLIAM H
	C	800		GALLEMORE ELISHA S
	B	364		GALLION DAVID
	B	634		GALLOP LOUIS C
	C	735		GANGER WILLIAM
	B	558		GANSEN JOHN
	C	974		GARVER JOSEPH
	C	813		GASLINE AURELIUS
	C	747		GEAUPERT CHARLES
	A	253		GEORGE ADAM
	B	642		GEYER JOHN
	B	512		GIBBS SAMUEL
	A	296		GILES JAMES F
	A	157		GILL J H
	A	300		GILLON JASPER N
	A	99		GILMER ALLEN
	A	299		GITHENS JACOB K P
	B	409		GLOVER HENRY
	C	682		GOODENO MARTIN
	A	192		GOODWIN J D
	A	302		GORBY WILLIAM
	B	541		GORDON GEORGE S
	B	618		GORDON HENRY
	A	4		GOTTSCHALK JACOB
	A	267		GOULD HENRY
	A	269		GREEN ALBERT
	A	29		GREEN RICE B
	B	398		GREER FRANKLIN
	A	172		GREY CHARLES E
	B	458		GRIEG MARTIN
	B	578		GRIMM FREDERICK
	A	58		GROB ULRICK
	B	453		GRONBECK C AUGUST
	C	829		GROSS WILLIAM
	C	882		GROVE J W
	C	993		GROVE MICHAEL
	A	93		GROVES W H
21	C	197	(19)	GROW DAVID

G

SECTION	LOT	GRAVE	WAR	NAME
21	A	18	(19)	GRUBBS JOSEPH T
	A	141		GRUETER JOHN
	B	376		GSCHWIND CHARLES
	C	773		GULORE HENRY
	A	59		GUNDY J H
21	C	929	(19)	GUNDY WILEY

H

SECTION	LOT	GRAVE	WAR	NAME
21	B	573	(19)	HABERLAND BENJIMAN
	C	740		HACKENBURG MICHAEL
	A	137		HAINER CHARLES C
	A	114		HALE J R P
	C	858		HALL JAMES
	A	160		HALL JOHN
	C	914		HALL RILEY
	B	437		HALL SAMUEL L
	A	291		HALLOWAY JAMES
	B	402		HALVERSON HALVER
	A	70		HAMILTON JEREMIAH
	C	782		HAMLIN WILLIAM
	C	696		HAMMOND LOUIS P
	A	125		HANAN JOHN
	A	28		HANDLEY MATTHEW
	A	21		HANSON JAMES
	C	902		HANSON JOSEPH
	A	290		HANT JACOB
	B	369		HAPNER JESSE
	A	30		HARDY HENRY
	B	496		HARING CHARLES P LIEUT
	B	663		HARRINGTON A H
	C	763		HARRINGTON BEN
	A	176		HARRISON G W
	B	423		HARRISON JAMES
	C	831		HARRISON JOHN W
	B	452		HARTLIEB CHRIS
	C	799		HARTMAN ISAAC
	B	555		HARVEY PATRICK
	A	136		HASE WM
	A	45		HASTINGS HUGH
	B	392		HATTERY JESSE
	C	936		HAY WILLIAM
	B	487		HAYDEN R B
	B	337		HAYS ROBERT
	B	345		HAYS THOMAS A
	A	40		HAZELMYER WILLIAM
	C	786		HEATHER NATHANIEL
	A	282		HEIGHOLTZER GOTLIEB
	B	480		HEINBACH PHILIP
	A	182		HELDF VALENTINE
	A	263		HELMS JACOB
	B	517		HEMSTREET HOZY
	C	845		HENDRICKS DAVID P
		750		HENDRICKS JOSEPH
	A	123		HENDRICKS RUFUS
	C	989		HENTHORN ALEXANDER
	A	33		HESS ANTHONY
	B	432		HESS ELI
	B	657		HESS PHILIP
	B	438		HEWETT PHILANDER
	A	129		HILL CHARLES
	A	174		HILL HENRY
	C	681		HILL PHILANDER
	A	19		HILLFECKER JACOB
	C	912		HILLMAN WILLIAM G
	C	767		HILLS JAMES
	A	277		HILLYER THOMAS O
	B	363		HINTON FRANCIS
	B	514		HIPP JACOB
	B	375		HIRSHMAN GOTTLIEB
	A	61		HITTWINE CHARLES F
	B	626		HITZING WILLIAM
	B	586		HODKINSON JAMES N
21	A	324	(19)	HOEN JACOB

H

SECTION	LOT	GRAVE	WAR	NAME
21	B	479	(19)	HOEY JOHN
	A	1		HOFELE NICHOLAS
	C	854		HOFF HENRY
	B	538		HOHLE THEODORE MAJ
	C	708		HOHNORTH HENRY
	C	720		HOHUR JOHN
	C	942		HOKE GEORGE
	C	815		HOLCOMB ALONZO N
	A	292		HOLCOMB DAVID
	B	559		HOLCOMB DEHIEL
	A	111		HOLLAND FRED F
	A	166		HOLLAND JOHN
	C	964		HOLLIDAY GREEN
	C	726		HOLLIDAY THOMAS D
	C	991		HOLLINGSWORTH JOHN
	A	254		HOLLINGSWORTH THOMAS
	B	666		HOLMES EDWARD
	B	560		HOLTEN JAMES M
	B	563		HOOVER FREDERICK
	B	360		HOPKINS FRANKLIN
	B	413		HOPKINS JOHN H
	A	224		HORD J G
	A	69		HORTON WILLIAM P
	A	77		HOSTERMAN FRANK
	A	85		HOUSE SAMUEL
	B	551		HOUTZ JOHN H
	B	505		HOWARD JOHN
	B	440		HOWARD JOHN H
	B	549		HOWARD ORLEAN
	C	890		HOWARD W H
	C	712		HOWARTH GEORGE W
	C	724		HOWLY PETER
	B	445		HOWRY JOHN
	A	214		HOYT GEORGE
	A	260		HUBBARD AMOS
	C	798		HUBBARD GEORGE
	A	78		HUBBARD WILLIAM B
	A	154		HUCKSTEP J F
	C	823		HUDSON C L
	A	113		HUDSON MILTON C
	B	652		HUFFMAN GEORGE
	C	957		HUGGITT WILLIAM
	A	91		HUFNAGLE J C
	A	190		HUGHES ALBERT
	B	449		HUGHES CHARLES
	B	613		HUGHES OLIVER
	C	865		HULL CALVIN C
	A	72		HULLETT ROBERT
	B	469		HUMPHREY GEORGE B SARG
	C	950		HUNT BAZEL
	A	49		HUNT HENRY
	A	178		HUNTER JOHN
	A	173		HUNTER JOSEPH
	C	742		HUNTER ROBERT P
	B	380		HUTCHINS GEORGE
	A	201		HUTCHINSON AMOS J
	B	436		HUTCHINSON S R
21	B	577	(19)	HYMAN HENRY F CAPT

I

SECTION	LOT	GRAVE	WAR	NAME
21	A	17	(19)	INGLE WILLIAM

J

SECTION	LOT	GRAVE	WAR	NAME
21	A	225	(19)	JACKSON ASA
	B	489		JACOBS JOHN
	C	802		JAMES JOHN H
	A	89		JARRETT ALLEN
	A	41		JENNINGS WILLIAM P
	C	946		JENTREY HENRY
21	B	460	(19)	JESTER ELKANA

J

SECTION	LOT	GRAVE	WAR	NAME
21	B	429	(19)	JEWELL HARRISON
	B	473		JEWELL JOHN G
	A	161		JOHNSON ALEXANDER
	A	74		JOHNSON BENJAMIN
	A	181		JOHNSON DAVID
	B	546		JOHNSON JAMES
	C	895		JOHNSON JAMES
	C	870		JOHNSON JAMES E
	B	519		JOHNSON JOHN J
	C	778		JOHNSON MARTIN
	A	284		JOHNSTONE JOHN
	B	CENTER O		JONES FREDERICK C COL
	B	571		JONES JOHN
	B	485		JONES JOHN
	B	359		JONES MALACHI
	B	494		JONES SAMUEL W
	A	66		JONES WHEELING A
	B	542		JONES WM P
21	B	673	(19)	JUMPER CHARLES

K

SECTION	LOT	GRAVE	WAR	NAME
21	B	462	(19)	KAISER GOTLIEB
	A	183		KARNES ROBERT CAPT
	B	382		KAUFFMAN GABRIEL
	A	131		KEEN LEWIS
	C	905		KEESOR EDWARD
	A	97		KEISER LAFAYETTE
	B	638		KEISER SAMUEL
	C	764		KELLER JOSEPH
	C	727		KELLEY WILLIAM
	C	746		KELLY ISAAC N
	A	119		KELLY JAMES
	B	641		KELLY JAMES B
	A	51		KELLY MARTIN
	B	654		KELLY MICHAEL
	B	482		KELLNER CHARLES W
	B	353		KENNEDY WILLIAM
	B	342		KENNEL SAMUEL
	B	374		KENT DAVID
	A	138		KILLS HYLAS L
	A	145		KILMER O P
	A	61		KIMBLE JAMES
	C	793		KIMLER SIMON
	C	692		KING EDWARD
	B	572		KING JOHN
	B	377		KINNEY HARRISON
	C	959		KITE JAMES F
	C	872		KNAPP ERASTUS
	B	461		KNIFFEN GEORGE C
	C	723		KNIGHT EDWIN
	C	814		KNIGHT JOHN
	C	774		KRAMER FREDRICK K
	B	399		KRAUSER JOHN
	B	414		KRIEGER FREDERICK
	B	428		KRIGER FREDRICK
	A	276		KRUGER HENRY
	A	115		KUISLEY G WASH
	B	569		KULL CHRISTOPHER
	B	556		KUNZMANN JOHN
	C	928		KURTZ GEORGE N
21	B	439	(19)	KURZ ERNST J M

L

SECTION	LOT	GRAVE	WAR	NAME
21	C	896	(19)	LACY H H
	A	245		LACY JACOB
	B	385		LADD RICHARD
	A	304		LASH WILLIAM J
	A	270		LAUNDERS JULIUSB
	C	701		LAW JAMES
	C	999		LAWLER EPHRAIM
	C	941		LAWRENCE JAMES I
	B	675		LAWSON WILLIE
	B	543		LAYNE GEORGE W
	A	204		LEADMAN ARCHE
	A	13		LEINDECKER PETER
	A	200		LERCH JOHN
	C	855		LESLEY AMOS
	B	611		LEWIS J
	A	8		LIGHTNER RICHARD
	B	630		LINDLY HENRY
	C	927		LINGO JOHN N
	A	175		LIPPEN HENRY
	B	599		LOCK JOHN F
	B	418		LONG HENRY
	A	207		LOOMIS DANIEL
	A	147		LOPP JOHN
	C	995		LOTTA T B
	B	530		LOVE WALTER
	C	841		LOW ALONZO
	A	319		LOWE GEORGE W
	C	881		LOWER JOHN
	A	127		LUCAS LAFAYETTE
	B	553		LUCHT CHARLES
	A	152		LUCKFORD HENRY
	A	146		LUELLEN JOHN
21	B	502	(19)	LYONS CHARLES H

Mc

SECTION	LOT	GRAVE	WAR	NAME
21	B	396	(19)	Mc CALL JOHN
	A	96		Mc CARTNEY THOMAS
	B	600		Mc CLURE ARTHUR
	A	218		Mc CLUSKY AMZI
	C	860		Mc COY WILLIAM
	C	683		Mc DERMOTT JAMES
	C	926		Mc DONNALD FRANCIS
	B	426		Mc DONALD PATRICK
	A	202		Mc FARLAND ROAS
	C	700		Mc INTYRE WATERMAN
	A	134		Mc KELLAPS JOSEPH
	A	36		Mc KINZEY DAVID
	B	490		Mc LAUGHLIN A J LIEUT
	B	669		Mc LAUGHLIN WILLIAM
	A	252		Mc MILLIN MALCOMB
	C	883		Mc MURTREE W G
21	C	770	(19)	Mc NEAL ANDREW

M

SECTION	LOT	GRAVE	WAR	NAME
21	B	433	(19)	MADIGAN DENNIS
	B	388		MAHON PATRICK
	B	580		MALLET JOHN
	B	608		MANIHUGH CHARLES
	C	745		MANN JAMES O
	C	794		MAPES ASBURY
	C	900		MARONY JOHN
	A	203		MARTIN BENJAMIN
	C	975		MASON JOHN B
	A	215		MATHER EDWARD
	A	121		MATHEWS JOHN H
21	B	562	(19)	MAUCH JOHN
21	C	956	(19)	MAUCK CHARLES
	A	238		MAY J ZERO
	C	886		MAXWELL THOMAS G
	C	868		MEADOWS THOMAS
	A	149		MEEK ANDREW J
	C	917		MENDALL AUGUSTUS
	A	83		MEREMEE JI
	C	944		MERITT SAMUEL T
	A	302		MERMAN W H
	B	632		MERTHESHEIMER FRED
	C	797		MESSER BENEDICT
	A	5		MEYER DOMINICK
	A	[illegible]		MEYERS JAMES
	B	506		MEYER HENRY
	C	954		MILLER CHARLES
	A	128		MILLER D A
	A	29-		MILLER DANIEL
	B	446		MILLER GEORGE
	B	466		MILLER GEORGE
	B	34[illegible]		MILLER ISAAC
	A	23[illegible]		MILLER J
	C	688		MILLER JACOB
	A	240		MILLER JOHN
	A	96		MILLER JOHN
	B	447		MILLER PHILIP
	A	163		MILLER S R
	A	272		MILT ENOS T
	B	648		MINK JOHN H
	B	349		MITCHELL JAMES
	A	247		MITCHELL MATHEW
	C	776		MITCHELL JAMES L
	C	861		MITCHAELS THOMAS H
	A	169		MONCRIFF HUGH
	B	381		MONROE SANFORD
	B	472		MONTGOMERY CHARLES
	C	765		MONTGOMERY HARRISON
	C	1012		MOORE GEORGE W
	B	499		MOORE HENRY LIEUT
	C	875		MOORE JAMES H
	C	992		MORELAND BENJAH
	B	570		MORGAN EVAN
	A	299		MORGAN PATRICK
	B	343		MORGAN SAMUEL
	A	52		MORRISON JOHN
	C	706		MORRISON RICHARD
	B	633		MORTIER CHARLES
	A	220		MORTON MARCUS E
	B	631		MUECKE EMILE
	B	450		MUELLER CASPER
	B	565		MUELLER JOHN
	C	1007		MUHLBACK GOTTLIEB
	A	274		MULHOLLAND DANIEL
	A	107		MULHOLLAND JOHN P
	A	264		MUND LOUIS
	B	607		MURPHY JOHN
	C	9[illegible]		MYER HENRY
21	A	7	(19)	MYERS JOHN M
	A	264		MUND LOUIS

N

SECTION	LOT	GRAVE	WAR	NAME
21	A	130	(19)	NASH ABRAM I
	C	761		NAYLOR JACOB
	C	827		NEEDS JOSHUA B
	B	370		NEIBER PAUL
	A	101		NELSON SAMUEL
	C	919		NEVIL JAMES
	A	87		NEWLAND ARCHIBALD
	B	350		NEWMAN RICHARD
	B	455		NEWTON ANZELO A
	A	126		NEWTON STEPHAN D
	C	1004		NICHOLAS DANIEL
21	A	158	(19)	NICHOLS J J
21	A	262	(19)	NICHOLS ORLANDO M
	B	441		NICKEL CHAS E CAPT
	B	431		NIGURS JF
	A	48		NOBLE DAVID
	B	544		NOBLE FRANK
	A	118		NOBLE J B
	C	986		NOLAN CORNELIUS
	C	1003		NOLAN HENRY
	C	969		NOLAN MICHAEL
	C	698		NOLTE AUGUST
	B	488		NORRIS ALEXANDER
21	C	716	(19)	NORTHROPE S H

O

SECTION	LOT	GRAVE	WAR	NAME
21	A	120	(19)	OAKLEY DANIEL
	A	193		OHLINGER JOHN
	C	857		OLESON ANDREW
	A	132		OLSON WILLIAM
	B	510		ORR WILLIAM
	A	234		OSTRANDO EDWARD
	A	227		OSWALT HENRY
	C	789		OWEN BENJIMAN
21	C	713	(19)	OWEN CHARLES

P

SECTION	LOT	GRAVE	WAR	NAME
21	B	557	(19)	PACKARD FRED M
	B	660		PACY JAMES
	C	679		PALMER ORIEN
	C	859		PARSONS HIRAM H
	C	842		PARTEE JOHN E
	C	830		PATRICK R JOHN
	B	465		PATTON JOSEPH
	B	537		PARKER CHARLES W
	B	411		PARKER R LEROY
	A	179		PAYNE WILLIAM
	B	457		PAYNE WILLIAM
	B	581		PECK F W
	B	532		PECK HORACE
	A	298		PENNOCK JOHN
	B	400		PERKINS JOHN
	A	23		PETTY ANDREW J
	A	208		PHINGST JOHN
	A	65		PICKLE HENRY
	A	25		PIPER C L
	C	781		PITCHER GUILD
	B	531		PLACE ALFRED E
	C	971		POINTER SEWELL
	B	495		POLLARD ROYAL S
	A	3		POTTER ANSON L
	A	94		POUNDS WILLIAM
	C	994		POWERS C H
	A	248		POWERS HENRY
	B	466		PRESCOTT JERRIE L
	C	840		PRESSE JOEL
	A	297		PRICE JAMES
	B	602		PRICE S L
	A	286		PRICHARD JAMES
	B	356		PRITCHARD GEORGE W
	C	748		PROTZMAN JAMES E
21	A	110	(19)	PURG HENRY

Q

SECTION	LOT	GRAVE	WAR	NAME
21	B	627	(19)	QUACKENBUSH THOMAS
21	C	680	(19)	QUIGLEY WESLEY

R

SECTION	LOT	GRAVE	WAR	NAME
21	B	357	(19)	RAHER MICHAEL
	A	312		RAINEY JAMES
	C	909		RANDALL EDWARD N
	B	645		RANDALL JOHN E
	C	880		RANDOL EDWARD L
	C	805		RANDOL F A
	A	295		RAPE WILLIAM
	C	811		READ AARON
	A	334		REALS EDWARD
	B	451		REDMAN JF
	C	686		REEDER ZACHARIAH
	C	907		REESE WM
	B	504		REEVES WILLIAM I
	A	197		REINTANTZ HERMAN
	B	463		REISOR M
	C	791		REMINGTON ALVA
	B	535		REYNOLDS HENRY
	A	283		REYNOLDS THOMAS
	A	219		RHIARD JOHN
	A	332		RHOADES IRA O
	A	31		RHOADES JOHN
	B	509		RHONE GEORGE W
	B	434		RICE RICHARD M
	C	949		RICH WILLIAM H
	A	242		RICHARDSON L J
	B	579		RICHTER GUSTAV CAPT
	B	372		RIGGLESWORTH CHARLES W
	A	255		RIST JOHN C
	C	924		RITCHIE HENRY
	B	615		RITTER ALBERT
	C	940		ROBERTS GEORGE
	B	527		ROBERTS JOHN S
	C	968		ROBERTS THOMAS
	C	970		ROBINSON DANIEL
	C	866		ROBINSON JAMES A
	A	205		ROBINSON J M
	C	785		ROBINSON JOHN
	C	965		ROBINSON JOHN W
	B	351		RODERIGO LOUIS
	B	412		RODMAN B
	A	210		ROHOLEN JOHN
	A	250		ROHRIN MICHAEL
	A	116		ROGUE HORACE
	A	303		ROLLER CHARLES
	C	1010		ROON HENRY
	A	213		RORKE I H
	C	833		ROSE WILLIAM
	A	165		ROSEBOROUGH SAMUEL
	A	105		ROSS C B
	B	615		ROSS JAMES M CORP
	B	623		ROSS PETER
	A	139		ROSS W H
	B	640		RUDEBAUGH BENJAMIN F
	B	636		RUDOLPH THOMAS
	B	601		RUMBOLD JOSEPH
	A	189		RUMMELLS JACOB A
	A	328		RUNKELS JOSEPH
21	B	525	(19)	RUSTON GEORGE B

S

SECTION	LOT	GRAVE	WAR	NAME
21	B	597	(19)	SANDERS JOHN H
	C	806		SANDERS TIMOTHY
	C	938		SARGENT HENRY
	B	528		SATTERLY R W
	B	606		SAWDEY EDWIN
	A	39		SCANLON - - -
	A	33		SCHMIDT THEODORE
	C	921		SCHNEIDER GEORGE
	B	486		SCHOW ANDREW
	C	783		SCHULTZ AMOS
	C	775		SCHULTZ HENRY
	B	576		SCHULZ JOHN
	C	943		SCOTT ALEXANDER S
	B	610		SCOTT HARRIS
	B	339		SCOTT ROBERT
	B	497		SCULLION BARNEY
	A	42		SEALOCK S F
	B	380		SEDWICK JAMES W
	C	737		SEREFIN CALVIN
	A	64		SEVERNS SAMUEL
	C	985		SHAMP MOSES
	B	524		SHARP GEORGE E
	B	574		SHARP HENRY
	C	801		SHAVER SAMUEL M
	B	422		SHAW EDWARD P
	C	976		SHEAFER JOHN F
	B	650		SHELDON THOMAS
	A	143		SHETTER DANIEL
	C	915		SHIFFLET JOHN
	C	930		SHILLING JACOB
	A	108		SHIRLEY W B
	A	124		SIBERT JOHN H
	C	836		SILLEY CHARLES H
	B	386		SIMMONS CALEB
	C	718		SIMPSON GEORGE
	C	828		SIMPSON JOSEPH V
	A	90		SINGLETON E T
	B	534		SISSON RANDALL JR
	C	839		SIX ELIAS W
	A	187		SKEELER GEORGE
	C	982		SMITH ANDREW
	C	754		SMITH DAVID N
	A	322		SMITH FREDERICK
	B	568		SMITH HENRY Y DR
	B	389		SMITH JACOB
	C	1009		SMITH JACOB
	A	241		SMITH JAMES
	A	211		SMITH JOHN M
	C	903		SMITH PETER
	B	508		SNYDER SAMUEL
	C	980		SORG ADAM
	B	492		SOUTHARD GEORGE
	A	309		SOUTHWORTH EZRA
	A	676		SPARENBERG HENRY
	C	849		SPATHOLZ JOHN
	B	435		SPEAR ELIJAH C
	A	323		SPEARMAN THOMAS
	C	892		SPICER JOHN L
	C	962		SPRAGUE M C
	A	56		SPRINGER LEANDER
	C	843		SPRINGER LEVI
	C	934		SPRINGER PHILIP
	C	931		SPRONCE WILLIAM A
	C	844		SQUIRES ADIN
	C	846		STANDARD THOMAS
	C	704		STARR WILLIAM
	B	348		STETZER PHILIP
	A	307		STEVENS HENRY
	A	321		STEVENS JOS
	A	92		STEWART JOHN A
	B	425		STICKNER ALLEN G
	C	922		STITES ALONZO
	B	552		STOCKWELL SOLOMAN
	A	162		STOKES HENRY
	B	503		STOPHINE ANTHONY
	A	109		STORRER WILLIAM
	A	223		STORY JOHN D
	A	27		STRAMER JOHN
	C	874		STRICKER JACOB
	C	899		STRICKLAND WALTER
	C	784		STULL ADAM
	C	816		STUMP JOHN
21	B	493	(19)	SURCK CHARLES

S

SECTION	LOT	GRAVE	WAR	NAME
21	B	575	(19)	SURLES FRANCIS
	B	536		SUTTON JACOB
	A	266		SUTTON PHILIP E
	A	[illegible]		SWAP GEORGE
21	C	760	(19)	SWISHER HENRY

T

SECTION	LOT	GRAVE	WAR	NAME
21	C	803	(19)	TAYLOR JAMES
	B	366		TAYLOR JOHN
	A	153		TAYLOR JOHN
	A	271		TAYLOR WILLIAM F H
	C	919		TAYLOR SANDERS
	C	772		TEAGARDEN LORENZO D
	C	897		THAIR AMBROSE G
	C	978		THATCHER DAVID
	B	339		THAYER JOHN
	B	515		THEOBALD HEINRICH J
	A	229		THEOBALD JULIUS
	B	584		THIELE CHARLES
	C	947		THOMAS CHARLES F
	C	884		THOMAS WALTER
	A	51		THOMPSON GEO SR
	B	416		THOMPSON STEPHEN
	A	265		THORNCROFT DAVID
	A	286		TITSWORD JAMES
	B	191		TOM ANDREW
	C	819		TOWNE ARTHUR D
	A	269		TRACEY HUGH
	C	853		TRACY JAMES
	C	967		TRACY JOHN
	C	703		TRAME WM SARGT
	A	150		TRIM THEODORE
	A	88		TRUMAN DAVID
	C	825		TUBBS SINCLAIR
	C	728		TURNER CHARLES
	A	144		TURNER DAVIS
	C	699		TURNER JAMES H
	C	790		TURNER WM A
	C	732		TURRILL HOMER
21	B	498	(19)	TWEED ALEXANDER

U

SECTION	LOT	GRAVE	WAR	NAME
21	C	738	(19)	UKELE PHILIP
	C	75		ULET ELI
	C	678		UNKNOWN
	C	845		
	C	988		
	C	850		
	C	954		
	C	734		
	C	756		
	C	757		
	B	464		
	B	540		
	B	589		
	B	598		
	B	603		
21	B	587	(20)	UNKNOWN

U

SECTION	LOT	GRAVE	WAR	NAME
21	A	171	(19)	UNKNOWN
	A	335		
	A	330		
	A	329		
	A	301		
	A	261		
	A	222		
	A	217		
	A	79		
	A	158		
	A	15		UNKNOWN
	A	301		UNKNOWN U S SOLDIER
	C	733		UNKNOWN
	C	687		UNKNOWN
21	B	484	(19)	UTHE CHARLES

V

SECTION	LOT	GRAVE	WAR	NAME
21	B	624	(19)	VANCE GEORGE T
	C	822		VANDYNE MAHLON
	B	653		VIGOR JOHN H
	A	320		VITT FRANK S
	B	408		VOGEL FERDINAND
21	A	303	(19)	VRULAND ABRAHAM

W

SECTION	LOT	GRAVE	WAR	NAME
21	A	285	(19)	WADDLE HARLAN
	B	387		WAGONER JOEL
	B	513		WAGONER JOHN
	C	901		WALKER EVANS
	C	848		WALLACE WILLIAM B
	B	378		WALTER GEORGE
	C	715		WARD JOHN W
	A	180		WARNER ALBERT
	B	585		WATER HENRY A
	B	646		WATKINS FRANK
	C	979		WATSON WILLIAM
	B	404		WATT JAMES A
	C	894		WEAVER JOHN
	A	26		WEBB JOHN
	C	990		WEBBER RANDOLPH
	B	368		WEBSTER M S
	B	332		WEIDNER E
	B	470		WEIGAND FRANK
	A	199		WEITMANN JOHN
	C	711		WELCH THOMAS
	B	448		WELKER JOHN
	B	456		WELLS M W
	B	471		WENDT CHARLES
	B	379		WENSEL WILLIAM
	B	344		WERMER JOSEPH
	C	885		WERTS NOAH J CORP
	C	1001		WEST CHARLES E
	A	301		WEST J A
	B	612		WESTENHAVER ABRAHAM
	C	817		WESTFALL TILMAN
	B	643		WHEELER ANTHONY
	B	620		WHETSTONE ABRAHAM
	A	185		WHITE JF
	C	972		WHITMAN ABSALOM
	A	80		WHITMAN J C
	C	932		WHITMAN VAN RENSSELAER
	C	824		WHITNEY JAMES A
	C	769		WHITTER AMOS C
	A	281		WICKERSON PHILIP
	A	273		WICKHAM JAMES M F
	C	721		WILCOX WM B
21	C	1008	(19)	WILHITE JOHN P

W

SECTION	LOT	GRAVE	WAR	NAME
21	A	306	(19)	WILLIAMS DAVID
	C	741		WILLIAMS JAMES
	A	313		WILLIAMS JOHN
	C	CENTER		WILLIAMS THOMAS J GEN
	C	1006		WILLIAMSON NATHANIEL
	B	662		WILSON AUSTIN
	B	622		WILSON DAVID
	A	298		WILSON FREDERICK
	A	140		WILSON JOHN
	B	550		WINDELL ELIJAH
	A	67		WINTRINGHAM JOB
	C	863		WITHERSPOON THOMAS J
	A	305		WIZENER ABRAHAM G
	A	11		WOLCOTT DAVID A
	B	419		WOLF CORNELIUS
	B	481		WOLF JOHN K
	B	373		WOLF LEVI
	B	459		WOLF S
	B	522		WOOD SAMUEL R
	A	82		WOODS EDWARD B
	A	12		WOODS JOHN
	C	796		WOOL ALONZO
	B	420		WOOLSEY FRANCIS E
	B	616		WRIGHT ISAAC
	B	354		WRIGHT ISRAEL
21	C	739	(19)	WRIGHT LUCAS

X

Y

SECTION	LOT	GRAVE	WAR	NAME
21	A	325	(19)	YOUNG HESEKIEL
21	C	1002	(19)	YOUNG OWEN

Z

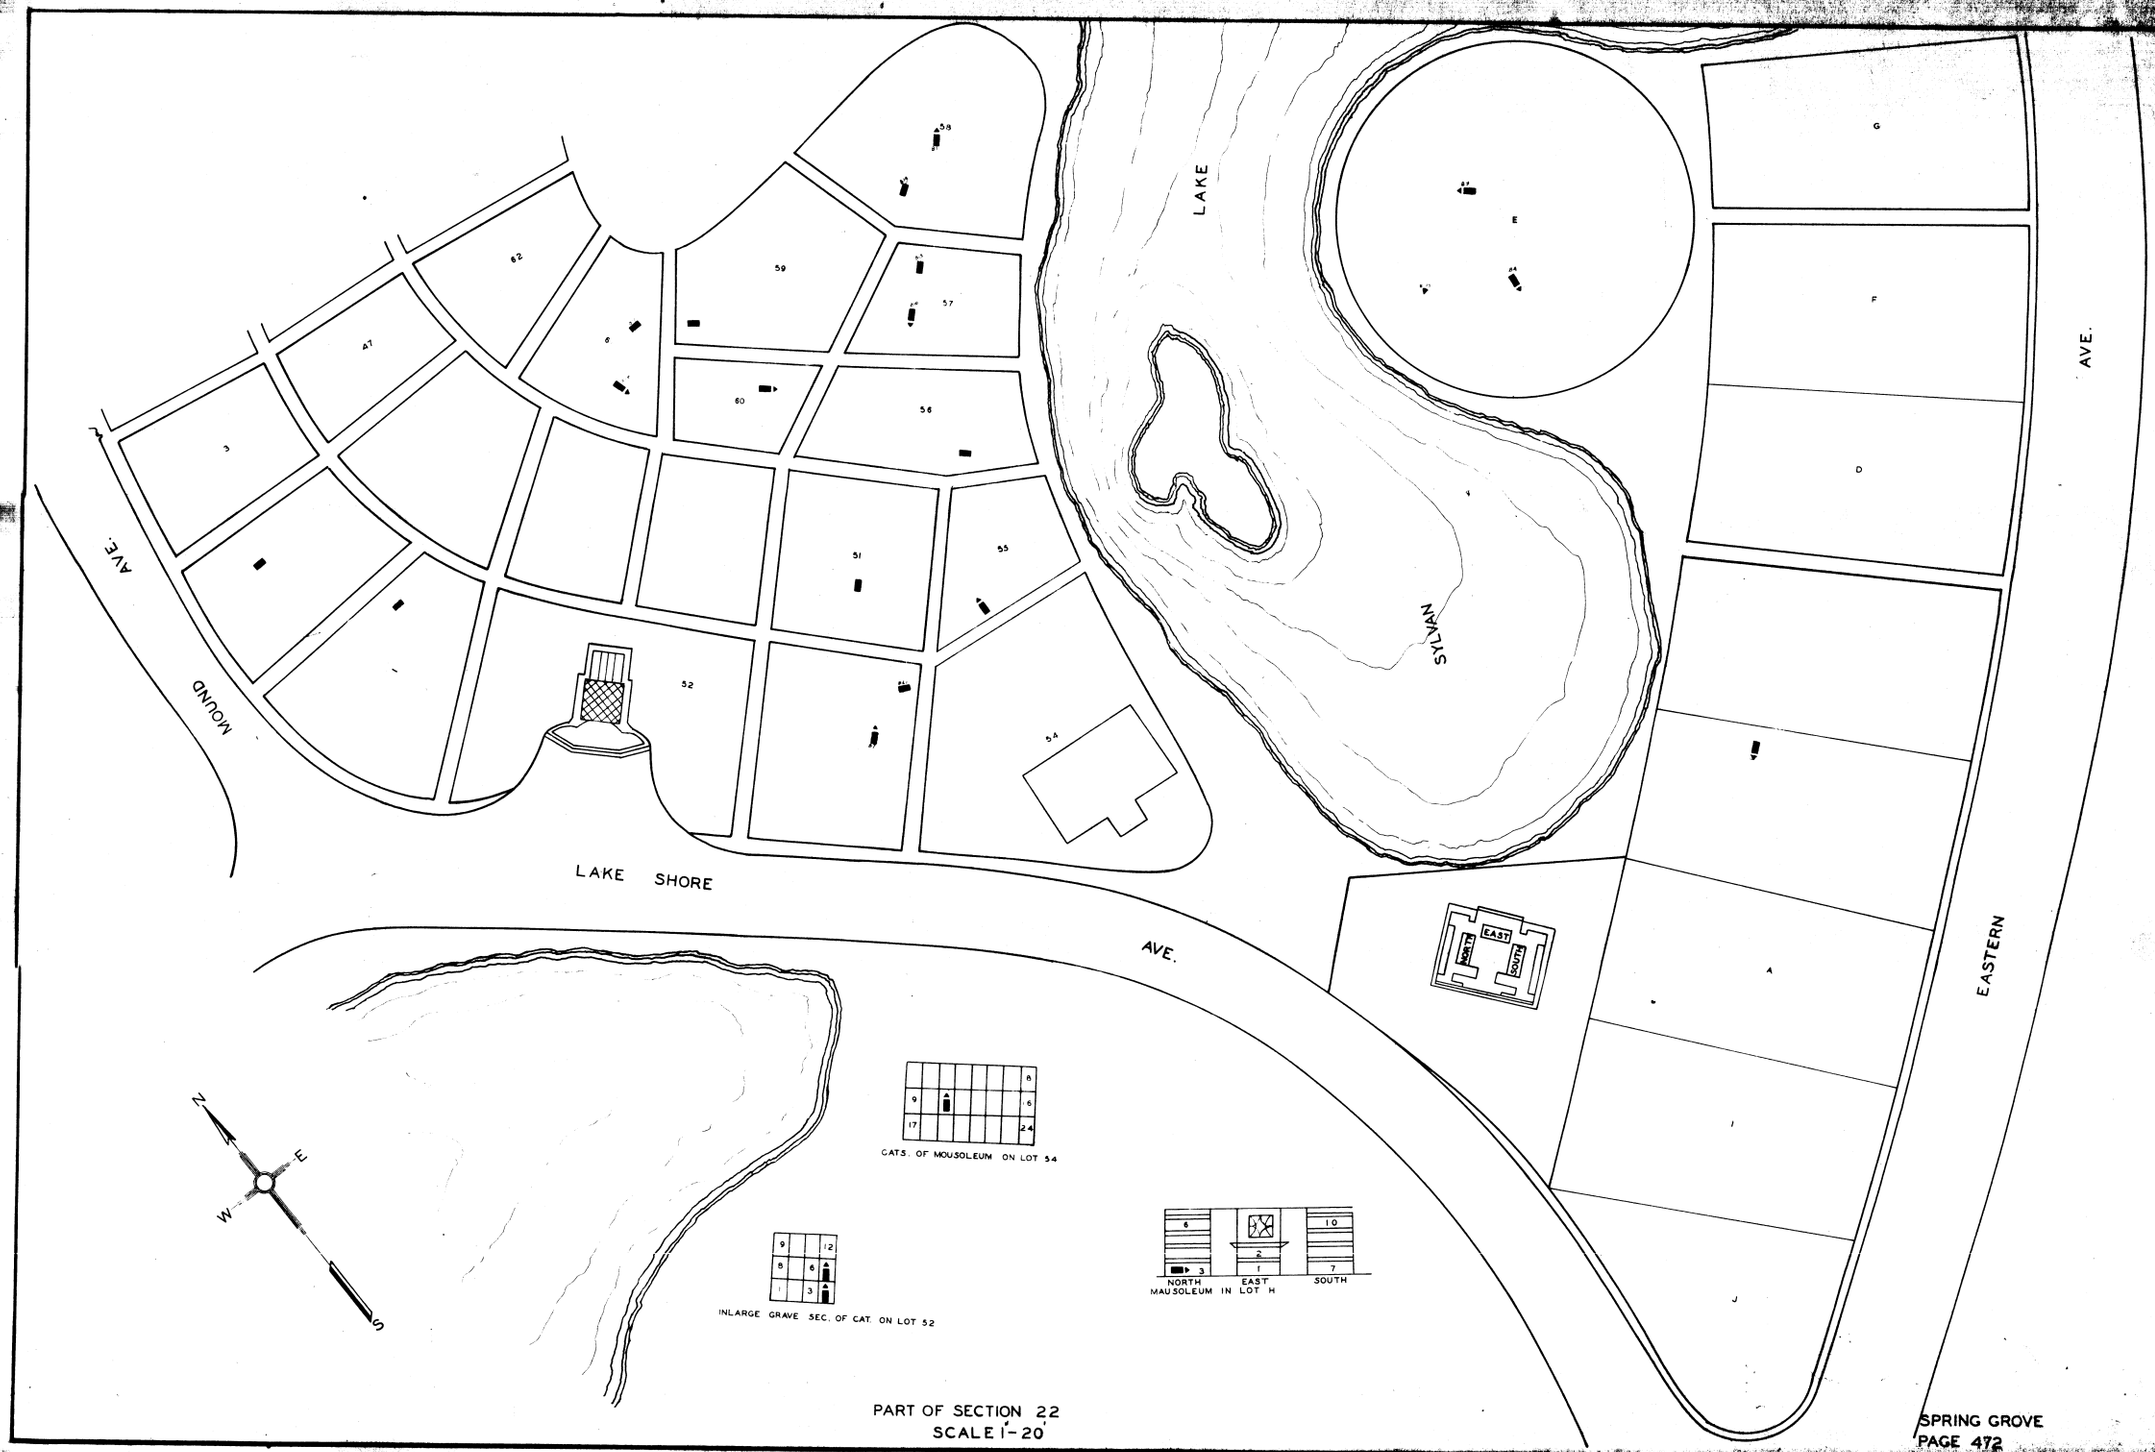

PART OF SECTION 22
SCALE 1-20'

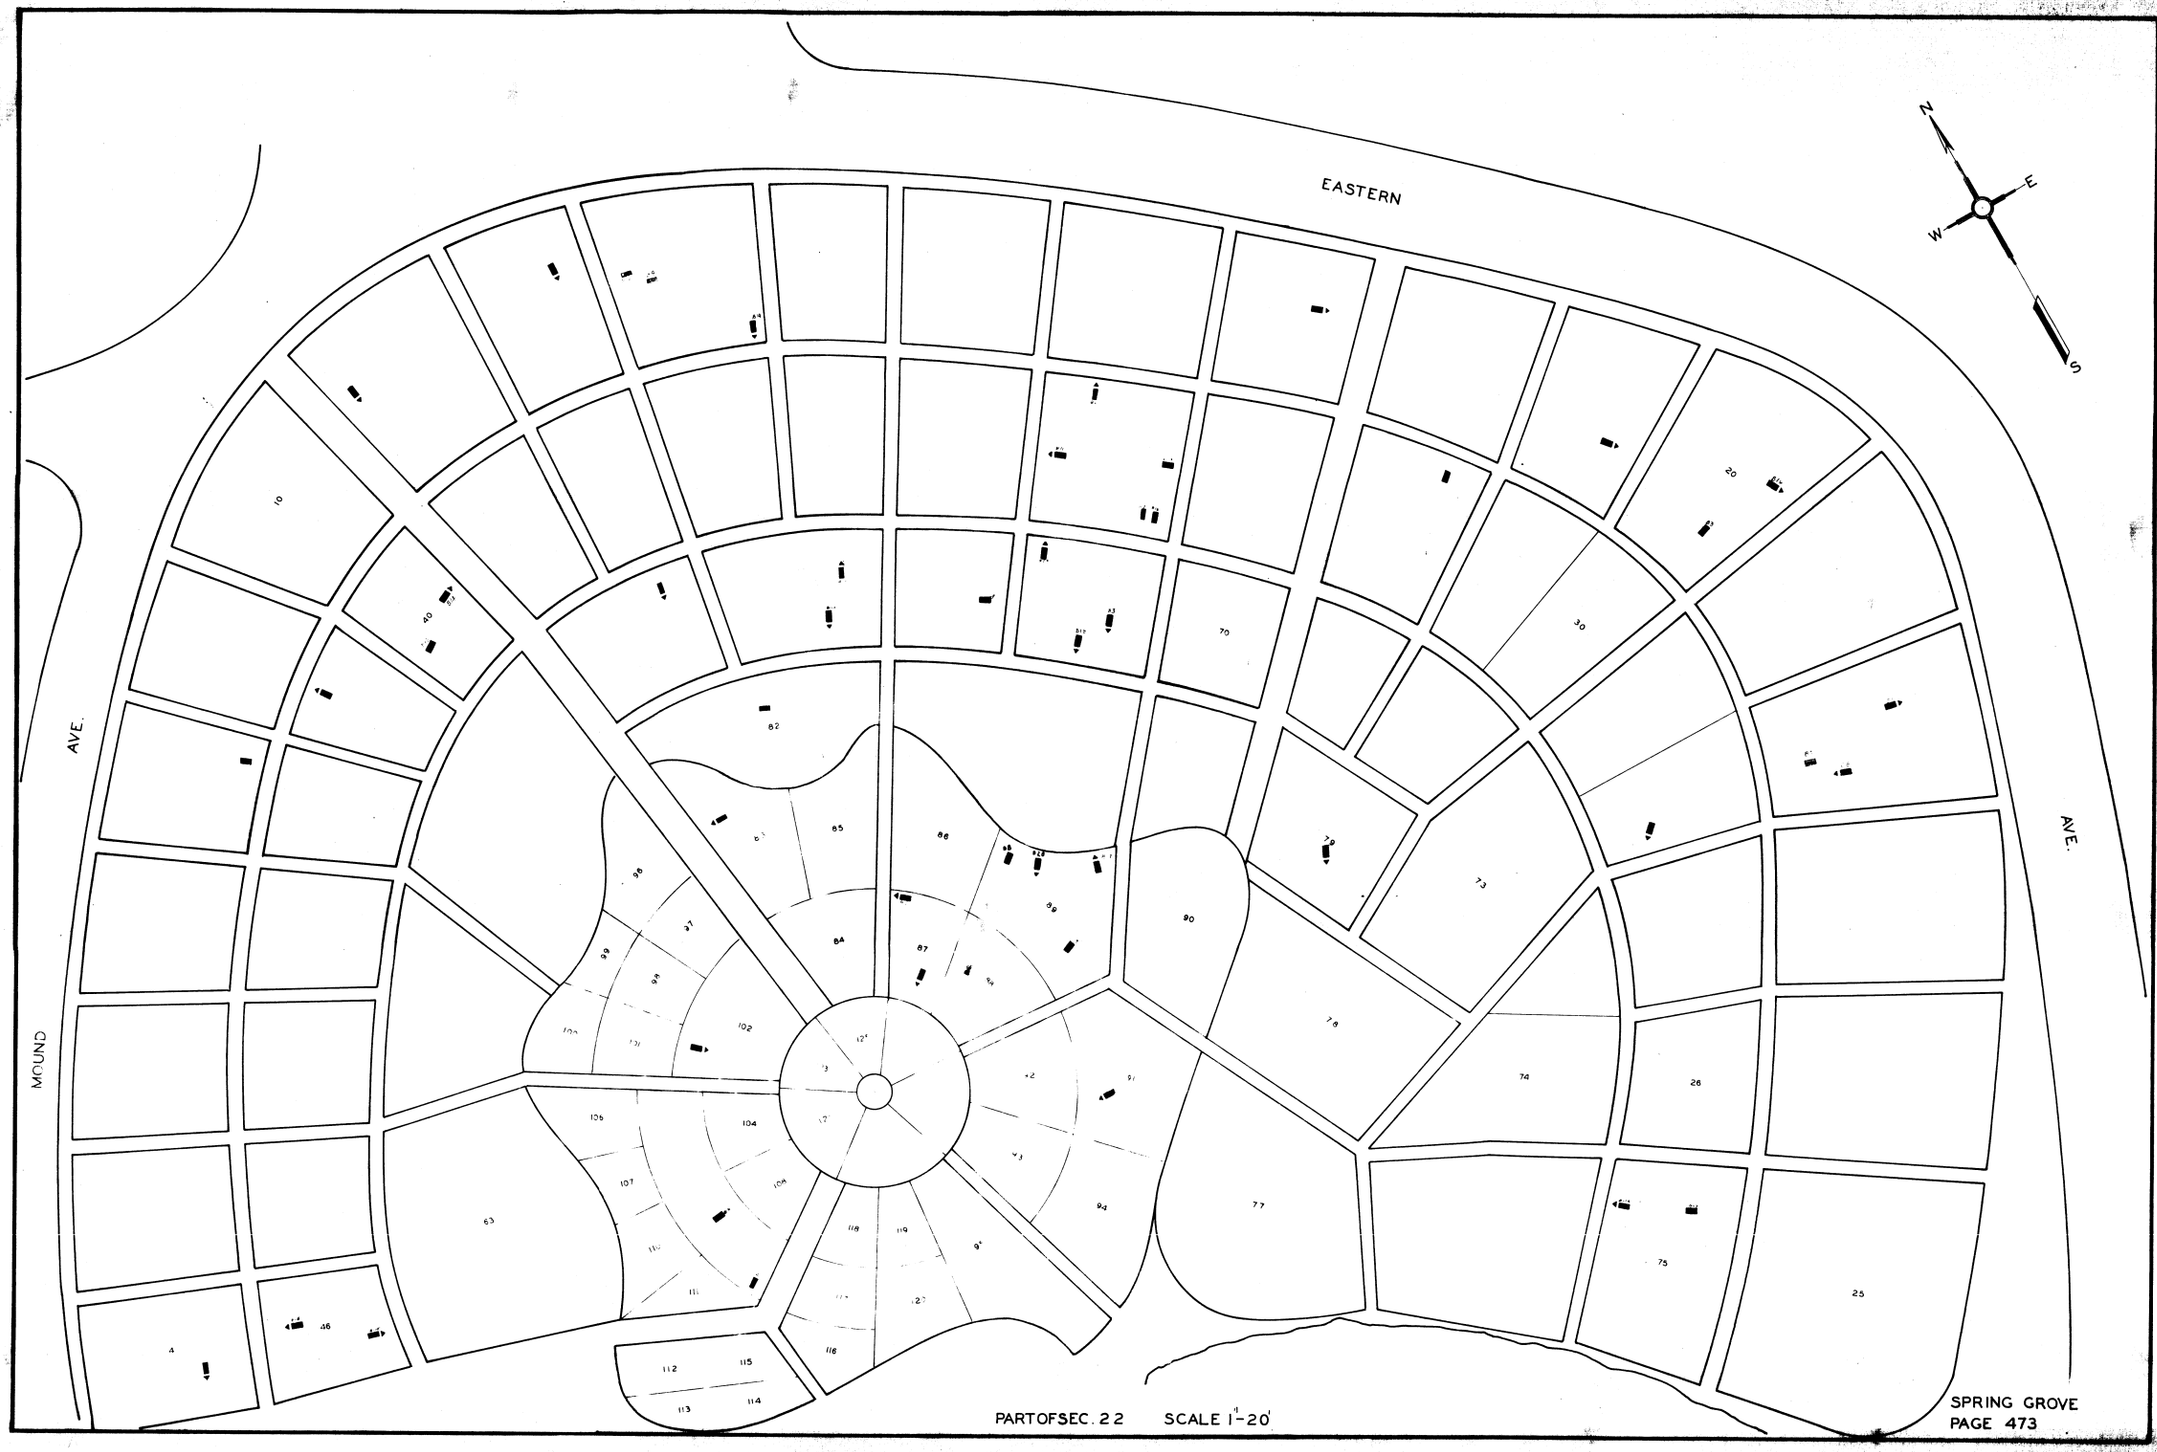

PARTOFSEC. 22 SCALE 1"=20'

SPRING GROVE
PAGE 473

LOT	GRAVE	WAR	NAME
67	B 12	(19)	BOSWORTH CHAS. E.
89	B 28	(25)	BROCKMAN WM.
61	B 17	(19)	BROWN GEO. H.
52	4	(19)	BURNETT GEO. W.
1	B 17	(31)	BROWN JAS. F.
46	B 15	(19)	CARRELL ROBT. R.
4	B 8	(19)	CULLUM GEO.
22	B 11	(13)	DAVIS FRANK S.
22	B 5	(19)	DAVIS HENRY L.
61	18	(19)	DAVIS THEOPHELUS
56	B 11	(19)	DECAMP CHAS.
17	B 9	(19)	DECAMP THOMAS L.
89	B 8	(19)	EPPINGER JOHN
91	B 2	(19)	FAGIN MORGAN H.
46	B 5	(19)	FISHER MARTIN R.
H IN VAULT	B 3	(21)	FLACH FREDERICK J.
28	B 2	(19)	FRENCH JOSIAH H
20	B 3	(12)	GANO JOHN
40	B 15	(31)	GANNON PAUL
8	B 10	(19)	GOLDEN GEO. W.
53	B 6	(19)	GROESBECK JOHN
5 IN CAT.	B 11	(31)	GROESBECK WM. S.
13	B 13	(25)	PHILIP HAYWARD
19	B 11	(19)	HOOPER HENRY
69	B 18	(19)	HOWE CHAS. A.
20	B 16	(19)	HUNT WM. L.
13	B 9	(19)	HURD ETHAN O.
57	B 13	(16)	JOHNSTON JOHN
57	B 10	(19)	JOHNSTON ROBERT A.
109	B 36	(25)	JONES THOMAS D.
B	B 9	(31)	JUDKINS WM. B.
11	B 12	(19)	KILBRETH JOHN W.
87	B 6	(19)	KLINE CHAS.
22	B 8	(19)	KNIGHT JOHN G.
67	B 14	(19)	LANE PHILANDER P.
59	B 3	(19)	LAYCOCK HARRY
88	B 15	(25)	LINGER LOUIS C.
69	B 3	(19)	LORD RICHARD S.C.

LOT	GRAVE	WAR	NAME
32	B 26	(19)	MADDOX JAS. E. C.
102	B 12	(25)	MAGILL WESLEY W. W.
68	B 5	(19)	M FARLAND ROBERT A.
11		(19)	M LEAN NATHANIEL H.
41	B 3	(19)	MENDENHLL CHAS.
83	B 4	(16)	MILLER HENRY
5	B 6	(16)	M TCHELL THOMAS
53	B 11	(19)	MOORE JAS A
53	B 7	(19)	MOORE R.M
79	B 15	(19)	MORGAN JOHN
E	B 4	(19)	MORRISON J HN L
E	B 9	(19)	MORRISON TH MAS R
E	B 13	(31)	MORRISON JOHN
34	B 7	(1)	OLIVER ALEXANDER (Alexander)
40	B 14	(19)	ORANGE WILLIAM F
87	B 9	(19)	PEROM JOHN M.
52	5	(19)	POMEROY CHAS C.
58	B	(19)	PRICE REES E
58	B 14	(19)	PRICE WM.
60	B 4	(19)	REDDISH STEPHEN
13	B 4	(19)	ROBINSON ANDREW R
89	B 3	(19)	RUSS GOTTHARD
75	B 12	(19)	SAMPSON HY C.
75	B 7	(19)	SAMPSON WM JR
2	B 10	(19)	SHAW ALBERT F
66	B 8	(19)	SMITH JOHN
34	B 26	(3)	SPENCER CHAS
34	B 6	(3)	SPENCER OLIVER
34	B 16	(16)	SPENCER WARREN
82	B 8	(19)	SNYDER DAVID W
100	B 2	(19)	WHITE ROBT. A.
69	B 26	(19)	WHITE AMOS
34	B 21	(19)	WILLIAMSON AM.
89	B 27	(19)	WIMMER PHILIP

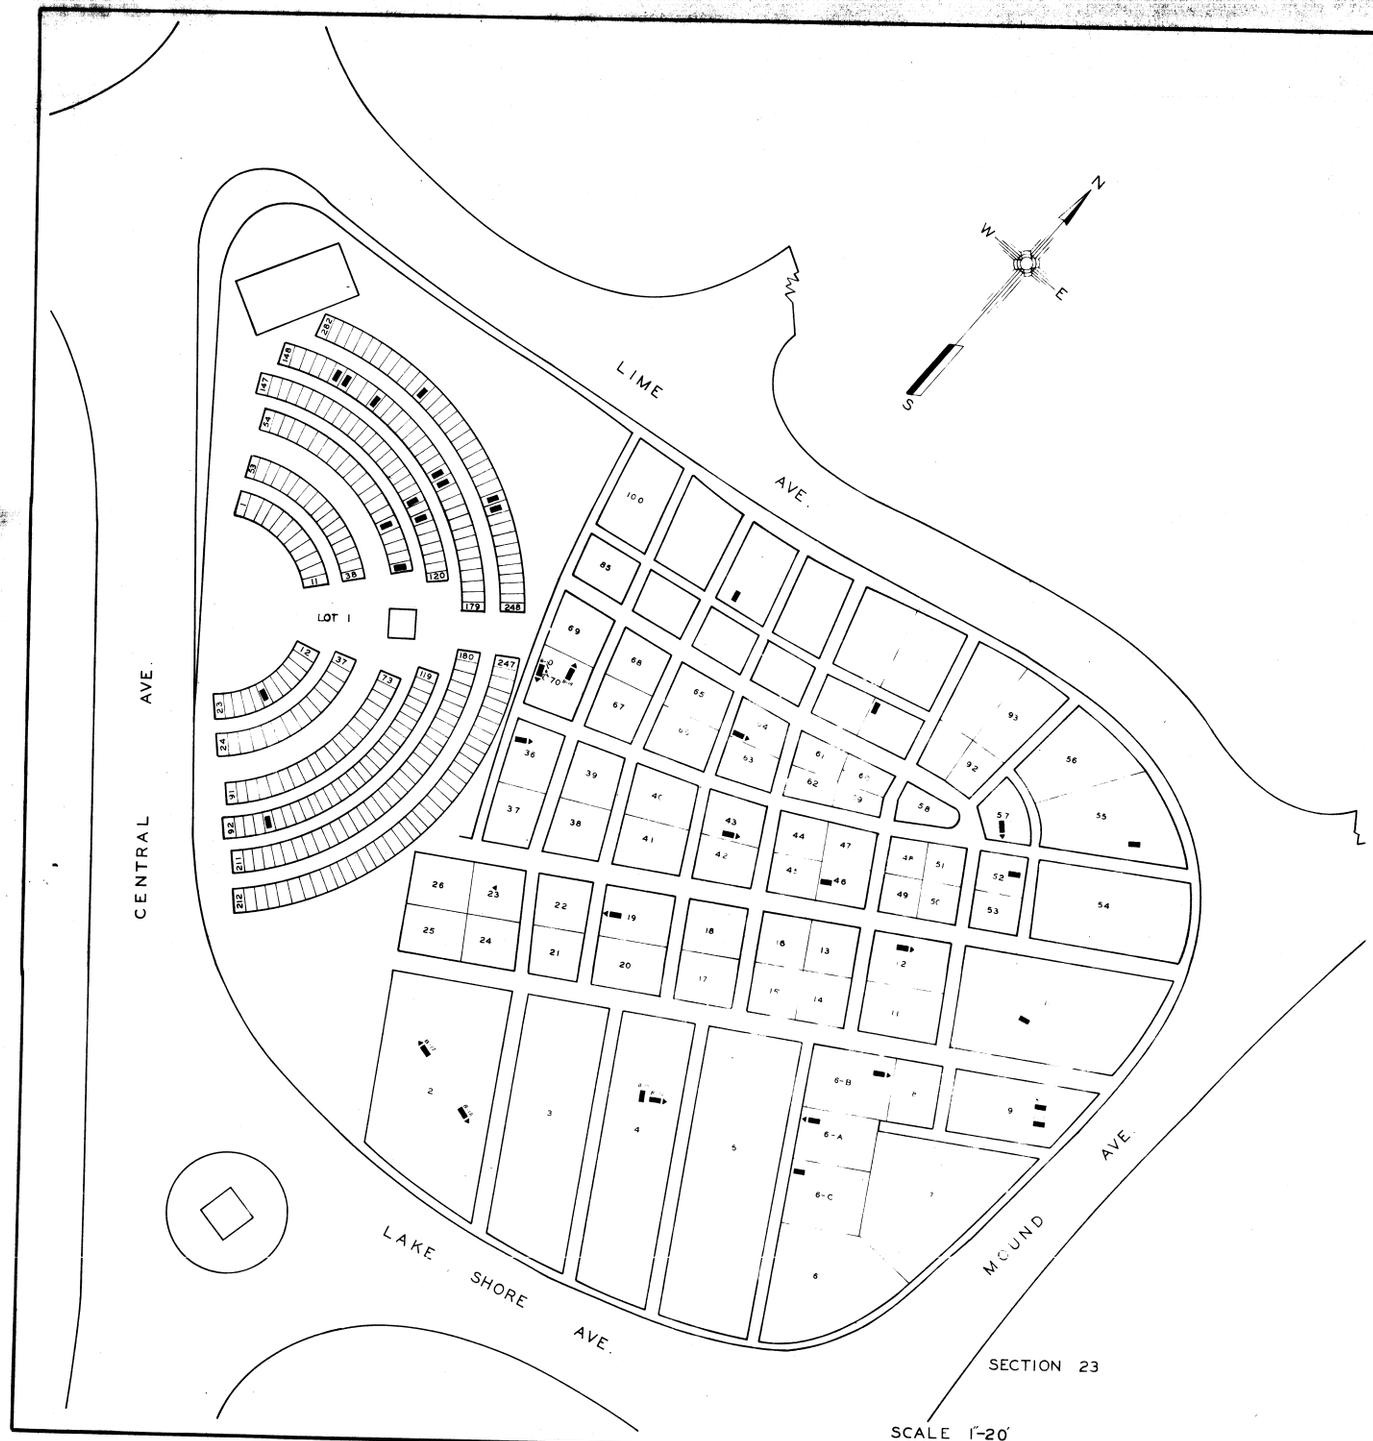

SECTION 23

LOT	GRAVE	WAR	NAME
1	167	(19)	ANDERSON CHAS. E.
1	72	(19)	BOSLEY W. K.
1	96	(19)	BRYANT JOHN W.
9	B-10	(19)	BURNETT HENRY C.
9	B- 7	(19)	BURNETT THOM.
1	B-159	(19)	BERTSCH FRED.
90	B- 4	(19)	CARY SAM. F.
12	B-13	(19)	CLOPPER EDW. N.
57	B- 3	(16)	CURD THOM. H.
10	B- 6	(31)	COOK CHAS. C.
1	B-153	(19)	DAVIS JOHN T.
70	B 16	(31)	DRAPER WALT. F.
70	B-14	(19)	DRAPER JOHN
4	B-15	(19)	ERNST CHAS.
6-C	B- 7	(19)	ERNST LOUIS J.
55	B- 5	(16)	FRAZIER JAS.
36	B-16	(19)	GAUL JOS.
64	B- 1	(1)	GOWDY JAS.
52	B- 5	(16)	HEIGHWAY A. E.
2	B-17	(19)	HOSEA LEWIS M.
2	B-18	(19)	HOSEA ROBT. H.
98	B-15	(19)	HOFFMAN MICH'L.
1	B-158	(19)	HURST THOS.
6-A	B- 7	(19)	JAMES ERNEST F.
1	154	(19)	KIRKDATRICK JOHN
1	271	(25)	KENNEDY EDW. J.
43	B- 6	(19)	LUDLOW ISRAEL
23	MEMORIAL	(19)	LANDRUM GEO. W.
4	B-12	(19)	MILLER A. F.
1	B-68	(19)	MORGAN WM. H.
1	B-126	(19)	MORRIS WM. H.
1	166	(19)	MOORE HENRY D. REV.
1	18	(19)	MOORE J. D. V.
1	128	(19)	PHELPS WM.
19	B- 5	(16)	REYNOLDS JOHN L.
46	B- 1	(19)	SYPHER DAVID
6-B	B- 5	(19)	THORP WM. J.
1	157	(19)	WELTY EDW.

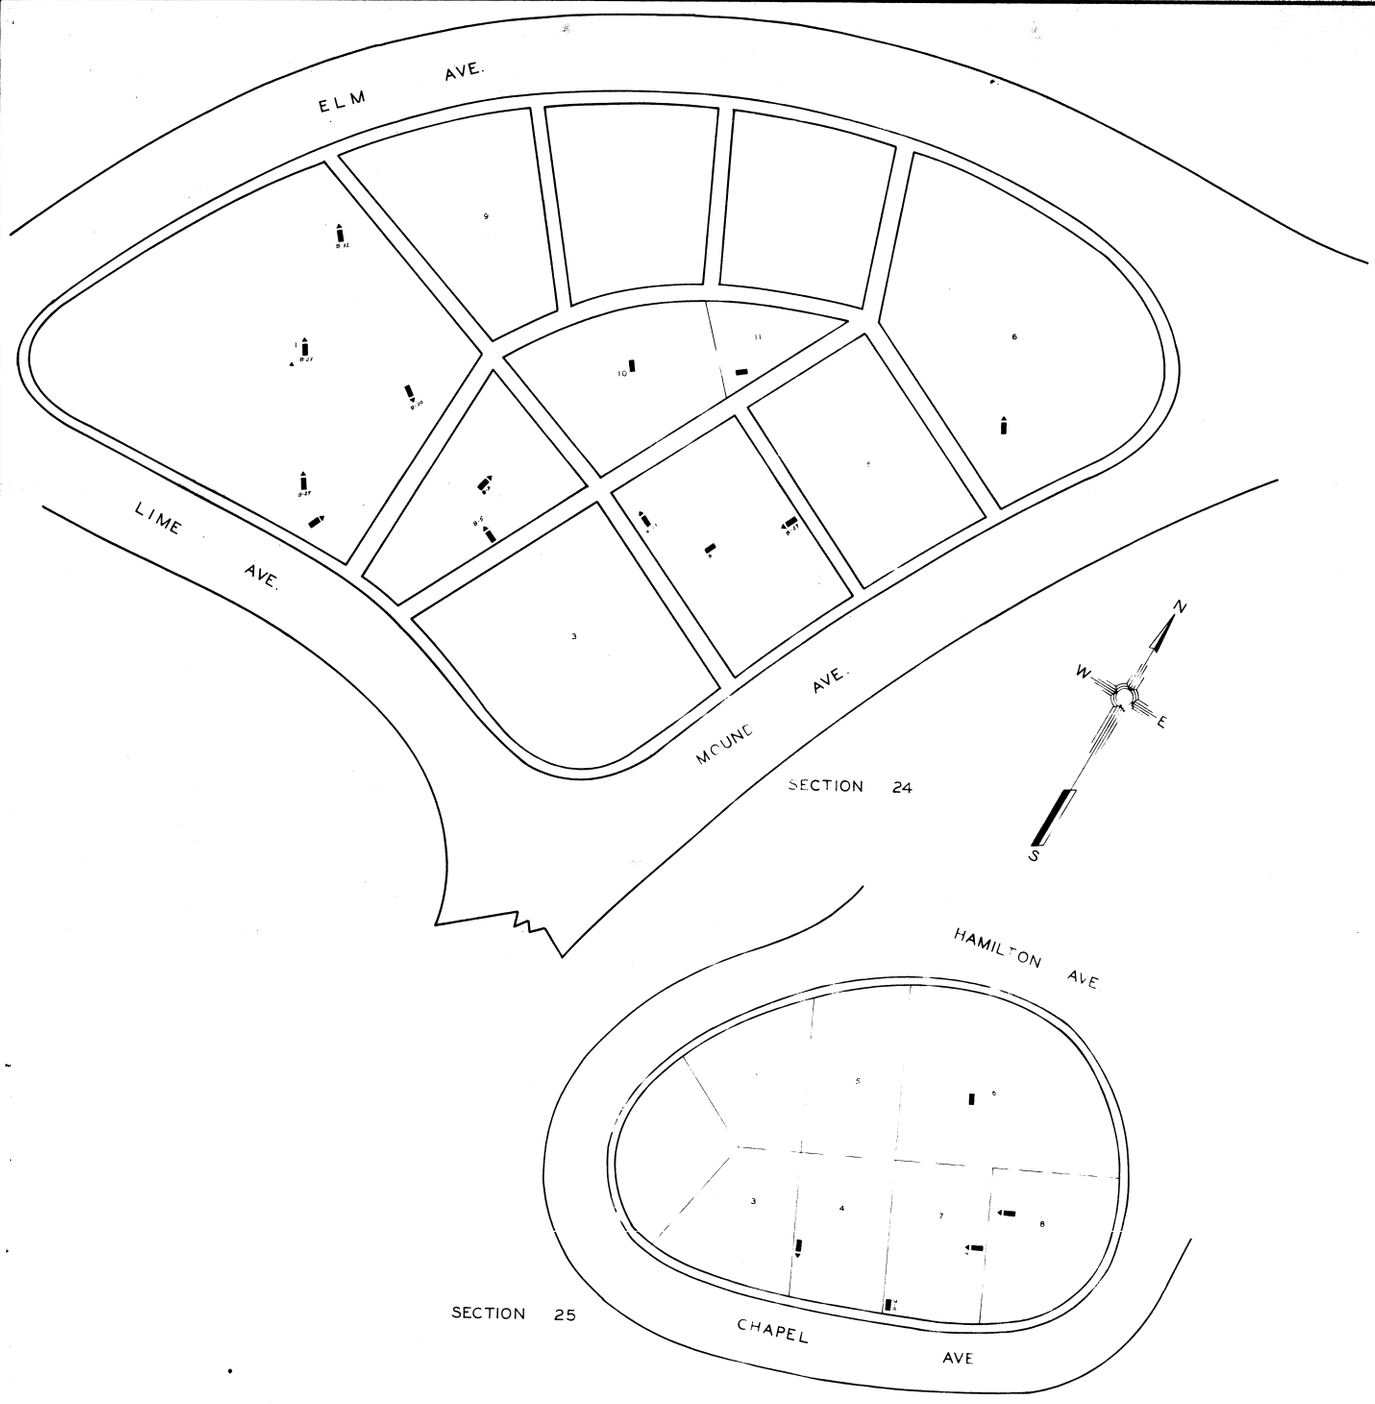

SECTION 24

LOT	GRAVE	WAR	NAME
1	32	(19)	ANDERSON EDW. L.
2	B-2	(19)	ANDERSON NICK. L.
1	30	(25)	ANDERSON ROBT. C.
1	B-23	(19)	ANDERSON WM. P.
6	B-11	(19)	ANDREWS JOS.
2	B-5	(19)	ARMSTRONG JAS. C.
1	B-25	(25)	ANDERSON LARZ
4	B-2	(19)	BROWN HENRY R.
4	B-29	(19)	BROWNE SYMMES E.
11	B-4	(19)	HOPKINS LUCIUS
1	B-11	(10)	HOWELL STEP.
10	B-1	(1)	SELLMAN JOHN
4	B-23	(19)	STOKES THOM. S
1	MEMORIAL	(19)	STETTINIUS JOHN L.

SECTION 25

LOT	GRAVE	WAR	NAME
8	B-7	(19)	BELL SAM. W.
7	B-4	(19)	FNCH DANL. W.
6	B-3	(10)	STEPHENS BLACKALL
7	B-6	(19)	STEWART CHAS. J.
4	B-10	(19)	THOMAS WM. C.

GRAVE	WAR	NAME
2399	19	ASBACH HENRY
2423	19	ARNIM FRANCIS
2099	19	BACKUS GEO. M.
3866	25	BAKER EDW. J.
3799	19	BAKER JOHN J.
4136	19	BALSER WM. H.
3016	19	BITZER JNO.
2854	19	BYRNE RICHD. R.
3883	19	BRADLEY WM. W.
3823	19	BRADY JOHN H.
3566	19	BRINER NATHANIEL
3522	19	BUETTNER GEO.
3111	19	BURGRAFF LUCAS
2323	19	BEARD WM.
4198	19	BOYCE JASPER N.
2977	19	BRACHLE JOHN
2899	33	BUTLER WALT. G
4211	19	CARNAHAN RICH.
2048	19	CAMPBELL HENRY
3594	19	CHAMBLIN JOHN W.
2173	19	CHAPMAN JAS.
3365	19	CLOUSER WM. B.
2414	19	COLLINS WM.
2775	19	COLMAR JACOB
2884	19	COPPAGE ROBT.
3709	19	COOL SAM'L. S.

GRAVE	WAR	NAME
2606	19	COTTY JOHN
3872	19	DAUGHERTY WM. F
4159	16	DAVENPORT HAMPTON
2120	19	DAV[illegible] DAVID
3567	19	DILG WM
2886	19	DITCHEN FRED.
2498	19	EBERHARDT MARTIN
2508	19	ELITZER JOHN
2595	19	ELSASSER GEO
2389	19	EVANS EVAN J
2141	19	EISENHARD CHAS.
[illegible]07	19	ETZEL CHRISTIAN
[illegible]022	19	F[illegible]RANKS [illegible]
[illegible]	19	FEL[illegible]HS GEO.
3504	19	FIELD WM H
2950	19	FISHER ROB'T M.
[illegible]054	19	FRIT[illegible] GEO.
3807	19	GAMER JAC. B
2005	19	GASSER FREDR.
2692	19	GOETZE CHAS. A
2227	19	GRANDT GEO
3877	19	GRAY FRANK
3903	19	HARRIS CHAS. M
3592	19	HAWKINS ALONZO
3588	19	HENDERSON RICH W.
2676	19	HILTON WM
3649	19	HOBBS WM C
3762	19	HOFFMAN CHAS P.
3502	19	HOFFMAN JOHN B.
3805	19	HOLLAND WM.
2199	19	HOPKINS JAS

GRAVE	WAR	NAME
2262	19	HOWARD CHAS. W.
3698	19	HAUCK WM.
2353	19	HELPMANN LEW.
3145	19	HINMAN SAM'L.
3023	19	ITSKIN HENRY
3742	19	JENKINS ISAIAH
2759	19	JOHNSON WM. L.
3309	19	JORDAN WM. A.
3825	19	JOHNSON JOHN W.
3442	19	JONES ISSAC N.
2740	19	KAUFFMAN CONRAD
3451	19	KIRBY JAS.
3554	19	KIRSCHHEINER NICK
3815	19	KNOX PRINCE A
2196	19	KLEIN MICH.
2322	19	LEEPOLE AUG.
1993	19	LAWRENCE SAM. J.
3722	19	LAUCK JOHN
2081	19	LEAKE JOS. B.
2721	19	LUTZ FREDK.
3475	19	MARSHALL GEO. T.
3665	19	MILLER ISAAC
3367	19	MILLER WM.
2239	19	MOSS GEO. W.
3451	19	MOORE GEO. B.
4506	19	McCAULEY ROB'T.
3507	19	NELSON ISAAC C.
2231	19	NICHOLAS WM.
3677	19	RORICK HENRY
3455	19	ROGERS WM. C.
3517	19	PARKER MANNING G.
3138	19	PISTNER LEOPOLD
3690	19	POTTER BENJ. F.
3694	19	PEAKE FRANK M.
2064	19	PFEIFFER GEO.
3549	19	REISING JOHN
2482	19	RASP JAC.
2976	19	RAIRDON THOM.
2063	19	RAMSHETTER AL.
2401	19	ROWLEY JAS. H.
3561	19	RUMMELS JOHN W.
4196	19	ROBINSON ANDY
2215	19	REIDEL FRANK

GRAVE	WAR	NAME
3137	19	SHERRILL JNO. J.
3222	19	SHALLER JOS.
2475	19	SCHNEIDER PHIL.
2888	19	SCHWIND CHRISTIAN
3262	19	SCOTT THOM. H.
3600	19	SEIBERT GOTLIEB
2457	19	SHAW GEO. W.
3706	19	SHANNON JOS
3414	19	SIMCOE WM. T.
3279	19	SCOTT J. M.
3574	19	SMITH HENRY
2641	19	SMITH ROBT. B.
2006	19	STEFFEE JOS.
3895	19	STONE CHAS.
2615	19	STORY GEO. L.
3743	19	STUBER JOHN
2237	19	SWANEY FRANC. M.
4204	19	SMITH CLEM'T. D.
1980	19	SPERBER EDW.
2025	19	SUTER JULIUS
2657	25	STRATTON ALB.
2879	19	TAYLOR JOS.
2849	19	TATE GIBSON
2275	19	THOMPSON JOHN
3476	19	THORPE CHAS. A.
3912	25	VALENTINER ART. B.
3304	19	VOEGELI JACOB
2034	19	WAGNER JOHN
2324	19	WALKER ASA
2820	19	WALTER JOHN
2139	19	WEASNER EMIL
3527	19	WETZEL HENRY
3245	19	WOLF JACOB
2724	19	WRATTON WM. H.
3761	19	WILSON JOHN M.
3043	19	WEBBER PHIL. D.

WESTERN AVE.

CHILDRENS GRAVES

N E W S

SECTION 26
SCALE 1-20

SPRING GROVE
PAGE 477

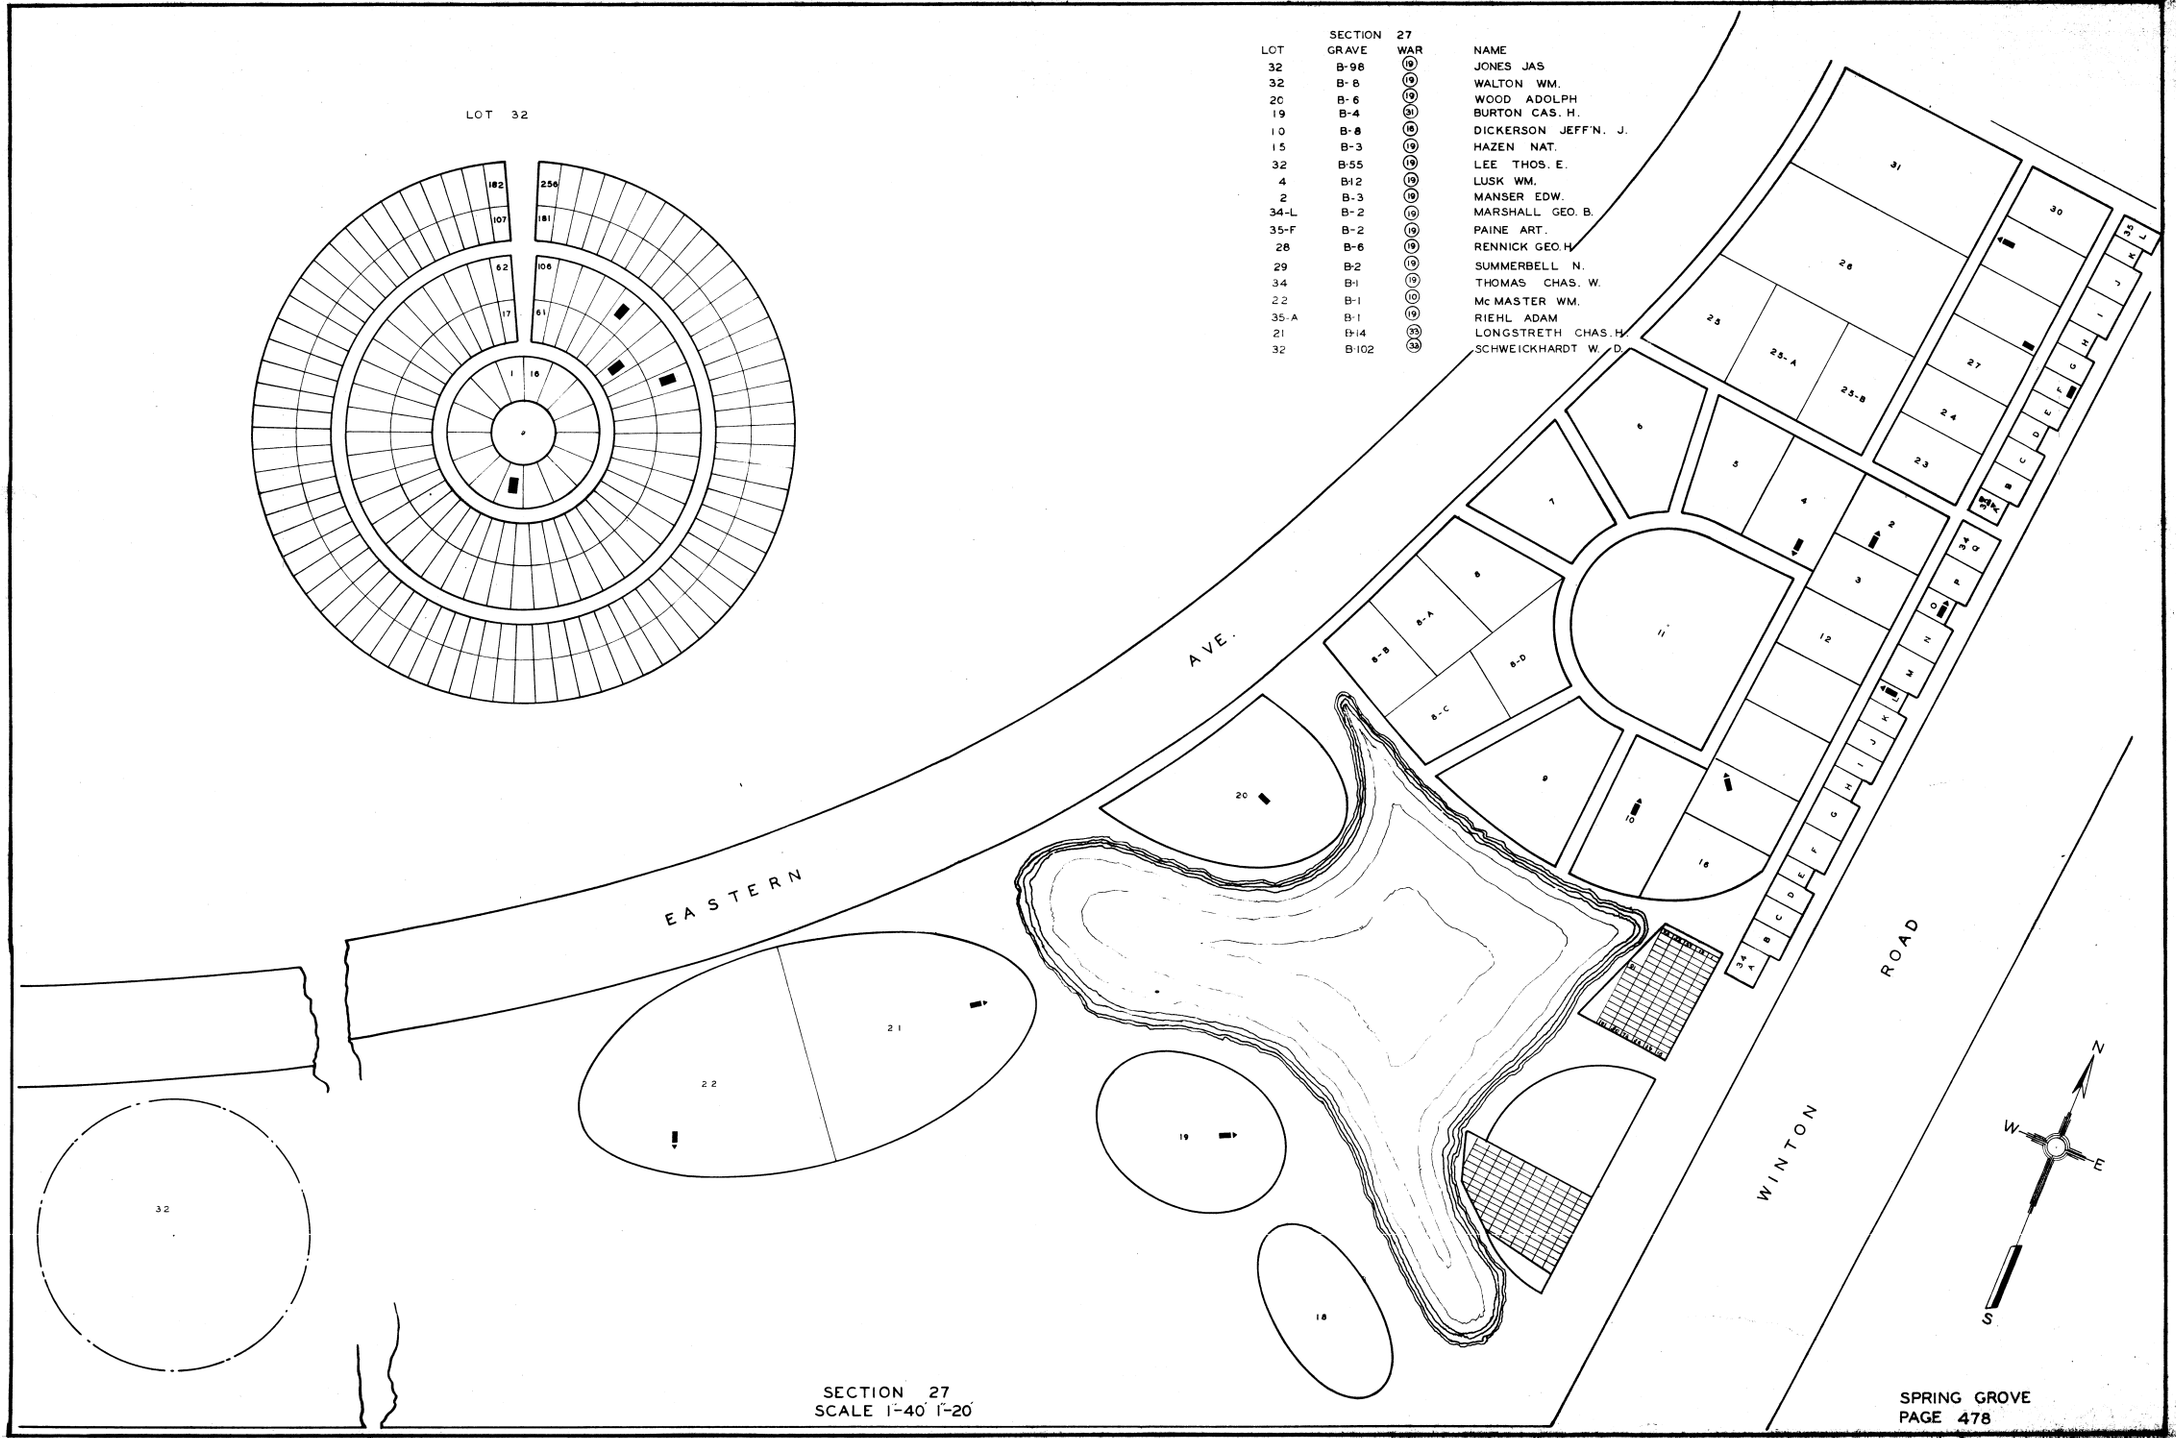

SECTION 27

LOT	GRAVE	WAR	NAME
32	B-98	19	JONES JAS
32	B-8	19	WALTON WM.
20	B-6	19	WOOD ADOLPH
19	B-4	31	BURTON CAS. H.
10	B-8	18	DICKERSON JEFF'N. J.
15	B-3	19	HAZEN NAT.
32	B-55	19	LEE THOS. E.
4	B-12	19	LUSK WM.
2	B-3	19	MANSER EDW.
34-L	B-2	19	MARSHALL GEO. B.
35-F	B-2	19	PAINE ART.
28	B-6	19	RENNICK GEO. H.
29	B-2	19	SUMMERBELL N.
34	B-1	19	THOMAS CHAS. W.
22	B-1	10	Mc MASTER WM.
35-A	B-1	19	RIEHL ADAM
21	B-14	33	LONGSTRETH CHAS. H.
32	B-102	33	SCHWEICKHARDT W. D.

SECTION 27
SCALE 1-40' 1-20'

SPRING GROVE
PAGE 478

LOT	GRAVE	WAR	NAME
96	B-6	(19)	ANSPACH JAS.
96	B-3	(19)	BAILEY ROG.
95	B-5	(19)	BIRD NORMAN
19	B-5	(19)	BOYD NELSON
20	B-1	(19)	BROWN ETHAN
41	B-4	(25)	BRUENING WM.
29	B34	(19)	CALDWELL WM.
65	B-4	(19)	CHESTER SAM.
29	B-2	(19)	CORRY THOM.
108-H	B-1	(25)	CRAWFORD WM.
109-F	B-4	(31)	DARLING WALT.
109-G	B-2	(19)	DEVEREAUX A. F.
39	B-8	(19)	FISHER JOHN
108-G	B-1	(19)	FOWLER WM. P
21	B-1	(19)	GRIFFITH DAV. H.
63	B-3	(19)	HAWKINS WM.
108-K	B-1	(19)	HIRST AL.
101	B-4	(19)	HOOKER JAS. J.
74	B-6	(16)	HOWARD EZEKIAL A.
2	B-9	(19)	HUDSON WM. C.
83	B-3	(19)	JACK SAM.
65	B-5	(19)	KORN J. L.
88	B-7	(19)	LEWIS JOHN E.
72	B-7	(19)	LEWIS THOM.
107-A	B-2	(19)	McAVOY ALEX. B.
62	B-8	(19)	MACKEY JOS.
34	B-6	(19)	McGREW HENRY
12	B-5	(25)	MAGUIRE JOS.
30	B-10	(19)	MARTIN PETER
68	B-3	(19)	MONROE HORACE
102	B-6	(19)	MORRIS JOHN
103-C	B-2	(19)	MOORE CHAS. W.
40	B-4	(19)	PERKING JOHN
4	B-2	(19)	PFAU JAC. JR.
3	B-3	(31)	ROSSITER ART. R.
62	B-9	(19)	SECHLER THOM.
26	B-3	(19)	SEIDENSTICKER GUENTHER
8	B-6	(19)	ST JOHN AL.
108-I	B-2	(19)	SULLIVAN THOS.
97	B-2	(19)	TICE JAS.
71	B-14	(19)	UMMETHUM GERRARD W.
106-F	B-1	(19)	VANOSDOL ROBT. J.
40	B-6	(19)	WEBB JOS. T.
3	B-6	(19)	WEITZEL GODFREY
97	B-7	(19)	YOUNG JAS.

LOT	GRAVE	WAR	NAME
14	B-4	(19)	BUNTEN CLINTON
90	" 2	(19)	GOOD ANDREW
42	" 13	(19)	HEISSEL DAN'L.
53	" 11	(19)	HUKILL MONTRAVILLE
78-A	" 1	(19)	MONAGHAN JAS.
74	" 21	(31)	RAWLES WILBER R
85	5	(19)	RICHARDS GEO. W.
6	2	(19)	STIFEL JOHN
105-B	1	(19)	DOSS [illegible]
108-J	2	(19)	McMILLEN GEO. P.
75	13	(25)	PETERSON CARL G.
107-N	3	(25)	BROSE CHAS. W.

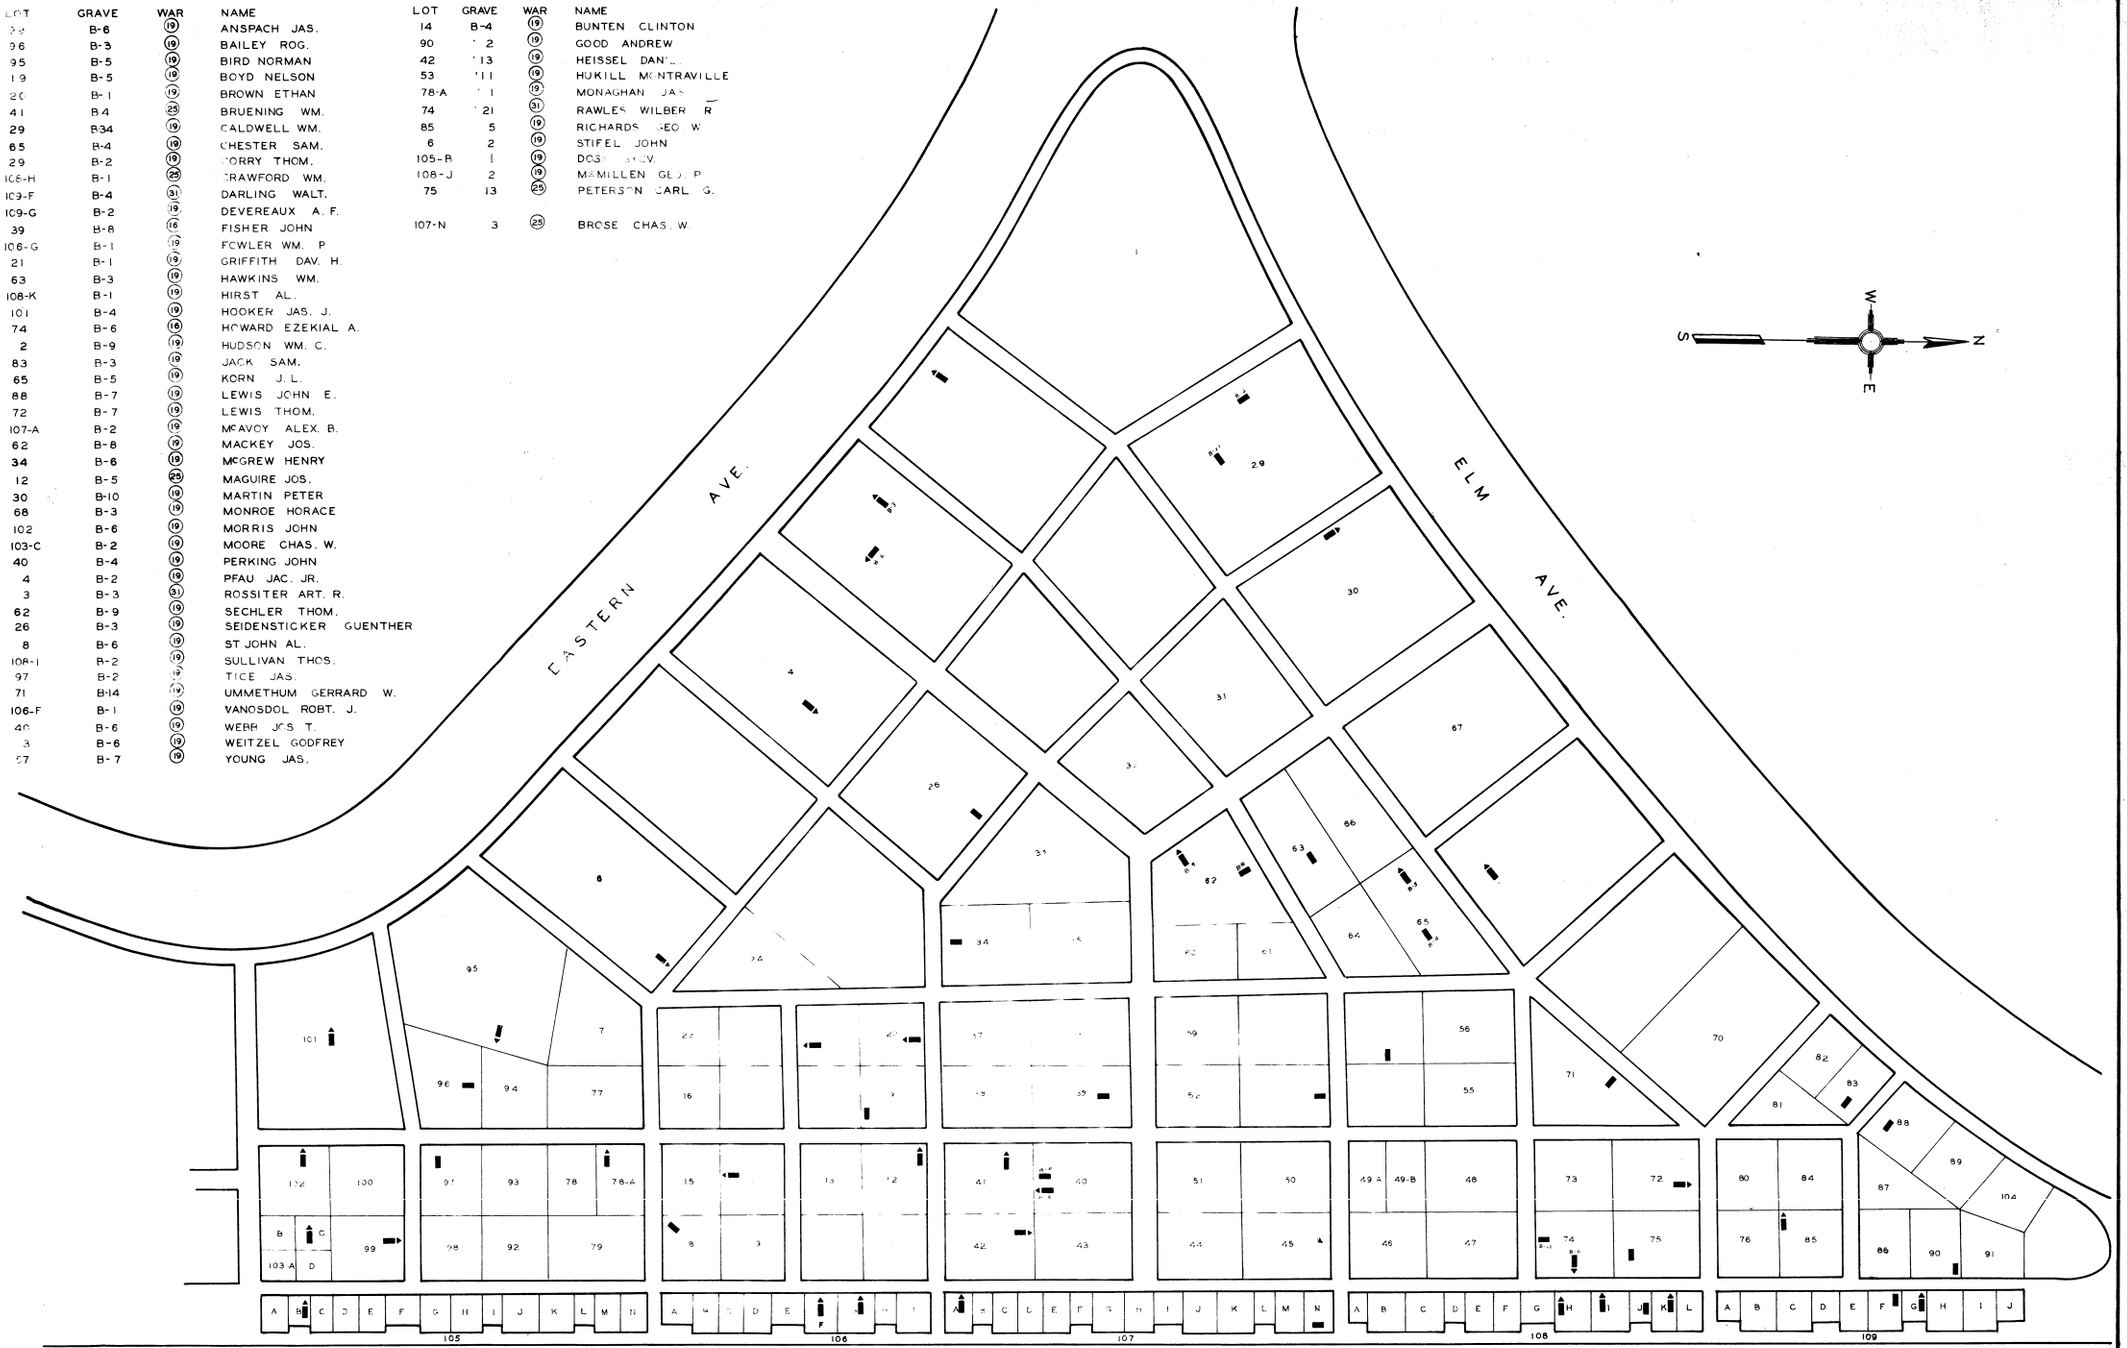

WINTON ROAD

SECTION 28
SCALE 1-20

SPRING GROVE
PAGE 479

LOT	GRAVE	WAR	NAME
61	B-1	(19)	ALLEN JOHN
59	B-7	(19)	ANDERSON JOHN
59	B-6	(19)	ANDERSON MARMADUKE
59	B-9	(19)	ANDERSON PEMBROSE S.
60	B31	(19)	ATKINS RICH.
94	B10	(19)	AVERY ORLANDO
52	B-3	(19)	BLACK JAS.
69	B15	(19)	BURGESS THOM.
69	B-3	(19)	BURGESS WM.
80	B-4	(19)	CALHOUN FREDR. S.
37	B32	(19)	CARSTENS GEO. W.
84	B15	(19)	CHARD THOM. J.
84	B-16	(23)	CHARD THOM. JR.
38	B-5	(19)	CLARK AL.

LOT	GRAVE	WAR	NAME
91	B-13	(19)	L'HOMMIDIEV STEP.
91	B-5	(19)	L'HOMMIDIEV T.
69	B-2	(15)	PARKER JOHN
70	B-1	(19)	PERRY DAV.
39	B-7	(19)	RESOR WM. JR.
84	B-6	(19)	ROBINSON LAW.
84	B-1	(19)	ROBINSON NIC.
50	B-14	(19)	BERTRAM CHAS.

LOT	GRAVE	WAR	NAME
95	B-11	(19)	BROWN AARON M.
42	B-12	(C)	COPPIN JOS.
89	B-18	(19)	GANO CHAS. L.
62	B-5	(19)	HOBLITZELL HENRY
54	B-12	(21)	PISTER JOHN C.
40	B-5	(19)	WEBB JAS. D.
94	B-8	(24)	CHARD DAN'L H.
94	B-16	(33)	COCHRAN PERCY M.
89	B-2	(28)	GANO WALT. W.

LOT	GRAVE	WAR	NAME
62	B-10	(19)	CUNNINGHAM GEO.
79	B-4	(19)(21)	DAVIS CHAS.
42	B-6	(19)(21)	DAVIS JOHN H.
78	B-8	(19)(19)	EVANS CHAS.
90	B-18	(19)(19)	FOSDICK WOOD
49	B-11	(19)(19)	FRANK CHAS. J.
78	B-18	(19)(19)	HILL ALEX.
83	B-15	(19)(19)	JACKSON JAS.
89	B-21	(19)	LEMON JAS.

HAMILTON AVE.

OAK AVE.

WINTON AVE.

WINTON ROAD

ELM AVE

N

W E

S

SECTION 29
SCALE 1"-20'

SPRING GROVE
PAGE 480

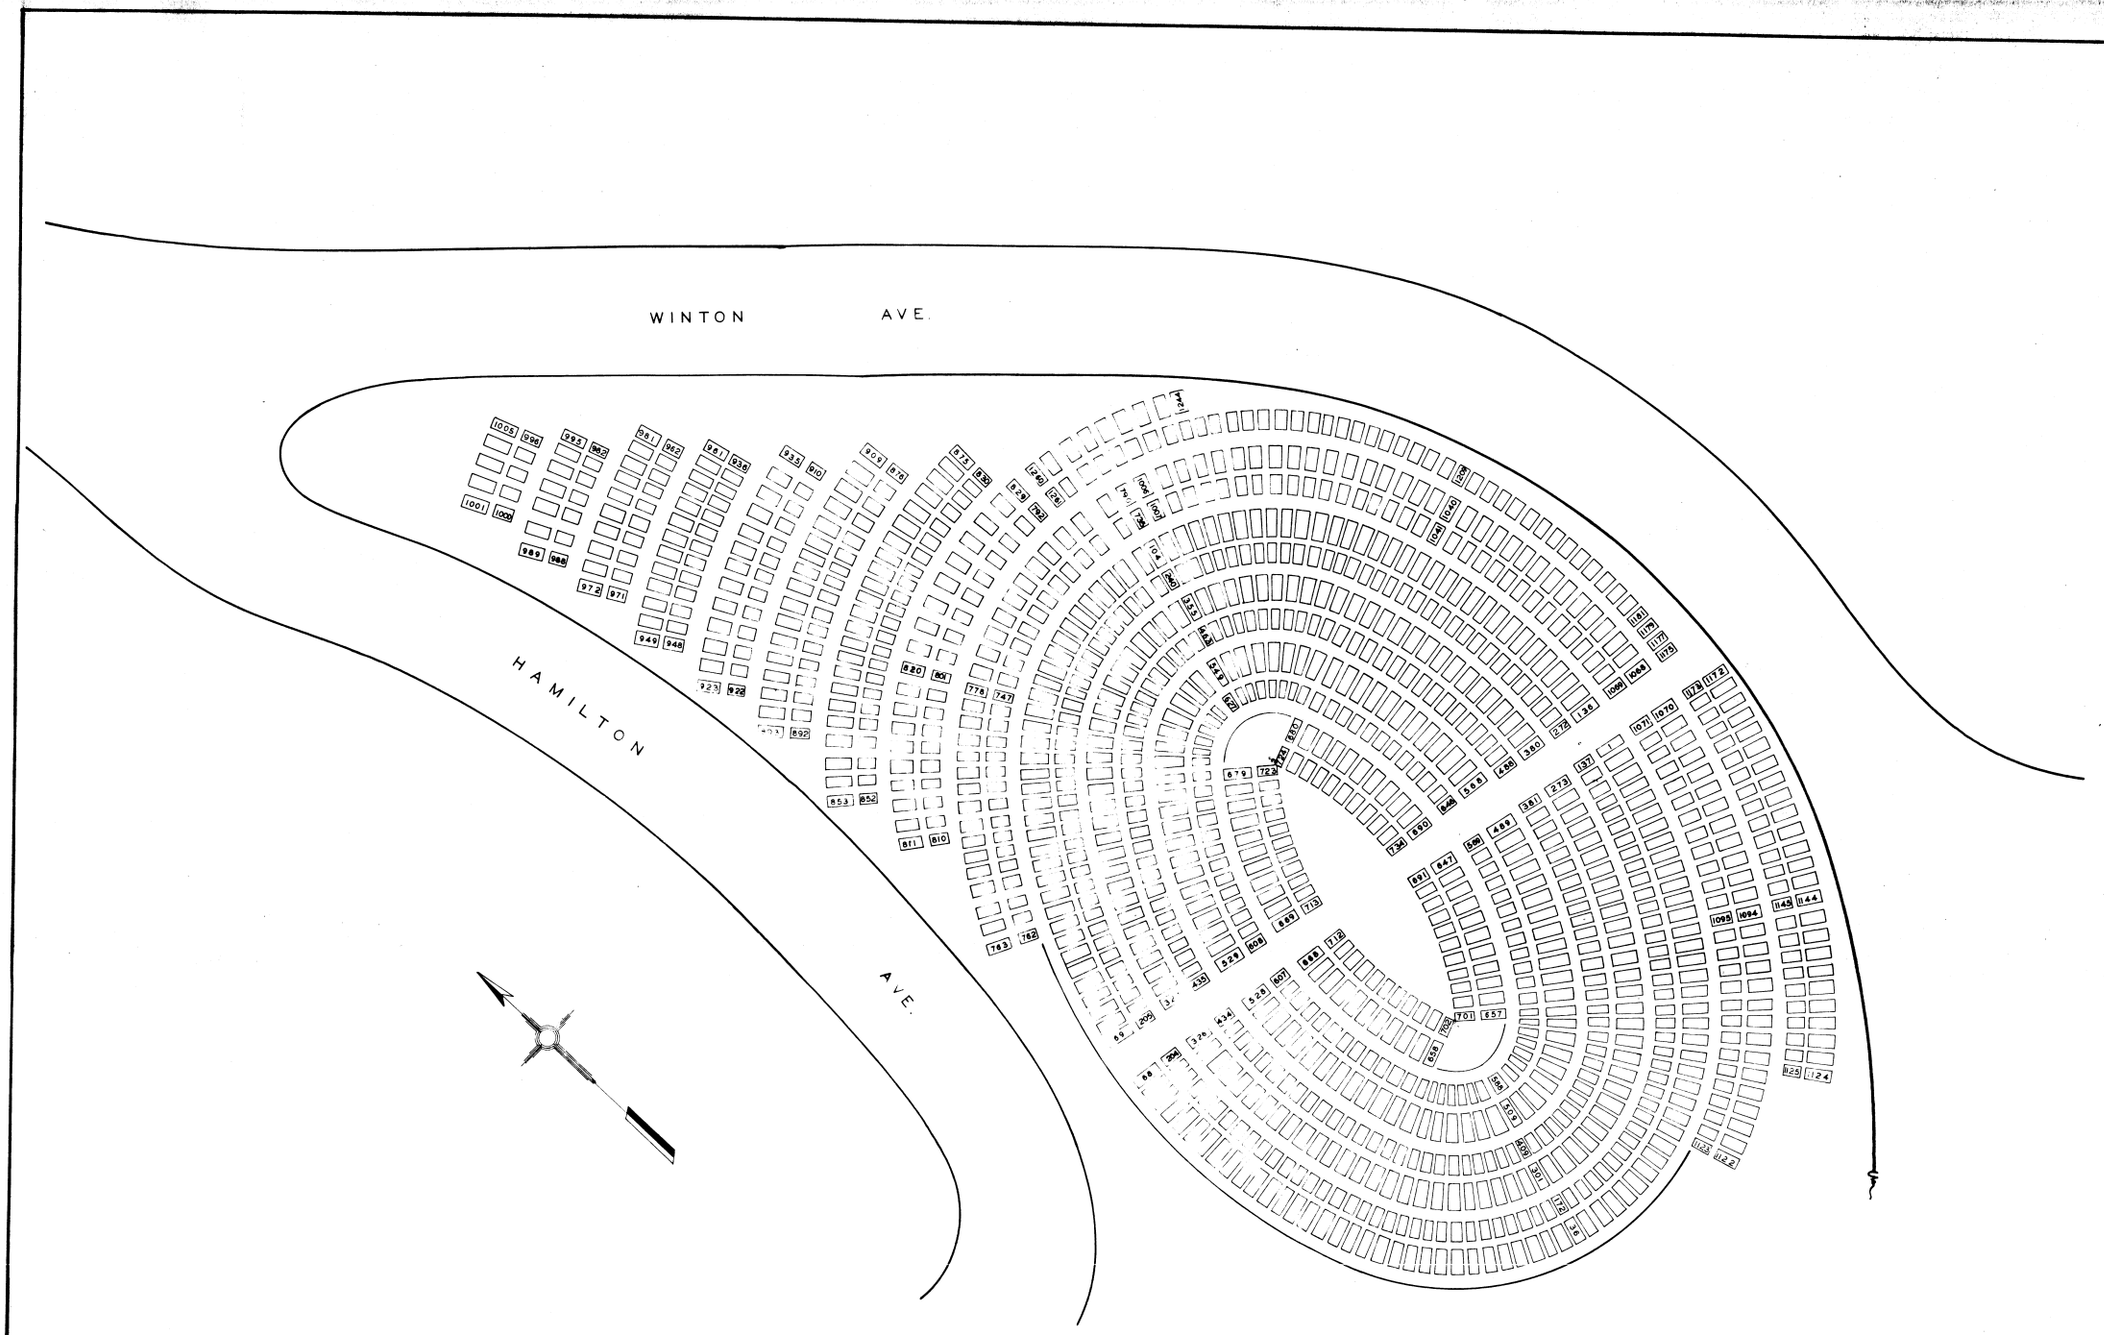

SECTION 29 LOT 74
SCALE 1"=10'

SPRING GROVE
PAGE 481

SECTION 30

LOT	GRAVE	WAR	NAME
34	B 3	(19)	ADAMS JOS. S.
43	B12	(19)	BECKER HENRY G.
36	B 7	(19)	BOWDLE D.D.
146	B 6	(19)	BOYD WM.
106	B16	(19)	BROSSART CHAS.
148	B 6	(19)	CARTER JAS. E.
92	B 5	(19)	CLEMENTS THOMAS A.
33	B 3	(19)	COX JOHN J.
172	B10	(19)	DICKINSON WM. S.
24	B 9	(19)	DICKSON CHARLES
67	B10	(19)	DYER PERCY B.S.
137	B11	(19)	DURBECK WM. G.
148	B 7	(19)	EDWARDS HARLAN A.
95	B 5	(19)	EVANS STEPHEN D.
116	B 5	(19)	FISHER GEO. W.
116	B 7	(19)	FISHER WM.
171	B 7	(21)	GAITHER ALFRED
155	B 2	(19)	GHOLSON WM. Y.
178	B 2	(19)	HALL CHESTER B.
14	B 1	(19)	HALL JOHN P.
124	B 9	(19)	HARDEN JOSHUUA
A	B 2	(19)	HOOKER JOSEPH
174	B12	(19)	HORTON JAS.C.
56	B 4	(19)	JEANES THOMAS
136	B 6	(19)	JONES JAS.M.
85	B 4	(19)	KING JOHN R
32	B 9	(19)	KOUNTZ GEO.
32	B 8	(20)	KOUNTZ THEODORE J.
180	B 3	(19)	LEVY WM. H.
28	B 3	(19)	LORD AMMI W.
102	B 5	(19)	MARSH RICHARD
84	B14	(19)	McFARLAND JOHN F.

LOT	GRAVE	WAR	NAME
49	B 9	(19)	REYNOLDS WM. T.
59	B 3	(19)	SHAW JAS.
139	B 3	(19)	SHEPHERD JOS.
138	B 9	(19)	SKARDON WM. S.
154	B 3	(19)	SMITH WM. H.
61	B 5	(19)	STEVENS JAS. W
26	B 2	(19)	TALBOTT CHAS A.
16	B 8	(19)	WILLIAMS JAS. C.
125	B-26	(25)	SCHAEFER CHAS. P.



LOT	GRAVE	WAR	NAME
92	B 2	(19)	MEEDS JOHN D.
133	B14	(19)	MEYER GEO.
94	9	(19)	MILLER GEO.
94	B 4	(19)	MILLER THEODORE
91	B 7	(19)	MOOR AUGUST
44	B 7	(19)	PHILLIPS HENRY
64	B 6	(19)	QUINTON EDWARD L.
20	B 5	(19)	REID JOHN A.
20	B 6	(19)	REID JAS. E.
40	B11	(19)	REYNOLDS JAS. K.

LOT	GRAVE	WAR	NAME
7	B-4	(19)	HEZLIP JOHN K.
126	B-22	(25)	NORRIS SAM'L. C.
7	B-2	(19)	TOLAND C.H.
98	B 11	(19)	FEHRENBATCH JOHN
91	B 12	(19)	WEITZEL LEWIS.
15	B 6	(19)	ESTE WM. M.

LOT	GRAVE	WAR	NAME
43	B 16	(19)	BECKER JOHN G.
120	B 4	(19)	BURROWS JOS H.
84	B 9	(19)	CAINE ALB H.
62	B 7	(19)	EVELETH ISAAC N.
75	B	(19)	FELT FRANKLIN W
24	B 16	(19)	HARDIN JAS W.
98	B 7	(19)	KISSICK JAS.
147	B 12	(19)	MOORHEAD WM
21	B 7	(19)	OBERMEN FREDK W
57	B 12	(19)	PFIRMAN ANDY
127	B 7	(19)	RICKEY ALF
42	B 6	(19)	WEBB JOHN

SECTION - 30
SCALE 1-20

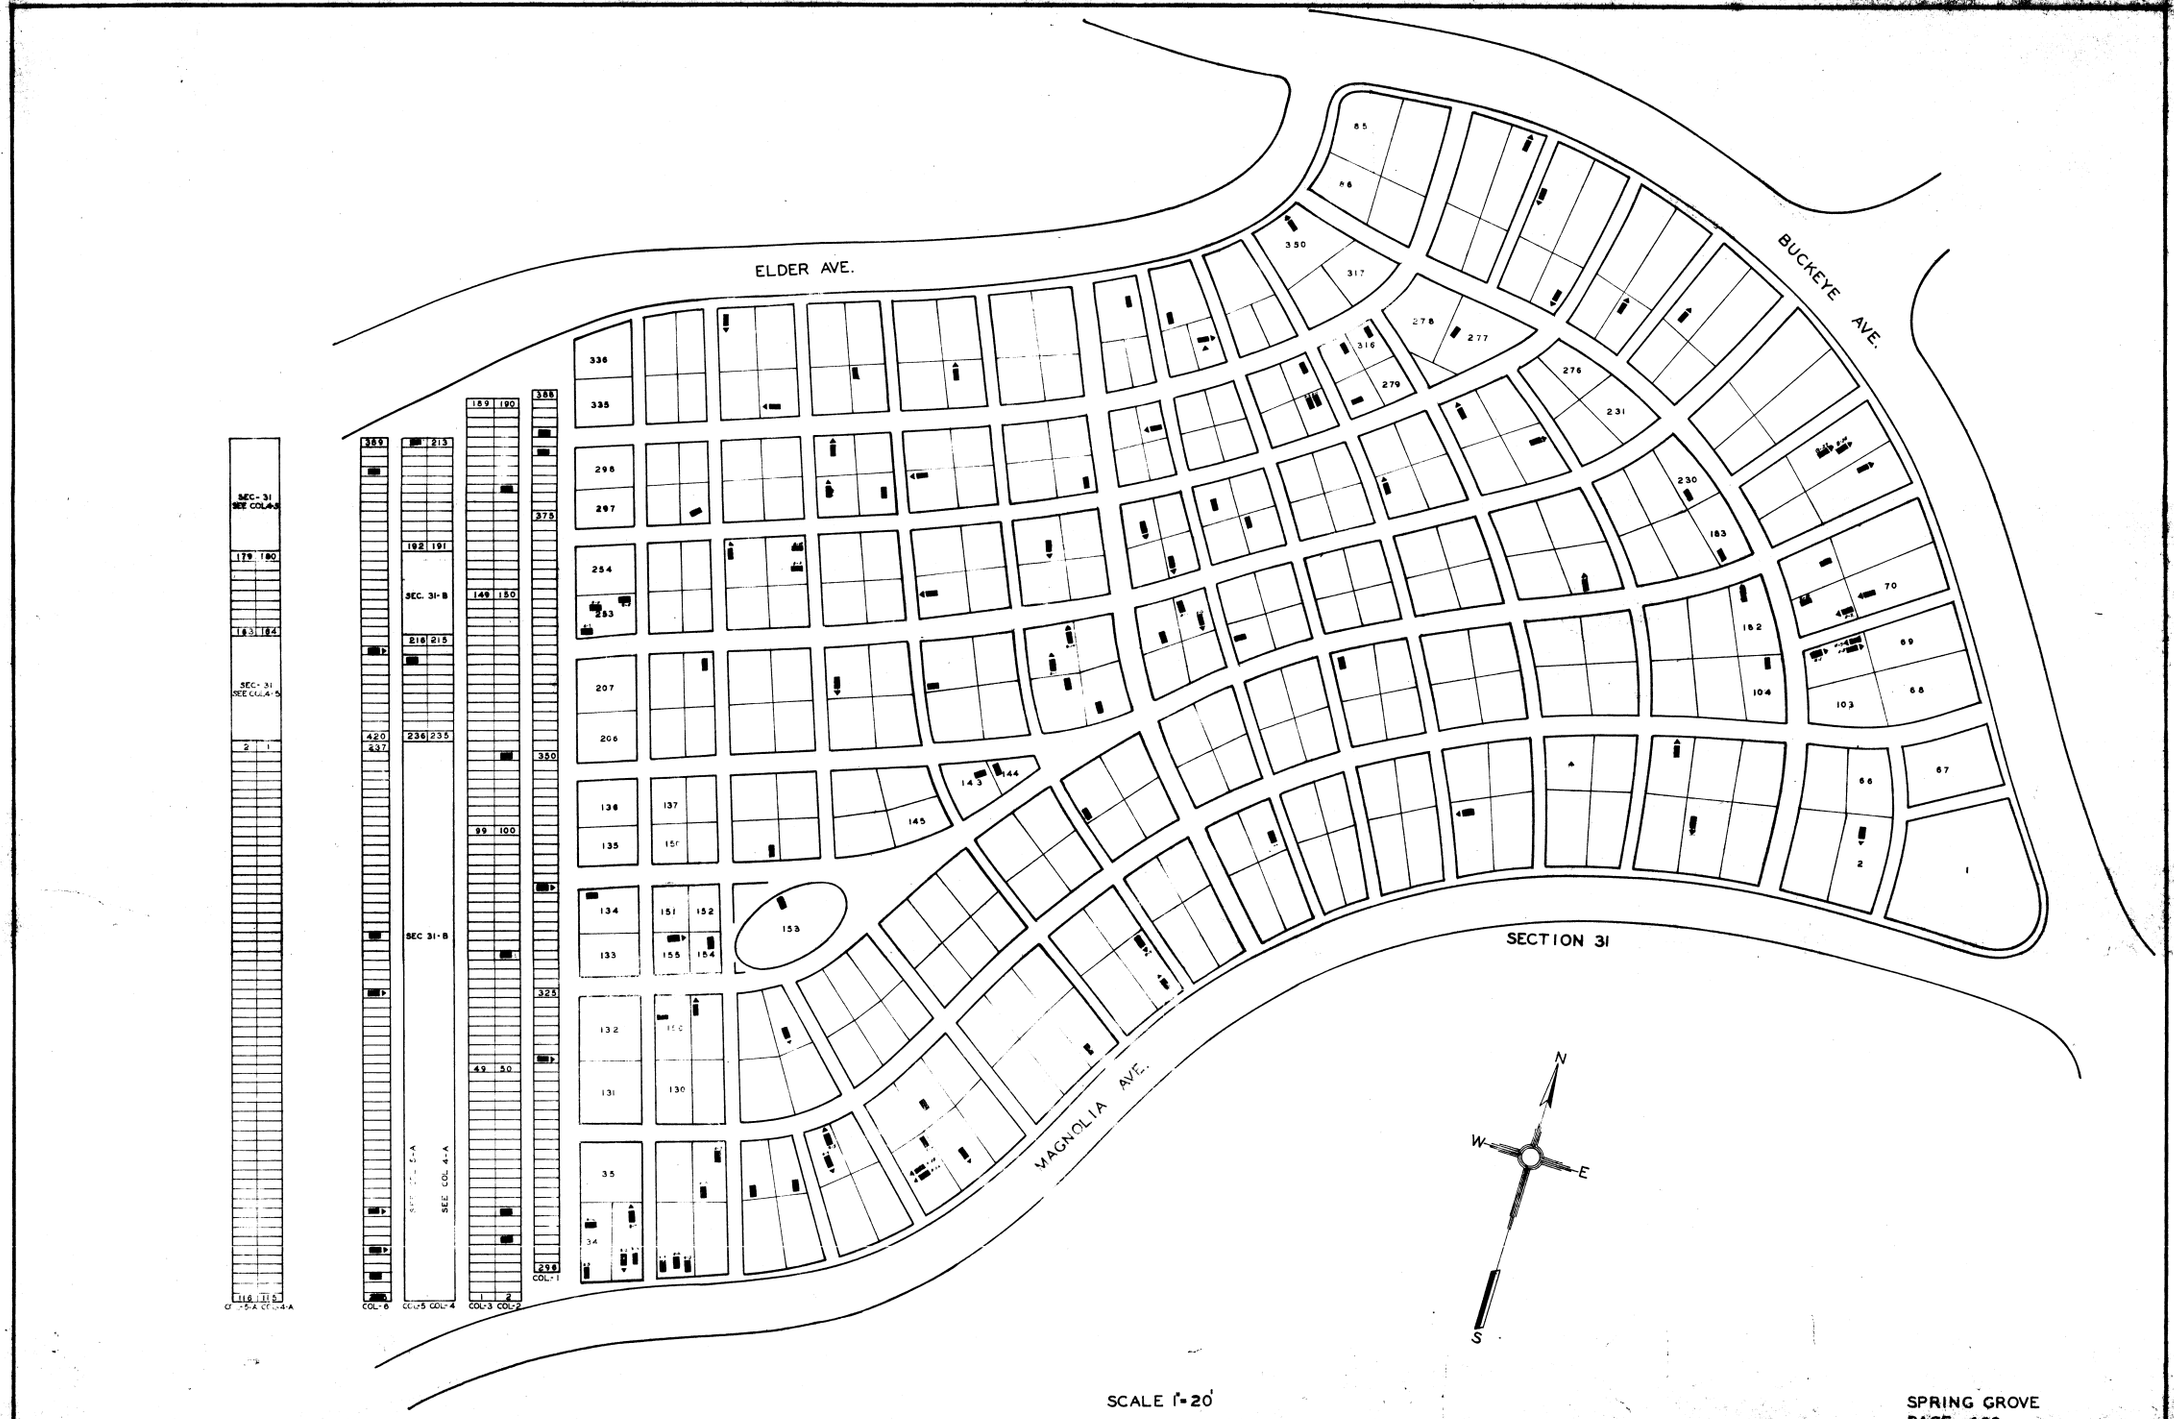

SCALE 1"=20'

SPRING GROVE
PAGE 483

SECTION 31

LOT	GRAVE	WAR	NAME
	B 7	(19)	ALLEN DAVID P.
	B 7	(19)	ANDERSON CHAS. R
102	B 9	(19)	ARAND FRANK F.
	B13	(19)	BANKHARDT GEO. C.
	B24	(19)	BANKHARDT VALENTINE
62	B 8	(19)	BAUER GEO. A.
77	B 6	(19)	BEAUCHAMP H. DR.
102	B 3	(19)	BECHT JOHN C.
	116	(19)	BEIHART GEO.
263	B 6	(19)	BELL ROBERT R.
73	B10	(19)	BERNHARD JOHN P.
	172	(19)	BOEHRINGER CHAS. F.
	295	(19)	BUMILLER THEODORE
146	B 4	(19)	BOTTLER PHILLIP
316	B 2	(19)	BRICKLEY ROBERT H.
331	B 8	(19)	BURNETT JOHN
156	B 1	(10)	BAILEY BRAZILLA
26	B16	(19)	BIEDINGER PETER JR.
26	B18	(19)	BIEDINGER PETER SR.
186	B 3	(16)	BORN JACOB
291	B 4	(19)	CAHILL JAS. W.
218	B 5	(19)	CALDWELL ANTHONY
236	B 1	(19)	CARTER ISAAC J.
43	B 2	(19)	CONNER OLIVER E.
258	B 3	(19)	COOK JOHN B.
32	B 3	(19)	CRAIG JOHN R.
32	B 2	(19)	CRAIG JAS. G.
32	B 4	(19)	CRAIG THOMAS
258	B 10	(19)	COOK THOS.
		(19)	
		(19)	
100	B 4	(19)	DAY JAS. T.
193	B13	(19)	DEARWATER JAS. B
253	B 5	(19)	DEPINAL WM.
72	B29	(19)	DHONAN JACOB
157	B 3	(19)	DOEBELE JOHN
196	B 6	(19)	EICHELBERGER JOSEPH
93	B 4	(1)	ELLIOTT ROBERT
253	B 7	(19)	ELLSTON WM.H.
104	B 5	(19)	ENSLEN ADOLPH
	411	(19)	FAIRCHILD CHAS.
153	B 2	(19)	FLOYD THOM E.
290	B 5	(9)	FROHMANN CHRIST H.
339	B14	(19)	FUCHS FREDK.
329	B 2	(19)	FIELDERS CHAS.
72	B28	(19)	FISHER G.
230	B 5	(19)	GAVIN DAVID R.
159	B 5	(19)	GREGG JOHN T.
287	B 5	(19)	GROP JOHN
292	B4	(24)	GODELMAN HENRY
239	6	(19)	HAMILTON ELI. F.
39	B 6	(19)	HERRON ALONZO
148	B 9	(19)	HOFFMAN JACOB M.
	263	(9)	HOLLAND JOHN
60		(19)	HUBER GEO.
310	B 1	(19)	JENKINS BARTHOLONEW
37	B 3	(19)	KAY RICHARD M.
37	B 4	(19)	KAY WM.
40	B 7	(19)	KING JOHN D
219	B 3	(19)	KENNEDY JAS.
40	B 3	(10)	KING COURTLAN W.
134	B 9	(19)	KLEINSCHMIDT CHRISTIAN
2	B14	(19)	KNEEDEE FREDK A
33	B 2	(19)	KREYENBROOK J. C.
219	B 6	(19)	KELLEY SAML B
168	B 12	(19)	KIEHBORTH PHIL
257	B 6	(19)	LEE SAML M
102	B 1	(19)	LEIST GEO A
155	B 7	(19)	LICHTENTHALER FREDERICK
314	B 4	(19)	LIND ROBT J.
281	B 1	(19)	LONG JOS.
70	B13	(19)	LUDWIG HENRY
281	B 2	(16)(19)	LONG ALEXANDER
197	B 6	(19)	MARTIN RUFUS L.
321	B 3	(19)	MATTHEWS JAS.
348	B 1	(19)	McDOWELL WM J
	20	(19)	McGREW HENRY
53	B 3	(19)	McKEAG ROBT
266	B 3	(19)	McLAUGHLIN THOMAS B.
34	B 4	(19)	McMULLEN ISAAC
216	B10	(19)	MILES GEO.
350	B 7	(19)	MOHLEHOFF JOHN A.
182	B 4	(19)	McREYNOLDS WM H
	318	(19)	MEYER JOHN
321		(19)	MATTHEWS ALEX
34		(3)	McMULLEN ALB.
267	B 5	(19)	MORTON FRANK E.
5	B 3	(19)	NICKERT JACOB
303	B 4	(19)	PARKER JOHN H
253	B 11	(19)	PEABODY JAS H
33	B 7	(19)	PHILLIPS JOHN T
	14	(19)	QUINN JOHN
233	B 7	(19)	RADER ROBT.
175	B 1	(16)	REYNOLDS WM.
19	B 7	(21)	RICHARDS JAMIE W
91	B 2	(19)	RILEY CHAS. H.
315	B 5	(19)	RILEY JOHN T.
	384	(19)	RILEY MICHAEL B.
209	B 3	(19)	ROBERTS ISAAC
214	B-4	(13)	SCHAREGGE LEWIS
183	B 4	(19)	SCHOENBEIN ADOLPH
212	B 9	(19)	SCHMIDT JOHN A.
	220	(19)	SCHUMACHER GUSTAVE
154	B 8	(9)	SENNETT ALBERT W
	392	(19)	SIMPSON JOHN A
280	B 5	(9)	SNYDER JOHN
246	B 3	(19)	STEVENS [illegible] MN F
	382	(19)	SUTTON JOHN
81	B 3	(10)	SLAYBROOK ABEL
21	B 2	(19)	THEIS JACOB
82	B17	(19)	THOMAS WM
33	B 6	(19)	TWIFORT CHAS E
101	B 8	(21)	VANMATRE HAROLD
101	B 7	(19)	VANMATRE HENRY
	286	(19)	VANTRESS THOS.
327	B 8	(19)	WAXLER GEO.
	293	(19)	WAY WM B
143	B 2	(19)	WEISKOPF FRITZ
	290	(19)	WEST JOHN A
273	B 2	(19)	WHITE CHAS. W
	336	(19)	WHITMORE SETH H.
	B 1	(9)	WILLIAMS A BERT G.
	B 7	(19)	WILSON HENRY W.
216	B 1	(19)	WOODRUFF SAMUEL M.
245	B 6	(16)	WOODWARD WM.
144	B 7	(16)	WRIGHT ROBERT
	257	(16)	WEBER [illegible]Y
	241	(16)	WRIGHT JOHN JR.
	74	(16)	WRIGHT JOHN SR
347	B 8	(19)	ZWISLER JOHN

SECTION 32

LOT	GRAVE	WAR	NAME
	B 1	(16)	CRAWFORD THOMAS
	26	(19)	NEAL JOHN B.
		◯	
		◯	
		◯	

SECTION 34

	B 8	(19)	STANLEY C.O.

SECTION 35

150	B 2	(19)	BAKER BENJAMIN R.
35	3	(19)	BAKER JOHN S.
139	B 3	(19)	BROOKFIELD EDWARD V.
181	B22	(19)	BRYANT ANDREW J.
82	B 5	(19)	BURGOYNE JOHN L.
80	23	(19)	BURGOYNE ERASTUS
92	B21	(25)	CARNAHAN WM. N.
154	B 9	(19)	CURL EDGAR
45	B 8	(19)	DAILEY JOHN L.
141	B 4	(19)	FALLIS EDWARD H.
127	B 11	(19)	FERDON EDWARD S.
143	B 6	(19)	FOX CHAS. H.
123	B 1	(19)	HASKELL W. P.
111	B 11	(19)	HAWKINS MORTON L.
159	B21	(25)	HAWKINS PERRCY H.
157	B 7	(19)	HIGGS CASSIUS M.
184	B 5	(19)	HOEL WM. R.
142	B 8	(19)	HYATT CHAS. B
118	B 2	(10)	LODWICK JOHN
112	B 7	(19)	LUCAS JOHN B.
125	B 9	(19)	McCAMMON GEO.
174	B18	(19)	McDONALD CLEON
80	B36	(19)	McDONALD THOMAS L.
93	B 6	(19)	MYERS JOHN F.
92	B14	(19)	NEILSON JOHN L.
118	B 9	(10)	NEWLIN CHAS. S.

SECTION 35

LOT	GRAVE	WAR	NAME
144	B 34	(19)	POOR CHES, M.
114	B 5	(19)	RODGERS JAS. V.
34	B 9	(26)	RULE ROBERT
32	B16	(19)	SIBLEY JAS. H.
141	B 9	(19)	SMITH CHAS. H.
107	B 4	(19)	STERRETT BENJAMIN JR.
156	B 8	(19)	WALLACE JOHN
179	B15	(19)	WILSON JESSE F.
36	B 4	(19)	WOODMANSEE WM.
37-A	B 4	(19)	BENHAM HY L.
94	B 5	(10)	CRARY LYMAN
118	B 3	(10)	CROW ALBRON T.
90	B 8	(19)	CUNNINGHAM WM.
80	B 40	(19)	EASTMAN FRANK
180	B 12	(19)	McNICOLL HY.
32	B 14	(33)	NORTON OLIVER D.
75	B-3	(10)	GIBSON JOHN
152-A	B-2	(33)	QUINN JOHN

SECTION 33

LOT	GRAVE	WAR	NAME
B		(10)	REAGIN REASON

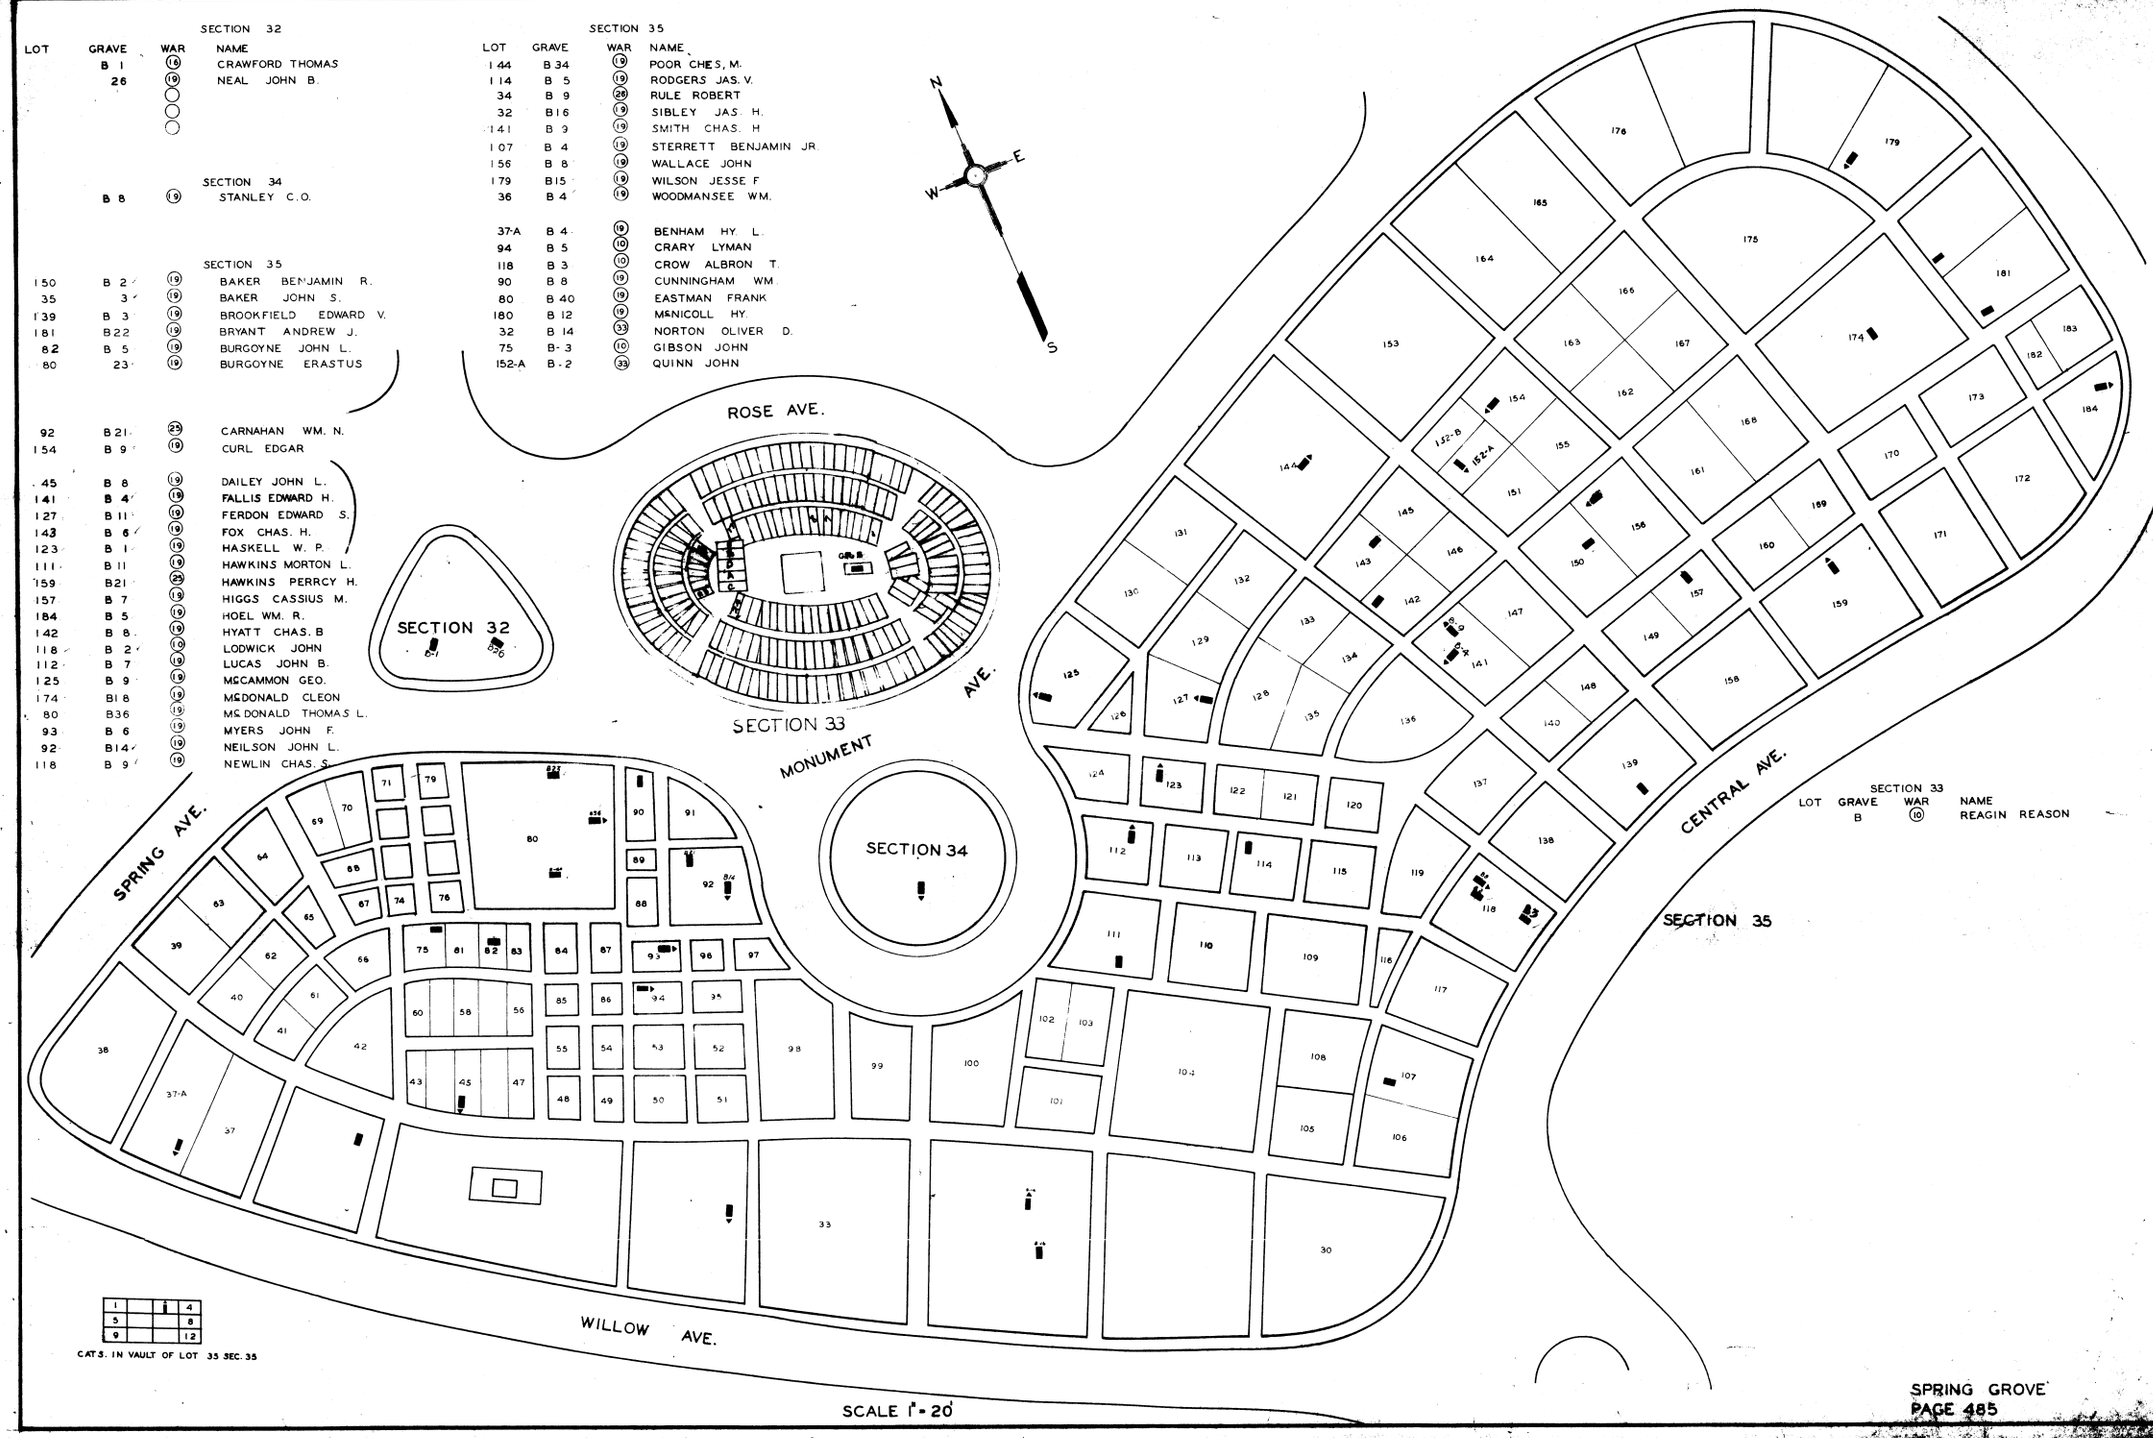

1			4
5			8
9			12

CAT 3. IN VAULT OF LOT 35 SEC. 35

SCALE 1" - 20'

SPRING GROVE
PAGE 485

LOT	GRAVE	WAR	NAME
61	B-5	(19)	ATHERTON CHAS.
49	B-19	(19)	BAKER HENRY F.
46	B-9	(19)	BAKER LEW. H.
66	B-15	(19)	BOYD WM. F.
25	B-1	(33)	BORDEN SAM. G.
84	B-5	(19)	CADWELL JOS.
101	B-8	(19)	CARTER JOHN W.
85	B-3	(19)	CHANDLER GEO. B.
62	B-14	(19)	CHAPMAN WM. P.
52	B-13	(19)	CLARK SAM. H.
15	B-15	(19)	COLE CHAS. W.
80	B-5	(19)	EMERY JOHN J.
43	B-25	(31)	FISH ISAAC T.
49	B-1	(1)	HALSEY LUTHER REV.
68	B-10	(19)	HARRIS SAM. T.
44	B-2	(16)	HOMAN WM.
90	B-8	(19)	INNES WM. D.
52	B-10	(19)	KIRBY WM. H.
19	B-11	(31)	LANGDON HENRY H.
1	B-2	(19)	LOTZE WM. H.
21	B-12	(19)	MEADER JUSTUS.
92	B-6 CAT.	(19)	NEFF RICH. W.
95	B-12	(19)	OWENS WM.
10	B-35	(31)	PENDLETON ELLIOTT H.
16	B-8	(19)	RAMMELLSBURG CHAS.
75	B-14	(19)	ROWEKAMP JAS. W.
20	B-11	(19)	SMITH EDW. F.
24	B-3	(19)	SMITH WM. H.
59	B-38	(26)	SHAFER AL. O.
59	B-19	(26)	SHAFFER GEO. H.
24	B-6	(19)	THOMAS DAV.
57		(1)	WADE DAV. E. REV.
67	B-5	(19)	WEBB THOM. B.
67	B-10	(19)	WEBB WM.
33	B-6	(16)	WILSON EDW. J.
31	B-8	(19)	WITHERBY GEO. P.
76	B-10	(19)	YOUNG THOM. L.
87	B-9	(19)	ZIMMERMAN MARTIN
87	B-5	(19)	ZIMMERMAN THOM. W.
26	B-1	(10)	CARR F.
101	B-9	(19)	COLWELL THOS. W.
40	B-9	(10)	PENDELTON N. G.
87	B-8	(19)	ZIMMERMAN EUG.

LOT	GRAVE	WAR	NAME
36	B-2	(10)	BALDRIDGE JAS
101	B-3	(19)	FAY CAL. C.
68	B-4	(19)	HARRIS WM. H.
106	B-9	(19)	MATTHEWS STAN
95	B-12	(19)	OWEN WM. JR
18	B-11	(19)	STACEY GEO. T
20	B-5	(19)	STARBUCK CAL W
24	B-2	(26)	THOMAS HARRY I
66	B-19	(19)	WOOD EDW. S
66	B-13	(19)	WOOD JAS.

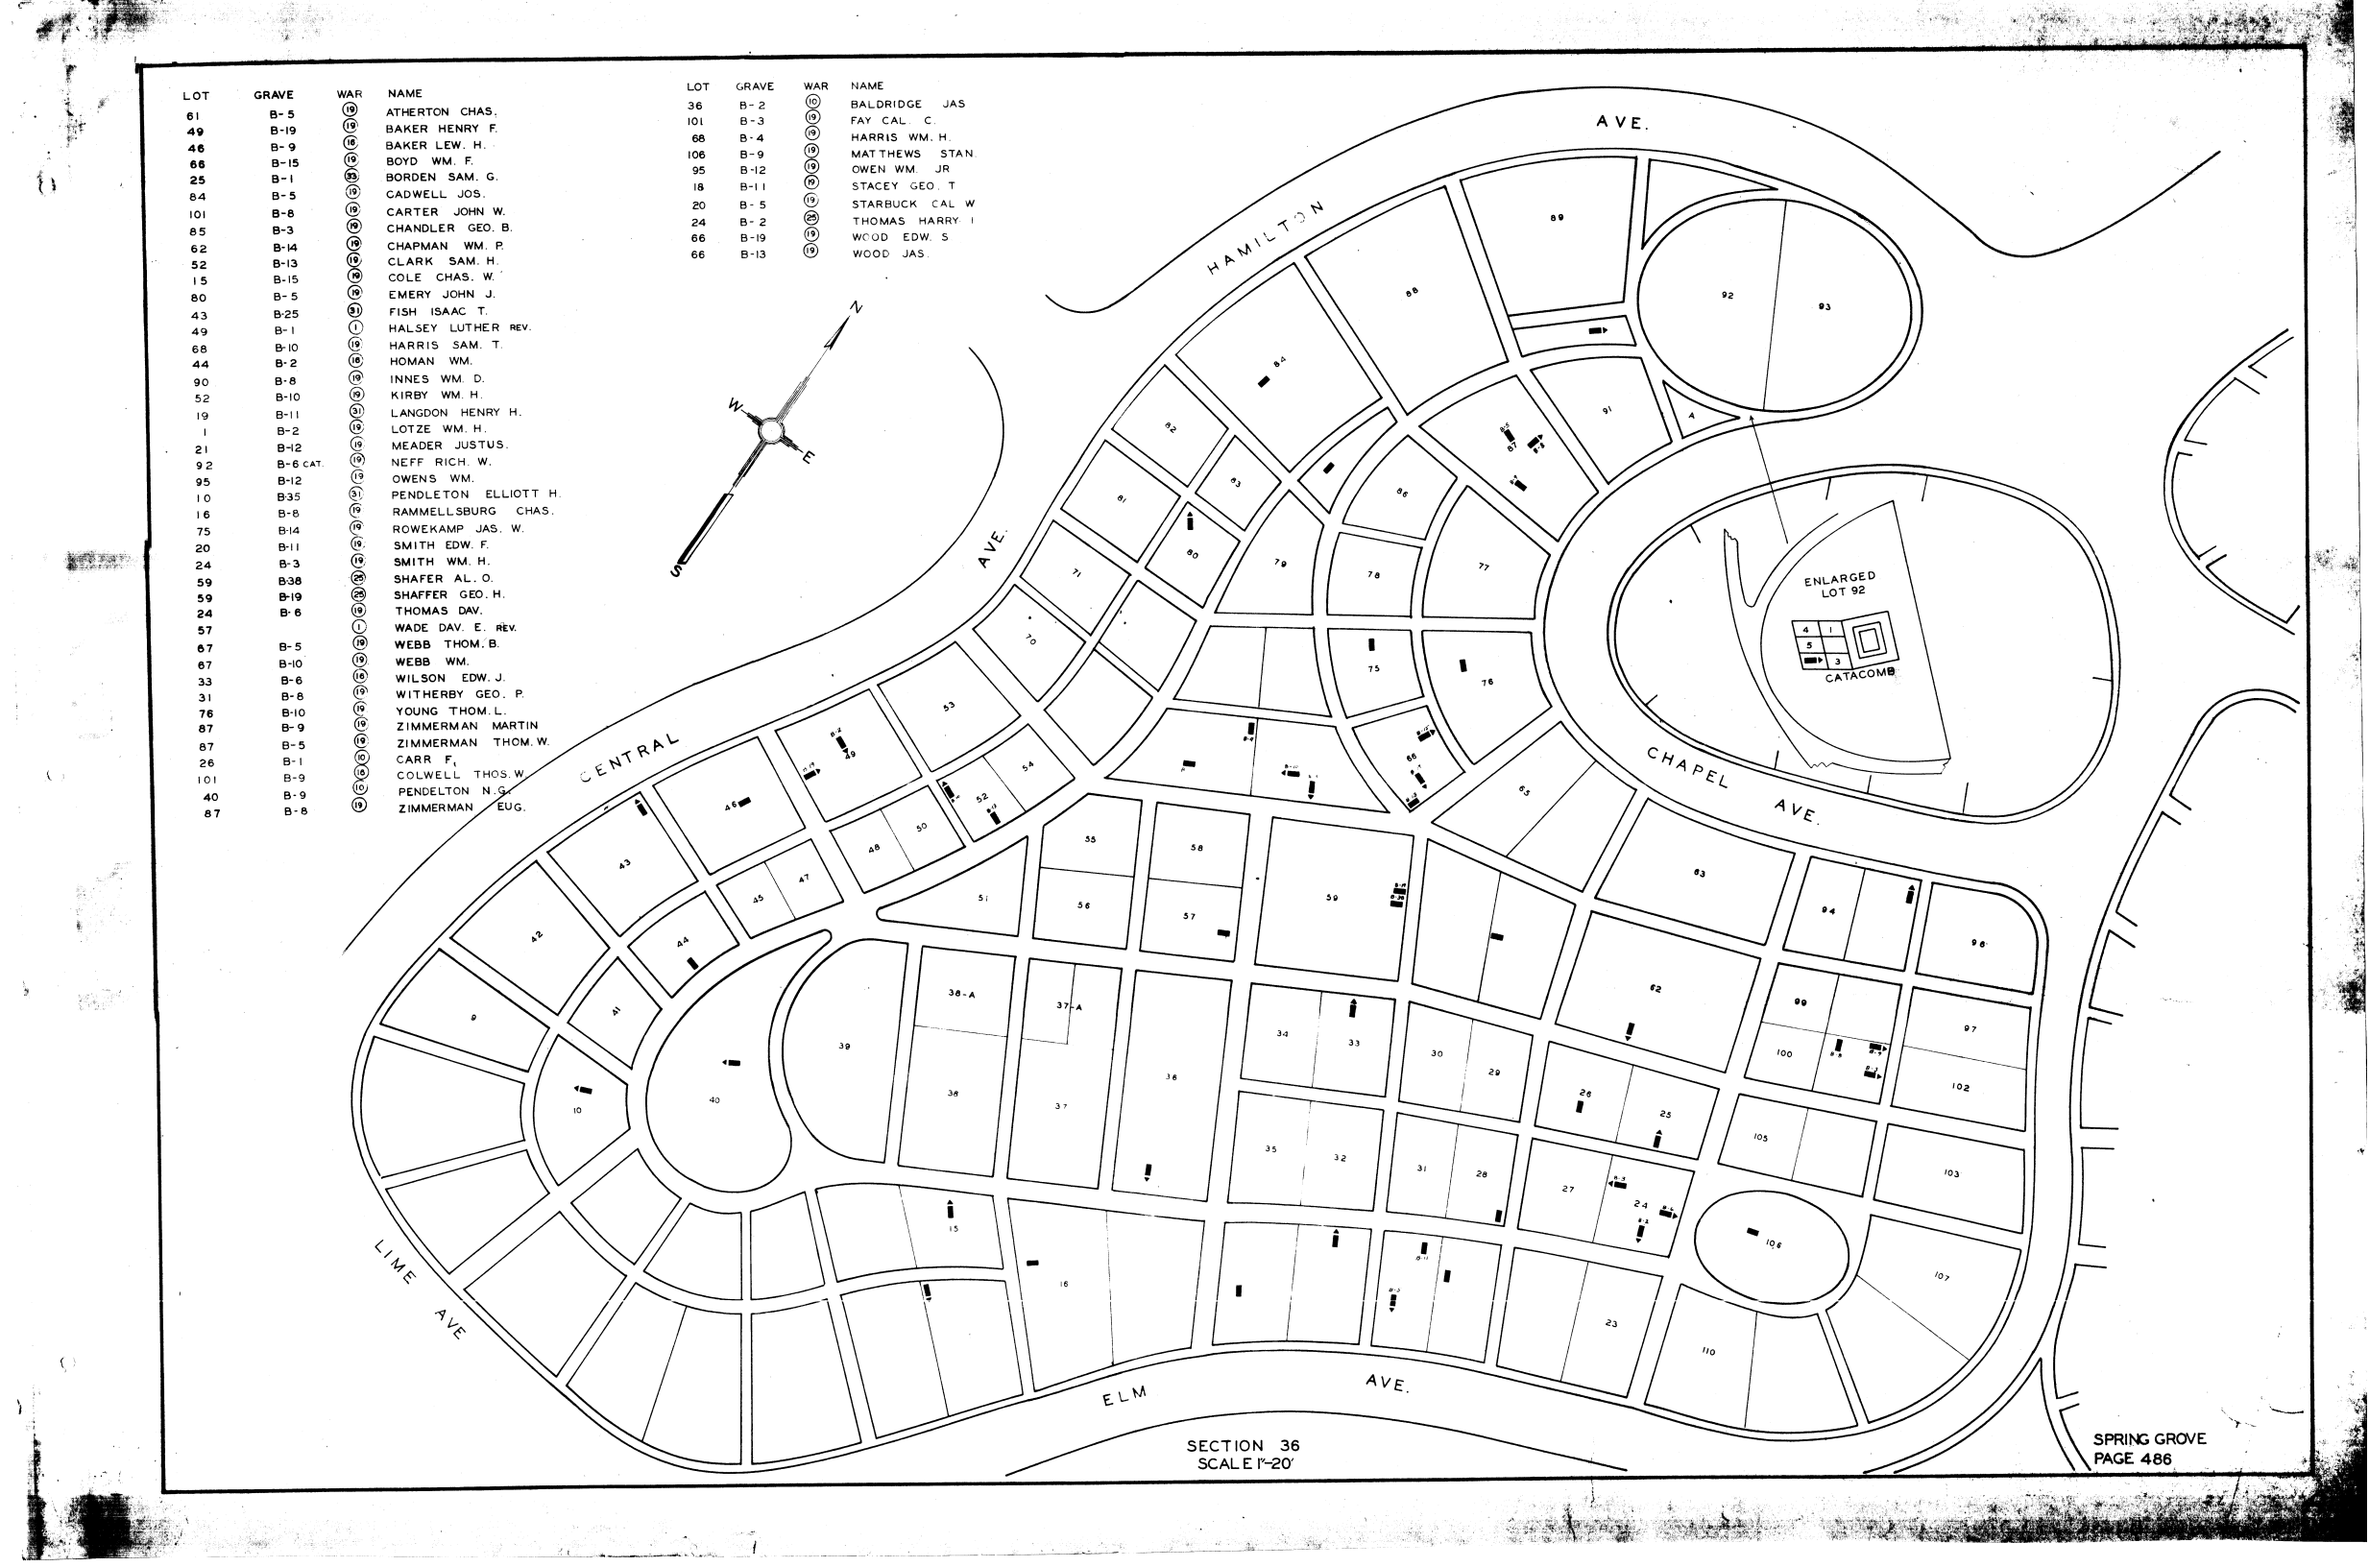

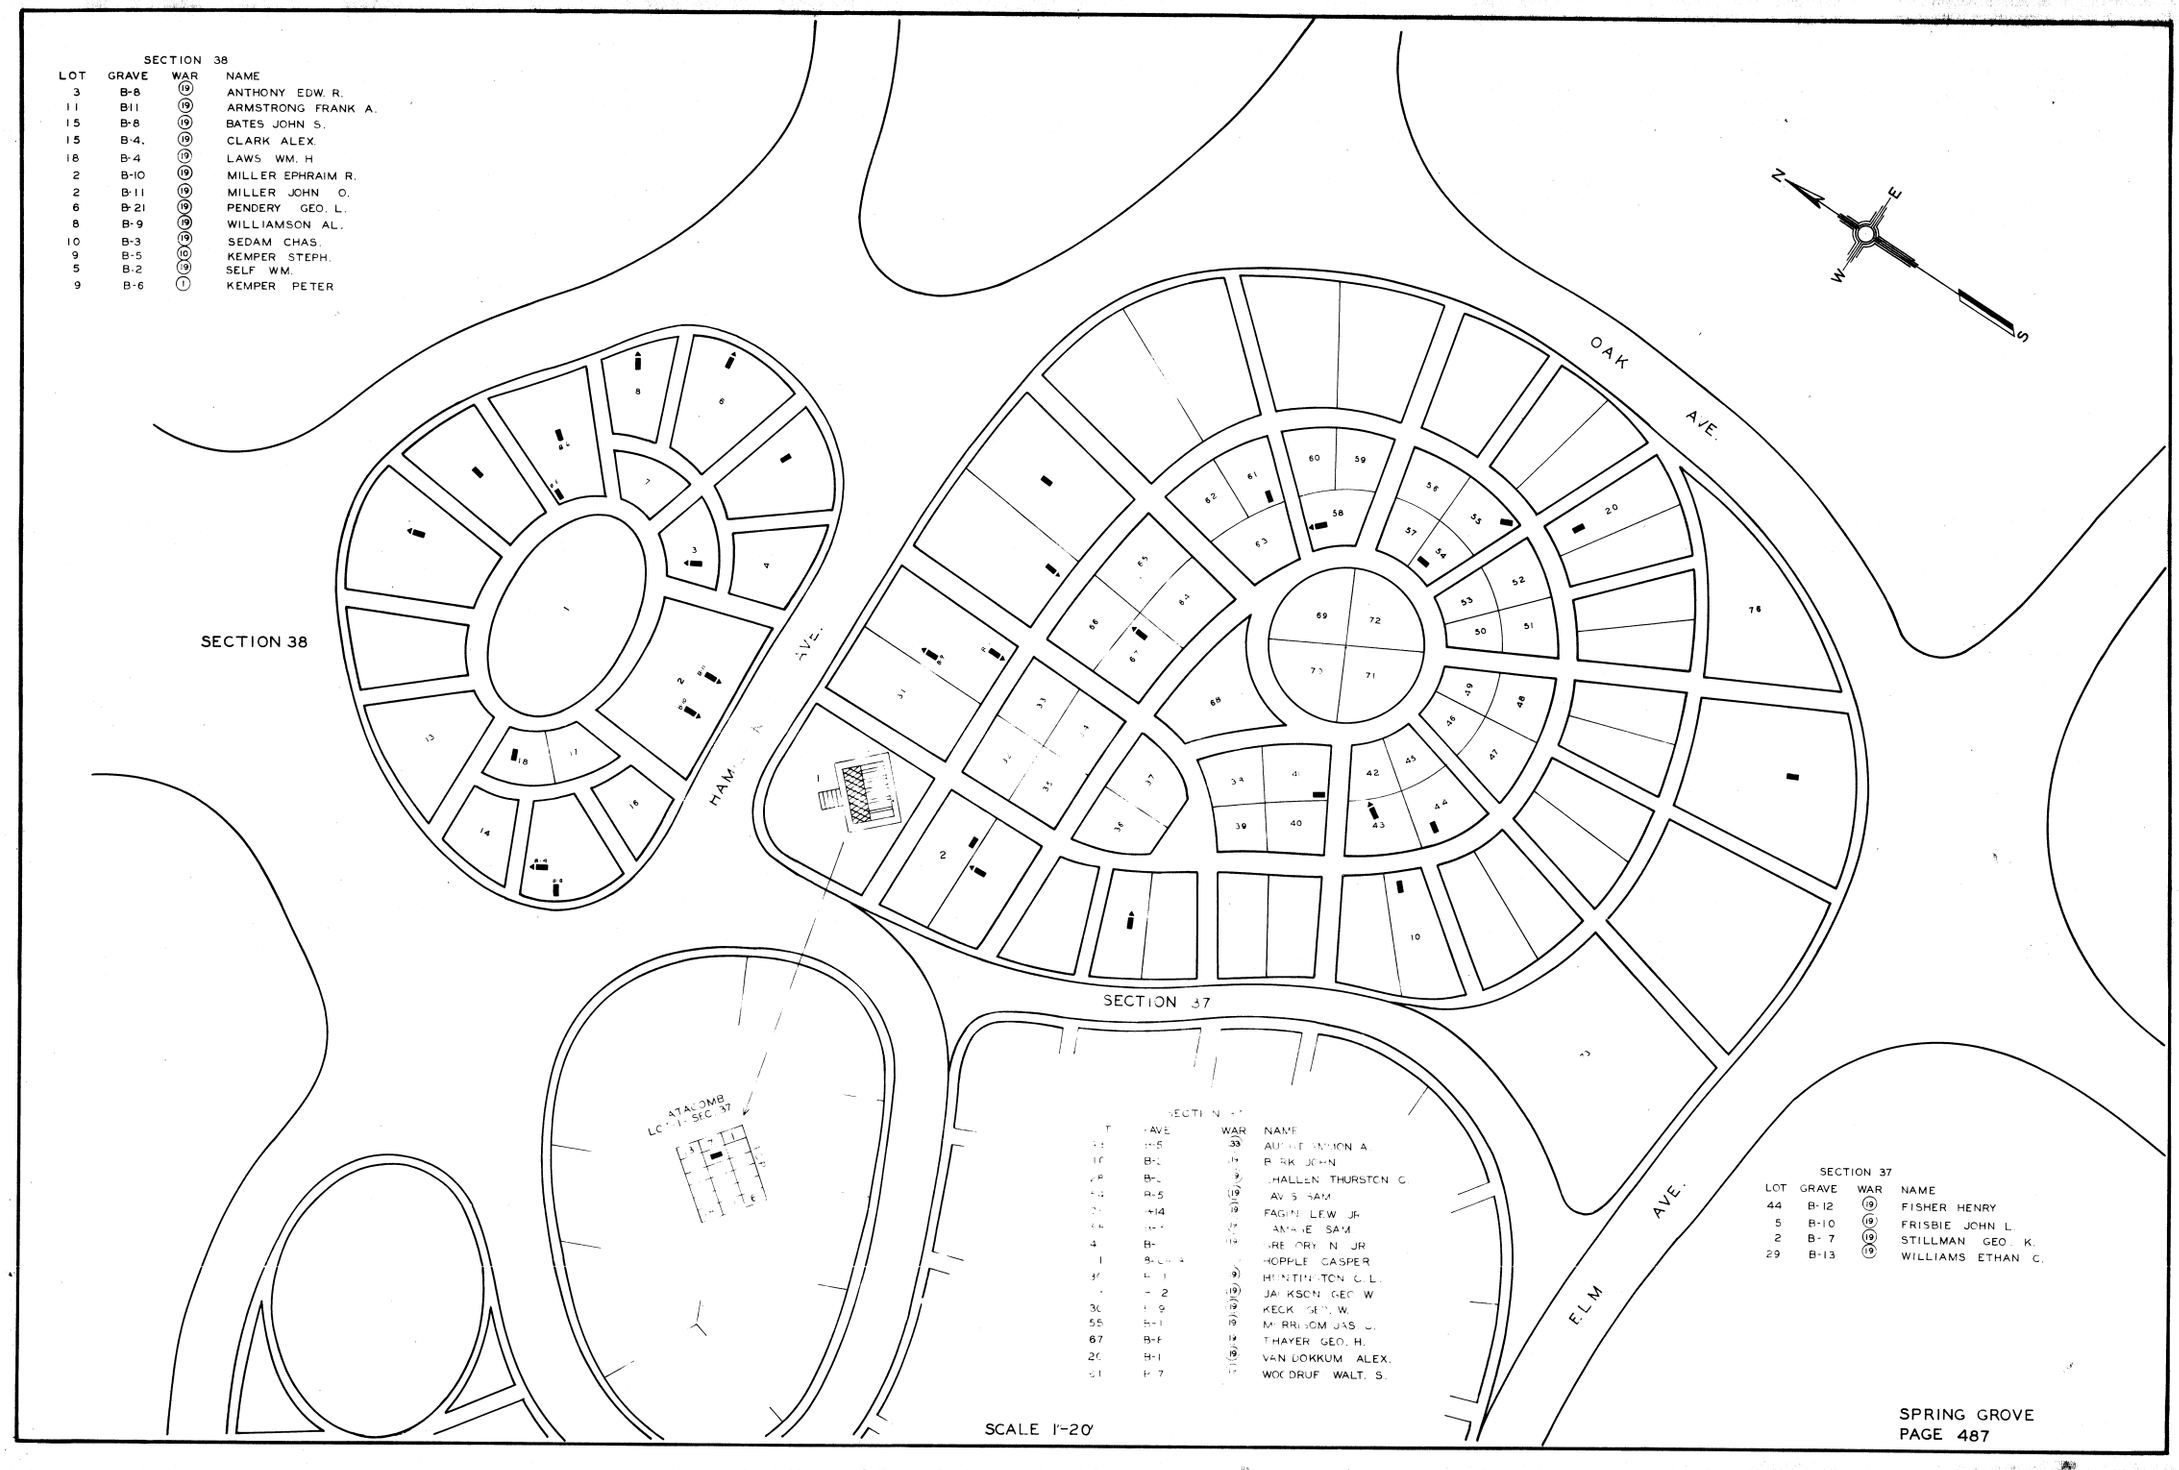

SECTION 38

LOT	GRAVE	WAR	NAME
3	B-8	19	ANTHONY EDW. R.
11	B11	19	ARMSTRONG FRANK A.
15	B-8	19	BATES JOHN S.
15	B-4.	19	CLARK ALEX.
18	B-4	19	LAWS WM. H
2	B-10	19	MILLER EPHRAIM R.
2	B-11	19	MILLER JOHN O.
6	B-21	19	PENDERY GEO. L.
8	B-9	19	WILLIAMSON AL.
10	B-3	19	SEDAM CHAS.
9	B-5	10	KEMPER STEPH.
5	B-2	19	SELF WM.
9	B-6	1	KEMPER PETER

SECTION 37

LOT	GRAVE	WAR	NAME
44	B-12	19	FISHER HENRY
5	B-10	19	FRISBIE JOHN L.
2	B-7	19	STILLMAN GEO. K.
29	B-13	19	WILLIAMS ETHAN C.

SECTION 37

LOT	GRAVE	WAR	NAME
[illegible]	[illegible]-5	33	AU[illegible]MON A.
10	B-[illegible]	19	B[illegible]RK JOHN
[illegible]	B-[illegible]	19	[illegible]HALLEN THURSTON C.
[illegible]	B-5	19	[illegible]AV[illegible]S SAM
[illegible]	[illegible]-14	19	FAGIN LEW JR
[illegible]	[illegible]	19	[illegible]AM[illegible]E SAM
4	B-	19	[illegible]RE[illegible]ORY N. JR
1	B-[illegible]	[illegible]	HOPPLE CASPER
3[illegible]	[illegible] 1	19	HUNTINGTON C. L.
[illegible]	[illegible] 2	19	JACKSON GEO. W
30	[illegible] 9	19	KECK GEO. W.
55	B-1	19	MORRISON JAS. C.
67	B-[illegible]	19	THAYER GEO. H.
20	B-1	19	VAN DOKKUM ALEX.
[illegible]	B-7	[illegible]	WOODRUF WALT. S.

SPRING GROVE
PAGE 487

LOT	GRAVE	WAR	NAME
280	B-4	19	ACKERMAN FREDR.
224	B-10	19	ADKINS DALLAS
224	B-4	19	ADKINS JOHN N.
263	B-17	19	ANDERSON JAS. E.
274	B-5	19	ARNOLD JAS. S.
98	B-4	19	BUSSE FREDR. C.
45	B-15	19	CAMERON ALONZO
45	B-12	19	CAMERION ROBT. B.
263	B-7	19	CARR JAS.
7	B-2	10	CARPENTER JOS.
238	B-7	19	COX WM. R.
61 63	B-2	19	CULBERTSON JAS.
267	B-17	19	DAVIS TOM.
274	B-6	19	DE SILVER ANTON E.
268	B-30	19	DETERMAN FRANK H.
83	B-5	19	DICKSON SAM.
273	B-6	19	DOOLITTLE FRANK M.
10	B-3	19	EATON EDW. W.
62	B-8	19	EHA GOTTLIEB
172	B-4	19	ELLIOTT THOS.
142	B-4	19	FORRISTALL WM. A.
139	B-7	19	GARRETSON GEO. W.
12	B-1	19	GETZ EDW. J.
12	B-2	19	GETZ LEW. B
189	B-9	31	GETZENDANNER WALT. S.
287 289	B-22	19	GILMAN CHAS.
240	B-13	19	HALL CHAS. W.
191	B-14	19	HALL JOSIAH C.
191	B-7	19	HALL REZIN F
225	B-12	19	HENDERSON ARCHIBALD
144	B-5	16	HERMAN SAM.
215	B-2	19	IRELAND CHAS.
215	B-1	19	IRELAND EDW.
215	B-6	19	IRELAND ISAAC.
272	B-1	19	JOHNSON JAS.
248	B-1	19	JONES JOHN D.
229	B-4	19	KIRKER THOM.
188	B-6	19	KOLBE HENRY
45	B-35	19	LAWLER WM. J.
105	B-9	19	MASON BEN. W.
185	B-5	19	METCALFE ALF.
219	B-7	19	MERRIMAN WM. H.
267	B-11	19	MILLER JOHN
66	B-7	19	MOORE WM. H.
263	B-16	19	MURPHEY GEO. W.
152	B-3	19	MURPHY JOHN
152	B-8	19	MURPHY JOHN G.
152	B-7	19	MURPHY THOM. J.
116	B-8	19	MURRAY CHAS.
240	B-14	19	MYERS GEO. W. H.
267	B-19	19	PARKER EDW.
268	B-29	19	PLACKE JOHN H.
268	B-23	19	POSTEL JOHN
241	B-17	19	RECHEL CONRAD
241	B-1	19	RECHEL WM

LOT	GRAVE	WAR	NAME
86	B-4	19	RIGDON WM.
102	B-3	19	ROBERTS JOHN D
3	B-11	19	ROBERTS JAS. H.
55	B-13	19	ROSS CHAS B
53	B10	19	RUFFIN CHAS. K
53	B-13	19	RUFFIN SAML. N.
193	B-11	19	RUPP CHAS
193	B-10	19	RUPP JAC.
193	B-4	19	RUPP J. P.
187	B-3	19	SCHMALZ ANDY.
264	B-16	19	SCHWARZ HENRY
240	B-10	19	SCOTT CHAS. A
97	B-5	19	SHAW JAS. W
139	B-9	31	SHEALOR H.
34	B-6	19	STRANG D. B.
172	B-5	16	TAYLOR JAS
172	B-3	19	TAYLOR WM.
114	B-2	19	TATEH EZEKICH H
252	B-6	19	VOGT WM. E.
141	B-19	19	WANKELMAN WM.
106	B-4	19	WARWICK SAM. H
147	B-10	19	WATERS JAS.
29	B-10	19	WEISGERBER PHIL.
68	B-1	19	WETMORE JOHN A.
178	B-1	19	WILL JOHN
45	B-13	19	WOLF SYLVANUS
246	B-4	19	ZIMPELMANN JOHN
246	B-13	19	ZIMPELMANN PETER
87	B-4	19	BALDWIN WM. A.
41	B-6	19	BRONSON D. H.
140	B-6	19	CHRISTOPHER ALEX. C
69	B-6	19	COOPER SAM. H.
142	B-6	19	FORRISTALL CHAS. T.
219	B-15	19	HANNUM THOS.
36	B-16	19	JENIFER GEO. W. C.
	B-40	16	McCARTY JOHN W. REV.
244	B-5	19	MEYER SEB'T.
232	B-7	20	MILLER JOHN. S
143	B-12	19	MURPHY CHRIS.
155	B-9	31	MUSCROFT C.
47	B-8	19	RHINE J. A.
239	B-7	31	SHAFER C. J.
132	B-9	19	STEWART CHAS.

LOT	GRAVE	WAR	NAME
130	B- 6	19	STEWART WM. R.
269	B- 7	10	WALLACE JOHN S.
73	B-12	19	WEIMANN FRANK
104	B- 6	19	HOFFMAN LOUIS
280	B- 5	19 20	MOUND CHAS. H.
47	B-10	19 20	SWEENEY JOHN G.
181	B- 9	20	WILLIAMS W. C.
48	B-16	19	MOFFATT ALVA
259	B-40	19	McCARTY JOHN W.

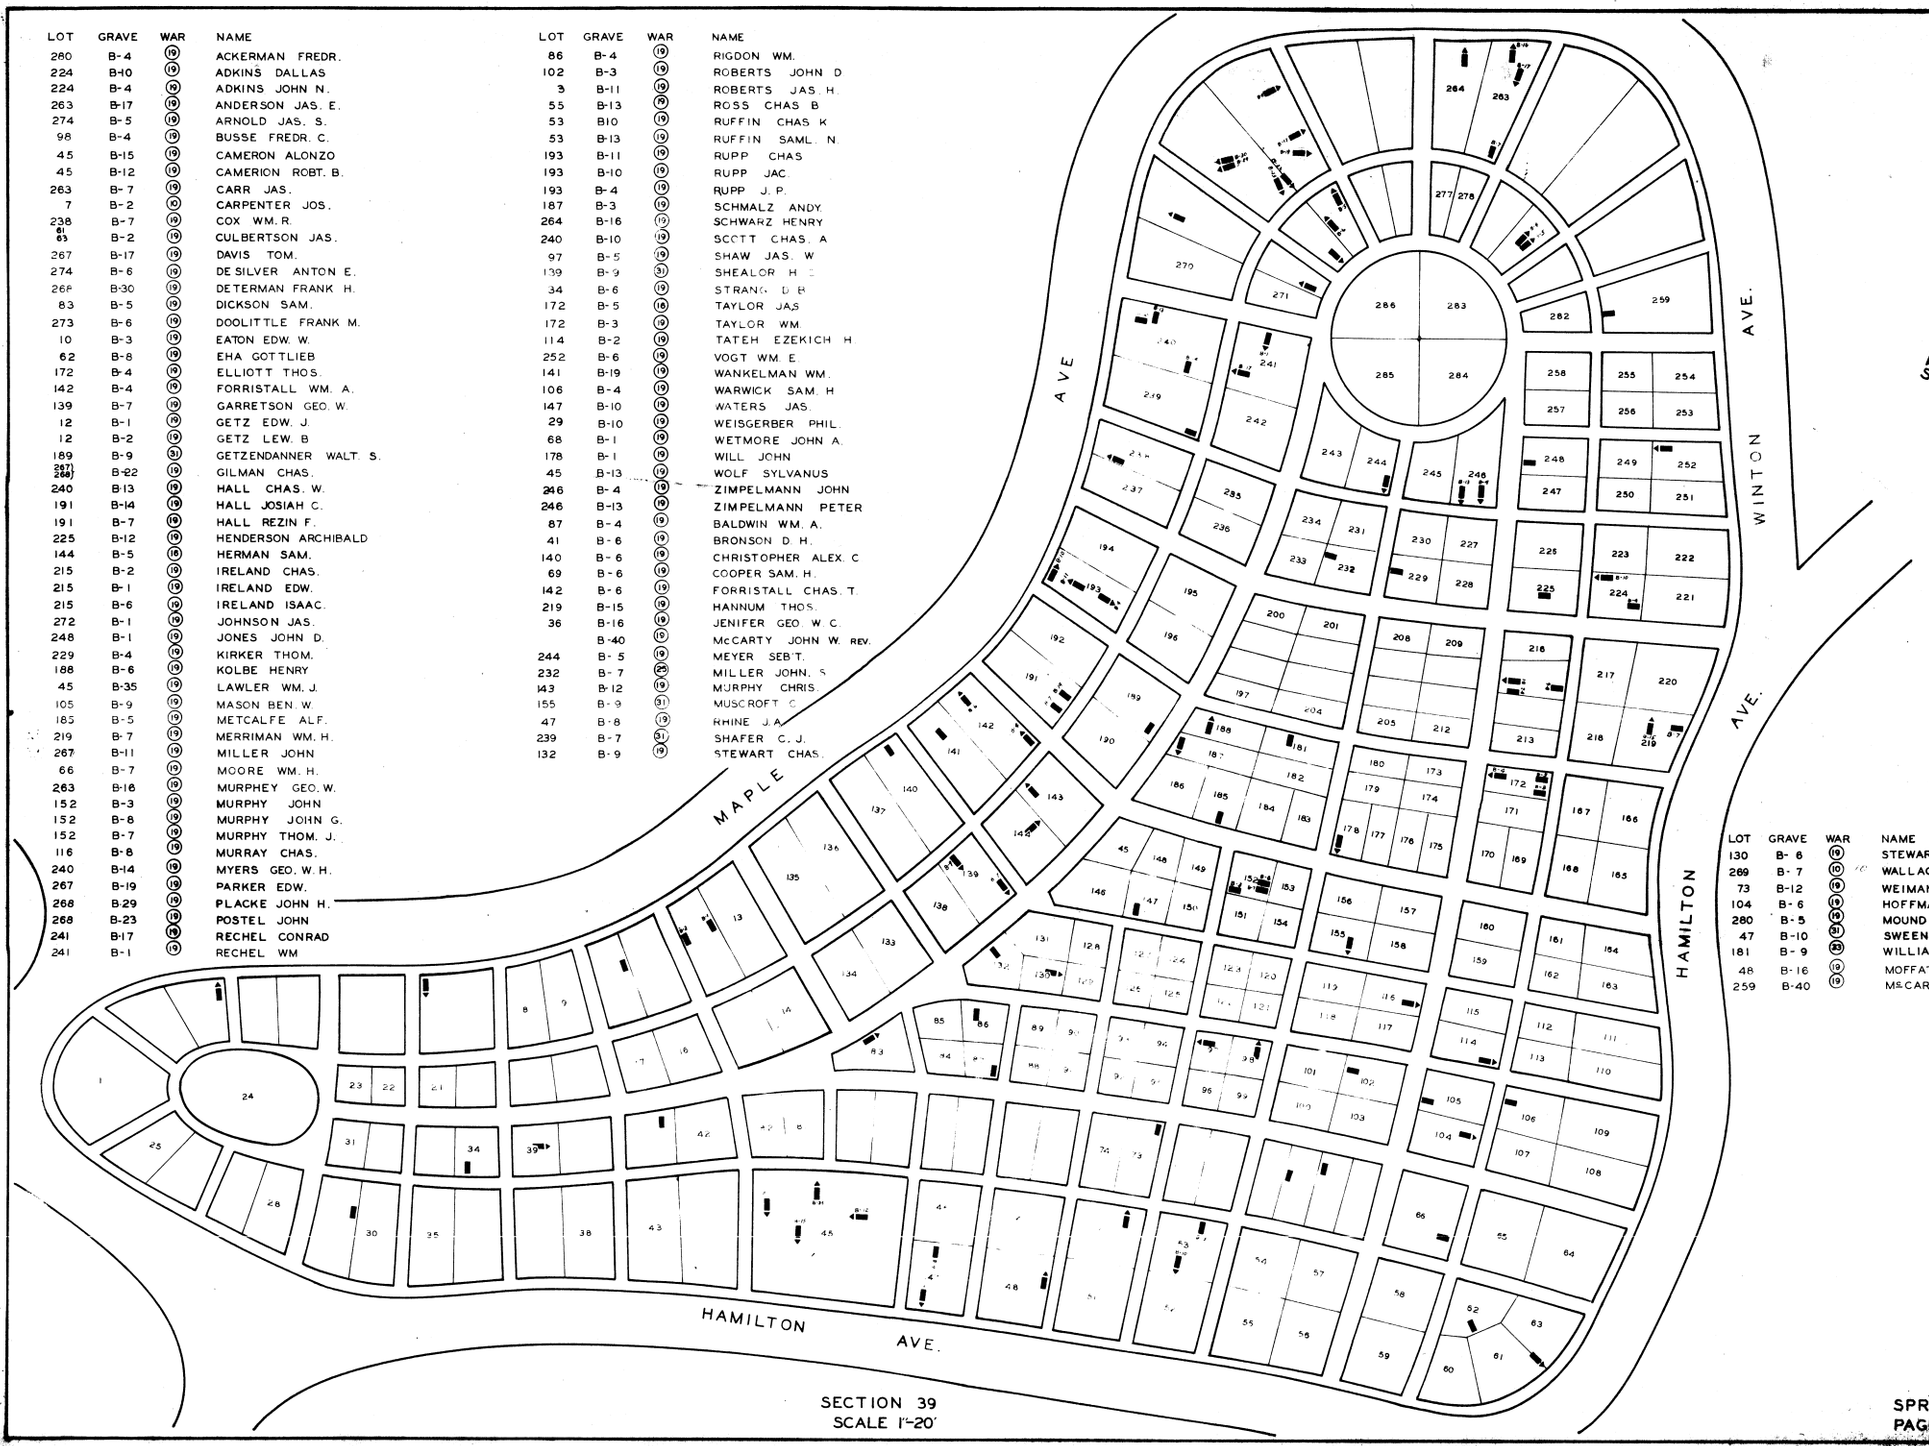

SECTION 39
SCALE 1"-20'

SPRING GROVE
PAGE 488

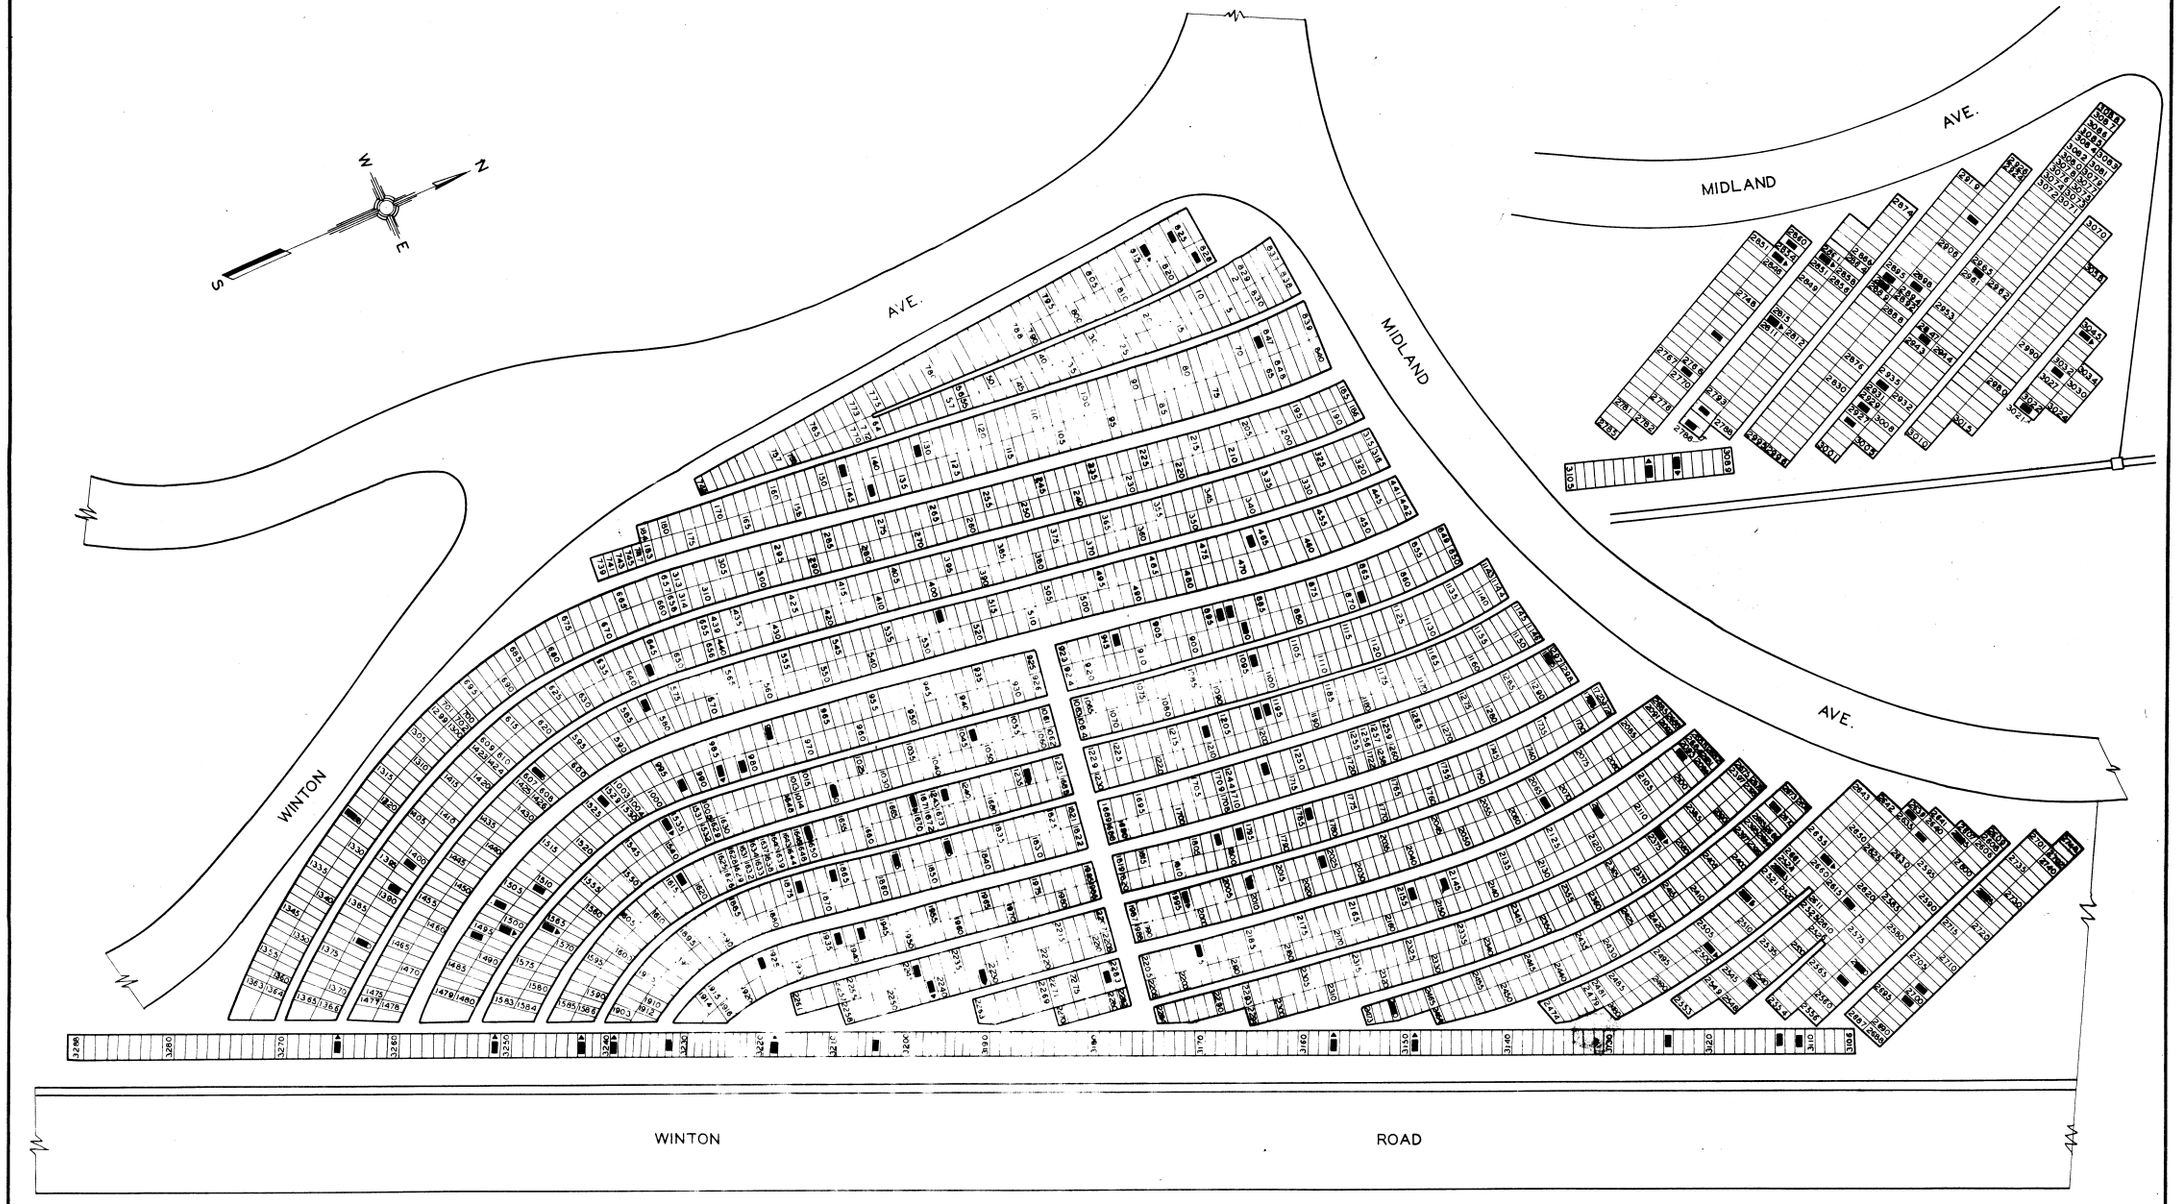

SECTION 40
SCALE 1"-20'

SPRING GROVE
PAGE 489

LOT	GRAVE	WAR	NAME
	525	(19)	ALEXANDER PETER
	1797	(19)	ALLISON WM.
	1867	(19)	ANDREWS JOS.
	1234	(19)	GALLIGHER JAS
	3204	(31)	BARLOW RICH.
	913	(6)	BEAN D.J.
	1295	(19)	BEAN WM.H.
	1508	(15)	BLACK JOHN Q.
	986	(19)	BOGART SAM.
	1398	(19)	BRANDENBURG AUG.
	817	(19)	BRATT CYRENUS P.
	975	(3)	BUCK JAS.
	605	(19)	BECK TRUMAN
	2637	(19)	BENZING GEO.
	2786	(19)	BRANDSTETTER FRANK
	141	(19)	BLAND PETER
	1669	(19)	BUTSCHA FREDK.
	2009	(13)	CALLAHAN JOHN
	2265	(3)	CAULFIELD PATRICK H.
	2470	(19)	CASE CHAS.
	3094	(19)	CASPER CHAS. L.
	994	(19)	CONRAD WM.
	2115	(19)	COX FRANCIS M.
	2768	(19)	COX GEO. B
	826	(19)	CARSON ANDY.
	2945	(19)	DAVIS WM. C.
	644	(19)	DIMICK WM. D.
	2242	(19)	DOUBLEDAY HIPPOLYTE J.
	581	(19)	DUNLAP JOHN C.
	2542	(3)	ELLIOTT WM.
	3251	(19)	FAEHULE WM.
	1873	(19)	FLECKENSTINE JOHN L.
	1501	(19)	GEIER GEO.
	2550	(19)	GEIGER JACOB B.
	881	(12)	GIBSON WM. H
	2658	(19)	GRAU GEO. M.
	1392	(2)	GRIFFITH JOHN F.
	3232	(19)	HAMILTON FRANCIS
	2789	(19)	HAMILTON JAS. B.
	1242	(19)	HALL ISAIAH
	2134	(19)	HART WM. H.
	2605	(19)	HENDERSON JAS.
	1567	(19)	HENSLER JOHN A.
	2616	(19)	HENTZ AL. W.
	2232	(2)	HERTH THEO.
	1199	(19)	HICKS HENRY C.
	2523	(19)	HICKS WM.Y.
	2281	(19)	HOLLAND JOHN J.
	1725	(19)	HANN PHIL.
	3044	(19)	JENKINS EDW. P.
	1097	(19)	JENKINS GEO.
	2153	(19)	JENKINS WM.
	2698	(19)	JONES JOHN

LOT	GRAVE	WAR	NAME
	1557	(19)	KELLER LOUIS
	2933	(2)	KELSO JAS.
	1649	(19)	KENNEDY PHIL
	2157	(2)	KERN JOHN W.
	2147	(19)	KITCHN GEO. C.
	1937	(19)	KRIELMAN LOUIS
	2570	(19)	LAVO JACOB
	3029	(19)	LEIVI HENRY
	13	(15)	LLOYD HAROLD
	2377	(19)	MACK CHRISTIAN
	1047	(19)	MAINS WALTER
	2023	(19)	MANLY DANL. J.
	2026	(2)	MCONNELL WM.H.
	1855	(19)	MCLEAN JAS
	3216	(19)	MCLOUD EDW.S.
	1941	(19)	MEYERS CHAS L.
	1209	(19)	MILES DANL T
	1923	(19)	MILLER JOHN
	2515	(19)	MILLER JOHN A
	1021	(19)	MUELLER MICHAEL
	2758	(19)	MCGREW FRANK
	2855	(19)	MILLER GEO
	2095	(19)	NEVERS KING G.
	2894	(19)	NUSKEY THEODORE
	203	(6)	PARKER WM. H
	3243	(19)	PAYNE GEO. A
	325	(19)	PIERCE JOHN S
	661	(19)	PINGHAM DUER
	1011	(19)	PINKET GEO. W.
	1380	(13)	QUIRY M.
	1617	(2)	REEVES WM
	2725	(19)	RENKIE JOHN
	3239	(19)	REMERS FRED. D.
	1643	(2)	ROBERTS WM.H.
	3091	(13)	RUEHLE JOHN C
	2195	(19)	RIEGEL JOHN
	2891	(15)	SANDERSON JAS. B
	1915	(3)	SCHMIDT HENRY
	148	(12)	SCHNEIDER GEO. W
	65	(2)	SCHNEIDER GEO. A.
	3173	(2)	SMITH SAMLE
	611	(15)	SMITH WM A
	2859	(2)	STEVENSON W.J.
	2963	(2)	STIENKEL PHIL
	146	(3)	TAYLOR FRANK
	92	(2)	THOMPSON WM.
	270	(2)	TINDALL WARREN
	1811	(19)	VOLTERS ANTON
	1997	(19)	WHITE MILTON H
	823	(29)	WIMMER WM
	2928	(13)	WALKER WM
	1783	(15)	WARD AUG.
	2502	(3)	WEBBER HENRY G
	1527	(15)	WERNZ MATHIAS
	2893	(19)	WERSHEY JAS.

LOT	GRAVE	WAR	NAME
	3149	(19)	WHITE WM.
	467	(19)	WILSON MORRIS
	982	(19)	WITSEL LOUIS
	2813	(19)	WOOSTER ANDREW
	2566	(13)	YARNELL DAVID F.
	1493	(19)	YEAGER JACOB
	1495	(13)	YOCUM EDWIN
	2914	(19)	WICH PHIL.
	890	(19)	WOESNER JOHN
	2926	(19)	WEISZ PHIL.
	2636	(19)	WILSON CHAS.

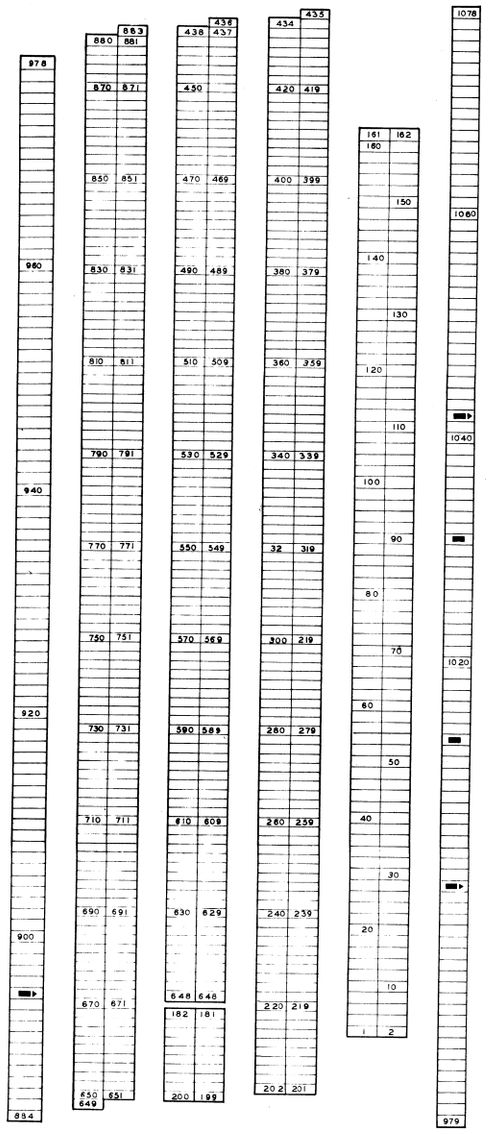

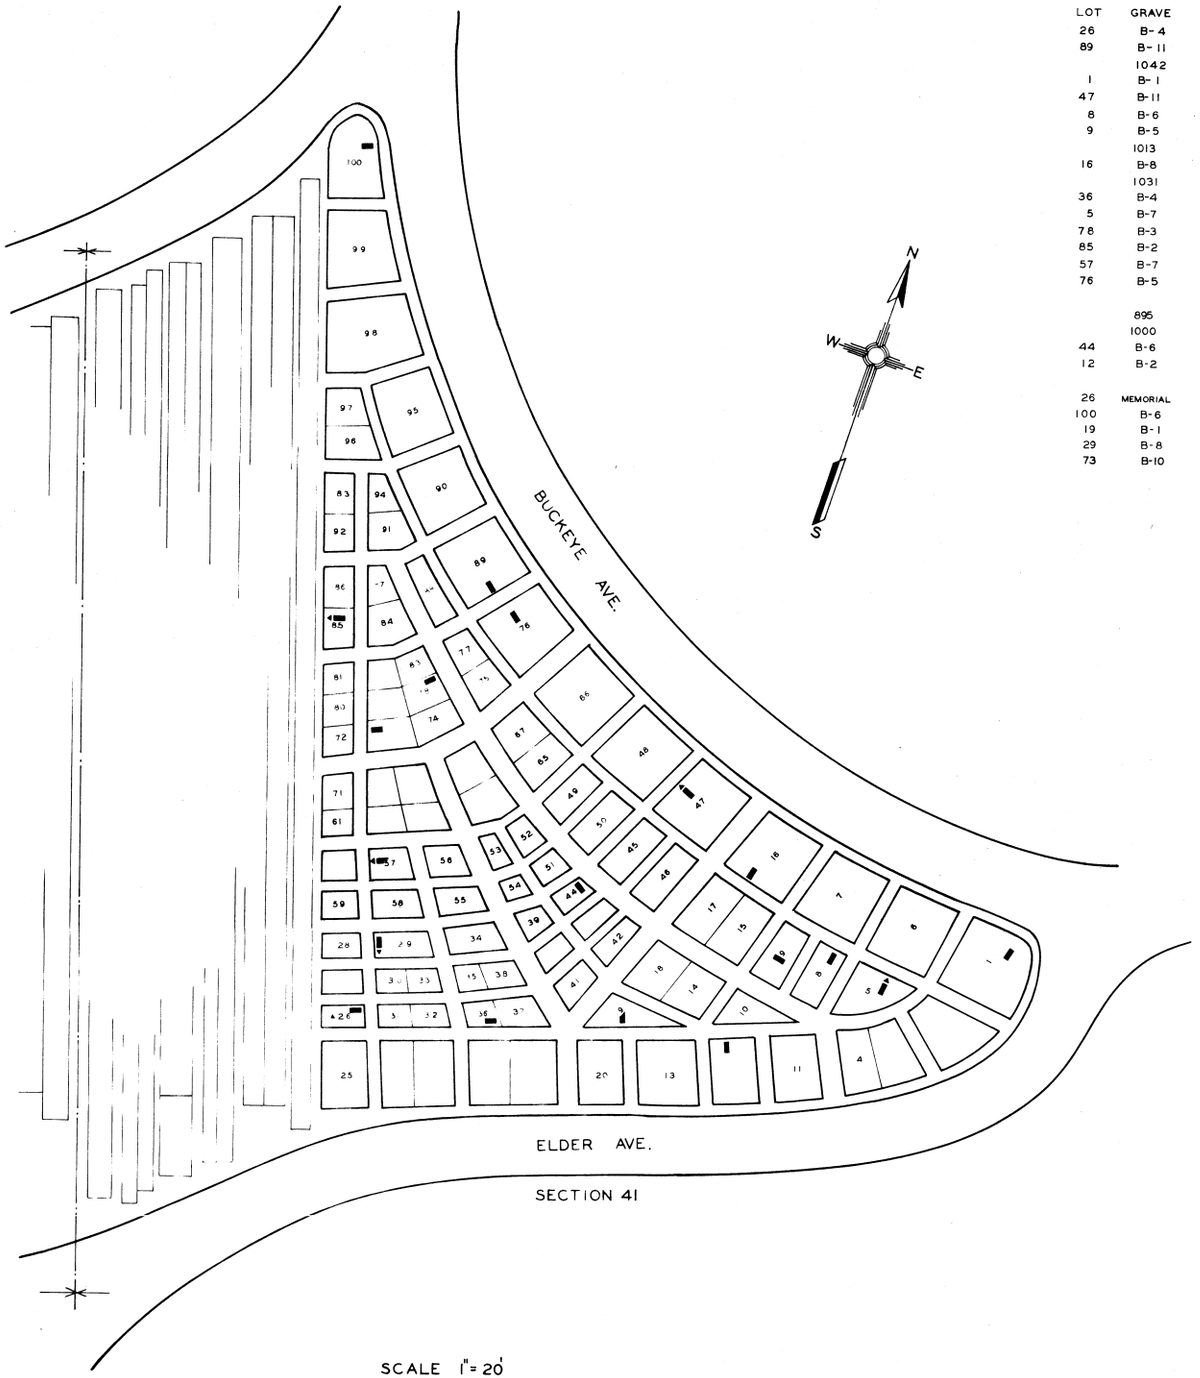

LOT	GRAVE	WAR	NAME
26	B-4	(19)	ASPINWALL WM. H.
89	B-11	(19)	AUTENREITH WM.
	1042	(19)	BANKHART JOS.
1	B-1	(19)	BURNETT JAS. C.
47	B-11	(19)	ENYART CHAS. L.
8	B-6	(19)	HARWOOD GEO. C.
9	B-5	(19)	JACKSON JOHN
	1013	(19)	KOCH JACOB
16	B-8	(19)	LEE JAS.
	1031	(19)	LEHMAN NATHAN
36	B-4	(19)	LEVERTON WM. A.
5	B-7	(19)	MYERS EDW.
78	B-3	(19)	REITZ GEO. H.
85	B-2	(10)	SCOTT SAM.
57	B-7	(19)	TULL ALF. L.
76	B-5	(19)	WAGGENOR WM. W.
	895	(19)	GLADWISH JOHN
	1000	(19)	HAIDER JOS.
44	B-6	(19)	HARRIS CONRAD
12	B-2	(19)	JACOBI EANST
26	MEMORIAL	(19)	ASPINWALL T. H.
100	B-6	(31)	GLAZIER WM. L.
19	B-1	(19)	HANKE HENRY C.
29	B-8	(19)	HILBERT CHRISTIAN
73	B-10	(19)	DAVIS JOHN

SECTION 41

SCALE 1" = 20'

SPRING GROVE
PAGE 491

LOT	GRAVE	WAR	NAME
19	B-19	(19)	ANDERSON DAV. L.
11	B-11	(19)	BAGGOTT ROB'T.
105	B- 6	(19)	CARPENTER SAM'L.
6	B- 8	(19)	CARLISLE GEO.
6	B- 6	(19)	CARLISLE JOHN
3	B-15	(19)	COLLINS JAS. A.
18	B-13	(19)	DODDS MILO G.
18	B- 7	(19)	DODDS OZRO J.
5	B- 7	(19)	EATON JOS. O.
4	B-18	(19)	FISHER HORACE
86	B- 3	(19)	FULMER JESSE
19	B-34	(19)	GLENN GEO.
83	B-20	(19)	GOODHUE WM. F.
99	B-7	(16)	JONES DAV.
34	B-34	(19)	KUGLER MATH. M.
19	B-16	(19)	LORING ELIPHALET
35	B-25	(19)	LUCKEY GEO. H.
35	B-34	(19)	LUCKEY JOS. W.
33	B-35	(31)	LUCKEY JOS. F.
80	B-14	(19)	MILLER BEN. F.
34	B-27	(19)	MILLER CHAS. H.
34	B- 8	(19)	MILLER WM. W.
6	B- 5	(9)	MURDOCK JAS. R.
8	B- 5	(19)	OGDEN AL. H.
1	B-11	(19)	PERKINS JOHN J.
20	B- 6	(19)	SECRIST JOHN L.
105	B- 7	(19)	SIEWERS CHAS. L.
67	B-12	(19)	STORY JOHN.
69	B- 5	(19)	THOMPSON THOM. J
80	B-17	(19)	W[illegible]SON [illegible]
73	B- 8	(19)	WOLF NICH



SECTION 42
SCALE 1"-20'

SECTION 43

LOT	GRAVE	WAR	NAME
26	B-14	(19)	ATTEE JAS. T.
30	B-5	(10)	BURDSALL JOSIAH
48	B-5	(19)	CULBERTSON WILSON S.
126	B-10	(19)	COWAN WM. P.
137	B-3	(16)	DODSON WM. J.
83	B-2	(19)	FOTREL JAC.
29	B-5	(19)	FRANK JOHN
75	B-10	(19)	FREEMAN LEW.
82	21	(19)	HATMAKER PET.
37	B-11	(10)	HANDSHAW JAS.
49	B-9	(19)	HERRICK DWIGHT R.
49	B-2	(19)	JACKSON JOHN H.
84	B-9	(31)	JOHNSON SANFORD A.
84	B-7	(19)	JOHNSON SANFORD A.
131	B-1	(19)	JUSTICE HORACE H.
41	B-6	(19)	KIPP WM.
93	B-8	(31)	LAWS CLEMT. E
69	B-7	(19)	LUTZ SAM.
88	B-8	(10)	MARTIN LEW.
55	B-4	(19)	McCAMMON EDW
89	B-3	(19)	MYERS WM.
92	B-2	(19)	OGDEN CHAS. A
78	B-11	(19)	PEARCE RICH. T.
78	B-4	(19)	PEARCE W. H.
32	B-12	(19)	PRICE THOM.
123	B-7	(19)	REID JOHN H.
87	B-9	(19)	SPEAR CHAS.
87	B-5	(19)	SPEER WM. H.
128	B-7	(19)	STRAIT GEO. T.
20	B-3	(10)	STEPHENS EBEN'Z.
11	B-14	(19)	TAYLOR WM. H.
66	B-8	(31)	TWITCHELL HENRY
16	B-7	(19)	VOGEL CARI
4	B-4	(19)	WENTWORTH THOM. S.
62	B-10	(19)	WOLFE WM.

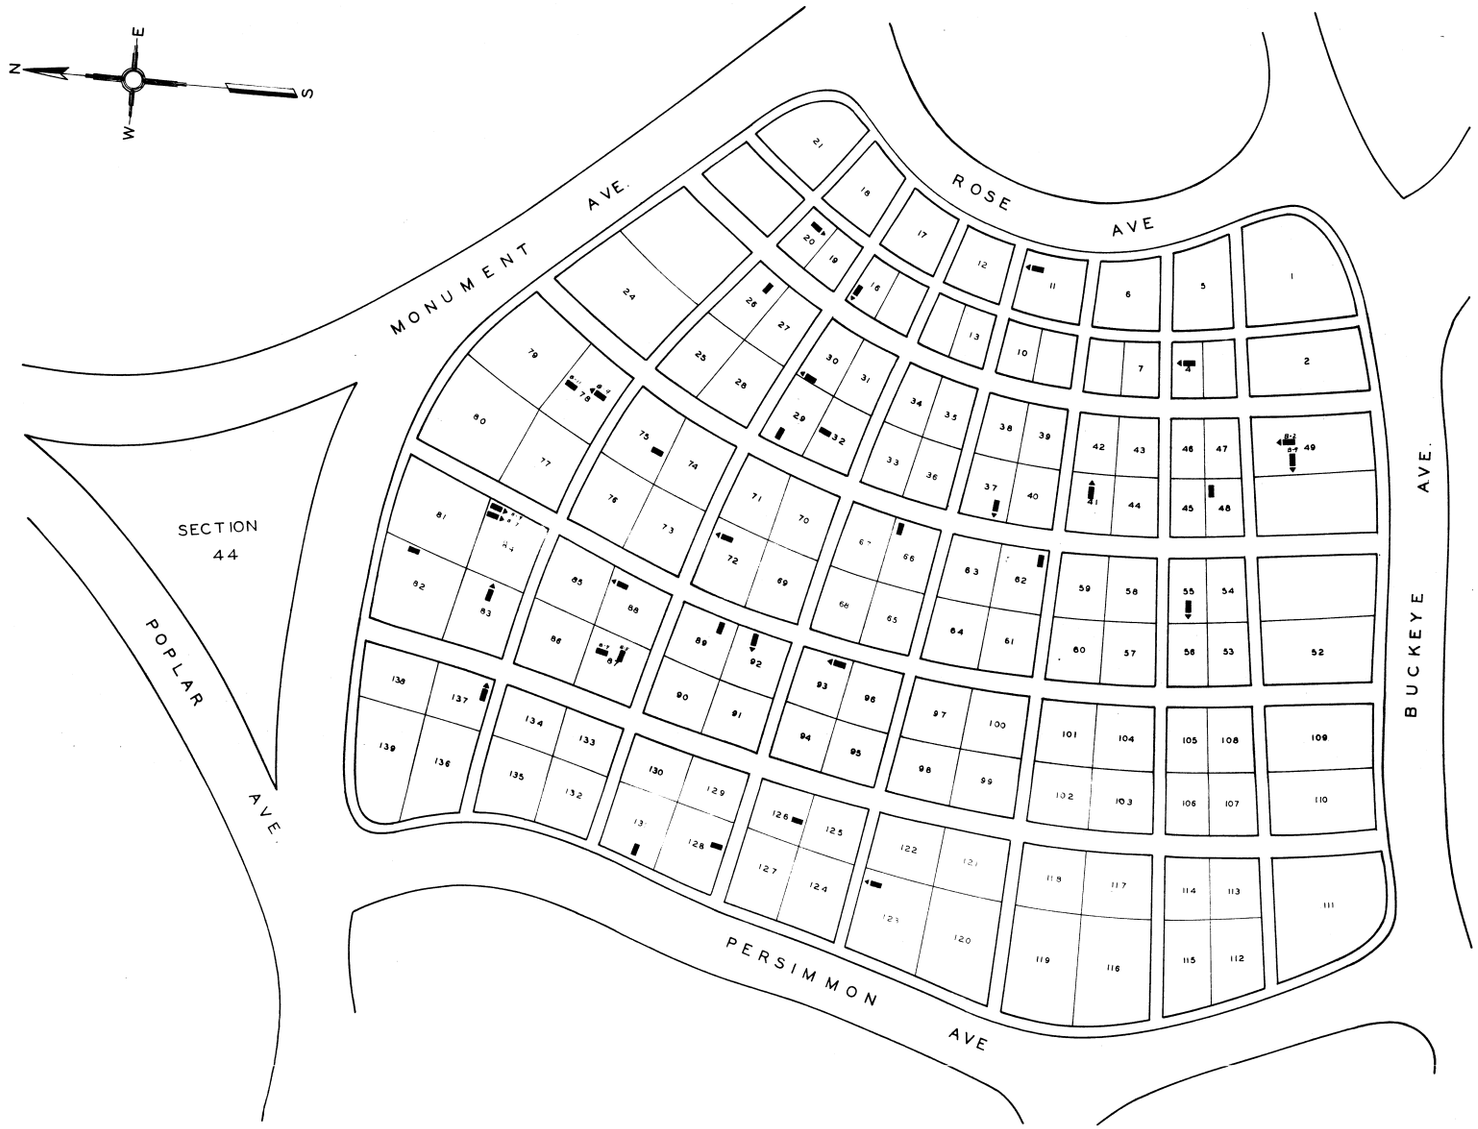

SECTION 43 & 44
SCALE 1"=20'

SPRING GROVE
PAGE 402

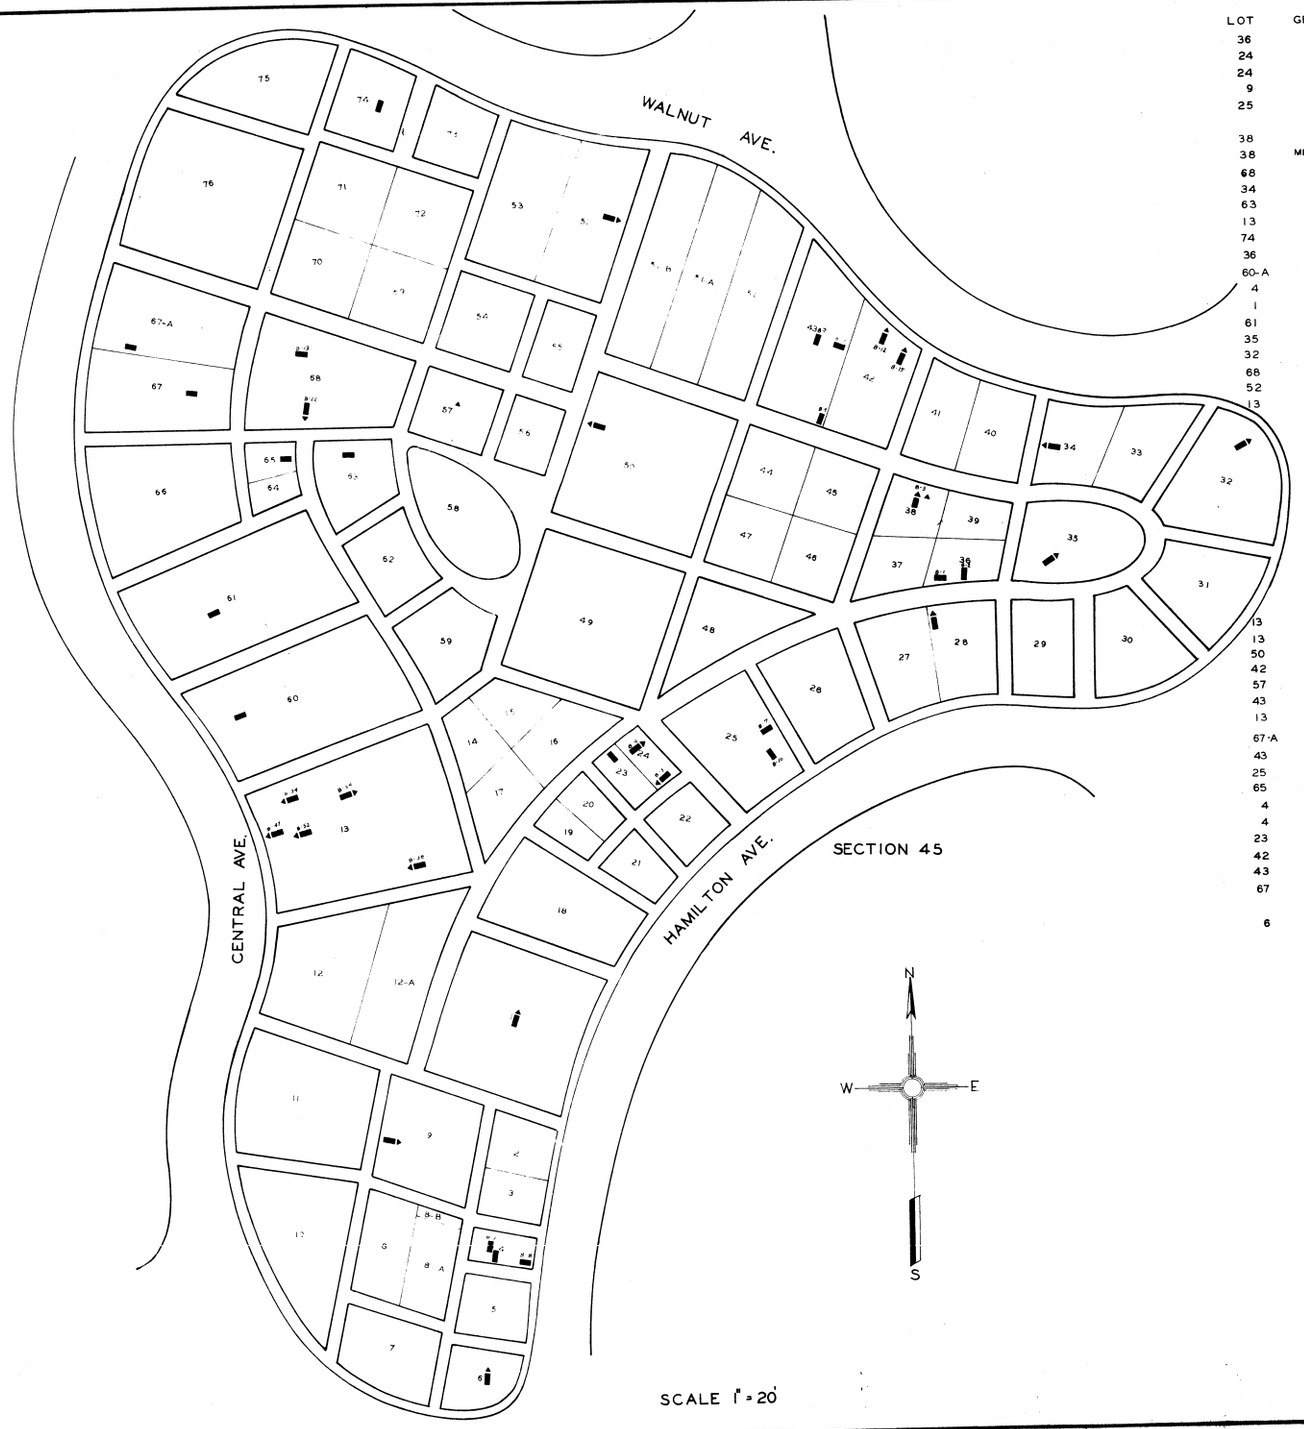

LOT	GRAVE	WAR	NAME
36	B-1	(1)	CHAPIN LUCIUS
24	B-4	(19)	CHOATE EVAN P.
24	B-5	(19)	CHOATE HARRY C.
9	B-6	(10)	CLARK NAT.
25	B-7	(19)	ELSTNER GEO. R.
	B-13	(19)	EVANS THOM. E.
38	B-3	(19)	GRAY DAV. A.
38	MEMORIAL	(19)	GRAY WM. H.
68	B-13	(18)	GRAHM WM.
34	B-5	(19)	HALDEM R. A.
63	B-4	(19)	HOLLAND PALMER
13	B-47	(19)	HUBBELL JOHN M.
74	B-1	(19)	JOHNSON HENRY M.
36	B-2	(10)	KEMPER EDW. Y.
60-A	B-7	(19)	LONG CHAS. H
4		(1)	MERCER JOHN
1	B-1	(10)	PIERCE JOS
61	B-14	(19)	RANKIN OLIVER
35	B-3	(19)	RICHARDSON LOYAL C.
32	B-7	(19)	SARGEANT WM. H.
68	B-22	(19)	SMITH JOHN M.
52	B-7	(19)	SMITH WM. A.
13	B-38	(19)	STEPHENSON A.
13	B-52	(19)	STEPHENSON CHAS. W.
13	B-54	(19)	STEPHENSON HENRY W
50	B-12	(19)	WALKER JAS. B.
42	B-15	(19)	WOESTER EDW.
57	MEMORIAL	(31)	RICKETTS LANGDON L.
43	B-17	(33)	SMITH HENRY E.
13	B-34	(33)	CARR HARRY E.
67-A	B-3	(19)	BONTE PET. C.
43	B-9	(19)	EASLY JOHN W.
25	B-16	(19)	ELSTNER WM. C.
65	B-6	(18)	GOCKEL WM.
4	B-3	(10)	HEIGHWAY JOHN
4	B-8	(19)	HUFFORD ALEX. W.
23	B-5	(19)	LOUDERBACH MICH'L.
42	B-12	(19)	MEYER CHAS. F.
43	B-7	(19)	RIDDLE SAM. M.
67	B-5	(18)	WILSON WM. B.
6	B-2	(10)	RUFFIN WM.

SCALE 1" = 20'

SPRING GROVE
PAGE 494

LOT	GRAVE	WAR	NAME
29	B-2	(19)	ARMSTRONG AARON T.
29	B-1	(19)	ARMSTRONG WM. P.
109	B-3	(19)	BERTRAM PET.
73	B-12	(19)	BIGLER OSCAR
	B-17	(19)	BRENT COLUMBUS P.
128	B-1	(19)	BRICKETT HENRY L.
96	B-2	(19)	BURDICK WM. H.
122	B-9	(19)	CARRICK A. L.
128	B-3	(19)	CONKLYN J. P.
43	B-9	(19)	COX RICH.
36	B-6	(19)	DISERENS CHAS. M.
63	B-14	(19)	DOMM GILBERT L.
63	B-7	(19)	DOMM JOHN L.
115	B-9	(19)	DUNLAP ROB. E.
11	B-9	(19)	DONNELLY AUG.
140	B-1	(19)	ERWIN SAM. C.
89	B-4	(19)	EVANS AL. M.
99	B-2	(19)	FORCE M. F.
84	B-3	(19)	FOSTER CHAS. H.
149	B-6	(19)	FRIEND CHAS. H.
86	B-29	(19)	GANO JAC. W.
134	B-13	(19)	GARRISON JAS. A.O.
14	B-1	(19)	GAULT WM. D.
88	B-1	(18)	GIBBS JOHN W.
115	B-11	(19)	GILMORE GEO. S.
12	B-7	(19)	HAUGHTON JOHN E.
116	B-10	(21)	HALSEY HENRY A.
23	B-7	(19)	HEWETT WM. T.
40	B-13	(19)	HILL NAT. S.
43	B-2	(10)	HILTON JOHN
88	B-4	(19)	JACOBS SAM'L. D.
123	B-5	(18)	JONES JOHN
41	B-2	(19)	JORDAN CHAS. W.
41	B-6	(19)	JORDAN DAN. B.
74	B-14	(19)	KERR ROB'T. H.
14	B-7	(19)	LARSH LOUIS A.
30	B-2	(19)	LATHROP WM. H.
77	B-12	(19)	LONG CHRIS. C.
60	B-7	(16)	LYONS JAS.
60	B-3	(10)	LYON MOS.
83	B-3	(19)	MARTIN JAS.
71	B-10	(19)	MASTERSON EDW. W.
138	B-6	(19)	McGREW MARSHALL
29	B-7	(19)	McINTYRE JAS. H.
76	B-3	(19)	MOORE JAMES
62	B 7	(19)	MURDOCK CHAS. C.
24	B-12	(19)	POTH JOHN
31	B-5	(19)	PURLIER HENRY
58	B-8	(19)	POWELL WATT E.

LOT	GRAVE	WAR	NAME
61	B-4	(1)	VATTIER CHAS.
113	B-7	(19)	WILTSEE JOHN A.
113	B-8	(19)	WILTSEE JOHN F.

LOT	GRAVE	WAR	NAME
39	B-1	(19)	RILEY ROBT.
3	B-2	(19)	RITTWEGER GE[illegible] C.
3	B-6	(19)	RITTWEGER WM. R.
148	B-9	(19)	SANFORD FRANKLYN
63	B-16	(19)	SKILLMAN ISAAC N.
3	B-5	(19)	SMITH ISAAC S.
42	B-12	(19)	SMITH OLIVER A.
106	B-7	(19)	SMITH WM. C.
106	B-6	(19)	SMITH WM. C.

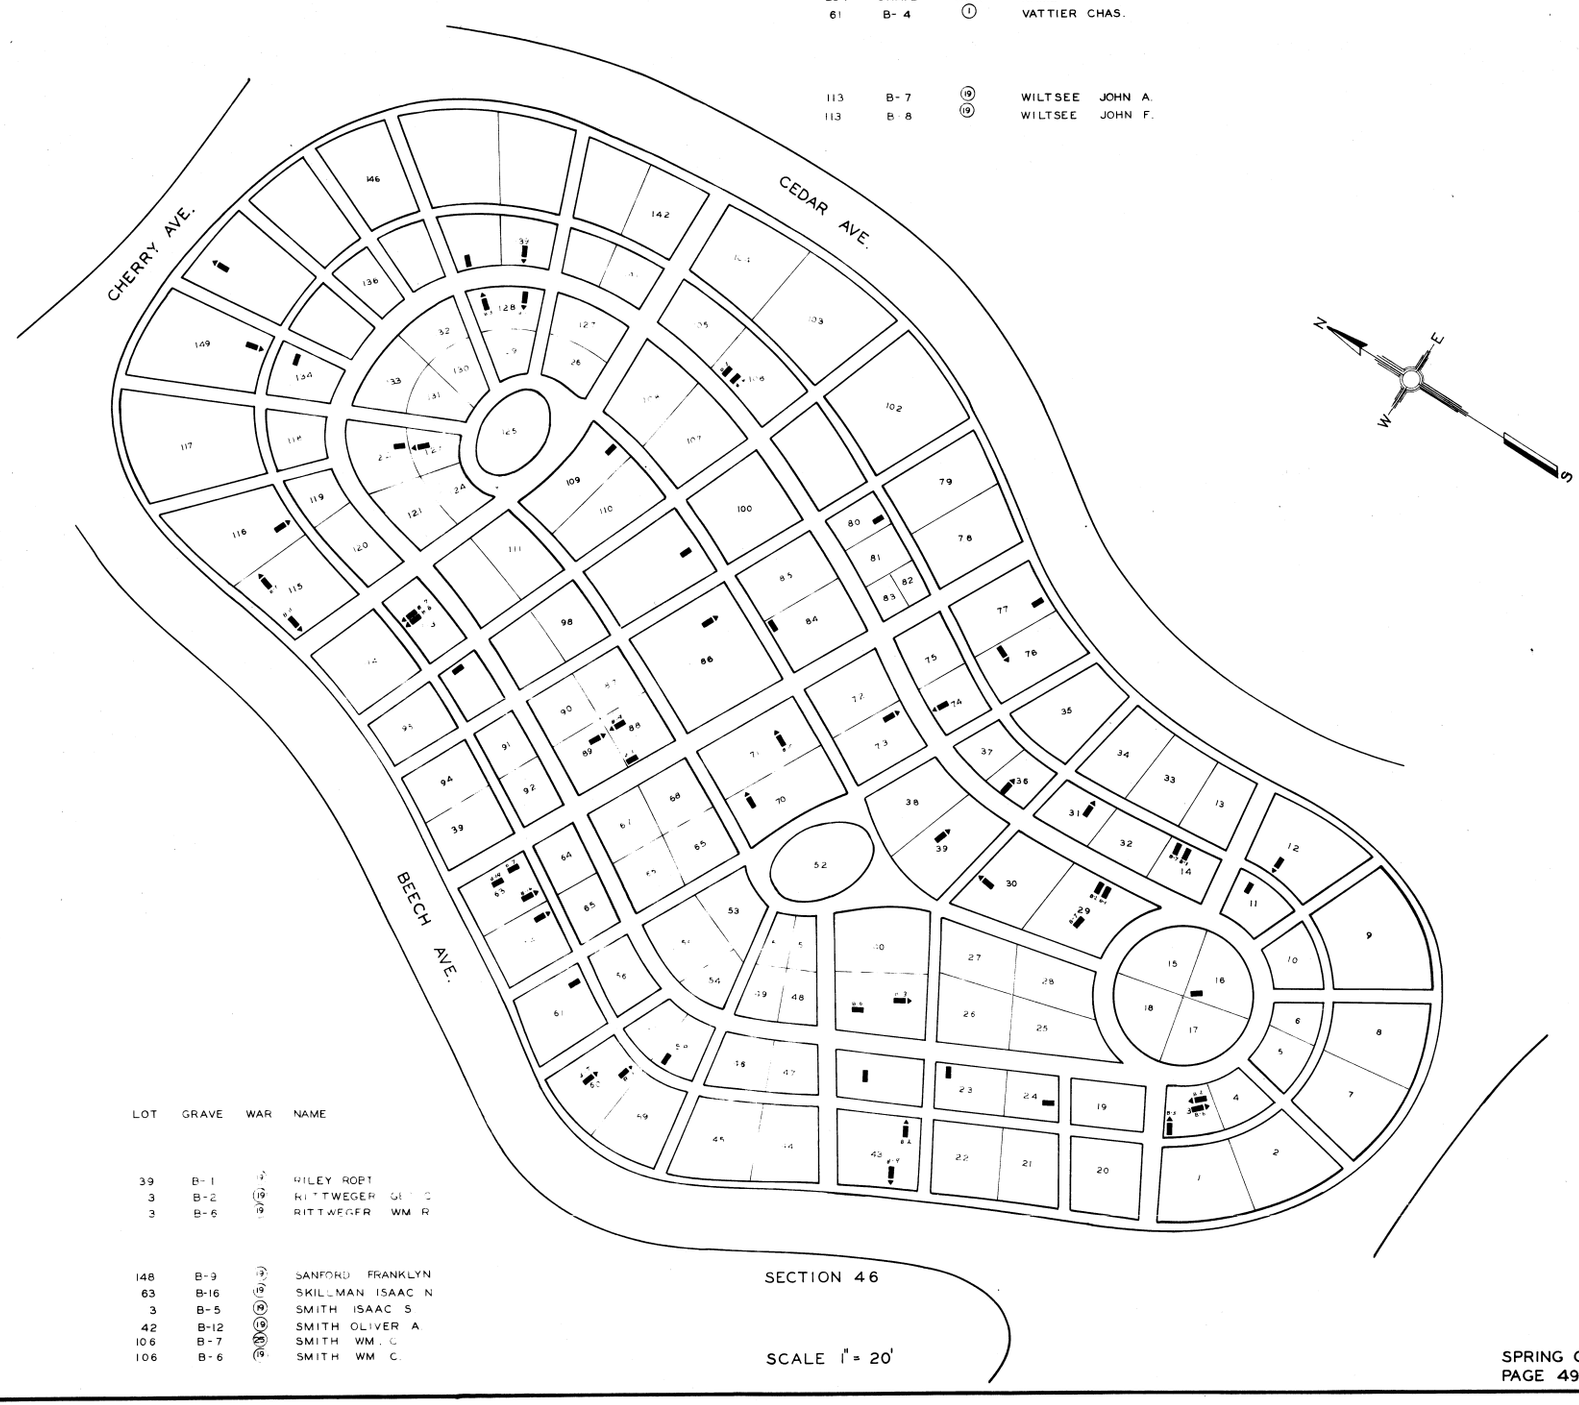

SECTION 46

SCALE 1" = 20'

SPRING GROVE SECTION 47

LOT	GRAVE	WAR	NAME
88	B 5	(19)	ATHEARN STEPHAN M.
7	B 10	(19)	ANDERSON ALB. D.
2	B14	(19)	BAGLEY
74	B 9	(19)	BLINN ARORY K
33	B 4	(19)	BOWEN GEO. G.
56	B 21	(19)	BUDD GEO. W.
19	B 9	(19)	BASCOM GEO.
21	B13	(19)	CARSON ROBT. C.
21	B11	(19)	CARSON WM.
9	B 6	(19)	CRAWFORD JOHN
41	B 11	(19)	CUSTARD DAVID C.
41	B 4	(19)	CUSTARD JOHN N.
80	B15	(19)	DAVIS CHAS. W.
25	B 6	(19)	DUNNING SAML. H.
60	B12	(19)	DUVALL NELSON
60	B14	(19)	FRANKLIN JAS. C.
84	B15	(19)	GATES JOHN O.
24	B 10	(19)	HALLABIRD LUCIUS H.
25	B 7	(19)	HEFFERMAN THOMAS W.
87	B 6	(19)	IRWIN GEO. A.
29	B 1	(19)	JONES ALFD.
83	B 5	(19)	JONES CHAS. D.
83	B 8	(19)	JONES GEO. W.
83	B 4	(19)	JONES WM. G.
83	B 13	(19)	JONES JOHN J.
70	B 6	(19)	KELLY HENRY P.
77	B 19	(19)	KENNETT HENRY G.
62	B 6	(19)	KING JULIUS A.
53	B15	(31)	LABOITEAVY HENRY C.
60	B 22	(19)	LINDSEY JOS. W.
10	B13	19	MS GILL ROBT. C.
61	B 9	19	MS GREGOR ALEX.
61	B 8	19	MS GREGOR CHAS. F
61	B 4	19	MS GREGOR WM.
77	B24	(5)	MURRY ALEX.
77	B 5	(10)	MANSFIELD JOHN F
65	B 6	(19)	PETERS J. H.
43	B10	(19)	PATTEN ANDREW H.
22	B13	(19)	POLLOCK GEO. W.
67	B10	(19)	POLLOCK JOHN
60	B 6	(19)	RYAN W.M.
45	B 5	(19)	SANDMAN LOUIS
64	B 4	(19)	SHILLITO GEO.
64	B 7	(19)	SHILLITO JOS. S
55	B 3	(14)	SMITH WM.
26	B17	(25)	SPEAR WM. H.
4	B 5	(19)	SWIFT EDWIN E.
6	B 4	(19)	TAYLOR LESTER L.

SECTION 56

LOT	GRAVE	WAR	NAME
12	B12	(19)	TOWNSEND WM. C.
7	B17	(19)	WILLIAMS EBENEZER
2	B 6	(19)	WILLIAMS ELMER W.
62	B 5	(19)	WIRTHWEIN JOHN A.
62	B26	(23)	WIRTHWINE HARRY H.
73	B-1	(2)	SMITH JOHN S
45	B17	(19)	SCHRODER JOHN
80	B 4	(1)	SLOATE PHIL.

SECTION 56

GRAVE	WAR	NAME
B-3	(19)	STONE GEO.

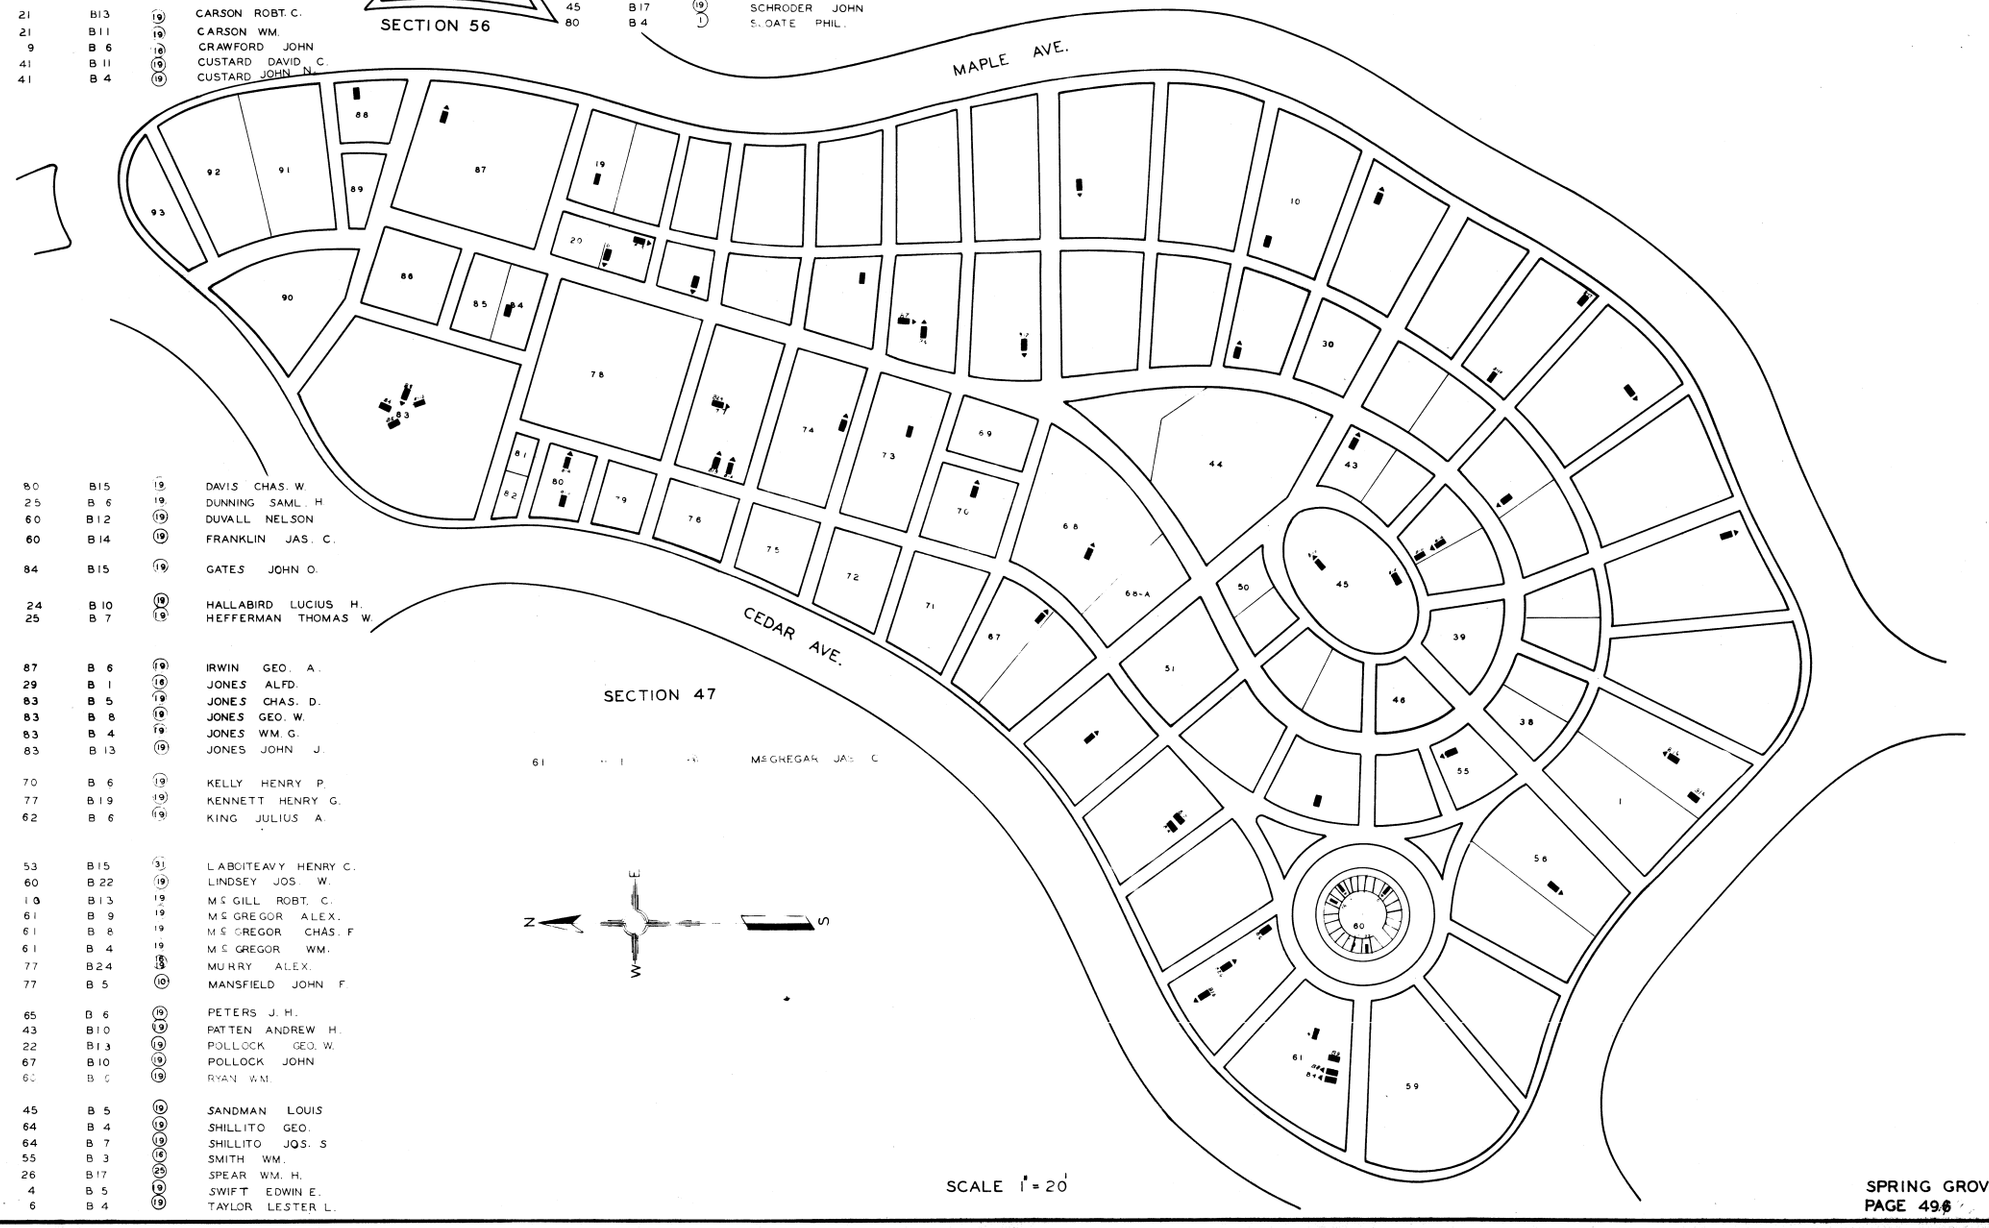

SCALE 1" = 20'

SPRING GROVE
PAGE 49.6

LOT	GRAVE	WAR	NAME
164	B 8	(19)	AIKEN CHAS. W.
40	B 5	(19)	ALLEN LOUDON S.
86	B 6	(19)	ALLEN SAML.
128	B 1	(16)	ARCHER JOHN R.
123	B 8	(19)	AUSTIN JAS. W.
136	B 5	(19)	BATEMAN EDW.
54	B 5	(19)	BROWN LORENZO
31	1	(19)	CALLAHAN JAS.
190	B 2	(19)	COLE CHAS. H.E.
190	B 3	(19)	COLE GEO. W.
98	B 1	(16)	CARWFORD JOHN
120	B 9	(25)	CULLEN CHAS.W.
110	B 8	(9)	DIETERLE ANDREAS
68	B 8	(19)	DOBBINS GEO. H.
68	B 3	(19)	DOBBINS WM. H.
192	B 2	(19)	EVANS HERM. C.
103	B 1	(19)	FOUTTY GEO.
109	B 8	(19)	FRITZ FRED'K. R.
158	B 5	(9)	HOLLIDAY JOHN C.
54	B 10	(19)	HOWELL HARVEY
54	B 1	(19)	HOWELL THOMAS J.
143	B 5	(19)	JOHNSTON JAS.
29	B 11	(19)	JOHNSTON SAML.
115	B 5	(19)	LYNN GEO.
115	B 2	(19)	LYNN JAS. E.
196	B 2	(9)	McBRIDE JAS. S.
196	B 5	(19)	McBRIDE JOHN
33	B 4	(19)	McCOMAS WM. R.
6	B 6	(19)	MOODY GEO. A.
6	B 5	(19)	MOODY JOHN W.
84	7	(19)	NEELY WM. V.
191	B 3	(19)	PATTERSON JOHN K.
88	B 1	(19)	POMEROY CHAS. W.
197	B 8	(19)	RANDALL ALVIN C.
29	B 7	(19)	REED WM.
60	B 1	(19)	REINICKE FRED'K.
140	B 4	(19)	SHEPARD GEO. C.
129	B 5	(19)	SKEAN JOHN S.
153	B 11	(19)	SMITH CHAS. A.
179	B 6	(16)	SMITH ISAAC.
92	B 7	(19)	STANHOPE W.
150	B 5	(9)	STEPHENSON JOHN R.
173	B 1	(9)	SYMMES H. E.
199	B 3	(19)	THOMPSON JAS.
176	B 9	(19)	WAFFENSCHMIDT FRED'K
	B 5	(19)	WEBER HENRY F.
158	B 4	(19)	WILSON JOHN R.
	B 3	(19)	ZUMMBUSH JOSEPH.
109	B 9	(19)	ALLENDORF HY.
16	B 4	(19)	BERNARD LEROY S.
193	B 9	(19)	BLACKBURN EDW.
154	B 7	(19)	CARTER JOS. H.
154	B 9	(19)	CARTER WM.
81	B 8	(19)	GUSWEILER DANL.
108	B 12	(25)	HENDLEY FRANK W.
159	B 5	(15)	HENRY JOHN
113	B 4	(19)	JACKSON CHAS. H.
137	B 16	(19)	KRENTZ DANL.
122	B 1	(19)	LINDSAY JAS. P.
48	B 5	(19)	SALMON WM. D.
22	B 14	(19)	WILKEY THOS.

LOT	GRAVE	WAR	NAME
23	B-6	(9)	SHOEMAKER EDW.
196	B-1	(15)	McBRIDE JAS.

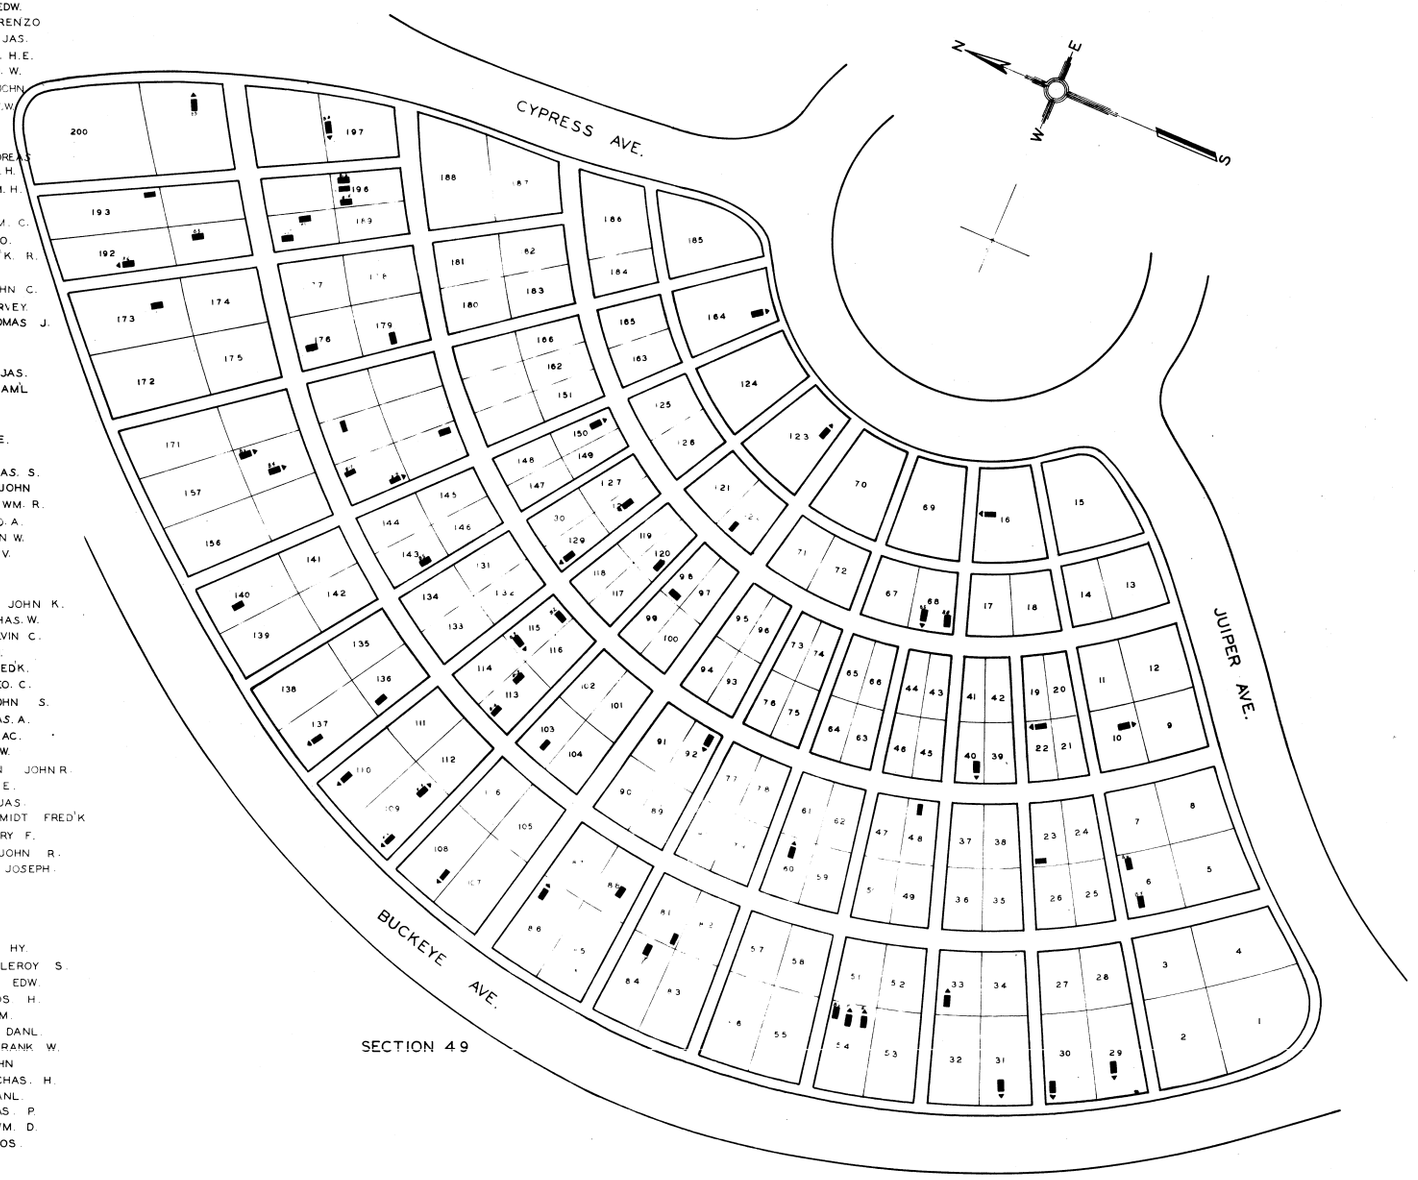

SECTION 49

SCALE 1"= 20'

SPRING GROVE
PAGE 497

LOT	GRAVE	WAR	NAME
81	B-22	19	BAIRD WM.
95	B- 3	19	BAKER AL. R.
60	B- 5	19	BRENNAN JOHN
20	B-22	19	CASE THOM. J.
135	B- 5	19	CASSELL JACOB W.
77	B- 8	19	COMPTOM JOHN
47	B-37	19	CRANE HENRY L.
89	B-10	19	ELLIS LEWIS W.
26	B- 8	19	GAITHER WILLSON B.
28	B- 9	19	HOFFNER CLARKSON
28	B 12	19	HOFFNER MARTIN V. B.
112	B- 4	19	HORTON WM. H.
62	B- 15	19	HULL JOHN E.
120	B- 10	21	JOHNSON JOHN R.
120	B- 6	19	JOHNSON JOHN W.
50	B- 4	19	KING CHARLES N.
40	B- 4	1	LYON JAMES
47	B-38	19	LUPTON THOM. N.
105	B- 10	19	MANN WM. A.
98	B- 9	19	MARVIN JOHN J.
93	B-67	19	MC GECHIN THOM. H.
124	B- 11	19	MC GOWAN JOHN H.
109	B- 1	19	MURDOCH THOM. F.
47	B-13	19	NEASE ISAAC P.
129	B- 10	19	NIEMAN SAM.
129	B- 5	19	NIEMAN THEO. F
53	B- 5	19	SEDAN JAS P.
26	B- 9	19	SHEPPARD SAM. C.
49	B-22	19	SHERWOOD JAS. E.
18	B- 5	19	SIMMONS LEWIS
45	B-20	19	SNELL BAKER DAVID L
63	B- 5	19	STEWART ARCHIE Y.
37	B- 2	33	STRONG A. R.
73	B- 7	19	TAYLOR THOM. B.
31	B- 9	19	THOMPSON ALEX'D L.
34	B- 2	19	TOZER EDGAR
20	B-16	19	WALKER JAMES
43	B-23	19	WOLF CHARLES A.
134	B- 4	19	WRIGHT NATHANIEL
84	B-54	19	GRAHAM HENRY Y.
1	B-1	19	RILEY POBT. T
66	B-4	19	SEELEY GEO.
84	B-59	4	AMMEN JACOB
49	B-1	10	SPOONER REED
49	B-26	21	SPOONER WM. R.
44	B- 3	10	STONE ETHAN
32	B-15	19	WHITAKER JOS.
78		19	WULSON EUGENE
30	B-10	25	ALLAN JOHN E
63	B-1	19	STEWART DAN'L. V.
66	B-9	19	THORNTON G. P.
86	B-2	19	TRACY FRED'K. C.
109	B-5	19	MURDOCK JAS. E.

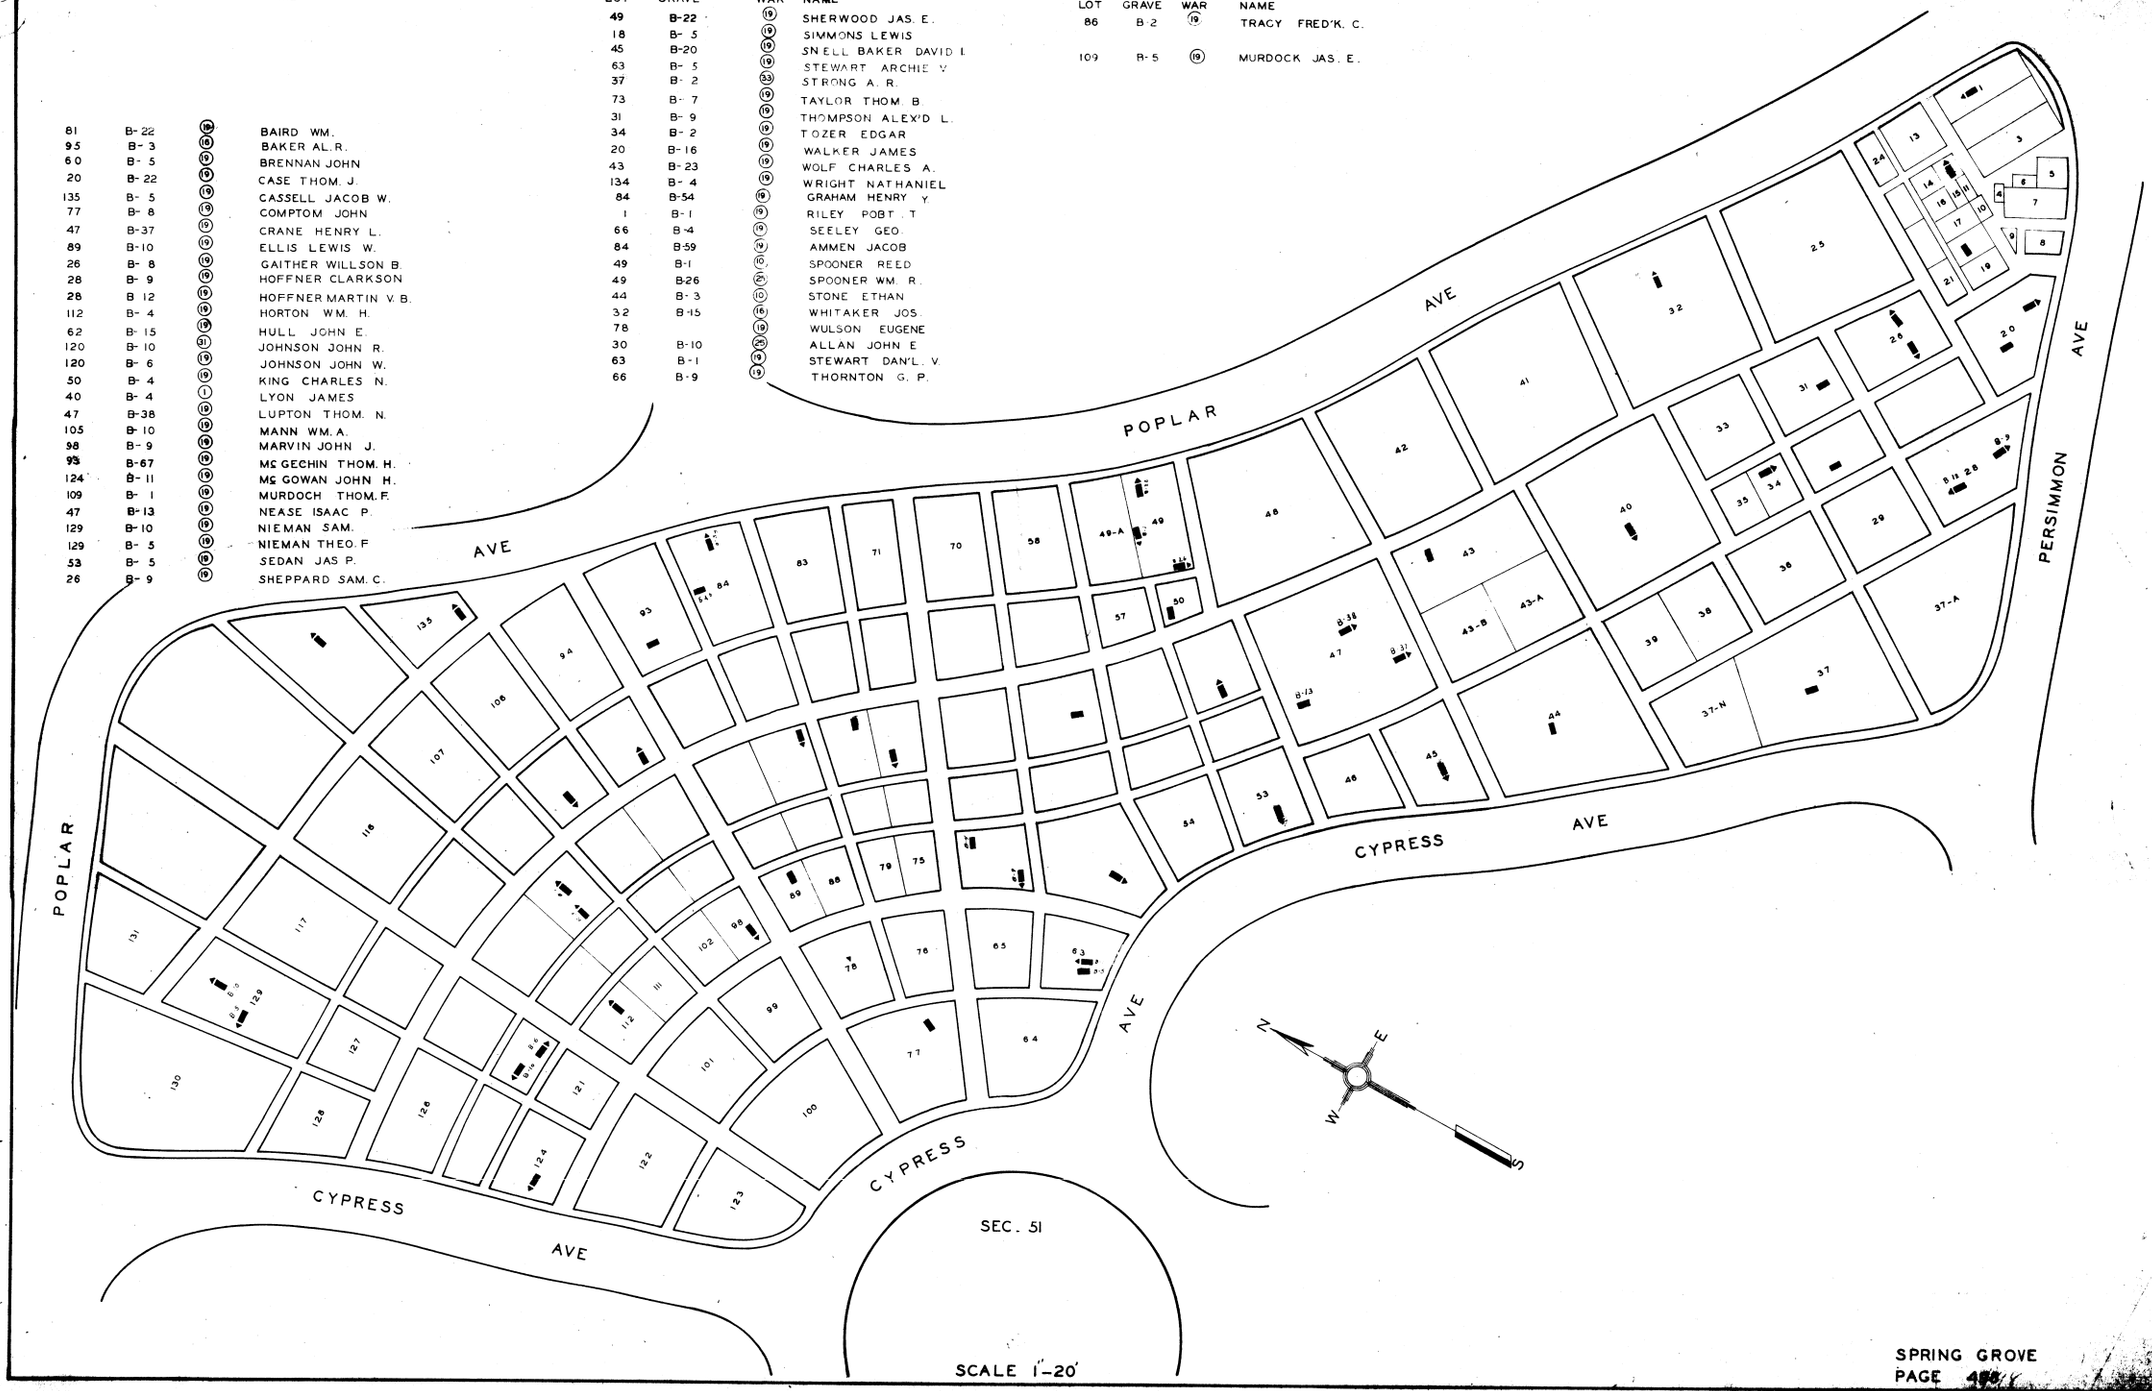

SCALE 1"-20'

SPRING GROVE
PAGE 49

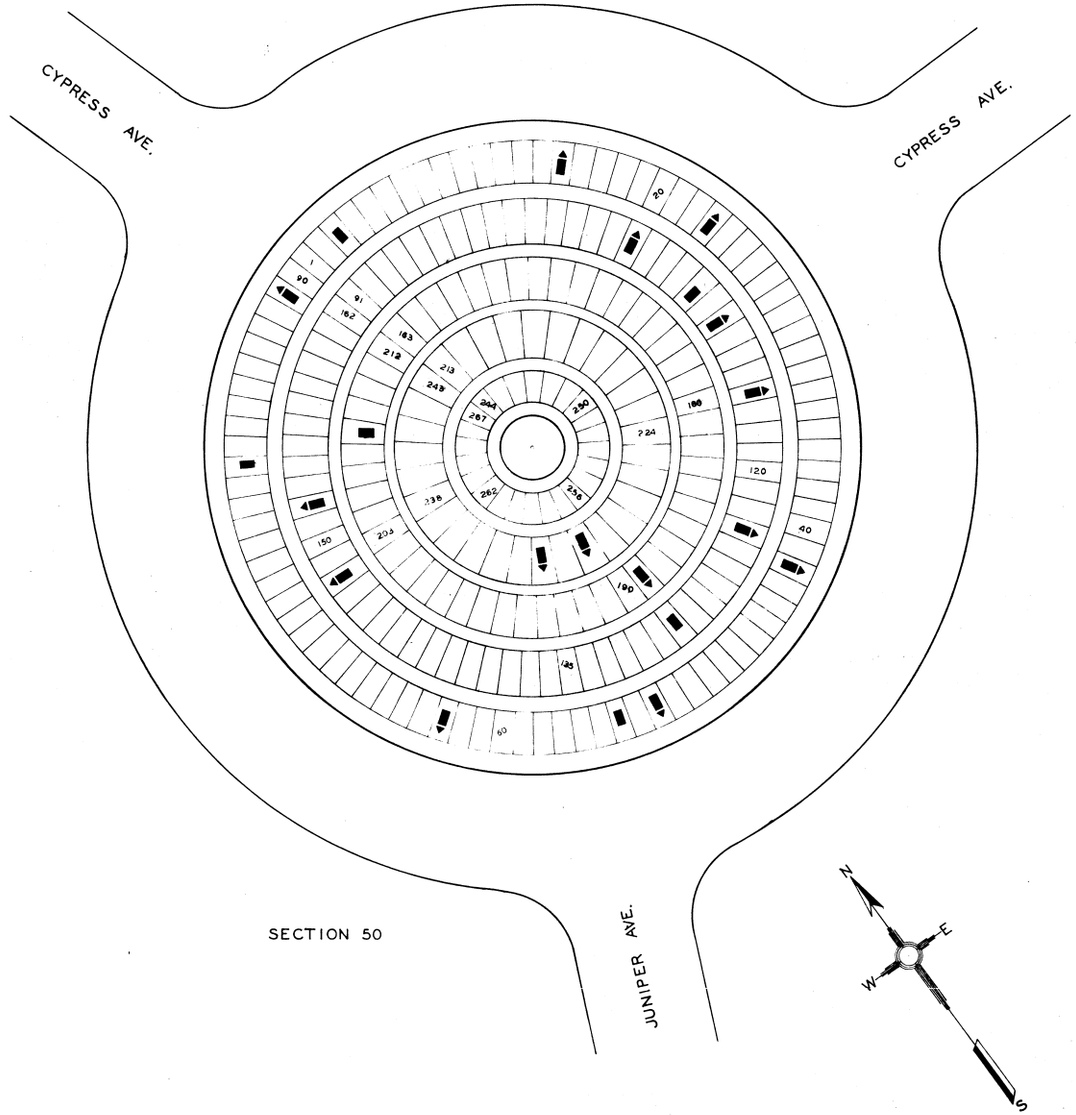

LOT	GRAVE	WAR	NAME
	15	(19)	BROWN THOM. F.L.
	189	(19)	BUECHE BALTHASER
	42	(19)	CRAWFORD JOHN
	230	(19)	FECKER CONSTANTINE
	63	(19)	HALL JOS. F.
	129	(31)	HOOG AL. M.
	123	(28)	KISSANE THOM. F.
	208	(19)	LILLIE GEO. W.
	106	(19)	MAST WM. H.
	116	(19)	MILLER CHAS. S.
	23	(19)	NORRIS ARETAS H.
	52	(19)	RUEHL JOHN
	222	(19)	SCHULMEYER WM.
	110	(19)	STREETER JAS. F.
	148	(19)	UHL ADOLPH ALIAS ADOLPH AHILE
	3	(19)	BAUMGARTNE CHRISTIAN
	152	(19)	FEHRING HENRY
	89	(19)	GABLE CHRIS.
	112	(19)	OSTENDORF WM.
	54	(19)	SCHROEDER HENRY
	80	(25)	STOCKS EDW. O.

SCALE 1" = 20'

SPRING GROVE


WALNUT AVE.
POPLAR AVE.
N
E
W
S
SECTION 52
SCALE 1" = 20'
SPRING GROVE
PAGE 500

SPRING GROVE **SECTION 52**

LOT	GRAVE	WAR	NAME
73	B-10	(19)	ASHBURY JOHN A.
174	B-8	(19)	ALLEN WM.
1	B-10	(25)	ATKINSON P.
36	B-26	(31)	BATES T. M.
36	B-21	(19)	BANKS JEDEDIAH C.
5	B-9	(19)	BATES CHAS. F.
36	B-1	(1)	BATES ISAAC
5	B-10	(19)	BATES THURSTON
71	B-19	(19)	BOYD THOM.
85	B-4	(19)	BROWN PAT.
50	B-8	(19)	BUDD PET. R.
117	B-12	(19)	BURUSALL SAM. T.
57	B-10	(19)	BROWN MAT'H.
105	B-3	(19)	CARPENTER DAN.
169	B-11	(19)	CILLEY GREENLEAF
102	B-11	(19)	CRUM GEO. C.
54	B-8	(14)(19)	EATON HENRY G.
8	B-3	(10)	FERGUSON WM.
34	B-8	(19)	FORD AUGS. C.
55	B-17	(19)	GUTHRIE JAS. V.
55	B-16	(25)	GUTHRIE VERNER H.
98	B-13	(19)	HARRISON WM.
98	B-9	(19)	HARRISON JOHN
40	B-3	(19)	HOLROYD EDW.
198	B-7	(18)(19)	HOLLIDAY JOS
185	B-6	(19)	JACKSON JOHN
28	B-3	(19)	JOHNSON BEN. A.
98	B-7	(19)	JOHNSON THOM. J.
2	B-13	(19)	JOHNSTON WM.
193	B-4	(19)	JONES I. N.
70	B-11	(19)	KELLY ALONZO K.
101	B-12	(19)	KING GEO. I.
78	B-7	(19)	KIERSTED J.
64	B-11	(18)	LAWRENCE JOHN H.
25	B-22	(14)	LAWSON JOHN
110	B-6	(19)	LITTLE CHAS. H.
185	B-9	(19)	LOVELL EDW. D.
46	B-1	(10)	MARTIN JOHN
151	B-15	(19)	MAXWELL SID. D.
177	B-1	(10)	McFARLAND STEP.
165	B-14	(19)	MEARS WM. C.
116	B-8	(19)	MILES ABIJAH J.
64	B-7	(19)	MOORE JOHN C.
126	B-7	(19)	MORRIS CHAS. W
112	B-13	(19)	MORRIS CLARENCE
112	B-14	(19)	MORRIS WM. R.
181	B-6	(19)	MOSHER WM. W
35	B-5	(19)	McLEISH JOHN
171	B-3	(16)	McCORMIC SAM'L.
177	B-1	(16)	McFARLAND STEP.
152	B-8	(19)	NEFF GEO. W
151	B-15	(19)	NEFF WALLACE
53	B-13	(19)	NELSON THOM. J.
26	B-10	(19)	NORRIS WALT. J.
156	B-10	(19)	OSBORN THOM. H.
38	B-10	(19)	OLIVER EDW. W.
133	B-17	(31)	PADDACK CLIFF D.
19	B-5	(19)	PARKER JOHN K.
62	B-24	(19)	RENNER JAC. F.
153	B-8	(19)	REEDER CHAS. A.
165	B-1	(19)	REYNOLDS JAS. M.
15	B-4	(19)	RIELEY GEO. E.
15	B-5	(19)	RILEY CLINT. J.
180	B-6	(19)	RICE CHAS.
95	B-3	(19)	RICHARSON DAV.
145	B-2	(19)	RICHARSON WM.
182	B-3	(19)	RICHARDSON WM. B.
161	B-10	(19)	SEYMOURE MANLY T.
85	B-9	(19)	SHARP JOS.
44	B-11	(19)	SIMPSON E. M.
129	B-7	(19)	SMILEY SAM.
155	B-7	(25)	SMITH MARK D.
155	B-7	(19)	SMITH THOM.
178	B-9	(19)	STEVENSON SAM. H.
165	B-12	(19)	SMITH GEO. W.
102	B-9	(19)	TUCKER RICH.
102	B-18	(19)	TURNER AM. H.
125 A	B-2	(19)	TOY [illegible]
173	B-1	(1)	WALLACE JOHN S.
134	B-7	(19)	WEEKS WM. H.
20	B-3	(19)	WESTSTONE JOHN C.
171	B-13	(19)	WHITE AMBROSE
7	B-3	(19)	WEST ISSAC. E.
5	B-19	(19)	YOUNG WM.

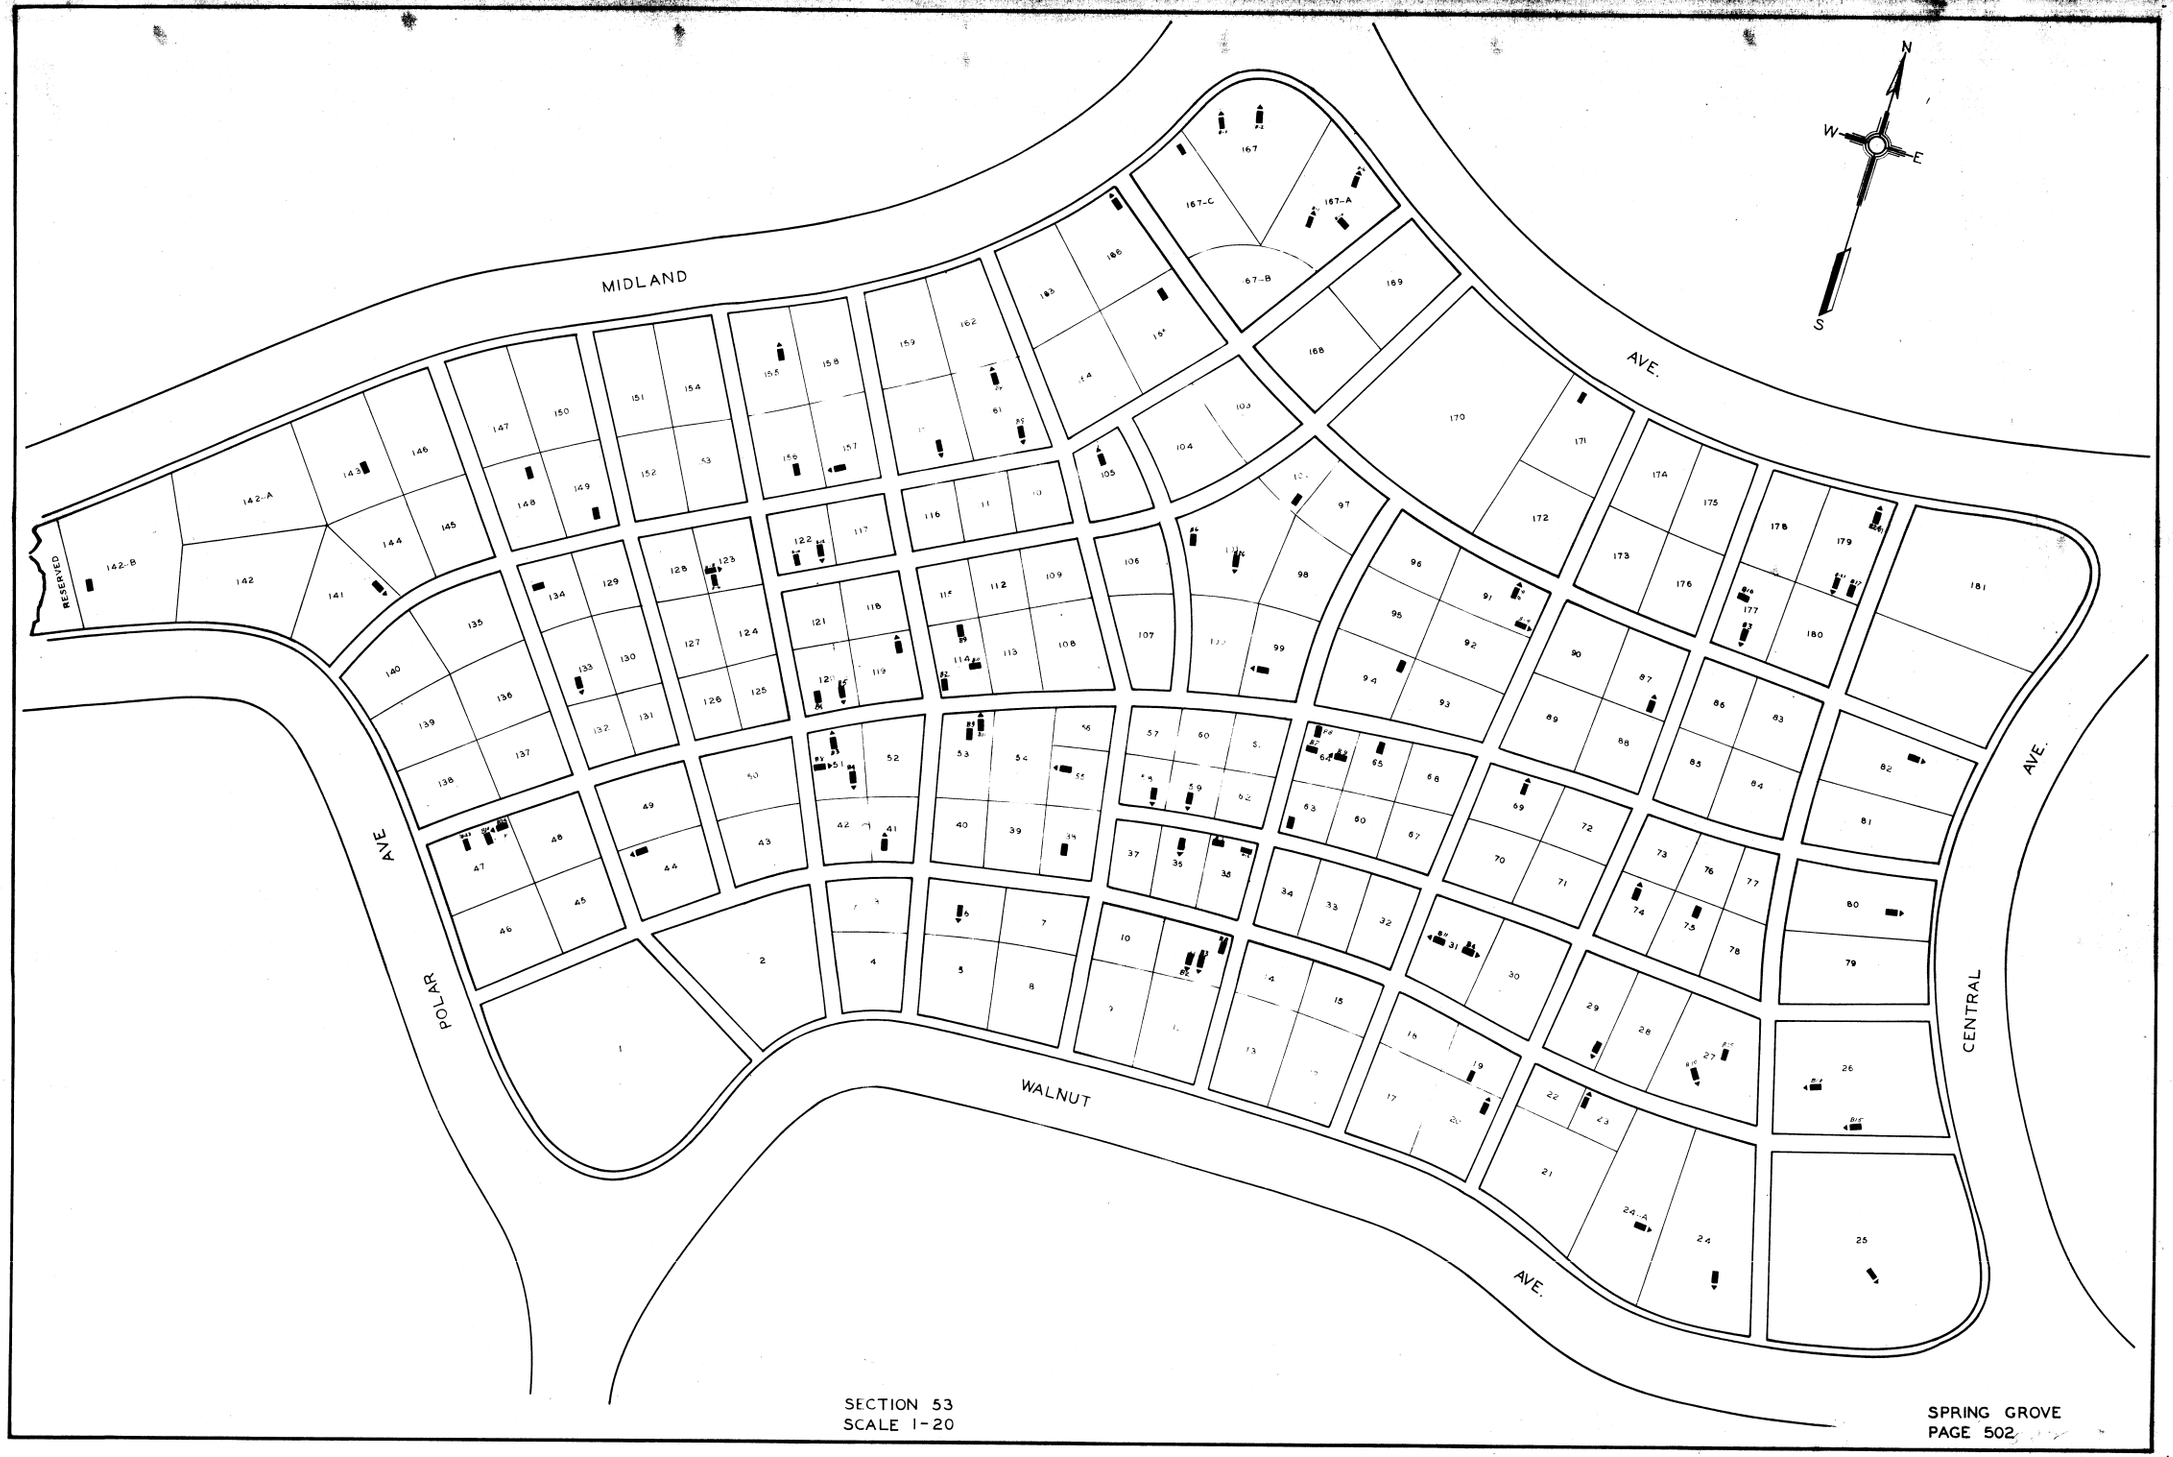

SECTION 53
SCALE 1-20

SPRING GROVE
PAGE 502

SPRING GROVE SECTION 53

LOT	GRAVE	WAR	NAME
47	B 10	(19)	ASSEL FREDK.
47	B 23	(25)	ASSEL FREDK.
35	B 6	(19)	AMBACH HY. J.
142-B	B 24	(31)	BABBITT PETER T.
160	B 8	(19)	BOGART JAS.
59	B 5	(19)	BASSON AUGST. R.
167-C	B 6	(19)	BAXTER ROBT. G.W.
19	B 2	(19)	BEST ADAM
29	B 3	(19)	CALDWELL SAM'L
166	B 6	(1)	CARY CHRISTOPER
102	B 1	(19)	CLARK HENRY C.
143	B 2	(19)	COLLINS HENRY E.
6	B 7	(18)	CRANE WM. E.
91	B 6	(18)	COX JACOB D.
172	B 2	(19)	DAVID WM. H
114	B 2	(19)	EVANS WM. H
149	B 2	(19)	FAEHR HENRY
24A	B15	(19)	FOX GEO. B.
58	B 6	(19)	FULLERTON GEO. W.
171	B 6	(25)	HILL FREMONT
167	B 2	(19)	HICKENLOOPER ANDREW
120	B 4	(19)	HOOD GEO.
55	B 7	(19)	HOPPER R.H
24	B14	(18)	HUNTING OLIVER P.
167	B 5	(24)	HICKENLOOPER SMITH
69	B 1	(18)	HILDRETH FRANKLIN
122	B 10	(19)	HOER PHIL.
161	B 6	(19)	JONES JOS. A
114	B11	(18)	JONES JOHN E.
155	B 1	(19)	JOHNSTON WM. B.
63	B 3	(19)	KAISER FRANK
51	B 4	(19)	KESTNER JOHN R.
157	B 9	(19)	KING SAML. J.
23	B 10	(19)	KIESEWETTER CHRIST F.
53	B 9	(19)	LEWIS CHAS. A.
53	B11	(25)	LEWIS CHAS. H
26	B10	(19)	MARTIN JACOB
26	B15	(19)	MARTIN LAFAYETTE
87	B11	(19)	MATHEWSON LEWIS W.
179	B17	(19)	MILLER HENRY
119	B 7	(19)	MILLER JOS. W.
20	B10	(25)	MILLER WM. E.
167-A	B 6	(18)	McGILL AMZI
123	B 6	(18)	MEACHAM FRANK W.
179	B 21	(18)	MILLER WM. C.
27	B-25	(31)	McCORD F. L.
165	B 4	(19)	NASMYTH ALEX. H.
64	B 9	(19)	PARKER JOHN C.
64	B 7	(19)	PARKER WM. F.
114	B 9	(19)	PASSELL GEO. W.
133	B 4	(19)	PATTISON THOS.
51	B 3	(19)	PEPPER JOHN W.
167-A	B 1	(10)	PINE BENJ.
74	B13	(19)	REES JOHN E.
74	B 1	(19)	REES WM. C.
148	B 2	(19)	RINEAR WM. L.
31	B11	(19)	ROBB JOHN M.
31	B 4	(19)	ROBB ALEX.
141	B 8	(19)	ROCAP LEVIS.
99	B13	(31)	ROGERS ROBT. S.
135	B 2	(19)	ROSEBOOM WM. H.
51	B 8	(19)	SCHILLING GUS.
82	B13	(10)	SEIBEL FREDK. M.
36	B 8	(10)	SHROBE THEOPHILUS
156	B 4	(19)	SHUMARD AUSTIN B.
105	B 1	(19)	SLOUGH JOHN P.
11	B 3	(19)	SMITH DAN'L.
11	B 8	(19)	SMITH JACOB H.
11	B 2	(19)	SMITH PHIL.
35	B 3	(19)	SPURLOCK THOMAS.
179	B24	(19)	STEELE JOHN Q.A.
27	B 0	(3)	STEEP GEO. W
	B 11	(19)	STEWART BENJ. B.
38	B 1	(19)	STEWART EDW
94	B 8	(19)	STEWARD JAS. E.
65	B 9	(18)	STOTHFANG LOUIS.
167A	B10	(19)	STOUT JOHN
25	B 7	(18)	SMITH A H.
120	B 5	(19)	UPPERMAN JOHN F.
47	24	(19)	WAGONER JOHN
80	B 3	(18)	WARD ROBT. D.
122	B 2	(19)	WEINHEIMER VALENTINE
41	B 3	(19)	WHITE B JOHN
177	B 2	(19)	WILLIAMS JOHN R.
177	B 3	(19)	WILLIAMS WM. H.
64	B 8	(19)	WRIGHT JOHN W.
123	B 8	(10)	ZIEGLER JOHN A.
101	B 6	(18)	ZIMMER CHAS.
101	B 26	(24)	ZIMMER WM. H.
91	B 4	(10)	COX THEO

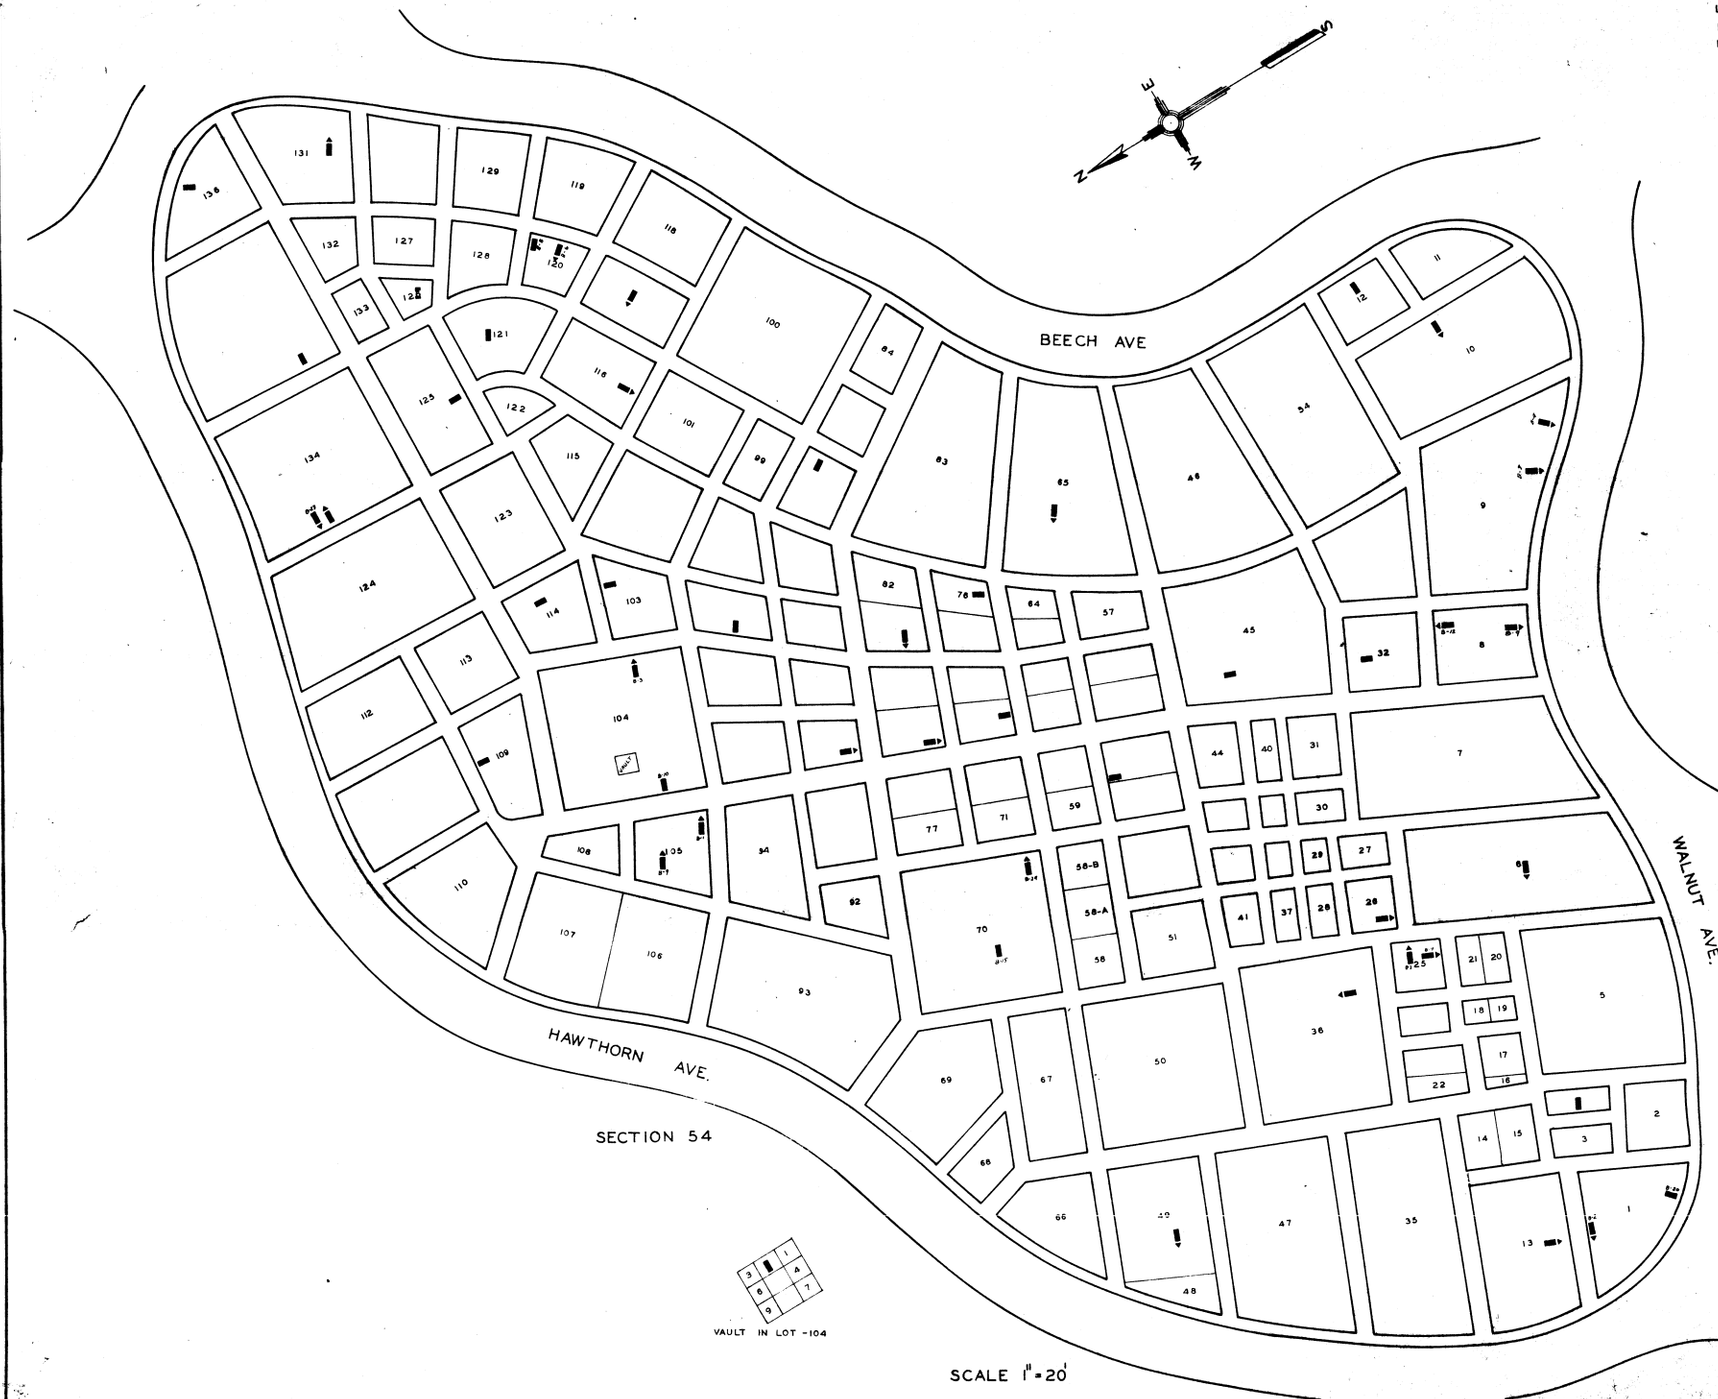

LOT	GRAVE	WAR	NAME
104	B-3	25	AMES FRANK D.
125-B	B-9	19	ANDRESS AUG. H.
8	B-9	19	BIGGS JAS. H.
76	B-4	19	CAMPBELL ALEX.
121	B-8	19	CAMPBELL WM. H.
116	B-9	19	CIST HENRY M.
10	B-7	19	COLEMAN JOHN W.
70	B-15	19	COOK CHAS. W.
70	B-24	19	COOK WM. C.
8	B-12	19	DAVIS WALT. L.
45	B-1	19	FINDLAY JAS.
134	B-23	19	FORBES GEO. W.
109	B-20	19	GAULT EDM. S.
12	B-4	19	HAND SPEN. C.
97	B-19	19	HERRON THOM. G.
1	B-2	19	HUMBLE JOHN
1	B-20	19	HUMBLE JAS. M.
65	B-12	19	JOHNSTON SAM.
131	B-18	19	KRAFT FRANK A.
26	B-11	21	LAKEMAN JOS. R.
114	B-15	19	LOHN WM. A.
81	B-8	19	PAVER CHAS. N.
4	B-5	19	PHILLIPS CHAS.
104	B-10	19	REA DAVD.
105	B-9	19	SHADDINGER WM. H.
105	B-1	16	SHAINGER ANDY. J.
79	B-8	21	SHOBROOK JOHN H.
73	B-5	19	SMITH JOSIAH
25	B-3	19	STERRETT W. K.
120	B-8	19	STEVENS WM.
49	B-18	19	TAYLOR WM. H.
103	B-8	19	WARREN EDM.
136	B-10	19	WHEELWRIGHT CHAS.
6	B-15	19	WHITAKER GEO. M.
134		19	WHITE JOHN H.
54	B-5	19	WHITESIDES CHAS. H.
66	B-9	19	WOOD CHAS. S.
9	B-9	19	WOOD WM. C.
104	B-2	19	AMES FISHER W.
25	B-9	19	FINCH GEO. M.
36	B-5	1	HORN FRED.
120	B-6		BARD SYL'V. W.
126	B-2		HARCOURT ENOCH
117	B-14		Mc NAMARA TIM. E.
13	B-5		RIDDLE HENRY A.
135	B-11		WOODRUFF WM.
90	B-8	19	BROWN FRED. W.
32	B-13	19	MARSHALL THOS.
9	B-4	19	REILEY FRANCIS A.

SPRING GROVE
PAGE 504

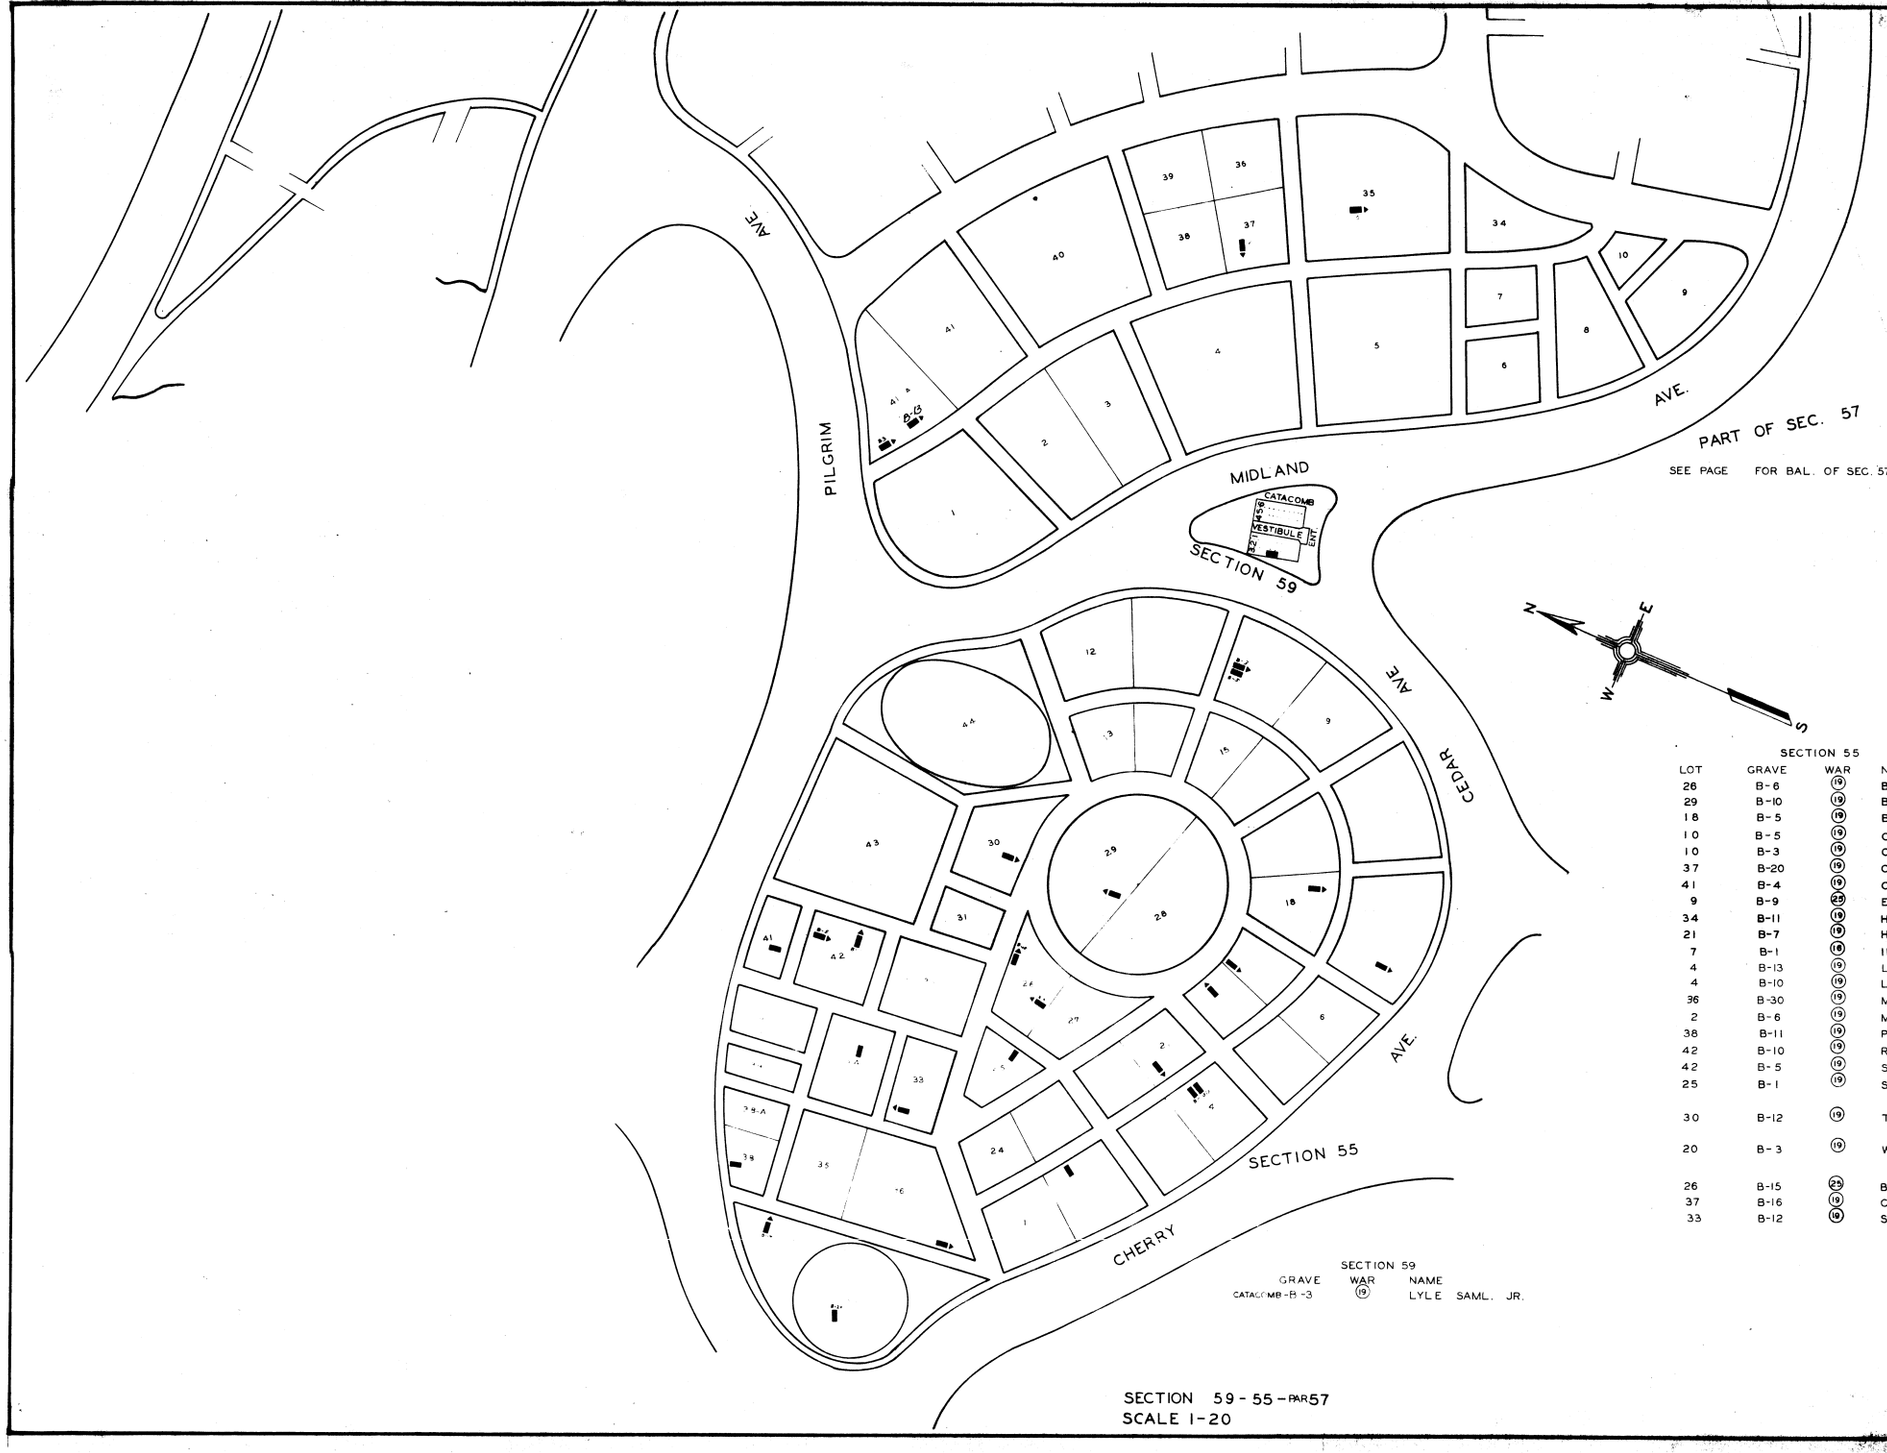

SECTION 55

LOT	GRAVE	WAR	NAME
26	B-6	(19)	BISHOP JAS. W.
29	B-10	(19)	BURTON WM. T.
18	B-5	(19)	BONSALL CHAS. P.
10	B-5	(19)	CLAY HENRY B.
10	B-3	(19)	CLAY JOHN K.
37	B-20	(19)	CARTER WM.
41	B-4	(19)	CLARK ERNEST M.
9	B-9	(25)	EVANS FRED. H.
34	B-11	(19)	HUBBELL WM. M.
21	B-7	(19)	HUBBELL CHAS. H.
7	B-1	(18)	IRWIN JAS. R.
4	B-13	(19)	LEEKE WM. H.
4	B-10	(19)	LEEKE JAS. C.
36	B-30	(19)	MORRIS ROBT. T.
2	B-6	(19)	MILLARD DELOSS A.
38	B-11	(19)	PEDIT SAM.
42	B-10	(19)	REYNOLDS JABEZ
42	B-5	(19)	SAUNDERS EDW. D.
25	B-1	(19)	SEEGAR LEONIDUS M.
30	B-12	(19)	TUCKER EDW. A.
20	B-3	(19)	WYNNE DAV. R.
26	B-15	(25)	BISHOP EDW. L.
37	B-16	(19)	CARTER JOHN
33	B-12	(19)	SWING ALF.

SECTION 59

GRAVE	WAR	NAME
CATACOMB-B-3	(19)	LYLE SAML. JR.

SECTION 59 - 55 - PAR 57
SCALE 1-20

SPRING GROVE
PAGE 505

SPRING GROVE SECTION 57

LOT	GRAVE	WAR	NAME
13	B32	(19)	ALMS HERMAN F.
30	B 5	(19)	BRAWLEY WM R.
14	B13	(19)	CARY WM.
23-T	B 1	(19)	DEVENNING JOHN
62	3	(19)	DICKSON JAS.
41A	B 3	(19)	DISIRMS EUGENE
52	B15	(31)	GATES GEO. C.
54	B 1	(19)	HUBBARD TIMOTHY
35	B 3	(19)	JOHNSON JOHN F.
23R	B 1	(19)	JONES GEO. W.
62	18	(19)	MILLER GRIFFIN F.
13	B27	(19)	MILLER WM. C.
42	INVAULT	(10)	OLIVER WM.
45	B14	(16)	PUGHE GEO. E.
68	B 2N	(19)	QUIGLEY WM.
48	B 1	(1)	RIDDLE JOHN
66	B14	(19)	RUNYAN CLAY C.
23A	B 1	(19)	SCHOLL MICHAEL
45	B23	(21)	SMITH SETH E.
21	B 6	(19)	STEDDON JOHN D.
68H	B 1	(19)	TREUSCH LEONARD
41-A	B13	(19)	VANZANDT ALFRED H.H.
68-I	B 3	(31)	WATERS ROBT. A.
59	8	(19)	WILSON ROBT. B.
21	B 3	(19)	WRIGHT HIRAM
62	16	(19)	YORKE LOUIS
23-H	B 3	(19)	CHASE WM.
88	B 8	(19)	FREY HY.
44	B 6	(19)	GRUBB JOHN
67	B 8	(19)	HOFFNER THOS. J.
49	B 13	(19)	NEWTON JOHN
19	B 6	(19)	SCHONER PAUL
71	B 5	(32)	SCHMALZ BLASIUS

LOT	GRAVE	WAR	NAME
37	B 7	(19)	HARTBURN THOS. J.
58	VAULT	(19)	MARSH WM. W.



SECTION 57
SCALE 1-20

SPRING GROVE
PAGE 506

GRAVE	WAR	NAME
211	(19)	ALBERT WILLIAM L.
545	(19)	ANDREWS WM.
529	(19)	BENGEL HENRY
439	(19)	BEST JOS.
273	(19)	BRENTUAL W.M. J.
329	(19)	CAMPBELL ROBT.
380	(19)	CRAIG SAML.
602	(19)	ECKARD PETER
89	(19)	FLUGEL JOHN
559	(19)	FAIRBANKS JOHN
63	(19)	FREESE CHAS.
53	(19)	GEIGER GEO.
517	(19)	GIERTEN MICHEL.
243	(19)	GLANDON JOE C.
276	(19)	GRANT JOHN A.
62	(19)	GRONAUER GEO.
288	(19)	GUTHRIE GEO.
186	(19)	HAEFFNER JOHN
122	(19)	HELDMAN JOE
427	(19)	HERTZBERGER CHRISTIAN
146	(19)	HASSELBECK JOHN

GRAVE	WAR	NAME
541	(19)	JOHNSON RICHARD M.
192	(19)	KENNEDY A.
500	(51)	KLEIN CHAS. E.
325	(19)	KITTERING LOU.
305	(19)	LEATHERBY STEPH. A.
426	(19)	LINCIMAN JNO
448	(19)	MGGEE JOHN
599	(19)	MGLOE JOH B
423	(19)	METCHLY JOHN
275	(19)	MAST JACOB
337	(19)	NORTON MICHAEL

GRAVE	WAR	NAME
554	(19)	REES JOHN
505	(19)	ROBINSON JOHN
397	(19)	RUSS STEPH.
28	(19)	SACHS WM. D.
476	(19)	SIMMONS JOHN L.
332	(19)	STOFFEL PETER
342	(19)	THOMPSON JAS. L.
163	(19)	WETZEL LEWIS K.
299	(19)	WILLIAMS DAN.
446	(19)	WALKE SAMUEL
319	(19)	PURDAM JOHN
291	(33)	ZECH JOE.

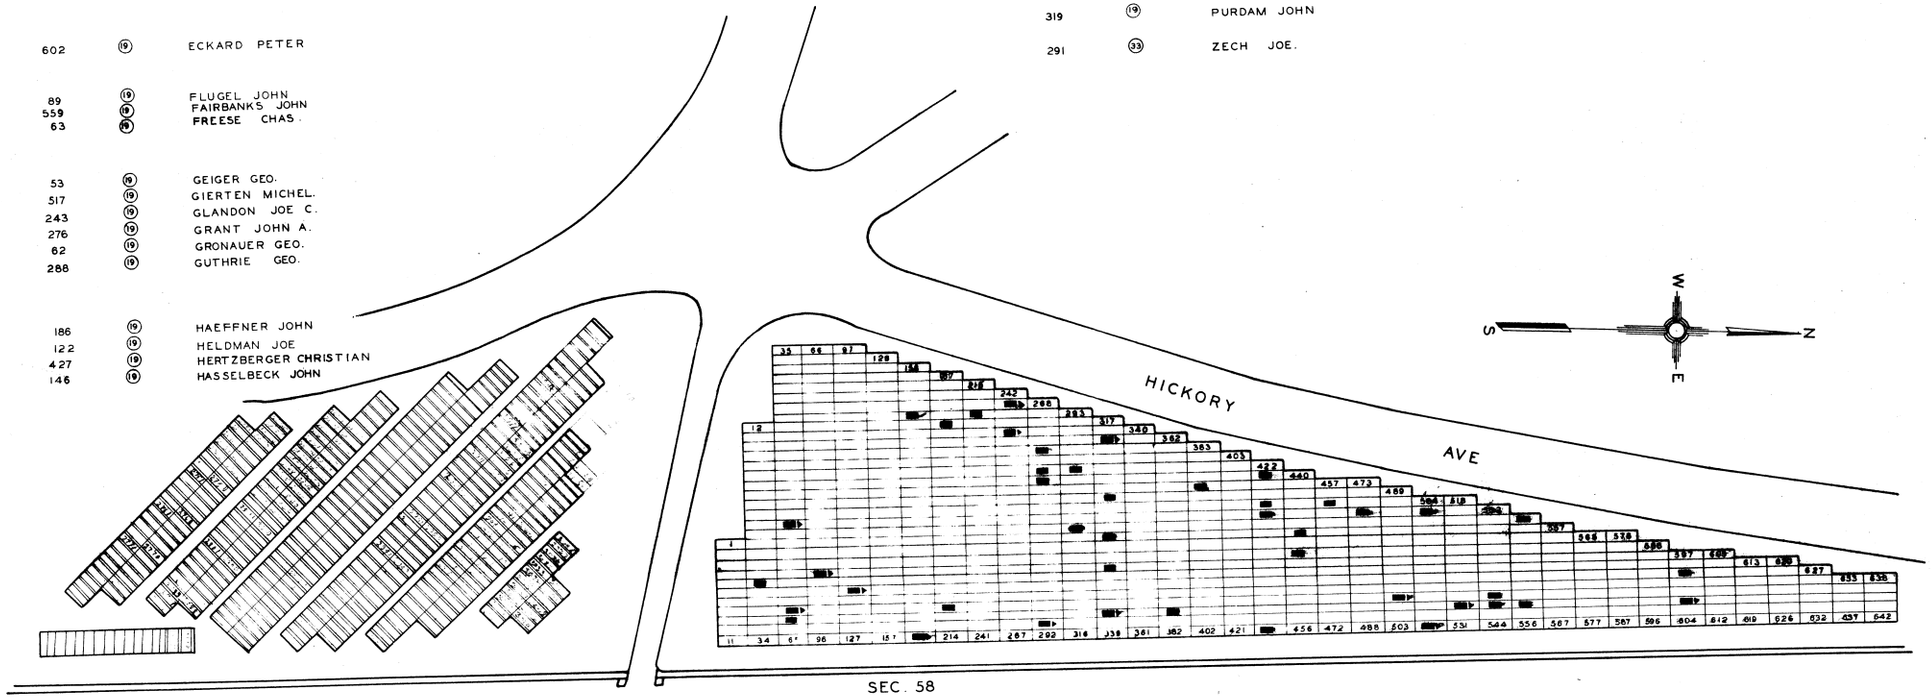

SEC. 58

SCALE 1"-20'

SPRING GROVE
PAGE 507

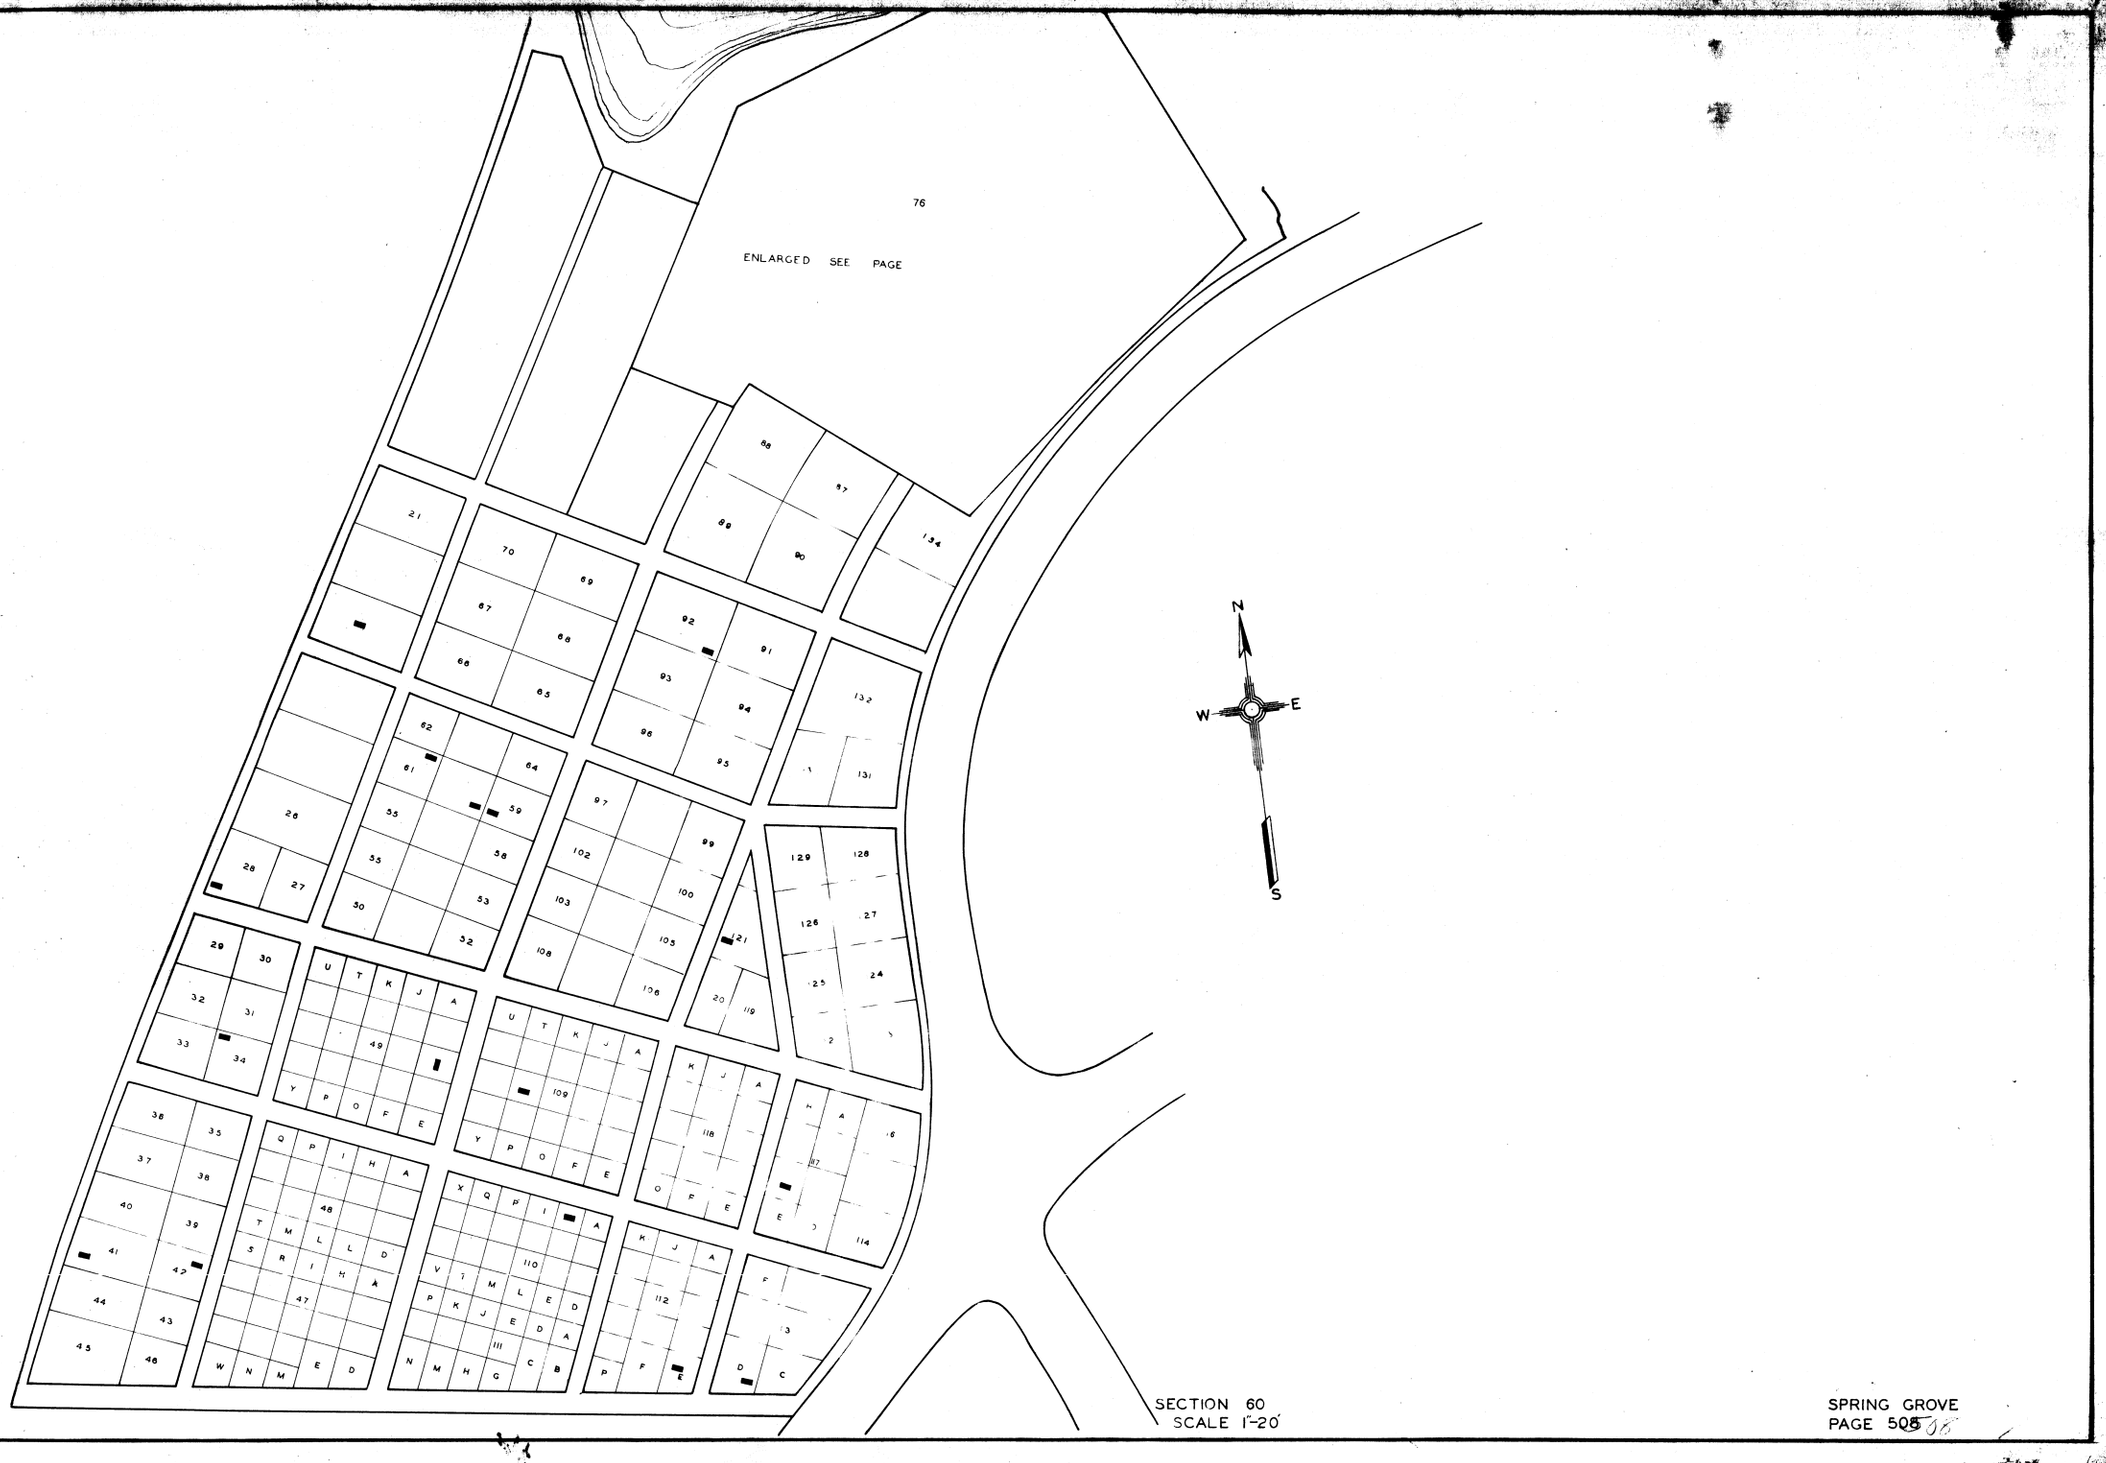

SECTION 60
SCALE 1"-20'

SPRING GROVE
PAGE 505

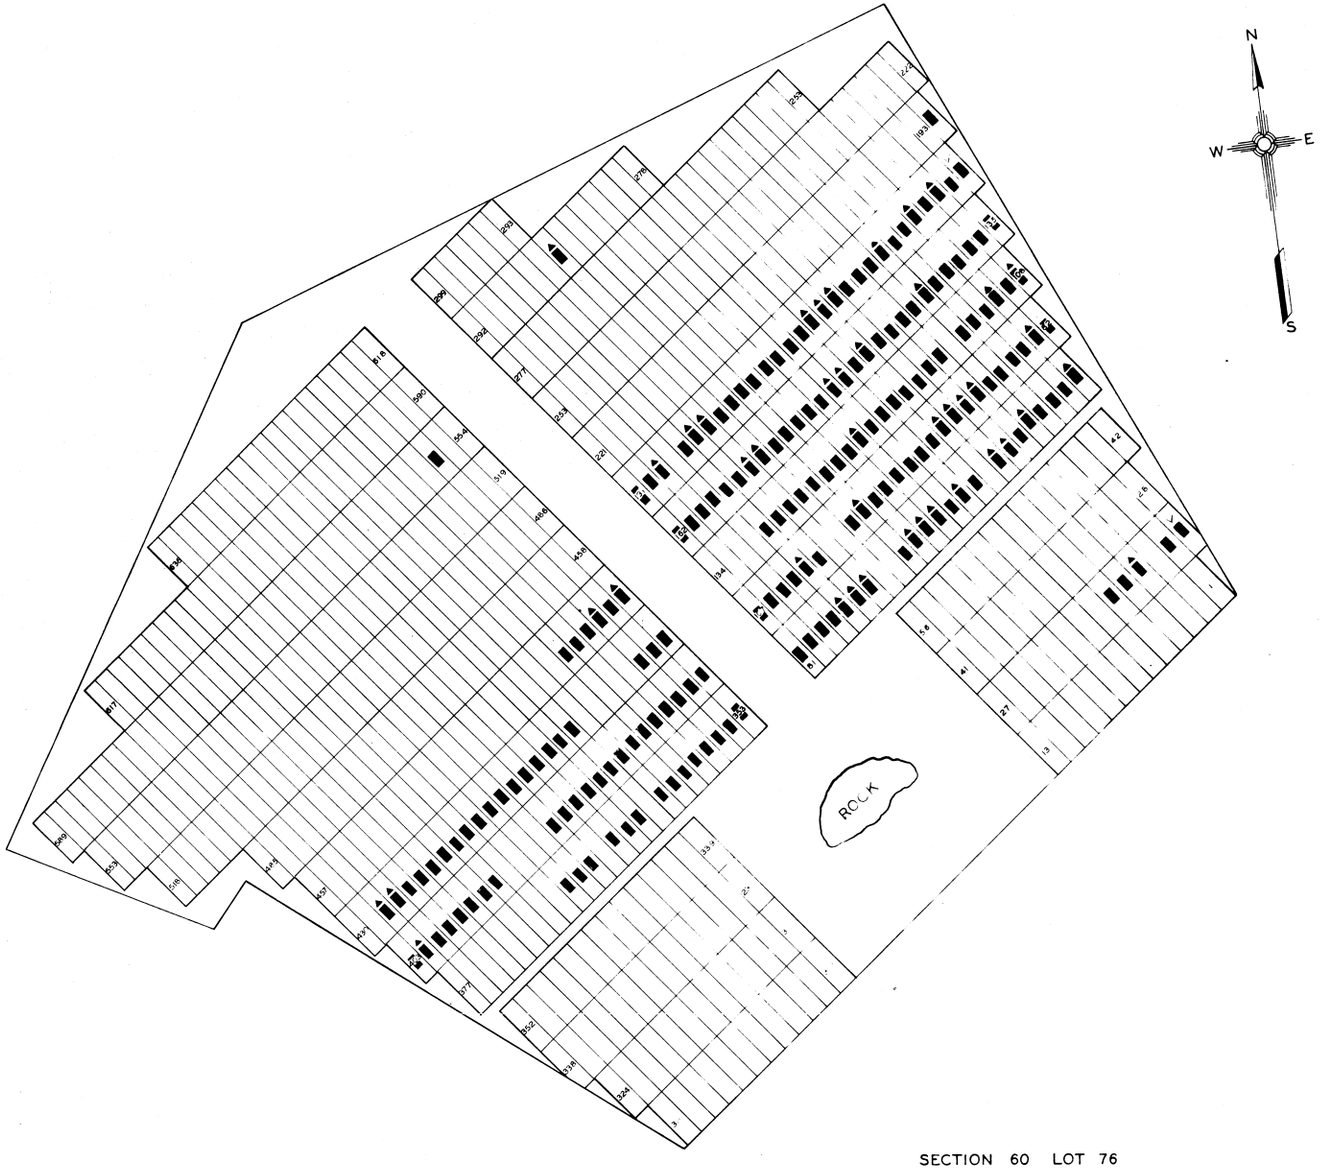

SECTION 60 LOT 76
SCALE 1-10

SPRING GROVE
PAGE 509

41-13

LOT	GRAVE	WAR	NAME
76	390	31	ARMSTRONG WM.
76	385	31	ASHLIMANN GOE.
76	167	25	ATHERRIN CLARENCE C.
34	1	19	ANDERSON GEO.
76	366	31	AVERY STAN. E.
76	99	25	BISHOP LOREN
76	14	25	BOLTON ROB. M.
76	93	31	BOWMAN JAS. L.
76	180	33	BROCK LEONARD C. E.
76	122	31	BROCK MILFORD
76	163	31	BRUNER HARVEY C.
76	400	31	BURGDORF WM. E.
76	173	25	BURNS EDW. A.
76	113	31	BURKARDT CLIFF.
76	189	26	BRODDLE CLARE T.
76	107	25	BROWN ALB. E.
23	1	19	CAREY JOHN W.
76	168	31	CASTETTER CLAUD C.
76	158	25	CLYDE FRANK A.
76	125	25	CHOWNING RISK
76	147	25	COOK LEVI
61	4	31	COBURN TROYLESS
76	81	25	CONWAY CHAS. M.
76	85	25	CONWAY JAS.
76	335	31	DAVIS ALB.
76	401	31	DAGNEY JULIUS
76	83	31	DALE LEROY
76	181	25	DAVIDSON WM.
76	178	31	DAVIS JAS.
76	381	31	DAWSON HAROLD T.
76	119	25	DIECKMANN WM.
76	185	31	DIX HENRY
76	106	33	DUNGAN WALTER C.
76	353	31	DOENCH ELMER C.
76	87	25	DE WITT ROLAND
76	175	33	DIEHL WM. R.
76	148	33	DREW DAN'L. W.
112-E	1	19	EDWARDS THOS.
76	433	25	ENGELKE VIC.
76	96	31	FINKLER CHAS. J.
76	159	31	FARDULIO PETER
76	406	31	FISHER WM. J.
76	397	31	FLOYD ROG.
76	91	31	FRIEDEL GUSTAV
76	378	33	FRITZ THOS.
113-D	1	19	FOGER THOS. R.
76	68	31	GOAD WM.
49-C		19	GOULD JOHN Q.
76	182	31	GRIFFITH GEO.
76	174	25	GELLENBECK FERD. H
76	176	31	GILBERT CLARENCE
76	177	25	GIMBRUCH HENRY
76	387	25	GODDARD HARRY
76	116	25	GRAF HENRY J.
76	418	25	GRIMERSEN FRED.
76	114	19	GROSSMAN GEO.
76	164	26	GRIMSTEAD WM.
76	422	25	GRUELLE THOS.
76	84	33	GULBE OTTO J.
76		33	GUSTAFSON AUGUST
76	151	31	HANES WM. B.
76	61	31	HAYNES FRED H.
76	414	33	HARTUPEE CARL A.
76	94	31	HEWINS HAROLD H.
76	67	31	HILLMAN SAM
76	78	31	HUFFMAN CLARENCE R.
76	[illegible]0	31	HUNT ELMORE
76	43[illegible]	31	HOMWEILER GEO H
76	[illegible]	31	HI[illegible]LEY [illegible]ARLEY
76	105	33	HAMM ELM[illegible] L
76	384	31	[illegible]OCKS HAS[illegible] L
76	130	31	HOGAN OS[illegible]AR
76	109	19	IRWAN EDW.
76	146	31	JACKSON ROB.
76	158	33	JAMESON JOHN
76	380	25	KAHLER IRA E
76	80	25	KELLER ART E
76	41[illegible]	31	KING BRONZE[illegible]
76	79	31	KLAMT HARRY F
76	14	31	KLING WM. J
76	65	31	KOARS BERNARD H
76	42[illegible]	31	KOCZOROWSKI MICHAEL
76	41	31	KREIDENWEIS EDW. A.
76	42[illegible]	31	KROPFELD FRANK A
60	B-3	31	KOENIG JOHN H. JR
41	2	19	KIRKPATRICK ALEX
76	118	25	LANG JOHN
76	76	31	LONGFROHER FRED. H
76	18	31	LAMMERS EDW. A.
76	66	31	LEMING JOS
76	69	31	LEMMON TAYLOR
76	35	31	LIGHT WM. J.
76	7	31	LINCIMAN FRED
76	190	31	LINGER JOHN B.
76	38[illegible]	31	LOW JOHN
76	97	31	LOWRICK JACKSON
76	424	31	LUHRMAN FRANK J.
76	144	31	LOSHAU LEO.
76	58	31	MASON ALB R
76	[illegible]	31	MACQUEEN WM A
76	[illegible]	31	MCSHOLLER [illegible] LEE
76	62	31	MELONOUGH JAS
76	[illegible]	31	MARIS [illegible]IA
76	[illegible]	31	[illegible]ARNOLD [illegible]OS [illegible]
76	59	31	MAN[illegible]S G
76	182	31	MARDOR[illegible] STAN
76	41	31	[illegible]A TAN
76	9	31	MA[illegible] LOUIS
76	[illegible]	31	M[illegible]CUE RUSSEL
76	40[illegible]	31	M[illegible] A[illegible]N CLARENC[illegible] G.
76	30	31	M[illegible]LISH CHAS.
76	94	31	[illegible] M[illegible]AN HOWARD H
76	15	31	M[illegible]KEY W[illegible] L.
76	[illegible]	31	M[illegible]RE EARL [illegible]
76	1[illegible]	31	MU[illegible]RE LAWR[illegible]
76	42[illegible]	31	MORTON MILTON
76	83	31	M[illegible]LLIGAN JAS. H.
76	42	31	M[illegible]RPHY JAS P
76	141	31	MYER[illegible] WALTER L.
76	6	31	MS[illegible]LA[illegible]N R.
76	413	31	[illegible]OLETON ERNEST M
76	149	31	[illegible]ILLER FRA[illegible] P
76	403	31	MITCHELL BERKIL
76	72	26	MORTON WADE V
76	39[illegible]	31	NOEL FRANK
76	92	31	NALVUNG HENR[illegible]
76	2	31	N[illegible]WEL JOHN T.
76	91	31	N[illegible]ELSEN SORIN
76	186	31	OBERTSCHEIDER OSCAR
76	98	31	OLARENSHAW EDWIN J.
76	13[illegible]	26	OWEN FRANCIS W.
76	364	31	OFFUTT ORVILLE L.
76	115	25	PARKER EDW. J.
76	192	25	PENLETON ELM.
76	420	25	PEIFFER JOS.
76	5	31	PERRY HOLLIE W.
76	187	31	PITTILLO JAS. S.
76	14[illegible]	31	POLKA PAUL
76	0[illegible]	31	PLUMMER JOHN B.
76	415	33	QUINN JOHN D.
76	127	31	REMPEL BEN'J.
76	426	31	REISING SYLV. H.
76	432	25	REDMAN MACA
76	170	31	RICHMOND EDW. R.
76	172	31	ROACH HARRY
76	88	19	ROGERS JOHN
76	137	31	ROSENBEERY WM. R.
76	169	25	ROYSTON HOWELL W.
76	86	31	SCHOCK EARL (ALIAS EARL MULLARD)
76	136	31	SAVAGE C. J.
109-R	2	19	SANDER FRD'K. W.
76	362	31	SAX GEO.
76	434	31	SAYLOR JOHN
76	153	33	SCHAFER EUG.
76	428	31	SCHMALZ JOS. F.
76	431	31	SCHOCKLEY HARRY F.
76	64	19	SCHOFIELD JOHN J.
76	104	31	SCHONER LOUIS H.
76	75	33	SCHROEDER HENRY J. (ALIAS HENRY SMITH)
76	427	25	SMITH HORACE E.
76	379	31	SMITH HARRY E.
76	13	25	SMITH JOS. P.
76	161	33	STEMICK WM.
76	57	31	STEPHEN CHAS.
76	419	31	STEPHENS VANLEY W.
76	140	31	STORER EDG. L.
76	129	31	STROTKAMP FERDN. N.
76	388	25	SUNKER OSC.
76	357	31	SEIBERT EDW. H.
76	360	26	SUMMERS ALONZO D.
76	367	25 31	SCHMIDT J. F.
76	436	25	SMITH ART. L.
76	368	25	SPURGEON WALT.
76	111	31	SHORT ROY
76	179	31	SINCERBEAN EARL
76	103	31	SMITH HAROLD L.
76	[illegible]	31	SMITH ZOLLIE M.
21	[illegible]	19	TAYLOR CHAS. E.
76	17	31	TAYLOR EDW.
76	383	31	TAYLOR ELM.
76	348	33	TACKER LINDSEY
[illegible]	39[illegible]	31	TURNER JAS
76	126	25	TRUMAN EMERALD A.
76	354	31	TIBBETT EDW.
76	4[illegible]	31	TUCKER THOS. W.
76	1[illegible]	31	TEMPLE RICH. S.
76	117	33	THELEAVEN WM.
76	90	19	WAGNER JOS.
76	160	31	WALTERS CHAS.
76	154	31	WIESTER FRANK M. JR.
76	77	25	WILLIAMS CHAS. E.
76	124	19	WILSON HIRAM D.
76	404	25	WOOD GEO. C.
76		25 31 33	WHITE HARRY B.
76	358	25	WARNELL WALT. W.
110-H	1	19	WEHRLE CHAS.
117-F	1	19	WENTZEL JAC. E.
59	4	19	WHITE CHESTER B.
76	359	25 31 33	WHITE H. B.
76	363	31	WILLIAMS AL. A.
42	2	19	WOODROW HENRY B.
76	152	25 31	WEBBERGALL VIRGIL
76	128	31	WIHLBERG EDW.
76	126	31	WALKER LEROY
76	121	31	WOLFE FRED'K.
76	62	33	WYANT CHAS. C.
76	17	31	YENISCH LILLIAN B. NURSE
92	4	31	SCHAFER EARL A.
76		25	MONTGOMERY ROB'T.
28	2	19	SNELL CHAS. B.

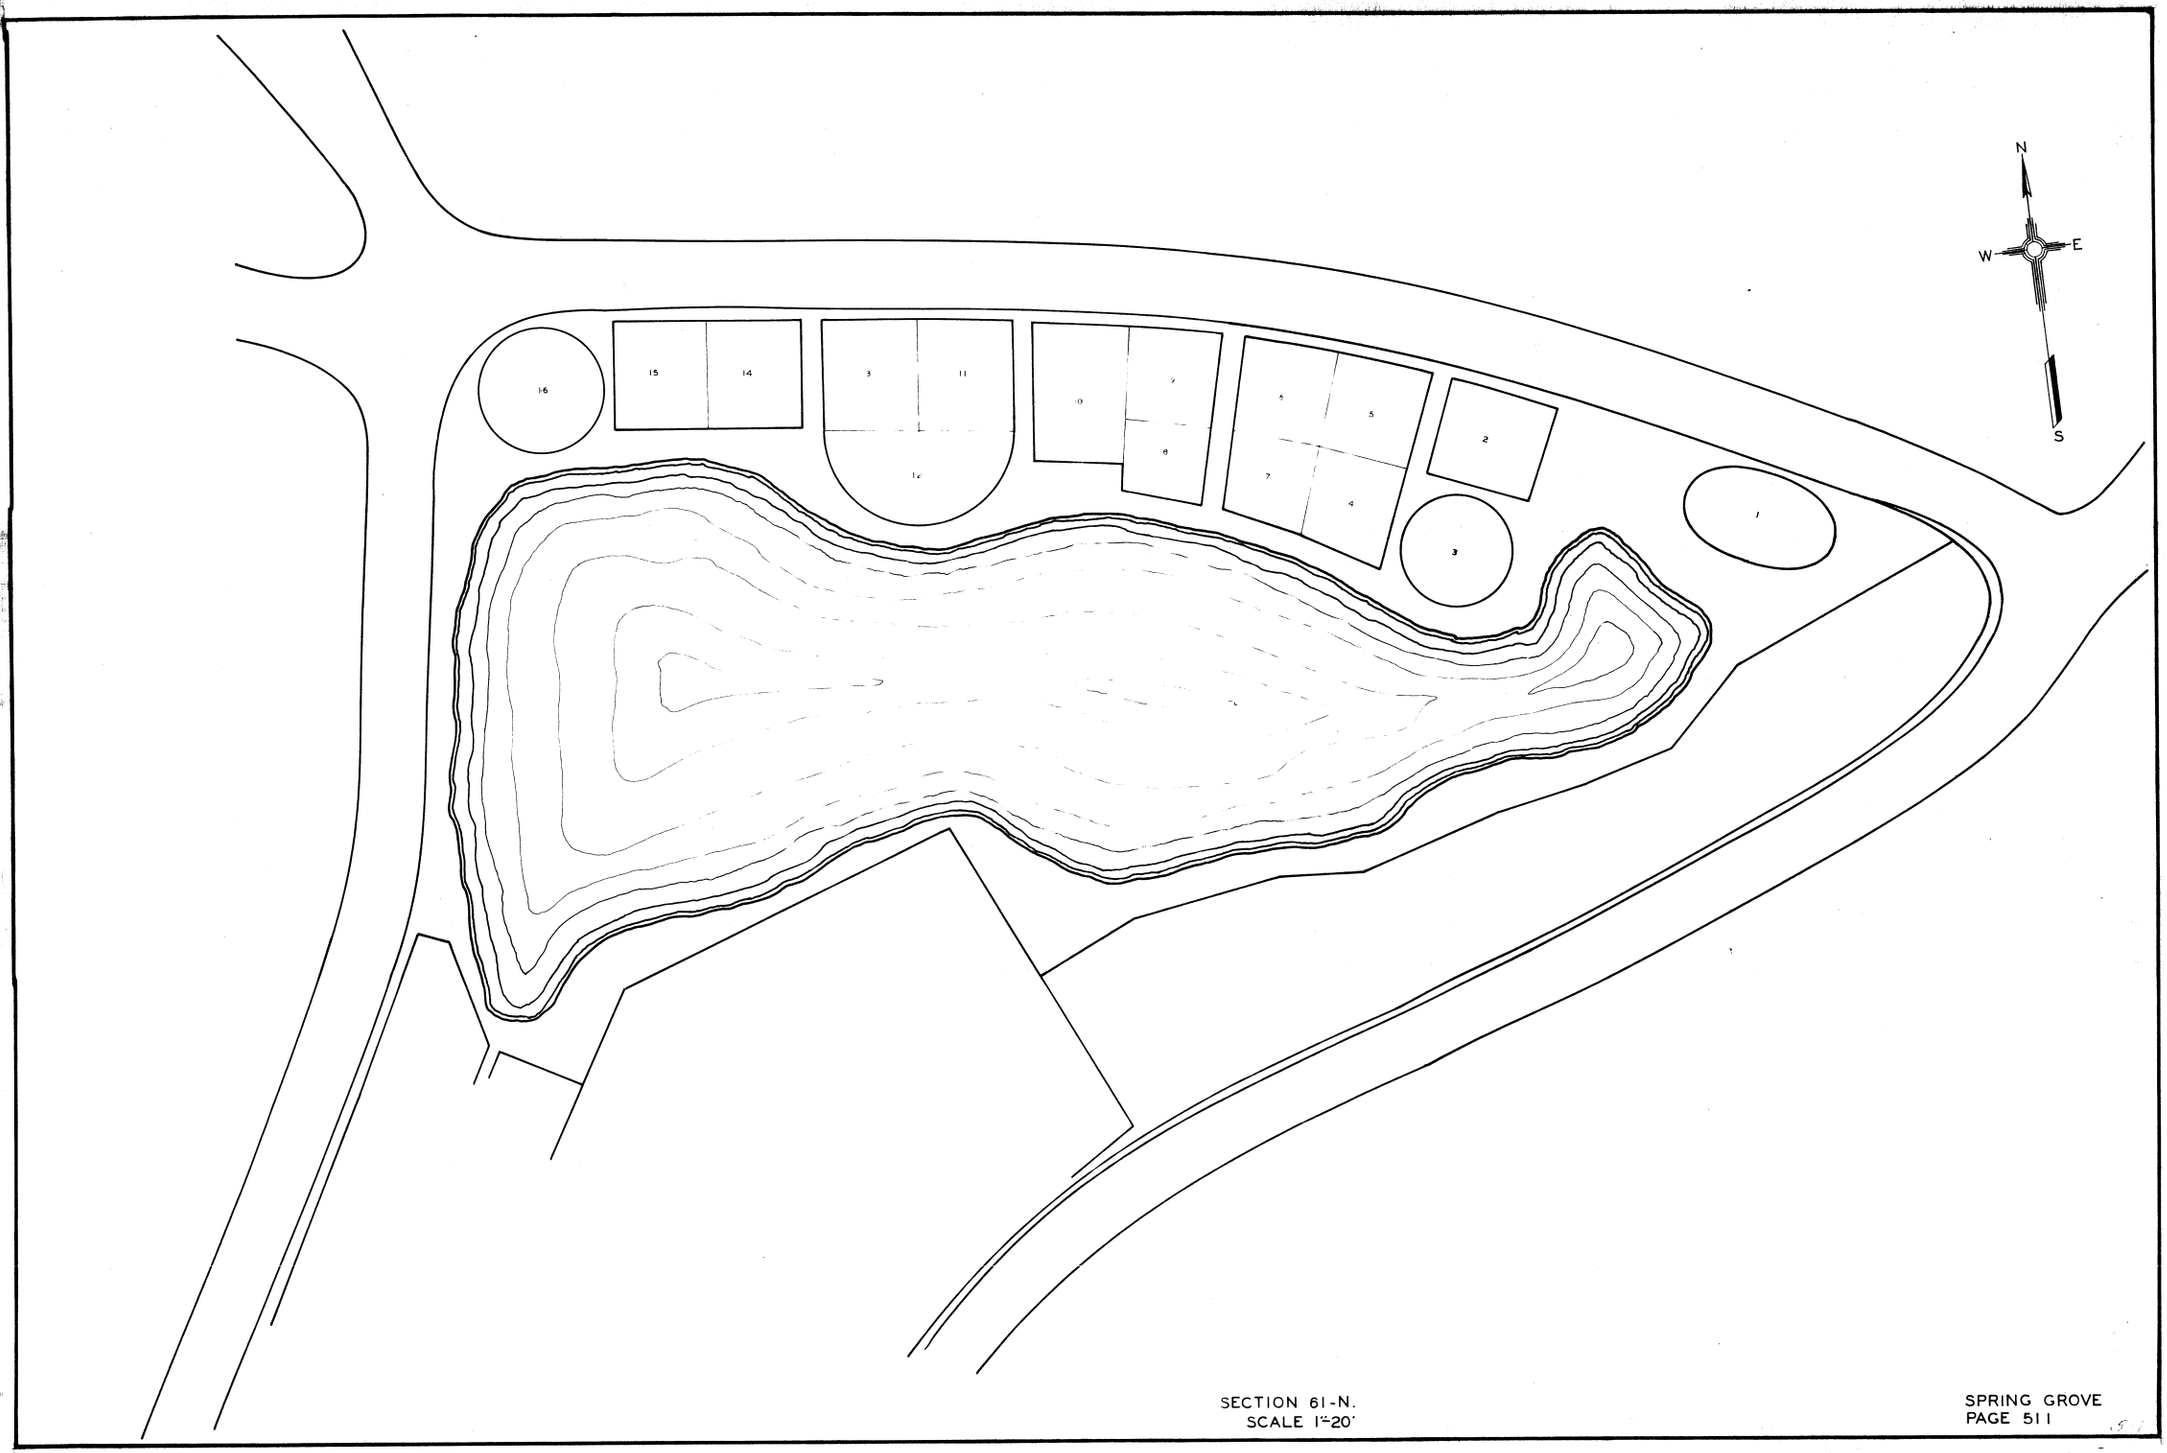

SECTION 61-N.
SCALE 1"=20'

SPRING GROVE
PAGE 511

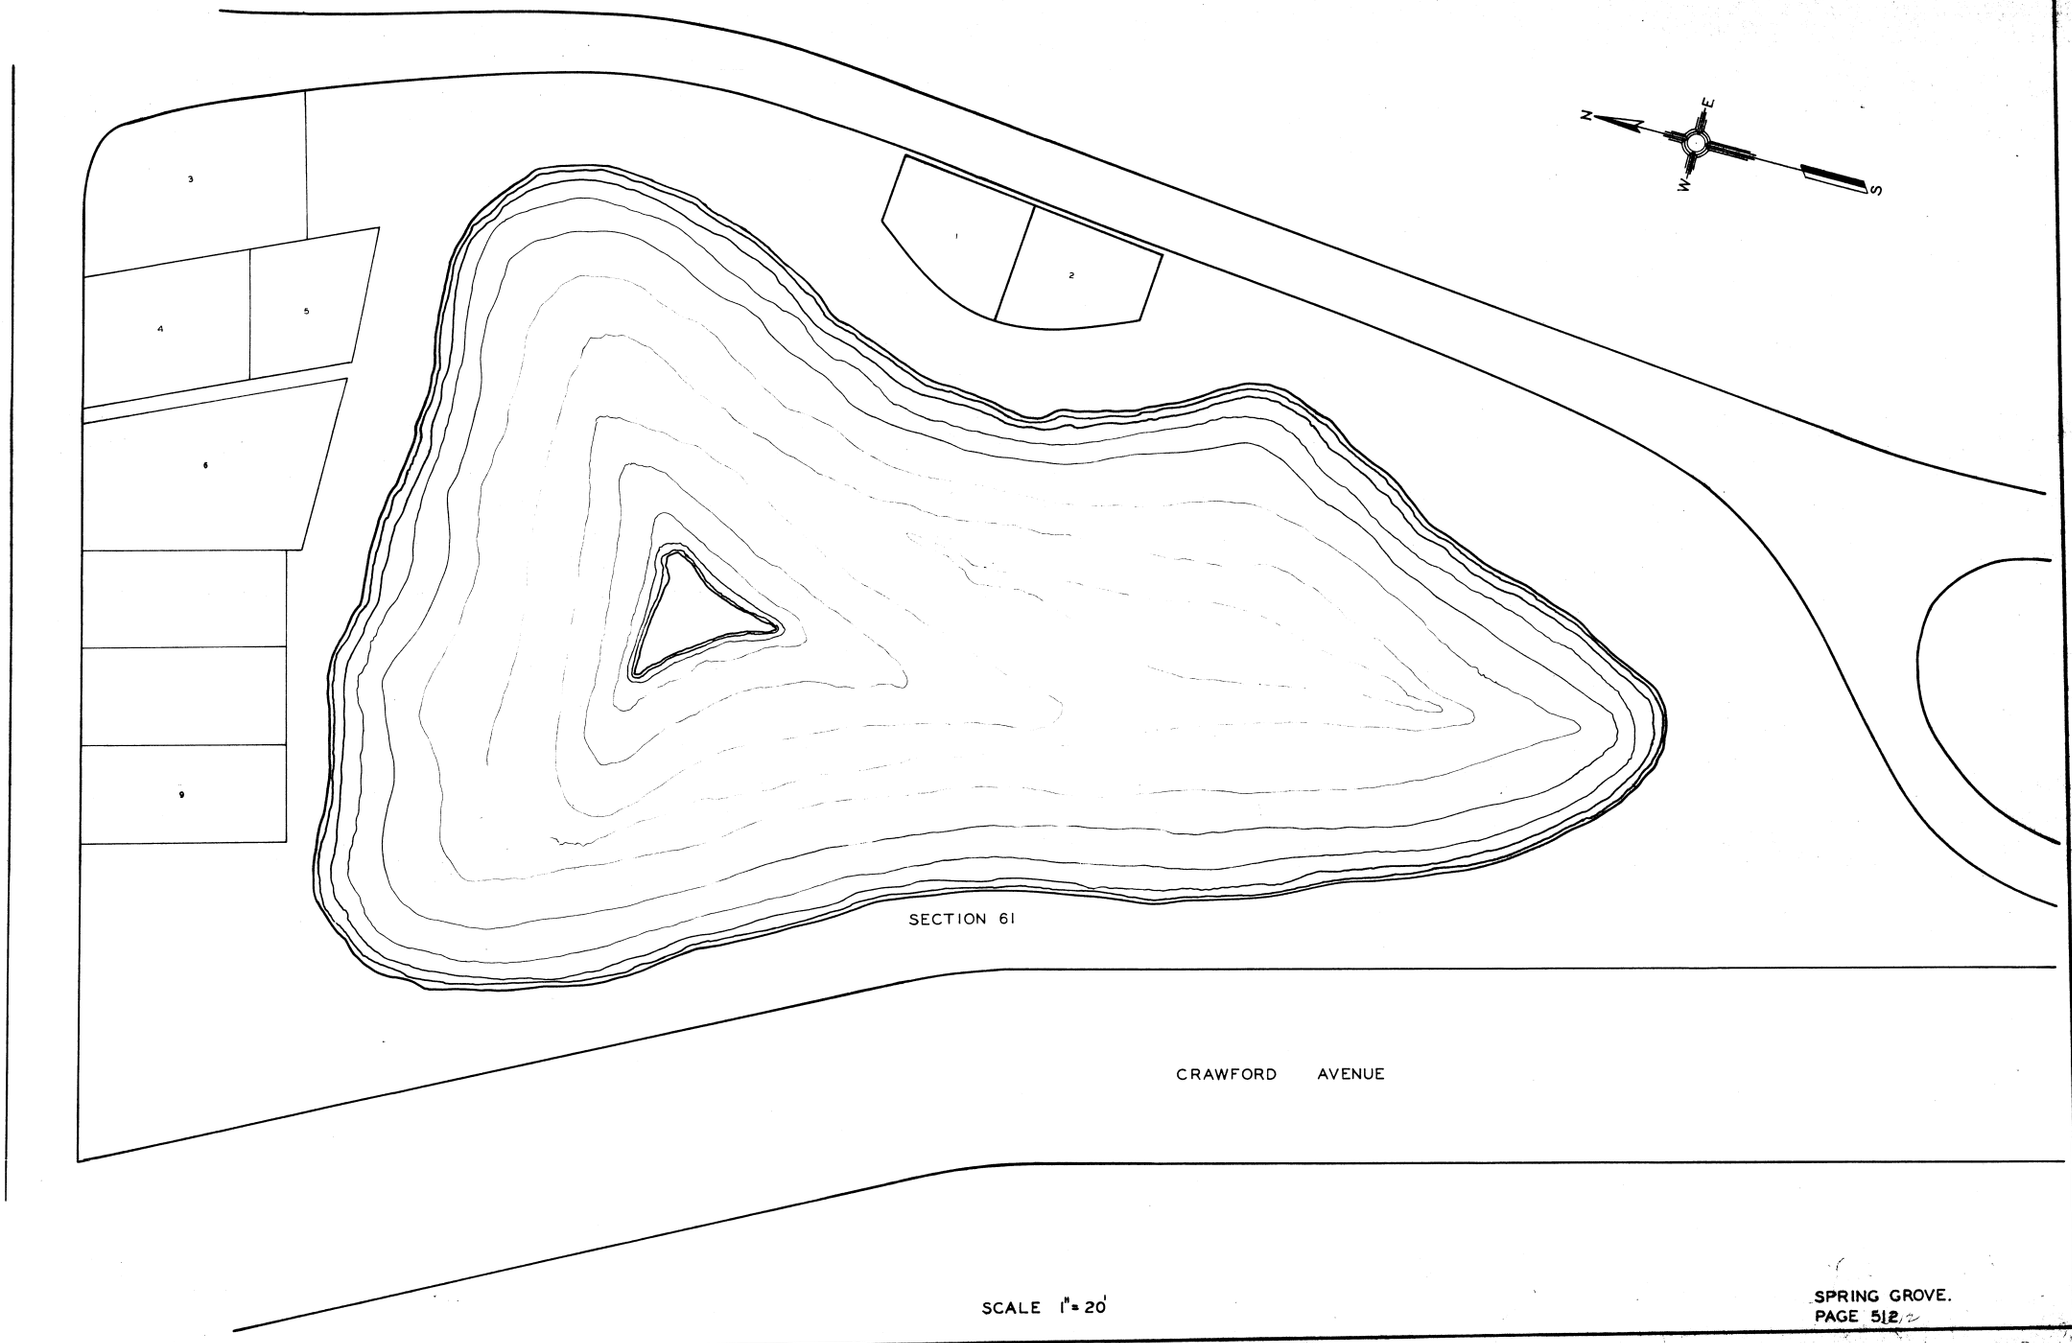

SCALE 1" = 20'

SPRING GROVE.
PAGE 512



LOT	GRAVE	WAR	NAME
B-35	B-3	(19)	ADAMS AYRES B.
B- 2	B-1	(31)	OSTERBROCK HARRY W.
B-22	B-2	(31)	EVANS PAUL E.
G-13	B-3	(31)	RUSH RAY, C.
F-20	B-1	(31)	MORRISON LUTHER F.
F-34	B-2	(28)	WEBB FRANK
A-27	B-1	(31)	WALTZ LYLE T.
B-20	B-1	(31)	FITCH HAROLD H.
H-42	B-1	(28)	FULLER DAVID D.
G-26	B-1	(31)	HUGHES THOS. C.
E- 2		(31)	ROBERTSON HARRY M.
A-27	B-2	(31)	WALTZ EARL
D-33	B-1	(19)	BEALL CHAS.
H-38	B-2	(31)	GRANVILLE HARDY P.
F-10	B-1	(31)	GRIFFITH W. G.
C-24	B-1	(31)	HUXEL WALT. C.
A- 8	B-2	(31)	WARNER HENRY
D- 3	B-1	(25)	MEYER WM. H.
F-50	B-1	(19)	MORRIS JAS. R.
D-34	B-1	(19)	REED GEO. T. S.



SECTION 65

LOT	GRAVE	WAR	NAME
44	B-8	(1)	ARMSTRONG AW.
44	B-2	(1)	ARMSTRONG JAS.
72	B-8	(1)	BOEBINGER JOHN
88	B-7	(1)	CLARK HEN. D.
71	B-9	(1)	COLEMAN JOS. E.
30	B-6	(1)	DISNEY RICH. M.
30	B-14	(1)	DISNEY WM.
35	B-1	(1)	GAULT SAM. C.
92	B-5	(1)	GLASGLOW GEO. C.
20	B-2	(1)	GUILD HENRY N.
91	B-3	(1)	JONES ROB.
39	B-13	(1)	NORTH WM.
65	B-10	(1)	STRUNK SI. H.
56	B-6	(1)	THOMPSON CHAS.
56	B-2	(1)	THOMPSON JOHN
1	B-10	(1)	WARDER JOHN
18	B-2	(1)	LOUDER BENJ.
16	B-1	(1)	McKAY NEAL
66	B-15	(1)	SMITH NEWTON C.
22	B-6	(1)	VAN KOOTEN HERMAN

SCALE 1"=20'

SPRING GROVE SECTION 67

LOT	GRAVE	WAR	NAME
22	B 4	18	BRADLEY CHAS.
2A	4	19	BURTON ANTHONY B.
46	B 5	19	CRAWFORD GEO. W.
21	B 6	19	GILMORE MILTON M.
38	19	19	KAMPING JOHN A.
35	B 1	19	KENDRICK CHAS. S.
33	B 9	19	LANBERT SAM'L.
57	B 6	19	LATTA LEONIDAS J.
3A	B 7	19	LAWRENCE WALT.
35	B 2	1	LUDLOW JOHN
35	B14	19	LUDLOW OLIVER C.
55	B 8	19	MANNING JAS. T.
20	B10	21	POOLE ALLYN G.
15	B 8	19	REYNOLDS CHAS. A.
12	B10	19	SCHULTZ GEO. W.
51	B 7	19	SNYDER WM.
38	B20	19	STEWART CHAS. E.
35	B 5	19	STILES JOHN
16	B 6	19	STOMS HORACE G.
16	B 1	19	STOMS WILLARD P.
1	B 5	19	TOWNSEND CHAS. H.
20	B-9	21	GROSSIUS WM. H.
24	B 6	10	COLLARD ISAAC
43	B 3	19	EARL EDW. A.
54	B 6	19	GOULD GEO. W.
35	B 11	10	LUDLOW JOHN S.
30	B 13	19	WILLIAMSON WM. B.

LOT	GRAVE	WAR	NAME
14	B-14	33	HINMAN BENJ. P.
2	B 9	31	SCHENK E. H.

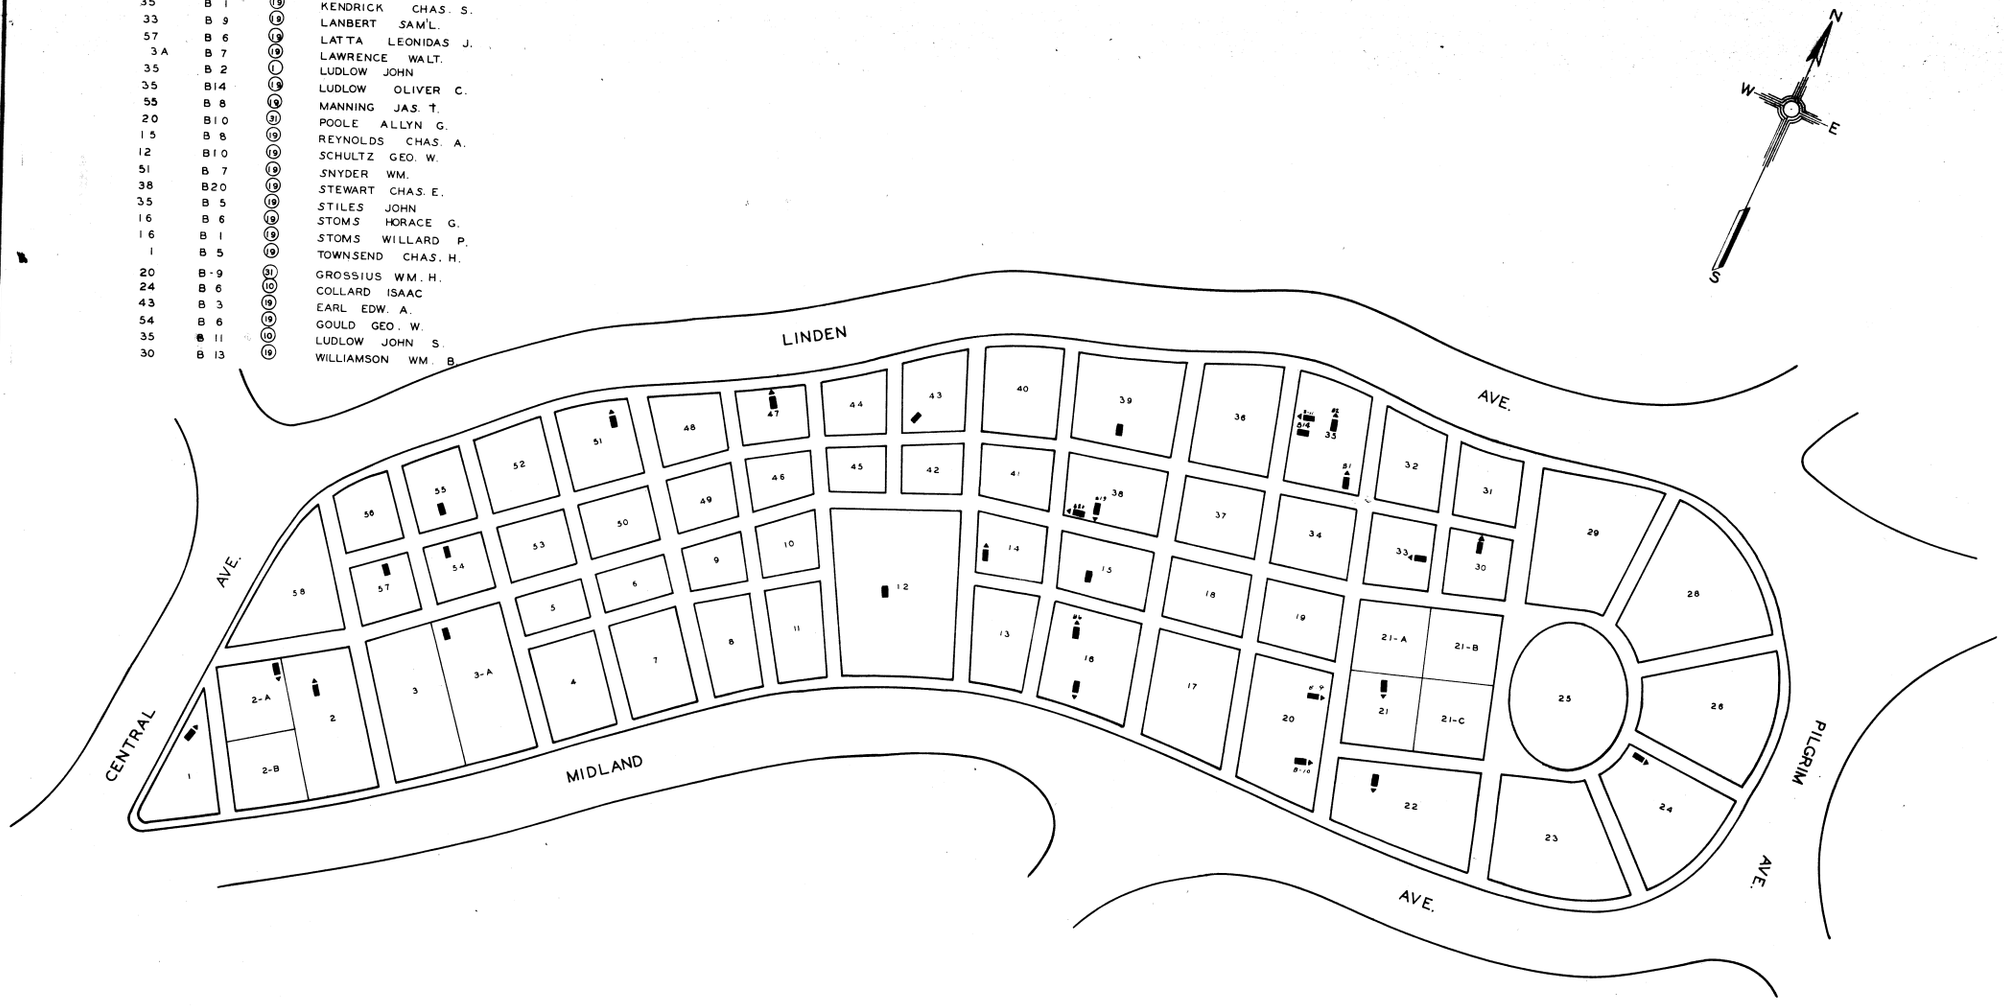

SECTION 67
SCALE 1-20



SECTION 68

GRAVE	WAR	NAME
534	31	ANDERSON JAS. L.
1384	31	BARNETT HARRY E.
982	25	BAUERSFLD EDW. J.
1103	31	BOERSTLER CARL J.
496	25	BROWN WM.
554	19	BURG JOHN
742	31	DAWSON WM.
893	19	DIEFFENBACH FRED.
1801	31	DRAIN THOMAS
289	31	EVANS ALF. H.
579	31	GARROS JOHN S
694	19	GASKELL GEO. S.
1414	25	HAMILTON WM.
279	25	HARTER HERBT. L.
735	19	HEILMEYER JOS.
1123	19	HIGGINS WM.
352	31	HOLZFASTER CHAS.
1121	25	JOHNSON WM.P.
1327	31	M MILLIN GEO. H.
850	25	RILEY WM.
1079	19	MORTON THOM.
1266	19	MURRAY JOHN G.
1759	25	MYERS EDW. F.
443	31	REESE WALT. S.
469	19	ROWLAND WM. H.
312	31	SANDMAN JACOB
479	31	TIERNEY WM. J.
761	31	TILLETT THOM.
303	19	SHORTEN JOHN W.
1137	31	SUNIUM JOHN T.
1558	31	REI MOND ORMA
1173	31	WARD JOHN J.
480	31	WAUEH EARL E
686	31	WOYCKE ANDREW A.
620	31	WURTZ ALBT B.
799	31	WADDEL WM
1486	31	VOEGELE CHAS. A
381	19	SIES WALTER R.
1107	33	HOLLEY CHAS. S
193	31	DALTON ARBELIA L.
978	19	BRIMSTONE THOS.
115	19	BUTLER LEWIS
760	19	DUNCAN JOHN
345	31	FRANEY JOHN J
1656	25	GILMORE WM. N.
1490	31	LAYTON HY A
576	31	MATHERS CHAS
1668	19	MSKILLIPS JOHN D
523	31	MEAD WM W.
962	31	SHAW CHAS. O
540	19	TRIMBLE WM. H.
1354	25	YOUNG SILAS

SECTION 68

GRAVE	WAR	NAME
484	19	BOYLE OLIVER P.
493	25	THIELE ALBERT G SR.
404	25	BOYLE MICH'L F
557	19	TALLMADGE HARRY C.
419	19	TALBOT ALF.

SCALE 1" = 20'

SPRING GROVE
PAGE 516

SECTION 70

LOT	GRAVE	WAR	NAME
	B-14	(19)	KITTERING SIMON W.
13	B-3	(19)	LANGDON OLIVER M.
2	B-11	(19)	SEITER GEO.
2	B-5	(19)	SEITER JOS.
9	B-8	(19)	STODDARD GROVE
4	B-10	(19)	DOUGLAS HOWARD
14	B-10	(31)	LEHMAN BEN'J F.
14	B-12	(31)	PAUL CHAS. M.

SECTION 82

LOT	GRAVE	WAR	NAME
1	B-1	(19)	RAWSON WARREN

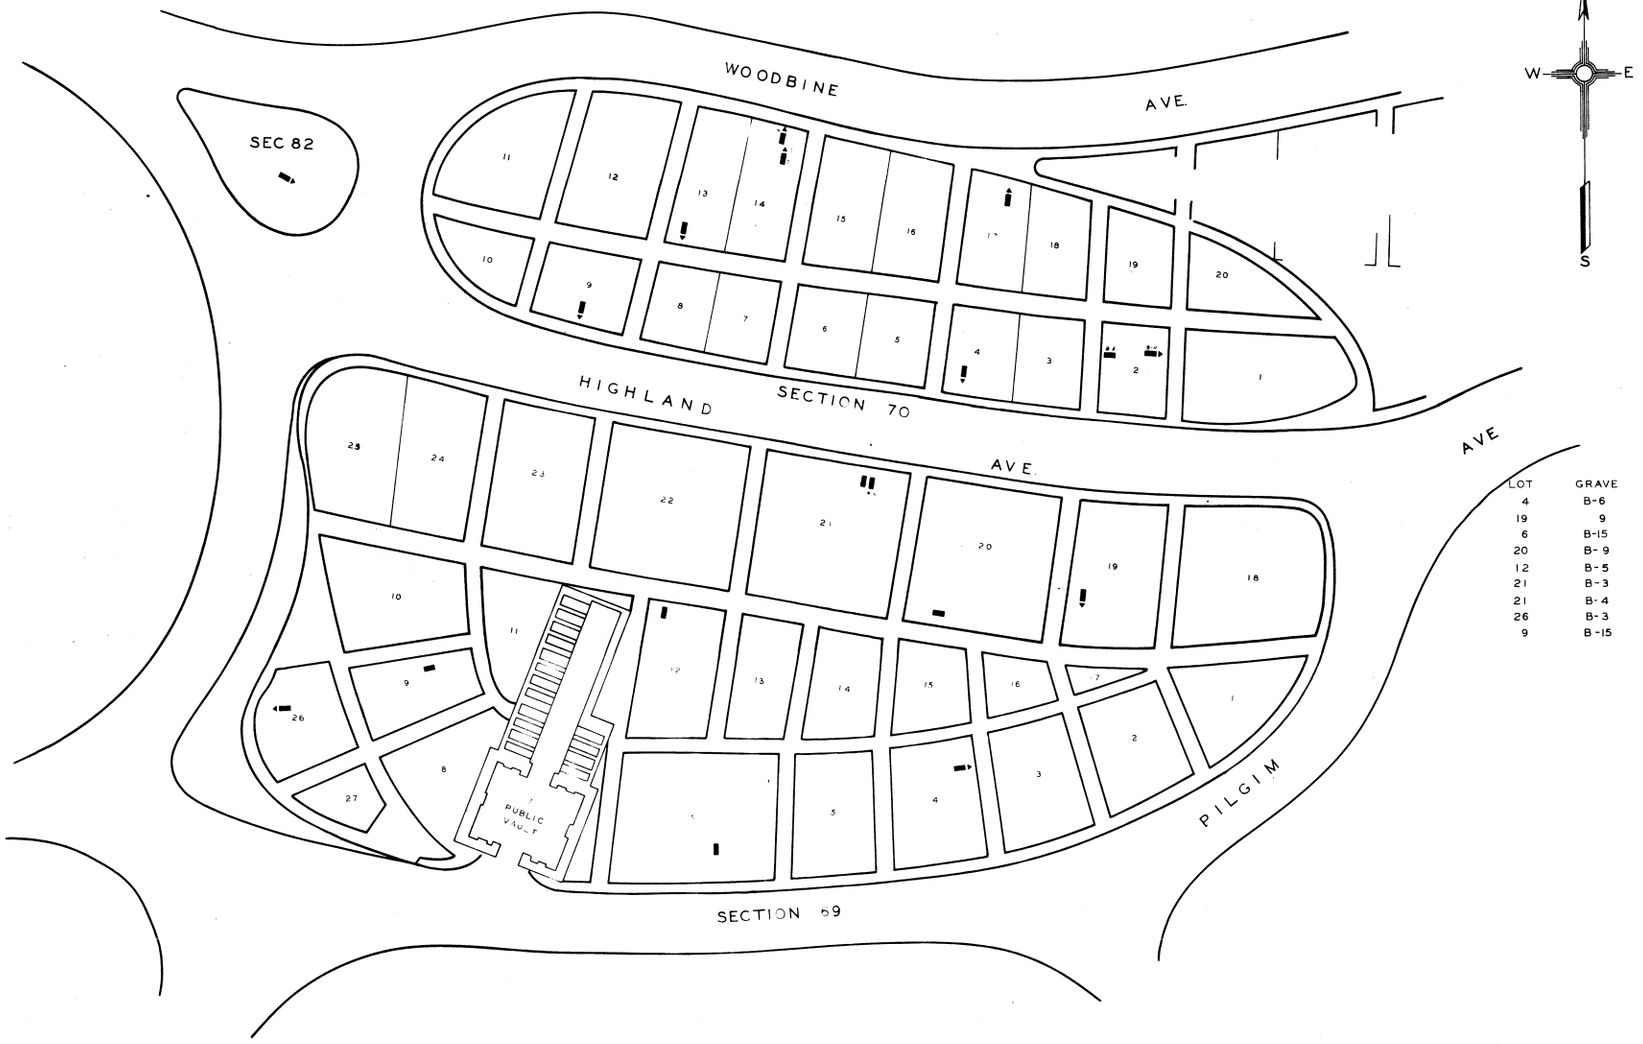

SECTION 69

LOT	GRAVE	WAR	NAME
4	B-6	(19)	ALEXANDER JOHN
19	9	(19)	ALLEN AL. H.
6	B-15	(19)	BROADWELL GEO.
20	B-9	(18)	BURDSALL HENRY. W.
12	B-5	(19)	MASON THOM.
21	B-3	(19)	MORGAN C. A.
21	B-4	(19)	PENDLETON WM.
26	B-3	(19)	SADLER LEW. L.
9	B-15	(19)	HORNBERGER JOHN

SCALE 1"-20'

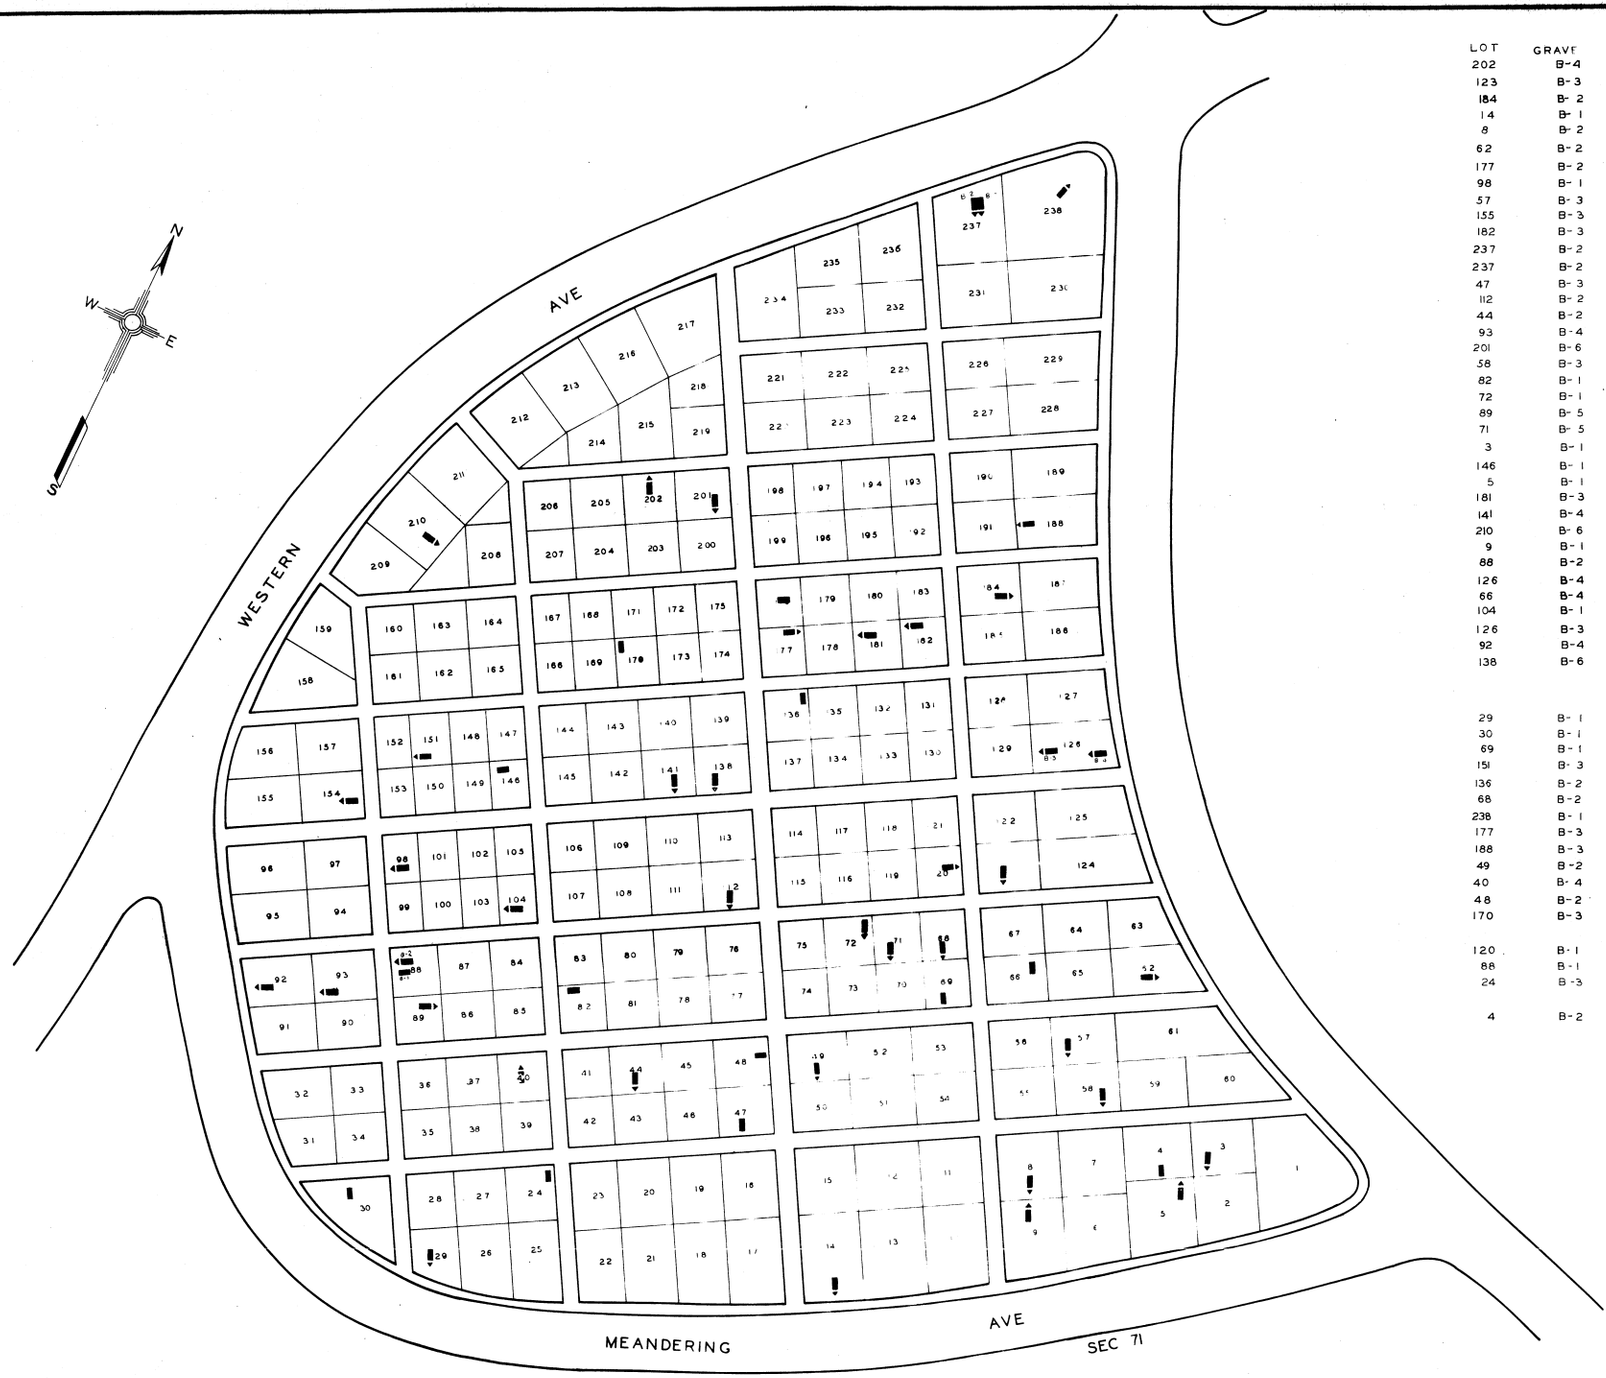

LOT	GRAVE	WAR	NAME
202	B-4	19	BOWMAN JOHN WM.
123	B-3	19	BROWN JAMES W.
184	B-2	19	CAPELL PETER
14	B-1	19	CROSSET WM.
8	B-2	25	DICKERSON JOHN H.
62	B-2	19	FERRIS AARON A.
177	B-2	19	FISHER JAMES H.
98	B-1	19	GARDEN FRINCIS J.
57	B-3	25	GEYER WM.
155	B-3	19	HAAB JOHN
182	B-3	19	HALL WM. F.
237	B-2	19	HILDRETH GEO.
237	B-2	19	HILDRETH JOHN C.
47	B-3	19	IRWIN JAMES S.
112	B-2	19	LANGENHEIM WM. D.
44	B-2	19	MAYHUGH BENJ. F.
93	B-4	31	MC KINNEY WESLEY
201	B-6	19	MILLER WM.
58	B-3	19	NULSEN CHARLES
82	B-1	19	PERRY WM.
72	B-1	19	PETERSON CHAS. P.
89	B-5	31	RAU IRVING W.
71	B-5	19	RUDD GEO. R.
3	B-1	19	SCHMITT JOHN H.
146	B-1	19	SCHNEIDER PETER
5	B-1	19	SCOTT WINFIELD
181	B-3	19	SEEGER CHAS. F.
141	B-4	19	SHAW EDW. T.
210	B-6	19	SIMPSON ROBT. B.
9	B-1	19	SOLARE JOHN J.
88	B-2	26	SCHAEFER JOHN
126	B-4	19	TURNER WM. H.
66	B-4	19	WERTS CHAS. W.
104	B-1	19	WILLIAMS DV.
126	B-3	19	WILTSEE CHAS. L.
92	B-4	19	ZINCK JOHN
138	B-6	31	ZOLLER MCLEAN J.
29	B-1	19	ARNOLD WM.
30	B-1	19	FRANK JOHS. S.
69	B-1	19	HELMAN ALB. M.
151	B-3	19	LESEP CHRISTIAN
136	B-2	19	MARYMAN DAVID
68	B-2	19	NEWTON ELISHA
238	B-1	19	PITTENER JACOB
177	B-3	19	RICHEY JOHN H.
188	B-3	25	WHITTEKER ELLIOTT
49	B-2	19	WINANS BENJ. L.
40	B-4	19	THOMAS JNO. M.
48	B-2	31	ERTEL CHAS. A.
170	B-3	19	WALKER LOU.
120	B-1	19	MC CALLISTER RICH. V.
88	B-1	19	SCHAFER JOHN
24	B-3	19	UNDERWOOD DE WITT C.
4	B-2	19	MEYERS FRED'K. A.

SCALE 1-20'

SPRING GROVE
PAGE 518



SCALE 1"–20'

SPRING GROVE
PAGE 519

LOT	GRAVE	WAR	NAME
2-B	B- 3	19	BARKER
13	B- 1	19	BEAM GEORGE F.
93	B- 2	19	BOGER MICHL.
45	B- 8	31	BRINKMAN
203-L	B- 2	18	ABRAM SAMUEL
3-D	B- 2	18	BARTELS FRANK
67	B- 2	18	BANKS MILO D.
200-H	B- 1	19	BALLARD PATRICK
133	B- 2	18	BOHLING HENRY
199-O	B- 1	25	CLARK CHAS. E.
101	MEMORIAL	19	COLBY LUCIUS
30	B- 1	19	COLLINS PATRICK W.
199-N	B- 2	19	DEAN THOS. E.
1-E	B- 4	19	DEFORD ANDR. J.
204-L	B- 1	19	DETERS FRANK E.
103	B- 1	19	DUSTIN EMORY F.
205-K	B- 3	19	EATON WM.
137	B- 5	19	ECKEL FREDR.
65	B- 3	31	ELLIOTT THOMS. J.
113	B- 1	19	EVANS DAVID E.
98	B- 6	19	EVERHARD PHILP. M.
130	B- 2	19	FIER GEO. E.
101	B- 2	23	FITCH GEO. C.
199	B- 1	19	FOSTER EDWIN H.
52	B- 2	19	FREEMAN EDWIN
20	B- 4	19	FREEMAN WM. D.
200-	B- 1		FOSTER WM.
187	B- 3	18	FUCHS JOS.
200-F	B- 2	19	GRACIE SAML.
14	B- 1	19	HUBER JACOB B.
199-E	B- 3	19	HAMMOND ANDW.
169	B- 3	31	JANTZ CLIFFORD L.
100	B- 4	19	JELLEFF BENJ.
49	B- 1	23	JOHNSON WALTER K.
49	B- 2	19	JOHNSON WM. C.
120	B- 6	19	JONES JOHN H.
34	B- 6	19	KENT WM.
141	B- 2	19	KNIPPER JACOB
125	B- 2	19	KAUTZ PHILP
34	B- 2	25 26	KENT WM S.
160	B- 1	19	LEONARD JOHN
4-C	B- 1	25	LEWIS WM. E.
5-N	B- 2	19	LIPPERT-EUGENE W.
145	B- 1	19	LEACH JOHN
182	B- 4	25	LINGERFELTER JAMES
8	B- 8	19	MAY DANL. C.
40	B- 1	19	MATHEWS GEO.
166	B- 1	19	MCFEE WM.
204-B	B- 1	19	MELLOR AL. C.
21	B- 3	19	MITCHELL JOHN
199-B	B- 2	19	MURRAY JOHN L.
122	B- 1	19	MARGRAF JULIUS
200-K	B- 2	19	PARCHER WM. H.
203-D	B- 3	25	PATTON CLARENCE E
203-D	B- 1	19	PATTON DAVID T.
198-G	B- 2	19	PETTIT ELEAZAR N.
193	B- 4	19	ROMES HENRY
89	B- 6	31	SCHLENNER AL
83	B- 1	18	SCHMIDT FREDR
205-J	B- 1	19	SCHNEIDER FRANK
203-F	B- 4	19	SMITH JOE A
205-H	B- 1	19	SWINSON JAMES
27	B- 1	19	SEGRIST WM
4-H	B- 1	19	SAUERBECK GF
204-E	B- 1	19	SPATZ PHIL.
200-L	B- 3	19	SNYDER SAML. D.
155	B- 4	31	SPELMAN JNO. D.
205-D	B- 1	19	TALBOTT NATHAN
135	B- 6	19	THOMPSON BENJ. W.
35	B- 3	19	THOMPSON JAMES
117	B- 2	19	TRINDLE SAML.
114	B- 2	19	THEOBALD CHAS.
58	B- 1	19	VOGEDING FREDR. WM.
200-A	B- 2	19	WALKER CHAS. F.
153	B- 6	19	WALLACE ALB. T.
202-J	B- 1	19	WARREN MICHAEL
97	B- 5	18	WEBB JOHN W.
68	B- 1	19	WELLS ALEX.
34	B- 5	19	WHITNEY GEO.
198-G	B- 4	19	WILBER GEO.
9	B- 25	19	WILDER GEO. R.
9	B- 34	19	WILDER WM. W.
203-G	B- 1	19	WILLIAMS JOHN R.
153	B- 11	19	WILTZ THOMS. H.
174	B- 6	19	WOOD HORACE M.
97	B- 2	19	WEBB JOHN F.
4-F	B- 2	19	WEIHLERT LOU.
23	B- 3	18	WILTSEE WM. P.

SECTION 48

LOT	GRAVE	WAR	NAME
9	B-8	(19)	BREWER WES. S.
25	B-9	(18)	BUCHANAN SAM. E.
48	B-3	(19)	CHRISTY JOHN T.
5	B-6	(19)	DALE GEO. C.
3	B-1	(19)	ENGLISH WM. P.
50	B-7	(19)	MORRIS HENRY W.
	46	(16)	RADLEY W. E. W.
57	B-4	(19)	RYALL WM.
11	B-11	(19)	SHIELDS JAS. D.
62-B	B-3	(19)	SMITH GEO. W.
62-B	B-2	(19)	SMITH WM. H.
8	B-9	(19)	CAMPBELL JAS.
	234	(19)	FEHR CHAS.
4	B-16	(19)	HUCK GEO.
	264	(19)	WIDMAN GOTTLIEB
3	MEMORIAL	(19)	ENGLISH CHAS. F.

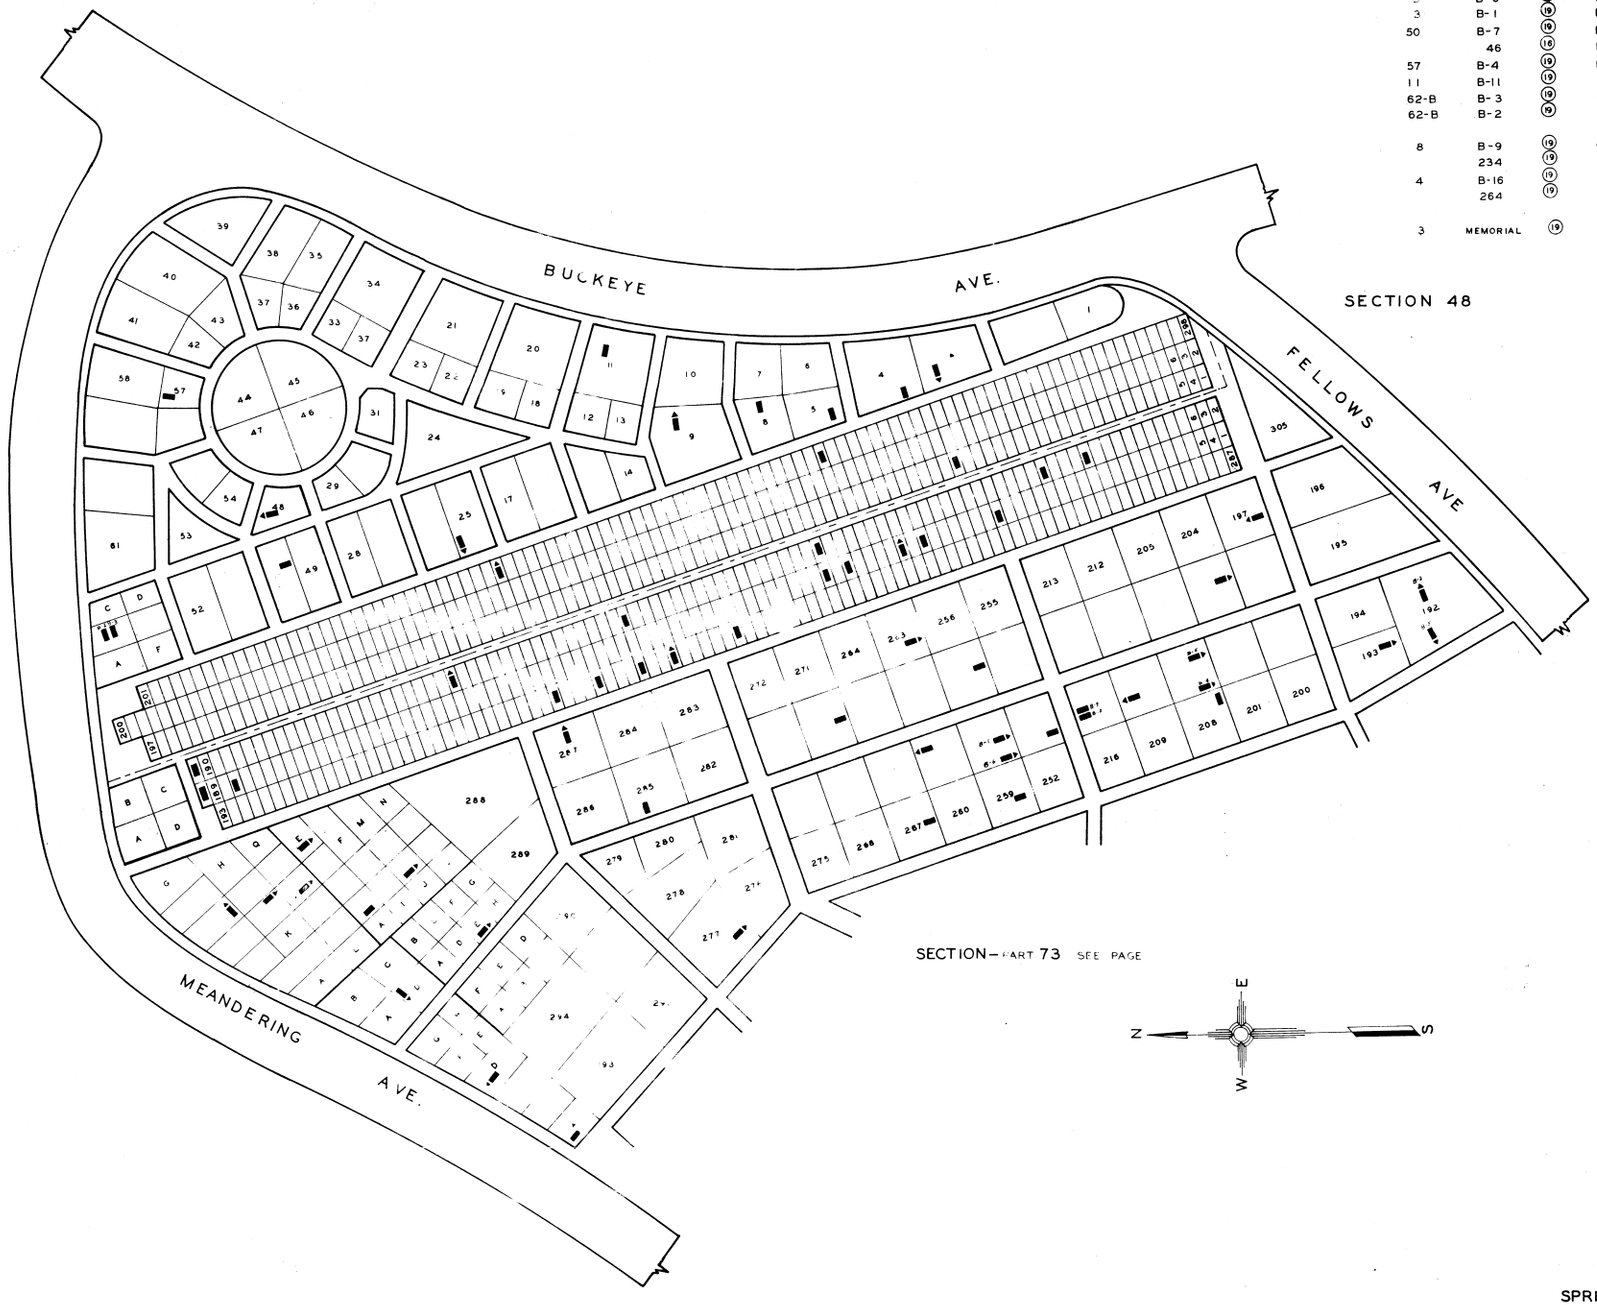

SCALE 1"= 20'

SPRING GROVE
PAGE 521

521

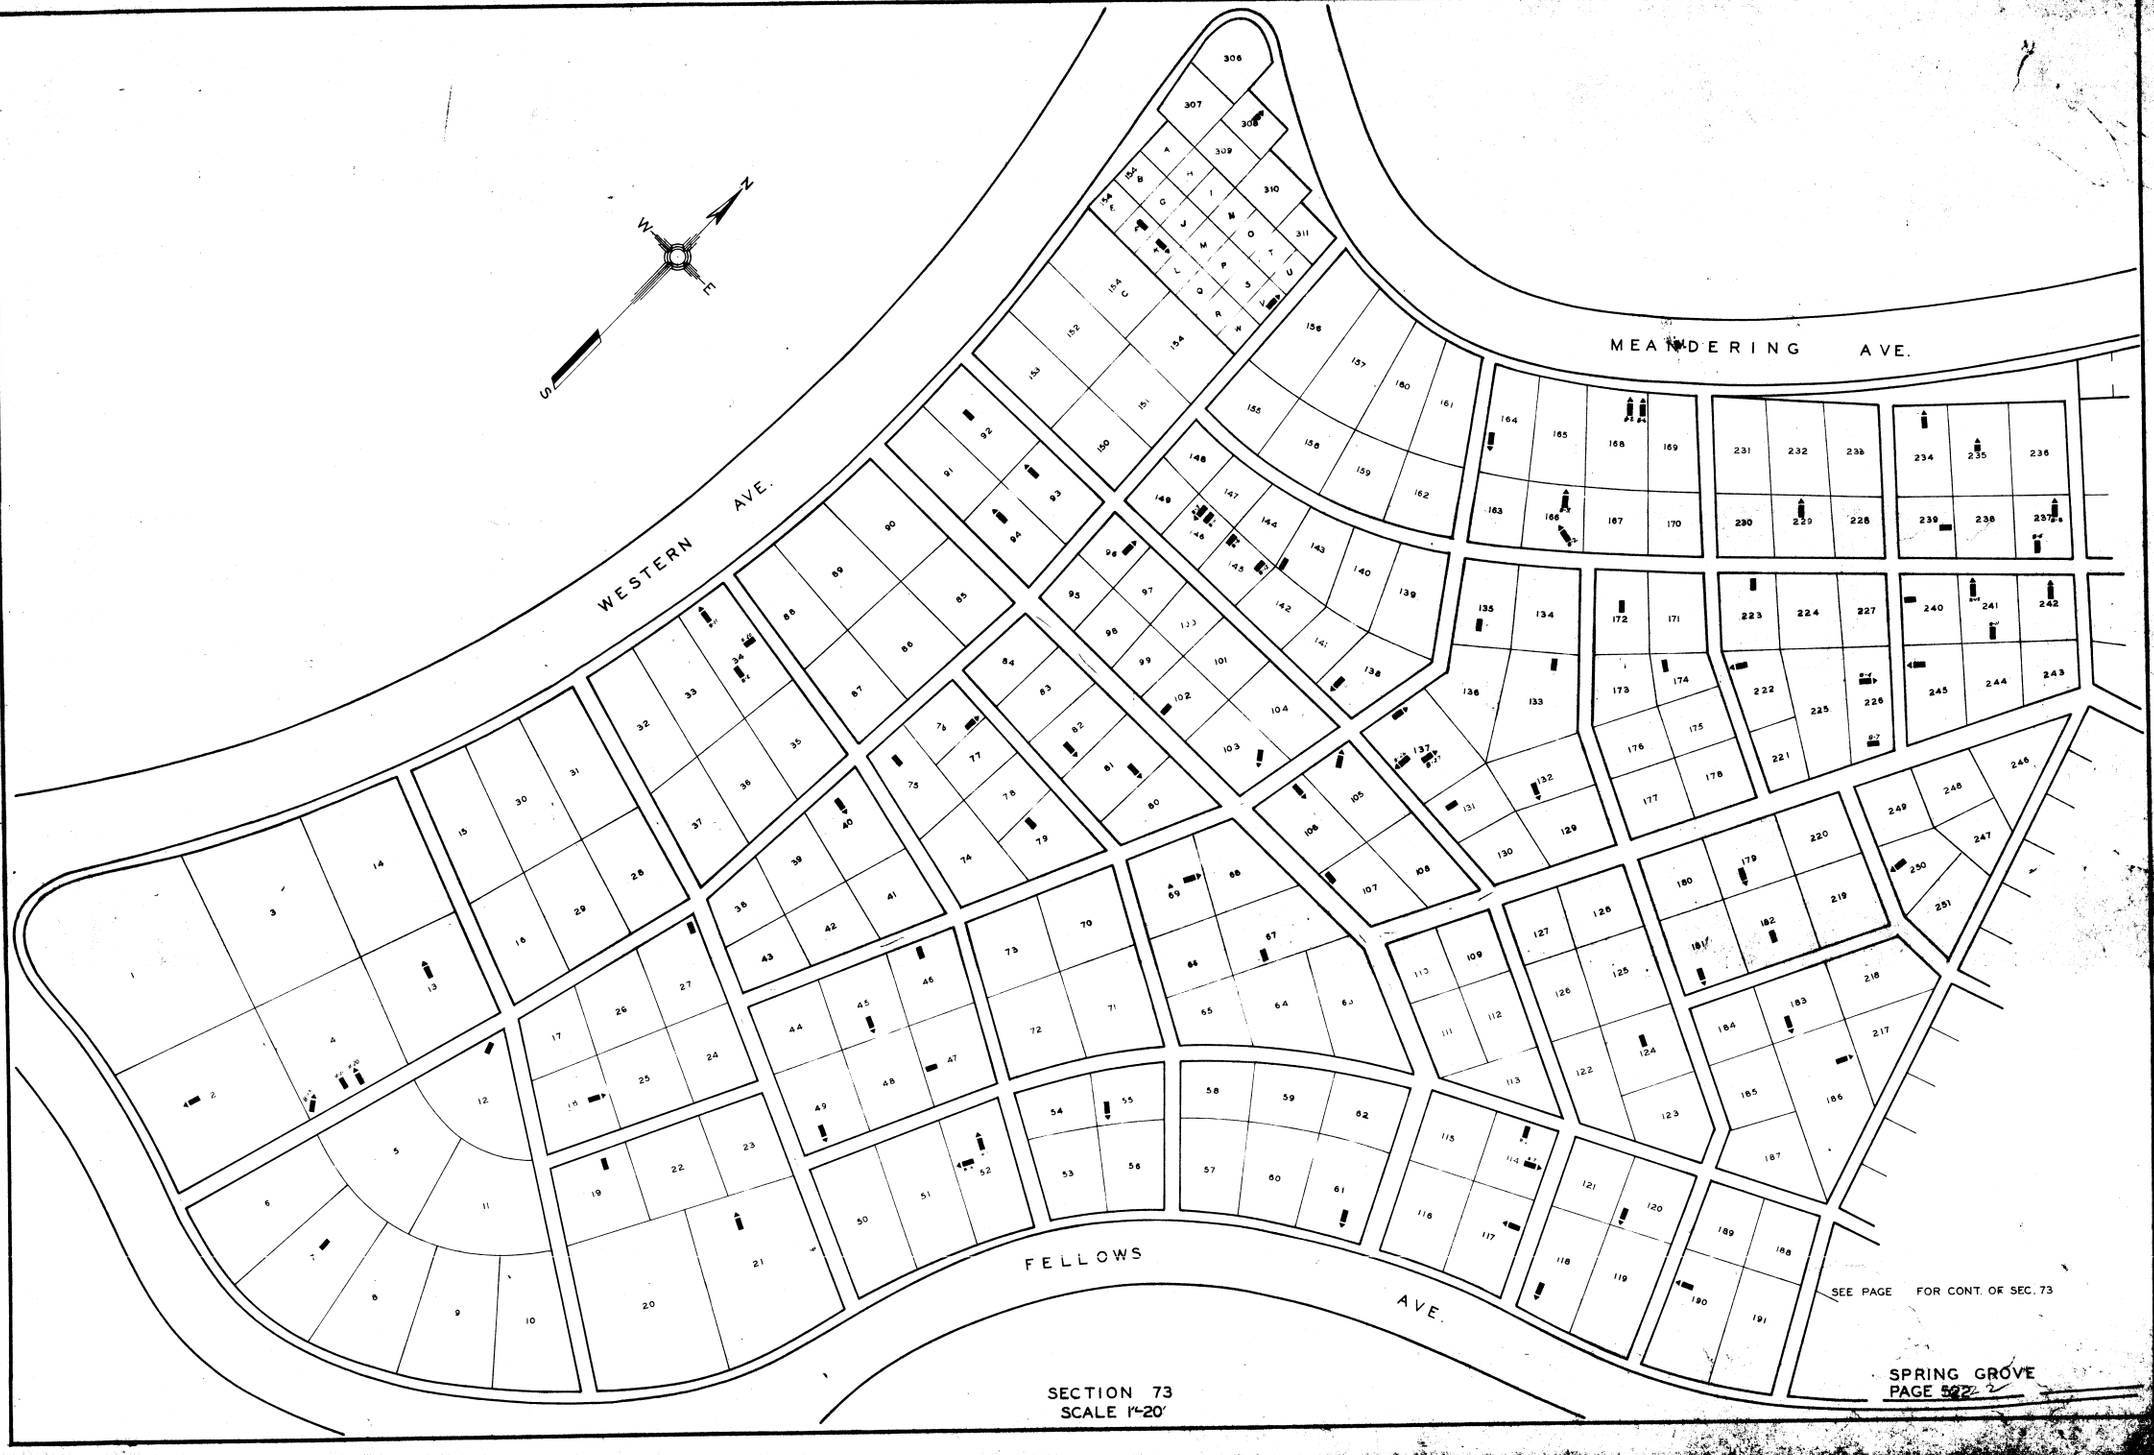

SECTION 73
SCALE 1"=20'

SPRING GROVE
PAGE 522

LOT	GRAVE	WAR	NAME
287	B-4	(19)	ALLEN MAT. W
19	B-11	(19)	ALLEN RICH.
207	B-5	(19)	ALLEN WM. H.
	224	(19)	APPLEGATE ANDY J.
267	B-6	(19)	ARZHEIMER HENRY
4	B-20	(19)	ASBURY FRANK C.
4	B-13	(19)	ASBURY WM. H
192	B-3	(19)	ATKINS WM. E.
76	B-6	(19)	AYERS SAM'L.
193	B-9	(19)	BAUMER JOHN
146	B-9	(25)	BUTLER WM.
81	B-10	(19)	BAUER JOHN
270	B-3	(19)	BEAHR JAC. J.
154-F	B-2	(19)	BERNE H. A.
93	B-2	(19)	BORGER P. J.
	228	(19)	BOSWELL JOS.
2	B-4	(19)	BRADFORD THOM. C.
239	B-4	(19)	BROWN ROBT. H.
133	B-6	(19)	BERTSCH WM.
234	B-2	(19)	BREHM ANDREW
297-B	B-1	(19)	BELLEVILLE DEWITT C.
137	B-27	(31)	BRATT WM. F.
69		(31)	BROWN JAS. W.
154-K	B-3	(19)	CARR JOHN S.
146	B-10	(19)	CAMPBELL CHAS. E
131	B-2	(19)	CAMPBELL SAM. L.
102	B-3	(19)	CARLISLE ROBT.
308	B-3	(19)	CARSON JOHN H.
	245	(19)	CARTWRIGHT THOM.
114	B-2	(19)	CASSIDY WM.
	26	(19)	CLARK THEO.
49	B-10	(19)	COOK JOHN
105	B-10	(19)	CUNNINGHAM DAV.
263	B-1	(19)	CUMMINGS WM.
229	B-3	(19)	CURRY WM. B.
12	B-6	(19)	CURTIS ENOCH H.
303-D	B-4	(19)	COX JOS. P.
137	B-19	(19)	CORTGARNER F. W.
27	B-10	(19)	DAVIS JOSIAH H
258	B-6	(19)	DECKER HENRY
40	B-5	(19)	DISTER FRED
	34	(19)	DONEY CHAS. F
	76	(19)	DUNKERLY JOHN
	72	(19)	DUNLAP SAM
301-E	B-1	(19)	DIETZ JOHN
203	B-3	(19)	DOERR ANDREW
172	B-7	(19)	ELLISON ALONZO
174	B-9	(31)	FALLON WM F.
132	B-7	(31)	FISCHER CLARENCE A
75	B-9	(19)	FISHER FRED A.
215	B-9	(25)	FISHER GEO
215	B-10	(25)	FISHER WM. H.
179	B-6	(19)	FORBIS WM. N.
67	B-12	(19)	FUSSNER JOHN

LOT	GRAVE	WAR	NAME
168	B-8	(19)	GALE BURT W
226	B-4	(19)	GIBBS AL.
186	B-2	(19)	GIBBS WM. H
21	B-9	(25)	GOSLING JEROME C.
94	B-1	(19)	GRUNDHOEFER WM. W
192	B-5	(19)	GARDNER BENJ M.
259	B-3	(19)	GOSSIN BEN'J F
301-J	B-1	(19)	GUTHARDT H. M.
79	B-2	(19)	GROWRECKER GEO.
166	B-5	(19)	HALLAM CHAS H
208	B-7	(19)	HART JAS D
114	B-7	(19)	HARRISON WM H
52	B-6	(19)	HAWES AMOS A
250	B-6	(19)	HAY JOHN E
	143	(19)	HERR J. A.
261	B-3	(19)	HODSON AND
44		(19)	HOFFMAN AUG.
	61	(19)	HOFFMAN CHRISTIAN
96	B-9	(19)	HUDSON DAN. E
190	B-6	(25)	HUNT LEVI W
253	B-4	(19)	HANS FRED'K.
137	B 26	(19)	HATMAKER DAN'L. D.
154-V	B-2	(19)	JONTE PET. N.
118	B-6	(19)	KAISER HEINRICH
210	B-14	(19)	KELLER FRANK
69	B-8	(19)	KING JAS. B.
143	B-9	(19)	KING FRANKLIN H.
182	B-5	(19)	KIRKUP ROBT.
297-K	B-1	(19)	KLINE CHAS.
34	B-2	(19)	KLINE CHAS.
34	B-20	(19)	KLINE GEO W.
34	B-11	(19)	KLINE JOHN
242	B-4	(19)	KOCH DAN
13	B-2	(19)	KREIS HENRY
61	B-11	(19)	KRUCKEMEYER LEW
117	B-5	(31)	KRUSE CARL B.
	191	(19)	KRUSE WM.
240	B-1	(19)	KNEPPER WM. J.
257	B-7	(19)	LANGHORN LEW
277	B-3	(19)	LIGHT JOHN L
55	B-3	(19)	LUDWIG WM F
124	B 9	(19)	LUDENS DW. J
223	B-1	(19)	LUTTON ROBT.
296-E	B-1	(19)	McCORVEY JOS.
302-D	B-2	(31)	McCANE HENRY R.
245	B-17	(19)	McCOMPS WM
106	B-6	(19)	MEDECKE BERNHARD
301-O	B-3	(31)	MILLER JAC.
197	B-4	(19)	MILLER RENTZ
	175	(19)	MITCHE WM
135	B-9	(19)	MOORHEA HOM
285	B-11	(25)	MENKE HENRY
82	B-6	(19)	PARKER THOM
	157	(19)	PARSHALL DAV
237	B-8	(19)	PATTERSON JOHN S
237	B-5	(19)	PATTERSON WM. T.
166	B-2	(19)	PEARCE JOHN
	111	(19)	PETERS JOS. A
241	B-11	(19)	PHILLIPS F. A
45	B-8	(19)	POHLMAN JOHN W.
47	B-3	(19)	POHLMAN MORRIS
183	B-4	(19)	PRYOR GEO W.

LOT	GRAVE	WAR	NAME
258	B-1	(19)	PAULSEN AUG.
4	B-1	(19)	RATLIFF J.
	24	(19)	RAYMOND CHAS
138	B-10	(31)	REINHART FRED. H
222	B-7	(19)	ROSS ANDREW
168	B-6	(19)	RUNKLER CHESTERFIELD
207	B-4	(19)	SANDS STEP P
	235	(19)	SCHLAFER GODFREY
46	B-2	(19)	SCHOTT CHAS.
145	B-6	(19)	SCHMER WM.
145	B-12	(19)	SCHMERER PHIL.
226	B-7	(19)	SCRANTON GEO. L.
7	B-3	(19)	SHOCKLEY DEWITT C.
	192	(19)	SMITH ADAM
241	B-12	(25)	SMITH GEO C.
18	B-7	(19)	STEPHENSON WM. M.
164	B-9	(19)	STERRETT WM. M
120	B-3	(19)	SCHWARZTRAUBER JAC.
103	B-11	(19)	SPREEN C.
235	B-1	(19)	SMITH ALEX.
107	B-13	(19)	TARVIN JOS. W
	185	(19)	USHER CHAS.
	232	(19)	WALKER CHAS
92	B-14	(19)	WEBBER HENRY
103-A	B	(19)	WETSELL LEW
297-E	B-2	(19)	WILLOUGHBY AMOS
181	B-2	(19)	WOODSIDE S
52	B-5	(19)	ZILAR WASH

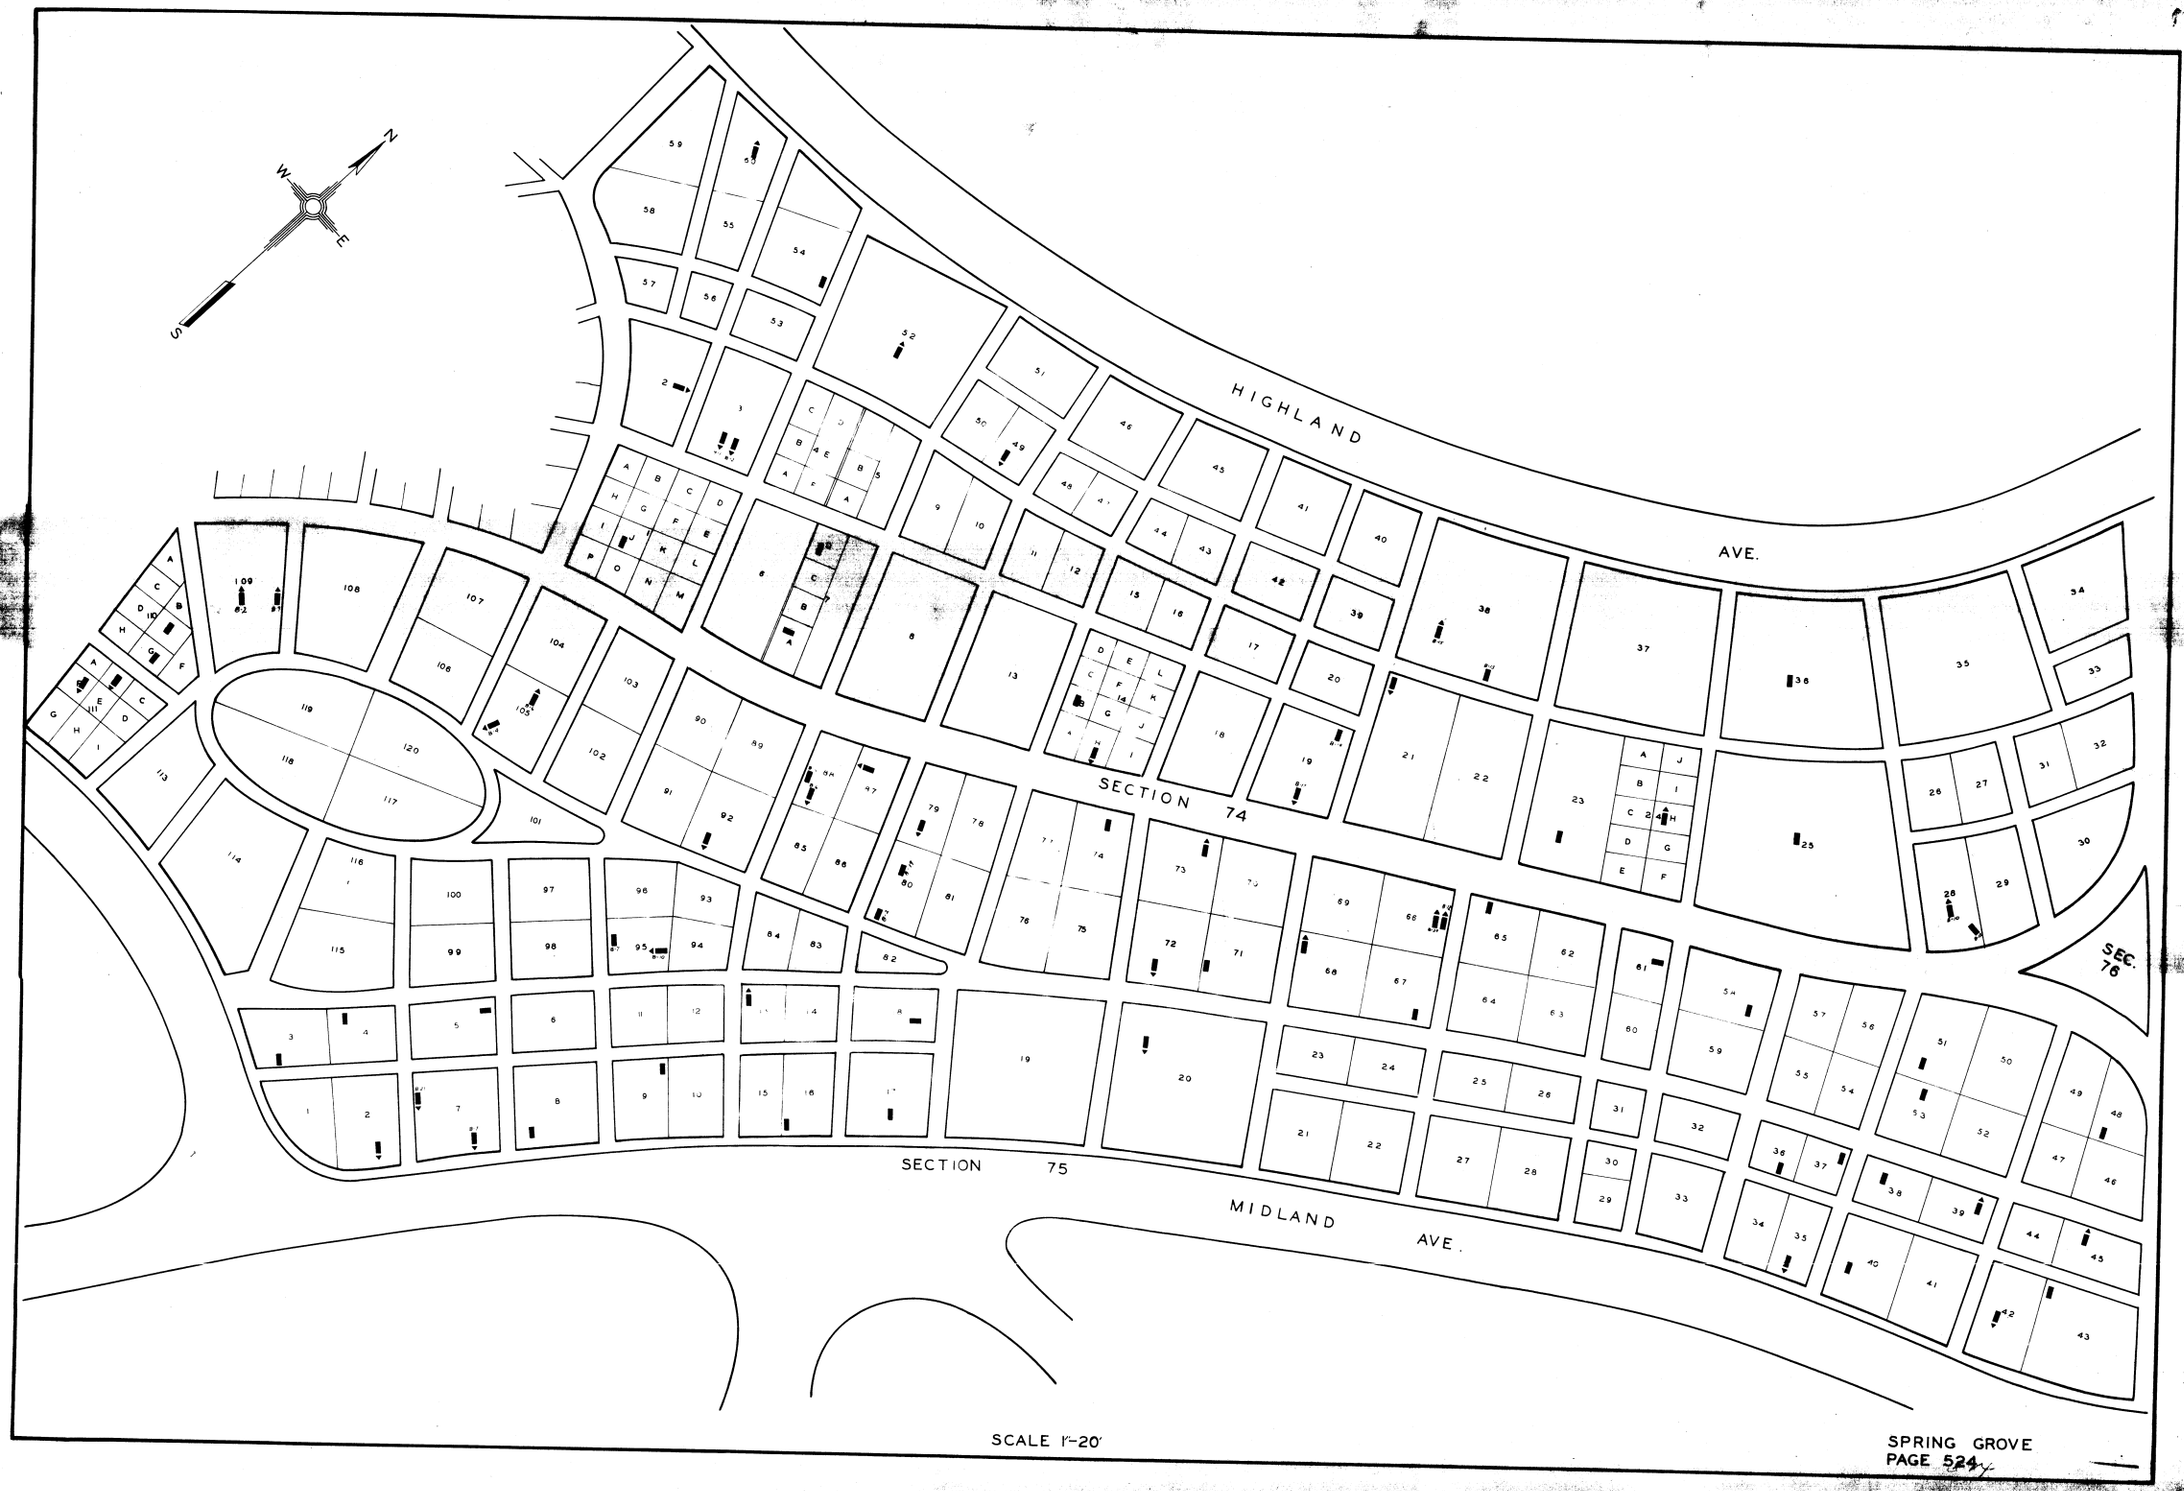

SCALE 1"-20'

SPRING GROVE
PAGE 524

SECTION 74

LOT	GRAVE	WAR	NAME
7-A	B-2	(18)	ARENDT THEO.
52	B-4	(19)	BATES GEO. H.
60	B-1	(13)	BATES JOSHUA H.
14-H	B-1	(25)	CASTLE CHAS. H.
25		(19)	CONNER PINES S.
38	B-15	(19)	DAVIS A. J.
38	B-13	(19)	DAVIS JOSHUA
14-B	B-1	(18)	DUNHAM GEO. C.
7-D	B-1	(19)	FRANKE HERMANN A.
24-H	B-2	(31)	GOODALL ART. E.
28	B-10	(19)	HAMILL WM. S.
28	B-12	(25)	HAMILL WM. B.
21	B-3	(19)	HAMBROCK JOHN H.
36	B-20	(19)	JACKSON GEO. A.

LOT	GRAVE	WAR	NAME
23	B-1	(19)	LANGHO G A.
49	B-5	(19)	PECK HIRAM D.
3	B-2	(19)	RANDALL HARVEY E.
54	B-6	(19)	ROCKEY GEO W.
3	B-1	(19)	STARTSMAN A A.
19	B-14	(19)	VOLKERT ADAM
19	B-17	(19)	VOLKERT PHIL.
2	B-10	(19)	WEIZENECKER FRE. R.
1-J	B-1	(19)	WOODS ALF. H

SECTION 75

LOT	GRAVE	WAR	NAME
3	B-11	(19)	AIKHOFF HARMON
2	B-1	(19)	AMEREIN ROMAN
109	B-2	(19)	ARCHER WM. S.
40	B-6	(19)	ARMSTRONG HARRY G.
79	B-5	(19)	ALLEN LEW.
42	B-5	(19)	BIRCH R. E.
39	B-8	(19)	BRONSON CHAS. H.
36	B-11	(19)	BROWN WM. F.
73	B-7	(19)	BUCHERT PET.
74	B-11	(31)	CARSON EDW. D.
111-B	B-1	(19)	COLEMAN JOHN W.
72	B-5	(19)	CONRADI CHRISTIAN
88	B-6	(16)	DAVIS DAV. D.
88	B-4	(19)	DAVIS DAV.
92	B-1	(16)	DAVIS JOHN
66	B-12	(19)	DEPPE HERMAN
66	B-24	(19)	DREHER HENRY
80	B-2	(19)	EDWARDS HENRY
58	B-16	(19)	EVERSON WM. B.
109	B-9	(19)	FERREE WM.
20	B-18	(19)	FINDLAY JOHN
111-F	B-1	(19)	FISCHER ERNST
18	B-9	(19)	GROSS PHIL.
13	B-11	(19)	HAYWARD HENRY
105	B-6	(19)	HOPKINS JOHN G.
105	B-4	(19)	HOPKINS WALT. F.
50	B-5	(19)	HOUST WM. B.
71	B-23	(19)	HEISSEL MARTIN
80	B-19	(19)	HOLT JOSIAH M.
8	B-13	(19)	HOOKER JOHN J.
53	B-7	(19)	JOHNSON SAML.
4	B-9	(19)	JONES WM. J.
7	B-7	(19)	KESTNER AUG. H.
7	B-21	(25)	KESTNER JOHN PHIL.
68	B-6	(19)	KOBMANN JOHN.

LOT	GRAVE	WAR	NAME
37	B-1	(19)	LUCK JOHN
110-G	B-2	(19)	LANHAM HOLLY W.
9	B-3	(19)	LINKENSTEIN JAC.
35	B-14	(25) (31)	McINTYRE EDG.
17	B-11	(19)	MORGAN JAS. G.
45	B-11	(19)	MATHEWS HUGH G.
16	B-11	(19)	NICHOLSON JOHN
67	B-9	(19)	RAABE HENRY
5	B-12	(19)	RAWLINS JOHN
95	B-7	(19)	RUPPRECHT GEO.
38	B-8	(19)	ROMANS ALVIN T.
110-E	B-1	(16)	SANDERSON GEO.
65	B-8	(19)	SCHMERR HENRY
48	B-2	(19)	SMITH WM. W.
95	B-10	(19)	STOCK ADAM.
87	B-5	(31)	SUNDERMANN JUSTUS F.
43	B-1	(19)	TRABER JAC. H.
61	B-4	(19)	WIEMER FABIAN

SECTION 77

LOT	GRAVE	WAR	NAME
50	B11	19	BATES CALE B.
73	B15	31	BRITTING JOHN
108-K	B 1	19	BROWN FREDK.
11	B16	19	BROWN. JAS. T.
34-S	B 1	19	BRUNER FRANK
46	B13	19	BUCHER WM. H.
79	B14	19	CAMPBELL FRANCIS D.
34-U	B 1	19	CHARLES JOHN W.
63	B 6	19	COLE GEO. H.
78	B 5	19	DAYTON LEWIS M.
70-B	B 2	31	DAVIS LESLIE W.
79	B 3	1	DRAKE ISAAC
84	B28	19	DULHAGEN ISAAC.
41	B 4	19	DUNN ELMORE
88-A	B 3	19	ELDRIGE ALF.
95	B 3	19	FERGUSON JOS. C.
106	B15	19	FISHER GEO.W.
106	B 5	19	FISHER SAM'L. S.
106	B12	19	FISHER WM. H.
58	B 2	19	GOSLING ALB. G.
58	B 5	19	GOSLING ELAVIUS J.
9	B 8	19	HALL WILLIAM
92	B 4	19	HILL WM. G.
4	B23	19	HOLMES HENRY S.
34-G	B 2	19	HUSSEY JOHN W.
105	B10	19	JORDAN NATHAN E.
7	B 4	1	KEYS RICHARD
61	B10	19	LEASURE RUDO.
75	B 1	19	LEAMAN ROBT. F.
10	B17	19	M'SALPIN HENRY
60	B11	19	MILLER JOHN H.A.
76	B 9	19	MILLS DAVID M.
91	8	19	MITCHELL JOHN
54	B 1	19	M'CARTHUA A.J.
108-L	B 1	19	ROTH AUG.
1	B11	25	SCHROTH JOHN
105	B 5	19	SEMPLE JAS. Y.
8	B 9	19	SHUMARD JOHN H.
98&98-A	B 1	19	SMITH WM.
29	B12	25	WAGONER JOHN J.
25	B24	31	WATES BARRETT
33-A	B 3	19	WHEELER WM. F.
89	B 3	19	ALDRICH LUMAN A.
108-J	B 1	19	BICKLER JOHN
90	B 5	19	FOOTE HY. E.
3	B 8	19	FRY BENJ. S.J.
27	B 12	19	GRONEWEG FREDH.
63	B 9	19	HANNA WM.
67	B 13	19	JAMES FRANK B.
21	B 9	25	MIDDLETON OSCAR L.
31	B-9	31	GOUGH FRANK S.

SPRING GROVE SECTION 78

LOT	GRAVE	WAR	NAME
1	B 4	19	CHAMBLISS WM. P.



SECTION - 77 S. & 78.
SCALE 1"-20'

SPRING GROVE
PAGE 528

SECTION 97

LOT	GRAVE	WAR	NAME
3	B12	(19)	LOCKE WM. R.
8&9	B 2	(19)	EWING B. MARTIN

SECTION 96

LOT	GRAVE	WAR	NAME
	28	(19)	BEINHART DAV.
IN CAT 2		(19)	DAVIS F. BENJ.
IN CAT 10		(19)	DAVIS CHAS.

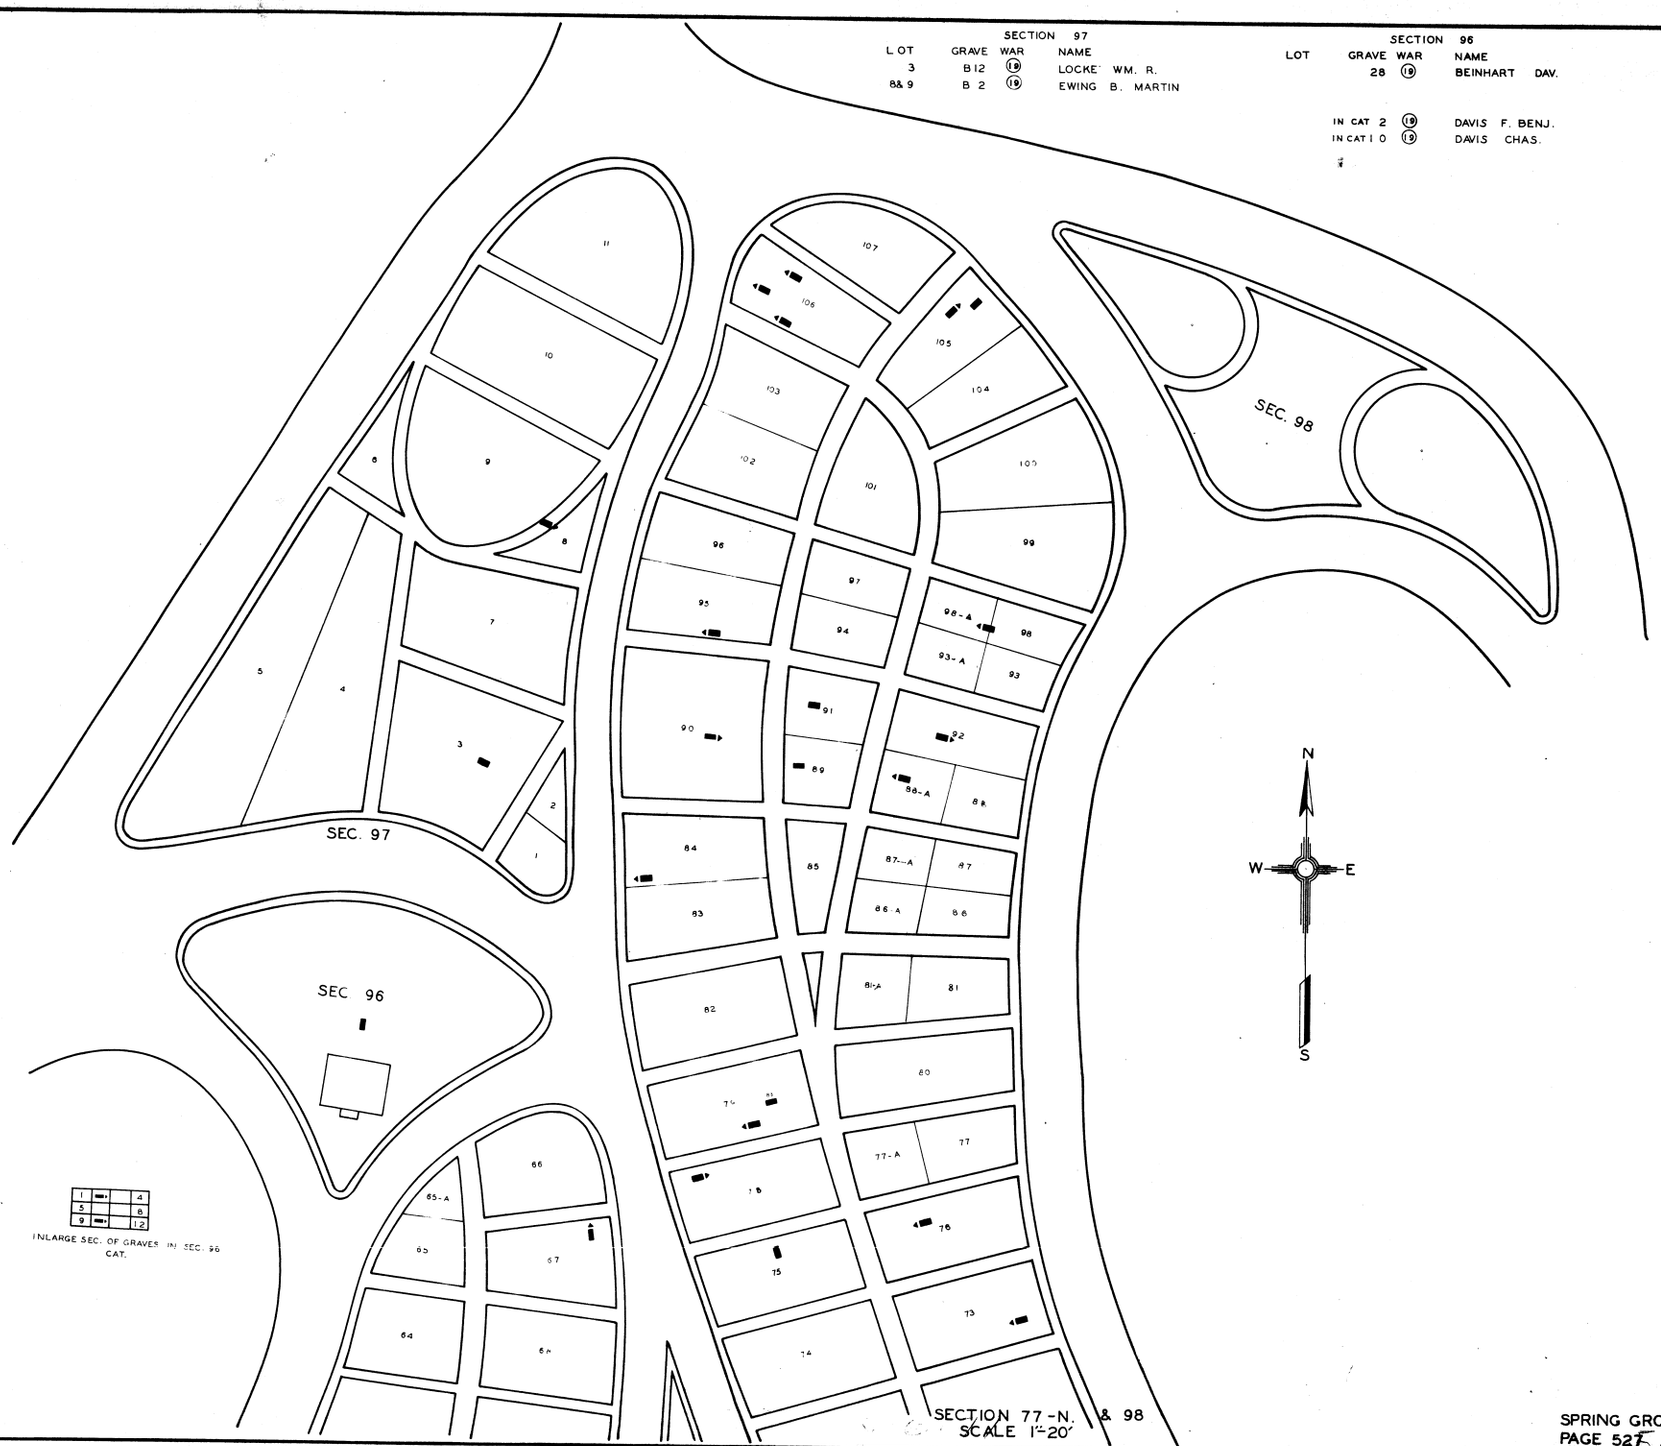

SECTION 77-N. & 98
SCALE 1"=20'

SPRING GROVE
PAGE 527

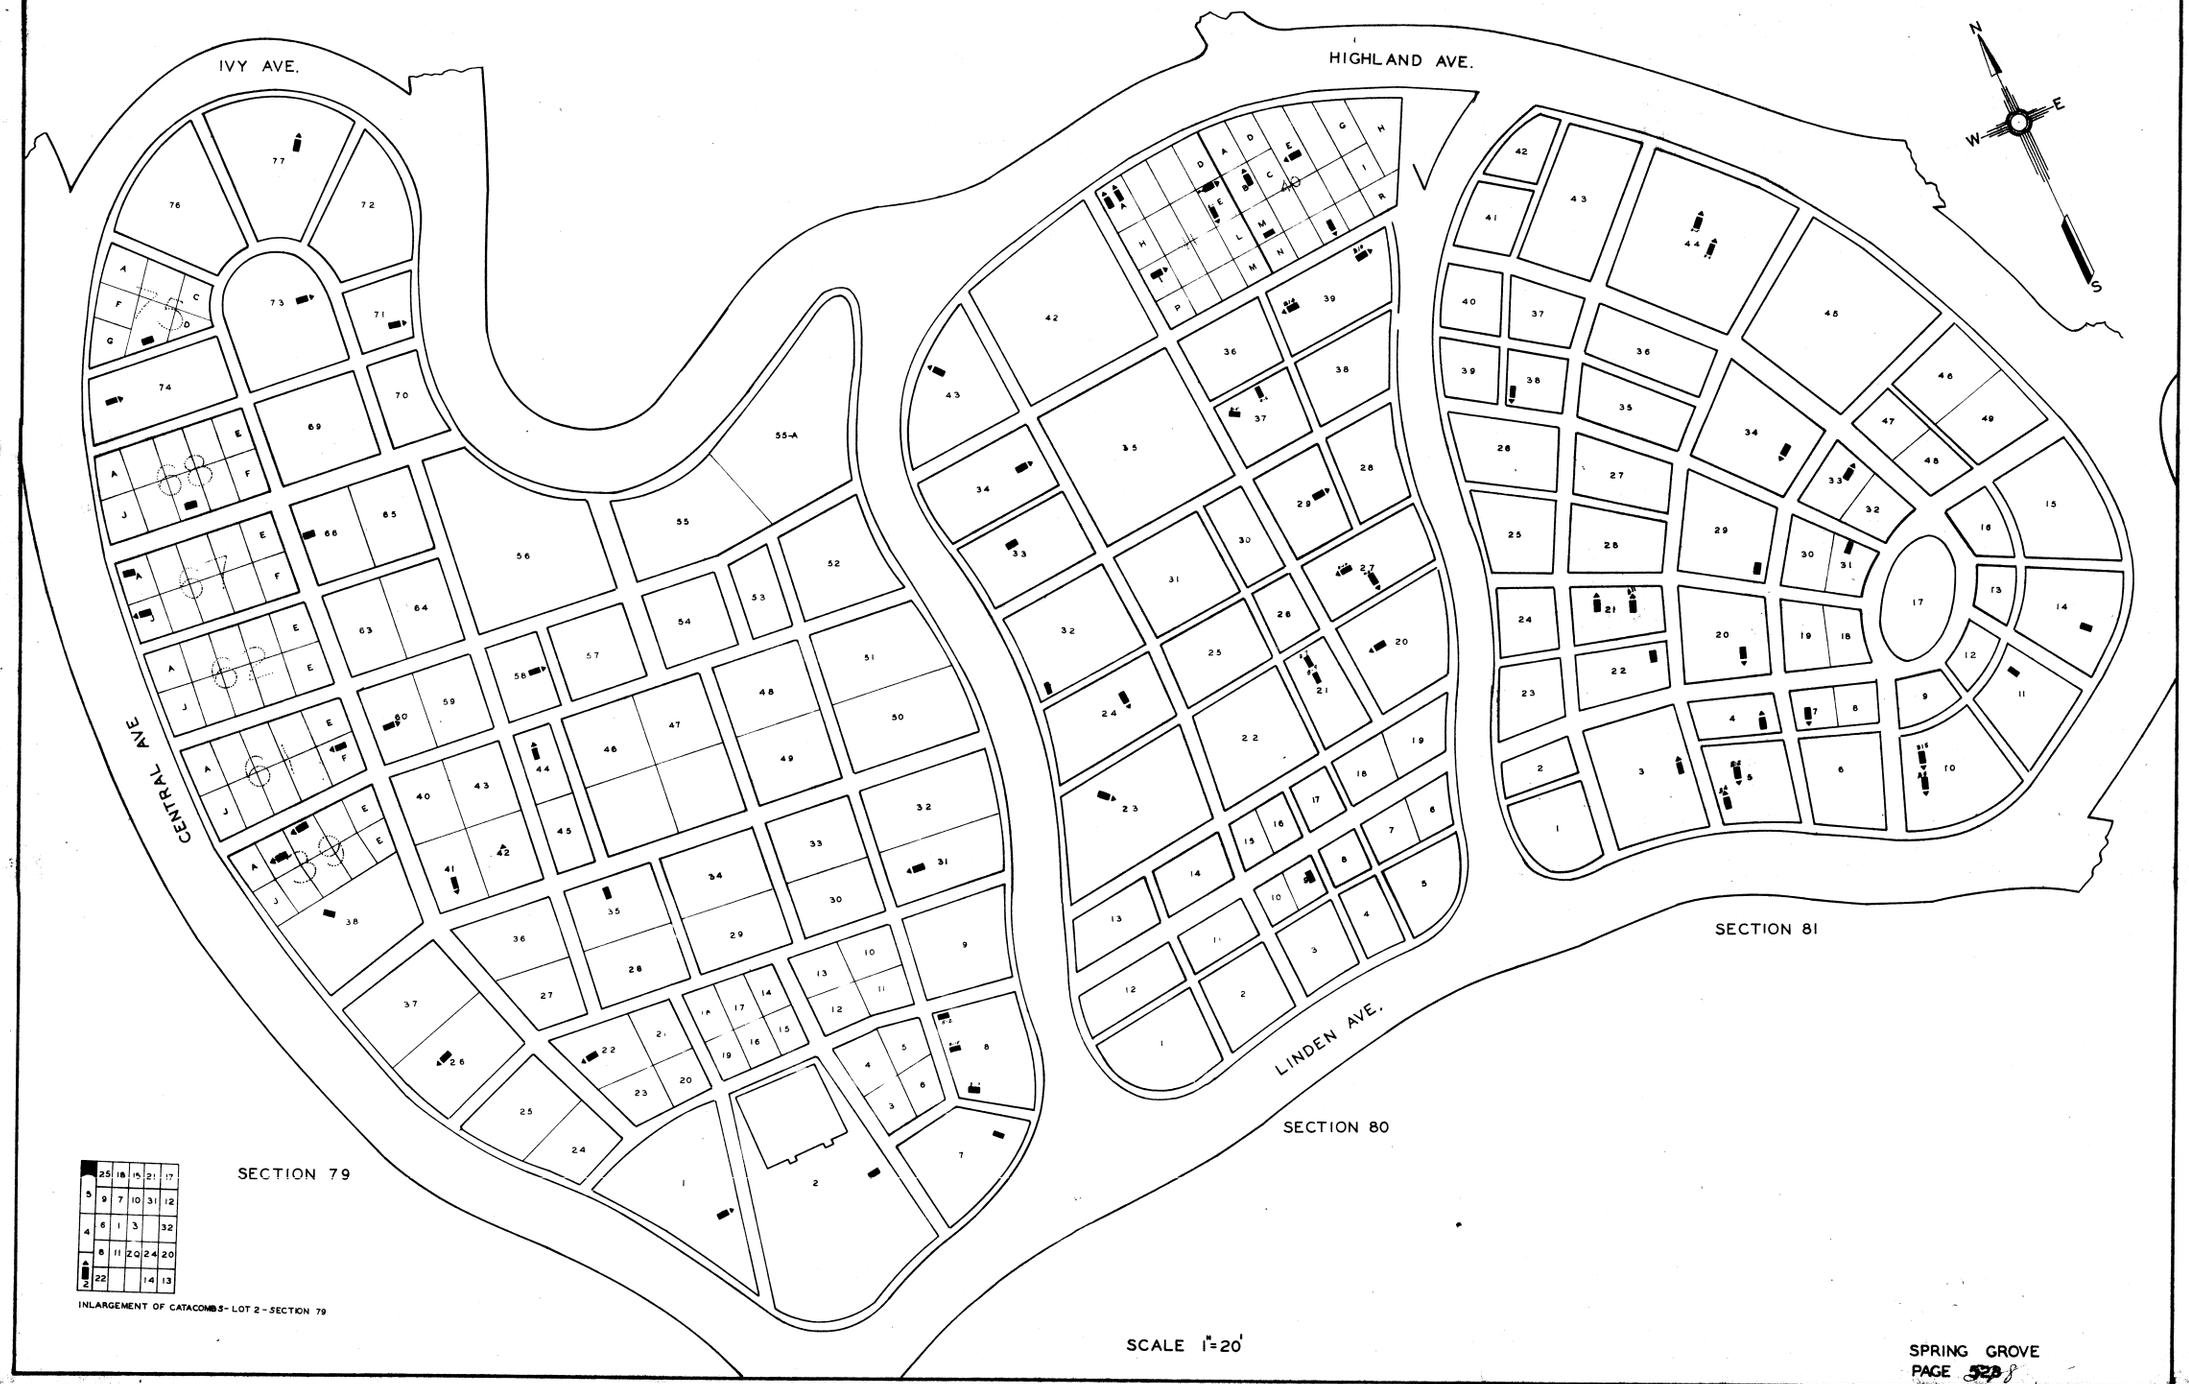

INLARGEMENT OF CATACOMBS - LOT 2 - SECTION 79

SCALE 1"=20'

SPRING GROVE
PAGE 528

SPRING GROVE SECTION 79

LOT	GRAVE	WAR	NAME
66	B 5	(18)	BROWN PETER
8	B 15	(18)	BATCHELDOR JOHN K.
42		(18)	BRICKLEY GEO. W.
39-C	B 2	(19)	CRAMER DAV.
8	B 2	(10)	BATCHELDER JOHN
67-J	B 1	(19)	DOWNEY JAS. F.
68-H	B 3	(19)	HAYES JOHN G.
71	B 2	(19)	HURLEY WM. C.
35	B 4	(19)	JONES SAML. S
67-A	B 3	(19)	KNOX HENRY
44	B 1	(10)	LEE LEW. H.
2	B 2	(19)	LEWIS ALB.
2	B33	(19)	LEWIS SAM'L. W
8	B 10	(19)	OWEN A. D.
7	B 7	(10)	OWENS OWEN
26	B 7	(19)	PEEBLES JOS. S.
1	B 9	(19)	PIATT JOHN J.
73	B 7	(19)	PRINCE HENRY
74	B 4	(19)	RHEIN JOS.
39	B 1	(19)	RIKER WM. H.
38	B 3	(19)	SHACKLEFORD FERDINAND S.
75	B 3	(19)	SMITH THEODORE
77	B 8	(19)	STEELE CHAS. M.
22	B 4	(19)	STEGNER HENRY
61-F	B 2	(16)	SMITH RUSS.
41	B 8	(19)	VOIGHT LOU.
60	B 3	(19)	WHITMORE THOS.
31	B 6	(19)	WILSON ALF.

LOT	GRAVE	WAR	NAME
58	B-4	(19)	ATTENBOROUGH R. H.

SPRING GROVE SECTION 80

LOT	GRAVE	WAR	NAME
33	B 2	(19)	BAKER CLARK A.
43	B 1	(19)	BANNING HENRY B
40-B	B 1	(19)	DICKINSON JAS
39	B14	(25)	HAUSER GUSTAN J
9	B 2	(19)	KINBALL JOHN F
20	B 4	(19)	LAW WM. C
39	B10	(19)	MOLTER ADOLPH
40-E	B 2	(19)	OSSMAN LEVI
41-A		(15)	RAPP JOS.
27	B	(19)	REIF LOUIS N
34	B 6	(19)	RICE EDW.
29	B 6	(19)	SCHOENLE WOLFGANG
23	B 2	(18)	SMITH W. H.
		(19)	
41-I	B 1	(19)	THOLE JOS. C
24	B 2	(19)	WURLITZER HUDO.
37	B 5	(19)	BASSETT OSCAR E
37	B 6	(19)	BASSETT SAML
41-E	B 4	(19)	BENHAM JOHN
21	B 9	(33)	LUEKERING WM
27	B 10	(19)	REEF ADAM
41-E	B 1	(19)	RUSFORD CHAS. C.
32	B 24	(19)	SCHOTT JOHN
41-A	H	(19)	SCHUTZE H.
40-M	B 2	(19)	HECKLE JOS.
21	B 7	(35)	LEUKERING CLIFF. K
40-P	B 2	(19)	CARSON SCOTT

SPRING GROVE SECTION 81

LOT	GRAVE	WAR	NAME
10	B15	(19)	BRUCE ROBT C.
10	B 9	(19)	BRUCE WM. H.R.
34	B14	(19)	DELANEY ROBT. G.
20	B10	(19)	DIEHI JACOB
33	B 7	(19)	GOODMAN GEO. S.
4	B 4	(19)	HAYDEN GEO. S.
5	B12	(19)	HAZARD J.H.
29	B 3	(19)	HOPKINS RICHARD
21	B15	(19)	PARIS CHAS. L.
21	B11	(19)	PARIS JOS. C.
14	B 8	(18)	PORTER WM.
5	B 4	(15)	SNELLING JAS. G.S.
22	B15	(19)	STRUB REINHARD
7	B 6	(19)	TOOKER AMOS
44	B 5	(19)	WALLANCE CHAS.
31	B 9	(19)	SPENCER WM.
38	B 7	(19)	STROBEL JOHN M.
44	B 2	(10)	WALLACE ROBT.
3	B 11	(18)	BARR DAVID M.
11	B 5	(19)	AVERY ANDREW J.

SECTION 84

LOT	GRAVE	WAR	NAME
30	B-2	19	AYRES JAS. A.
17	B-11	19	CHILO WARREN H.
9	B-5	19	FOLGER JAS.
91	B-2	1	FRENCH JEREMIAN
9	B-26	29	GATES GEO. N.
18	B-3	1	HATCH ABNER
18	B-7	10	HATCH WM. S.
9	B-29	31	HENDRICKS MILES E.
18	B-10	19	KING JOHN H.
14	B-12	19	McINTYRE JOHN M.
83	B-1	19	RIGGS JOHN H.
12	B-18	19	ROSS CHAS. E.
54	B-4	19	SCHERER L. R.
67	B-2	19	SMEDLEY DAN. P.
18	B-5	10	STANLEY WM.
72	B-1	19	STRONG CARY G.
9	B-17	19	WALLING DAN.
31	B-7	25	WEAVER JAS. T.
3	B-1	19	WILLIAMS CHAS

LOT	GRAVE	WAR	NAME

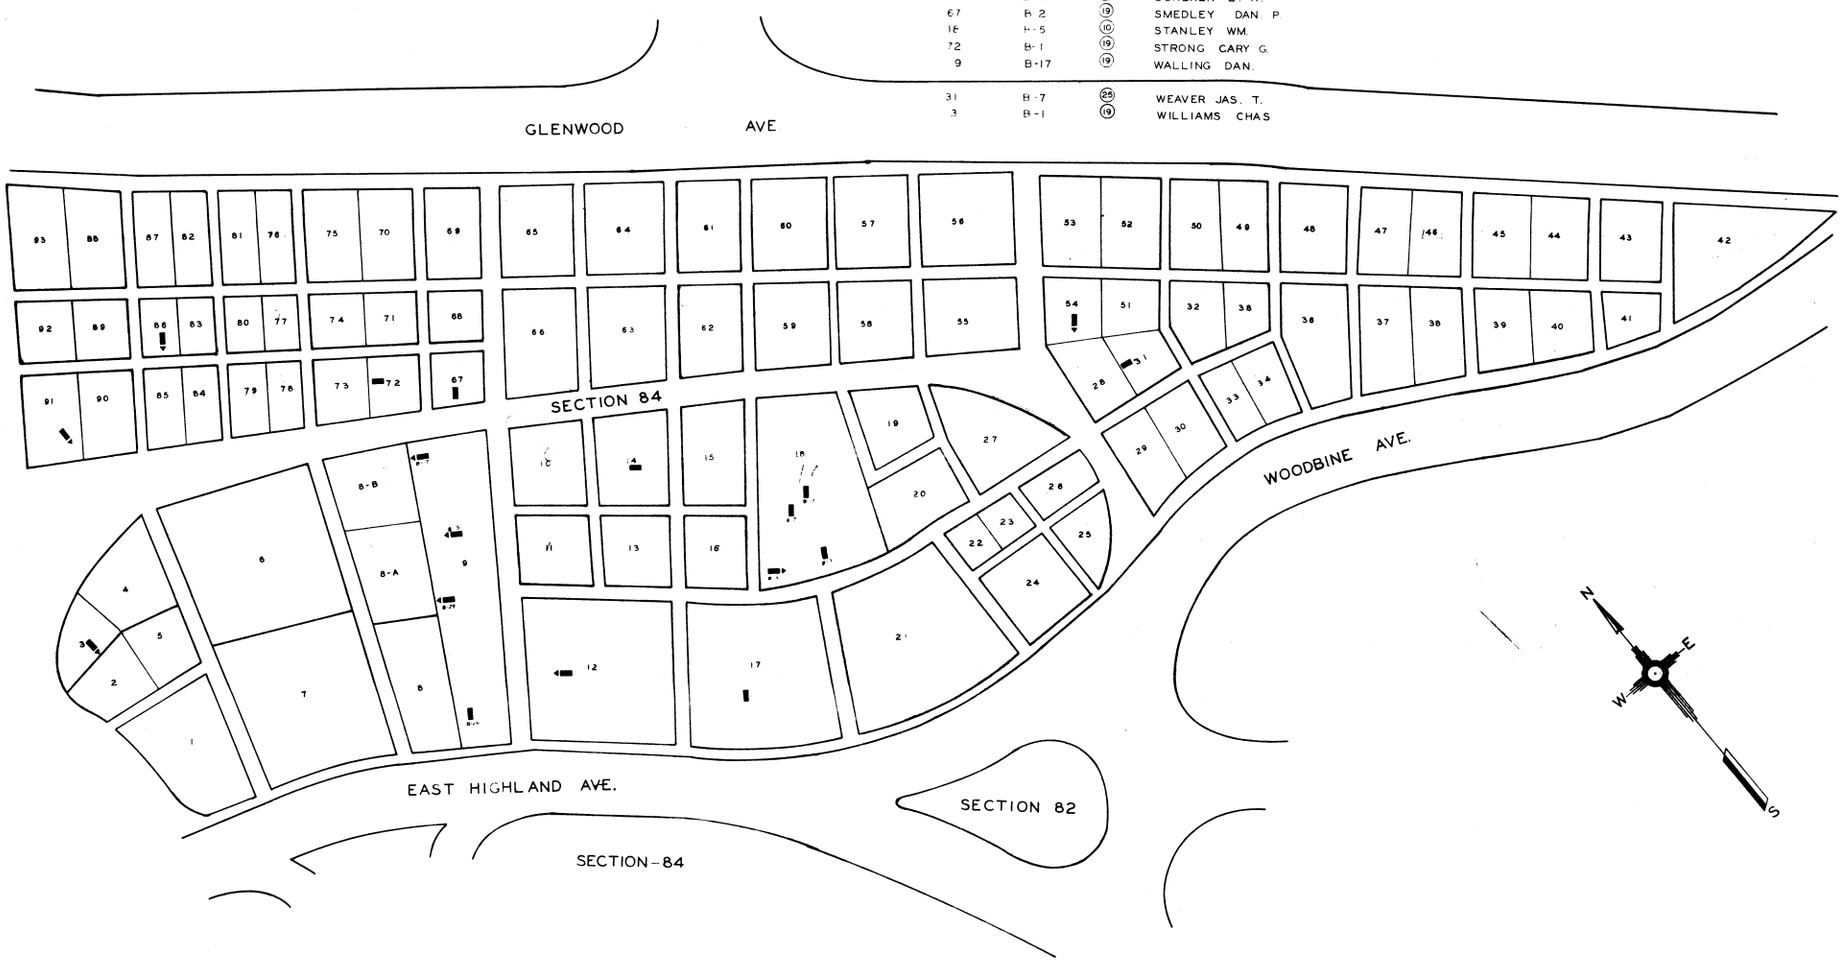

SCALE 1"=20'

LOT	GRAVE	WAR	NAME
143	B- 1	(19)	ARMSTRONG WM. J.
119	B- 1	(19)	BREMFOERDER HENRY
72	B- 2	(19)	BROMLEY ROBERT
37	B- 2	(19)	BULTMAN EDW. E.
76	B- 3	(19)	CHAPMAN WM. S.
75	B- 6	(19)	DEARMOND JAMES A.
14	B-10	(19)	DELFENDAHL HENRY
25	B- 4	(19)	DONALDSON ANDR.
25	B- 3	(19)	DONALDSON ARTHUR
144	B- 2	(19)	FORAKER JOS. B.
9	B- 1	(19)	GOOD DANL.
140	B- 1	(19)	GOOD JOS.
115	B- 1	(19)	GRAY GEO. A
11	B-14	(31)	GRIFFITH HAROLD J.
40	B- 4	(31)	HOADLEY GEO.
90	B- 3	(19)	LAW JOHN H
27	B- 3	(19)	MAAG FRANK G.
80	B- 3	(19)	MILLER ISAAC N.
30	B- 3	(19)	MORGAN JAMS
39	B- 1	(19)	PAPE HENRY A.

LOT	GRAVE	WAR	NAME
27	B- 4	(19)	RILEY JOHN
73	B- 4	(19)	SHATTUC WM. B.
45	B- 4	(19)	WEBER CHRISTIAN
92	B- 3	(31)	YEISER HENRY C
86	B- 1	(19)	IREDELL JAMES W.
3	B- 1	(31)	KIECHLER PHIL S.
41	B-3	(19)	RICHARS CHANNING
37	B- 3	(33)	BULTMAN CHAS E
60	B- 3	(31)	GALLAGHER ANDREW C.
108	B- 4	(33)	HILL GEO. S.



SECTION 86
SCALE 1"=20'

SPRING GROVE
PAGE 231



LOT	GRAVE	WAR	NAME
57	B-12	31	BUTTERFIELD BRYANT S.
21	B-4	19	CARPENTER WM. B.
145	B-1	19	HERRON WM. C.
63	B-6	19	KRUSE HENRY.
96	B-6	31	LANGDON MELCOLM E.
48	B-1	19	LE BLOND R. E.
20	B-6	19	MITCHELL PIERSON R
141	CAT-1	19	PITTS JOHN A.
124	B-3	31	REED CHAS. L.
90	B-3	19	WARRINGTON JOHN W.
96	B-4	31	BACHELOR RUS'S. M.
89	B-4	31	BRAGG ROSS W.
57	B-2	19	BUTTERFIELD A.S.
4	B-1	19	ISHAM ASA B.
54	B-1	19	POTTER JAS. M.
57	B-9	19	SANDS GEO. F.
13	B-1	19	TAYLOR J. G.
56	B-2	31	WUENKER ALB. H.

SCALE 1"= 20'



SCALE 1" = 20'

SPRING GROVE
PAGE 533



SCALE 1"=20'

SPRING GROVE
PAGE 534

LOT	GRAVE	WAR	NAME
237	B-59	31	AULT HARLEY R.
152-I	B-3	19	ALLBRIGHT JOS.
172	B-5	19	BELMER HENRY B.
172	B-8	19	BELMER HERMAN
205	B-1	19	BOYD WM.
89-A	B-1	31	BUERGER RAYMOND F.
76-T	B-7	19	BURNHAM VICTOR
151	B-2	19	CHAPIN ART. B.
78-M	B-1	19	CHARLTON JOHN R.
31-D	B-2	19	CANWAY THOMS J.
222	B-5	19	CRAIG PETER
157	B-4	19	DILLON THOS. H.
63-P	B-1	19	DOLEZICH CHAS. F.
83-I	B-1	19	DYE DUDLEY W.
31-R	B-3	19	WDWARDS JOHN T.
78-P	B-3	19	FISHER THOMS. E.
153-H	B-1	19	FOGG W. H.
207-N	B-1	19	GRAHAM JOS.
252	B-3	19	GARDNER SEBASTIAN
84-I	B-1	19	HAFLING JOHN
163-W	B-4	19	HALL THOMS. T.
149	B-1	19	HAMILTON JOHN A.
213-A	B-3	31	HARGITT JOHN W.
6	B-8	19	HENDERSON JAMES
116	B-3	19	HONERT HENRY
42-F	B-2	19	HUGHES THOMS P.
215	B-4	19	KAPPES PHIL.
76-X	B-1	19	KELLER JACOB
76-X	B-3	25	KELLER JACOB W.
64	B-2	19	KING JOHN R.
58	B-2	19	KLEINSCHMIDT EDW. H.
41	B-7	19	KOCH JOHN
6	B-7	25	KOESTER WM. F.
215	B-3	19	KUHN MICHL. E.
89-K	B-1	19	LA'BOITEAUX LEGRAND
170	B-2	31	LAWSON STAN.
206-N	B-3	19	LEISURE ANDW. J.
33	B-1	19	MARSH JOHN O.
166	B-1	19	MC DONOUGH FREDINAND
229	B-1	19	MC LEAN CHAS.
210	B-2	19	MC CROSKEY A.
75	B-3	19	MOORE WM. H.
164-D	B-6	19	MORRIS JOHN F.
78-I	B-2	19	NAGLE CONRAD
196	B-2	19	NAGEL HENRY F.
152-E	B-1	19	NEUMULLER PAUL
146	B-1	19	NUSS PETER
181	B-5	25	OLHABER WM. M.
76-N	B-3	19	ORR WM. T.
164 F	B-3	19	PARKER HENRY
227	B-1	19	PATTERSON SAML D.
99	B-6	25	PENN HARRY
76-C	B-2	19	POORMAN JOEL E.



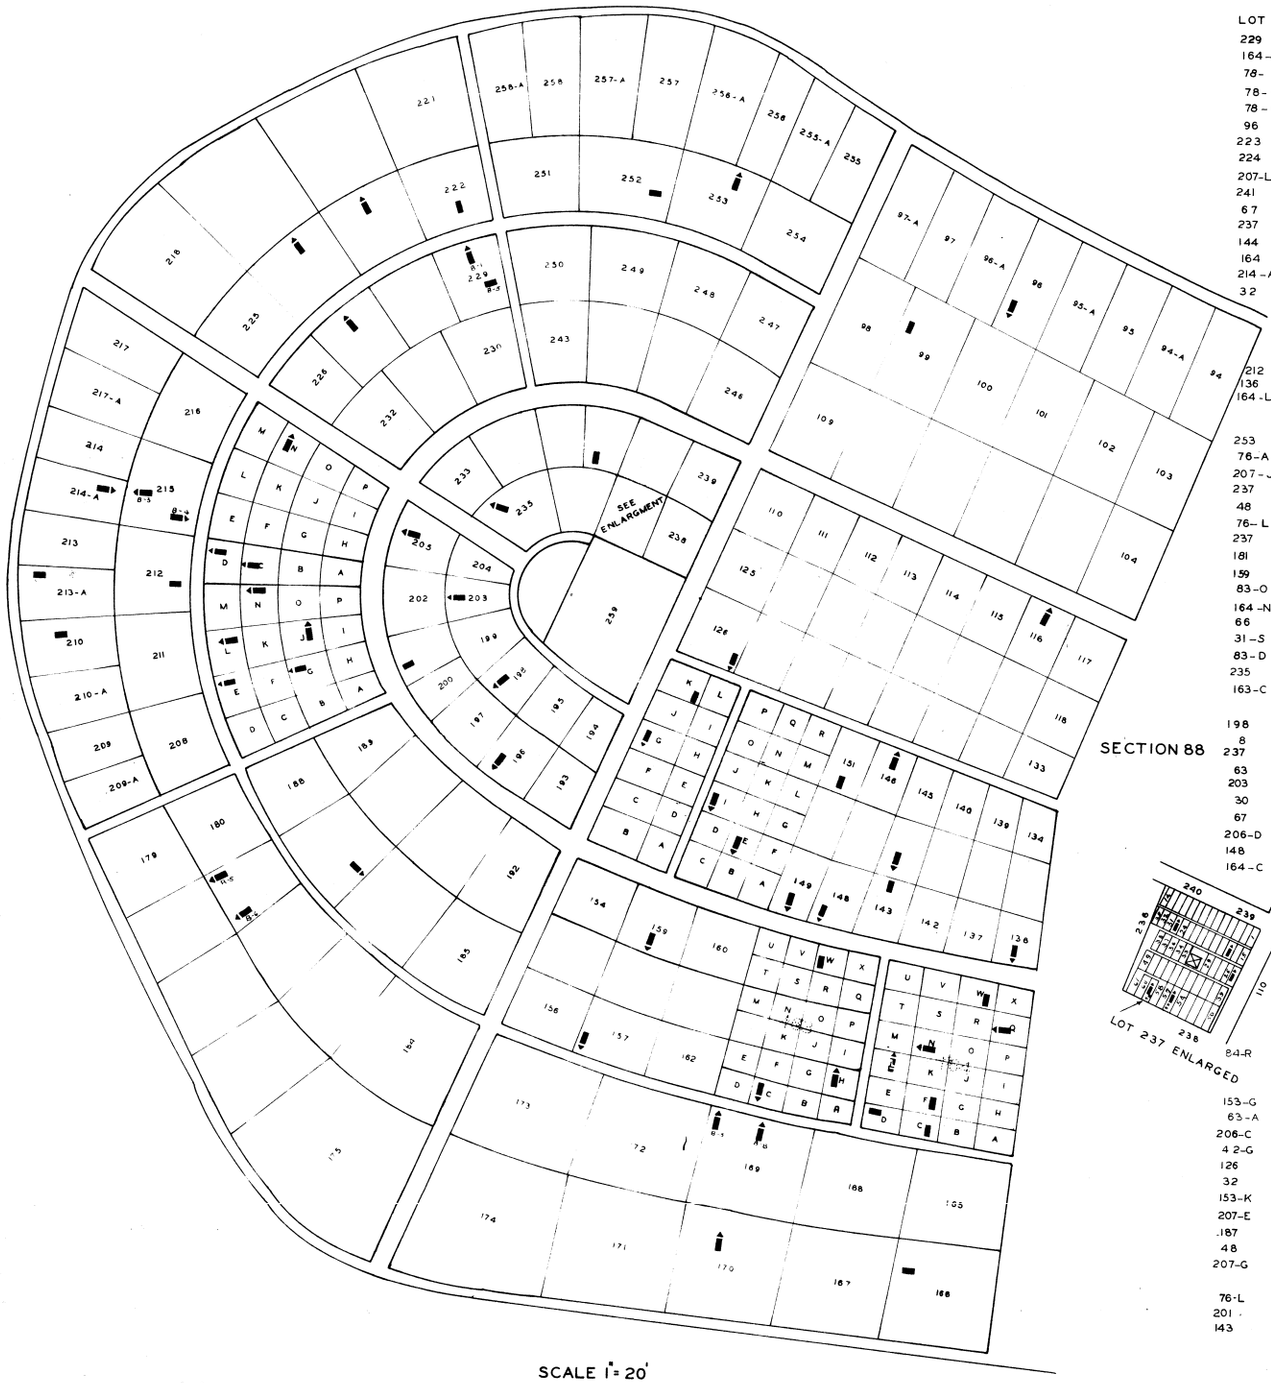

SCALE 1"= 20'

LOT	GRAVE	WAR	NAME
229	B-5	19	REES HENRY
164-W	B-4	19	RINGS JACOB
78-D	B-2	19	ROBINSON LORENZO
78-O	B-2	25	SANDERS THOS M.
78-O	B-1	19	SANDERS WM. F.
96	B-2	31	SCHNEIDER HENRY M.
223	B-2	19	SCHOTT LEO
224	B-2	19	SEIB THEO. W.
207-L	B-3	19	SHERWOOD THOS. C.
241	B-9	25	SIMON WM.
67	B-4	19	SMITH BENEDICT
237	B-30	19	SMITH WHITNER
144	B-1	19	STENGER JACOB
164	B-1	19	STEVENS LEMUEL A.
214-A	B-2	19	STEWART ALEX W.
32	B-1	19	STRUNK WM.
212	B-5	31	CRESSLER ALF. M.
136	B-1	33	FARREN HENRY V.
164-L	B-2	31	KIRKER GEO. H.
253	B-2	19	TAYLOR JOS. H.
76-A	B-2	19	TEALEN DAVIS T.
207-J	B-2	19	THOMPSON JACOB
237	B-55	19	TURNER WM. W.
48	B-3	19	UNDERHILL JAMES W.
76-L	B-2	19	VANHORN JOHN
237	B-35	19	WASHABAUGH GEO. H.
181	B-6	19	WEBSTER JOHN H.
159	B-3	19	WERNER FREDR. J.
83-O	B-1	19	WILLIAMSON GEO.
164-N	B-1	19	WILSON HART
66	B-7	19	WILSON JAMES A.
31-S	B-2	31	WOLFE WM.
83-D	B-3	19	WOOD LEWIS C.
235	B-3	19	WOOLLEY GEO. W.
163-C	B-1	19	YOUNG JOHN

SECTION 88

198	B-3	19	JONES JOHN T.
8	B-3	19	JONES DAVID J.
237	B-17	19	BAKER WM. A.
63	B-2	25	BACKER EDW.
203	B-2	19	BROMWELL ROBT. R.
30	B-12	19	CHEESEMAN THOS.
67	B-3	25	FISCHER GEO. A.
206-D	B-1	19	GOBRECHT E.
148	B-1	19	HAMMETT JOHN W.
164-C	B-2	19	HAUG GEO. U.
84-R	B-1	19	KRIEGER CHRISTIAN
153-G	B-2	19	MAUS WENDELL
63-A	B-1	19	M COMAS RICARD T.
206-C	B-1	19	PIEPENBRINK CHAS
42-G	B-1	19	SAFFIN JAMES
126	B-2	19	SENNETT ABNER J.
32	B-3	31	STRUNK HOWARD G.
153-K	B-4	19	TAGGART WM.
207-E	B-2	19	TAYLOR THOS. S.
187	B-6	25	TAYLOR WM. B.
48	B-6	25	UNDERHILL WHITTINGTON T.
207-G	B-1	19	WARDLE SAMUEL
76-L	B-4	19	HARMAN WM.
201	B-3	19	SCHWARTZ GEO.
143	B-6	19	SAVER GEO. H.

SPRING GROVE
PAGE 535

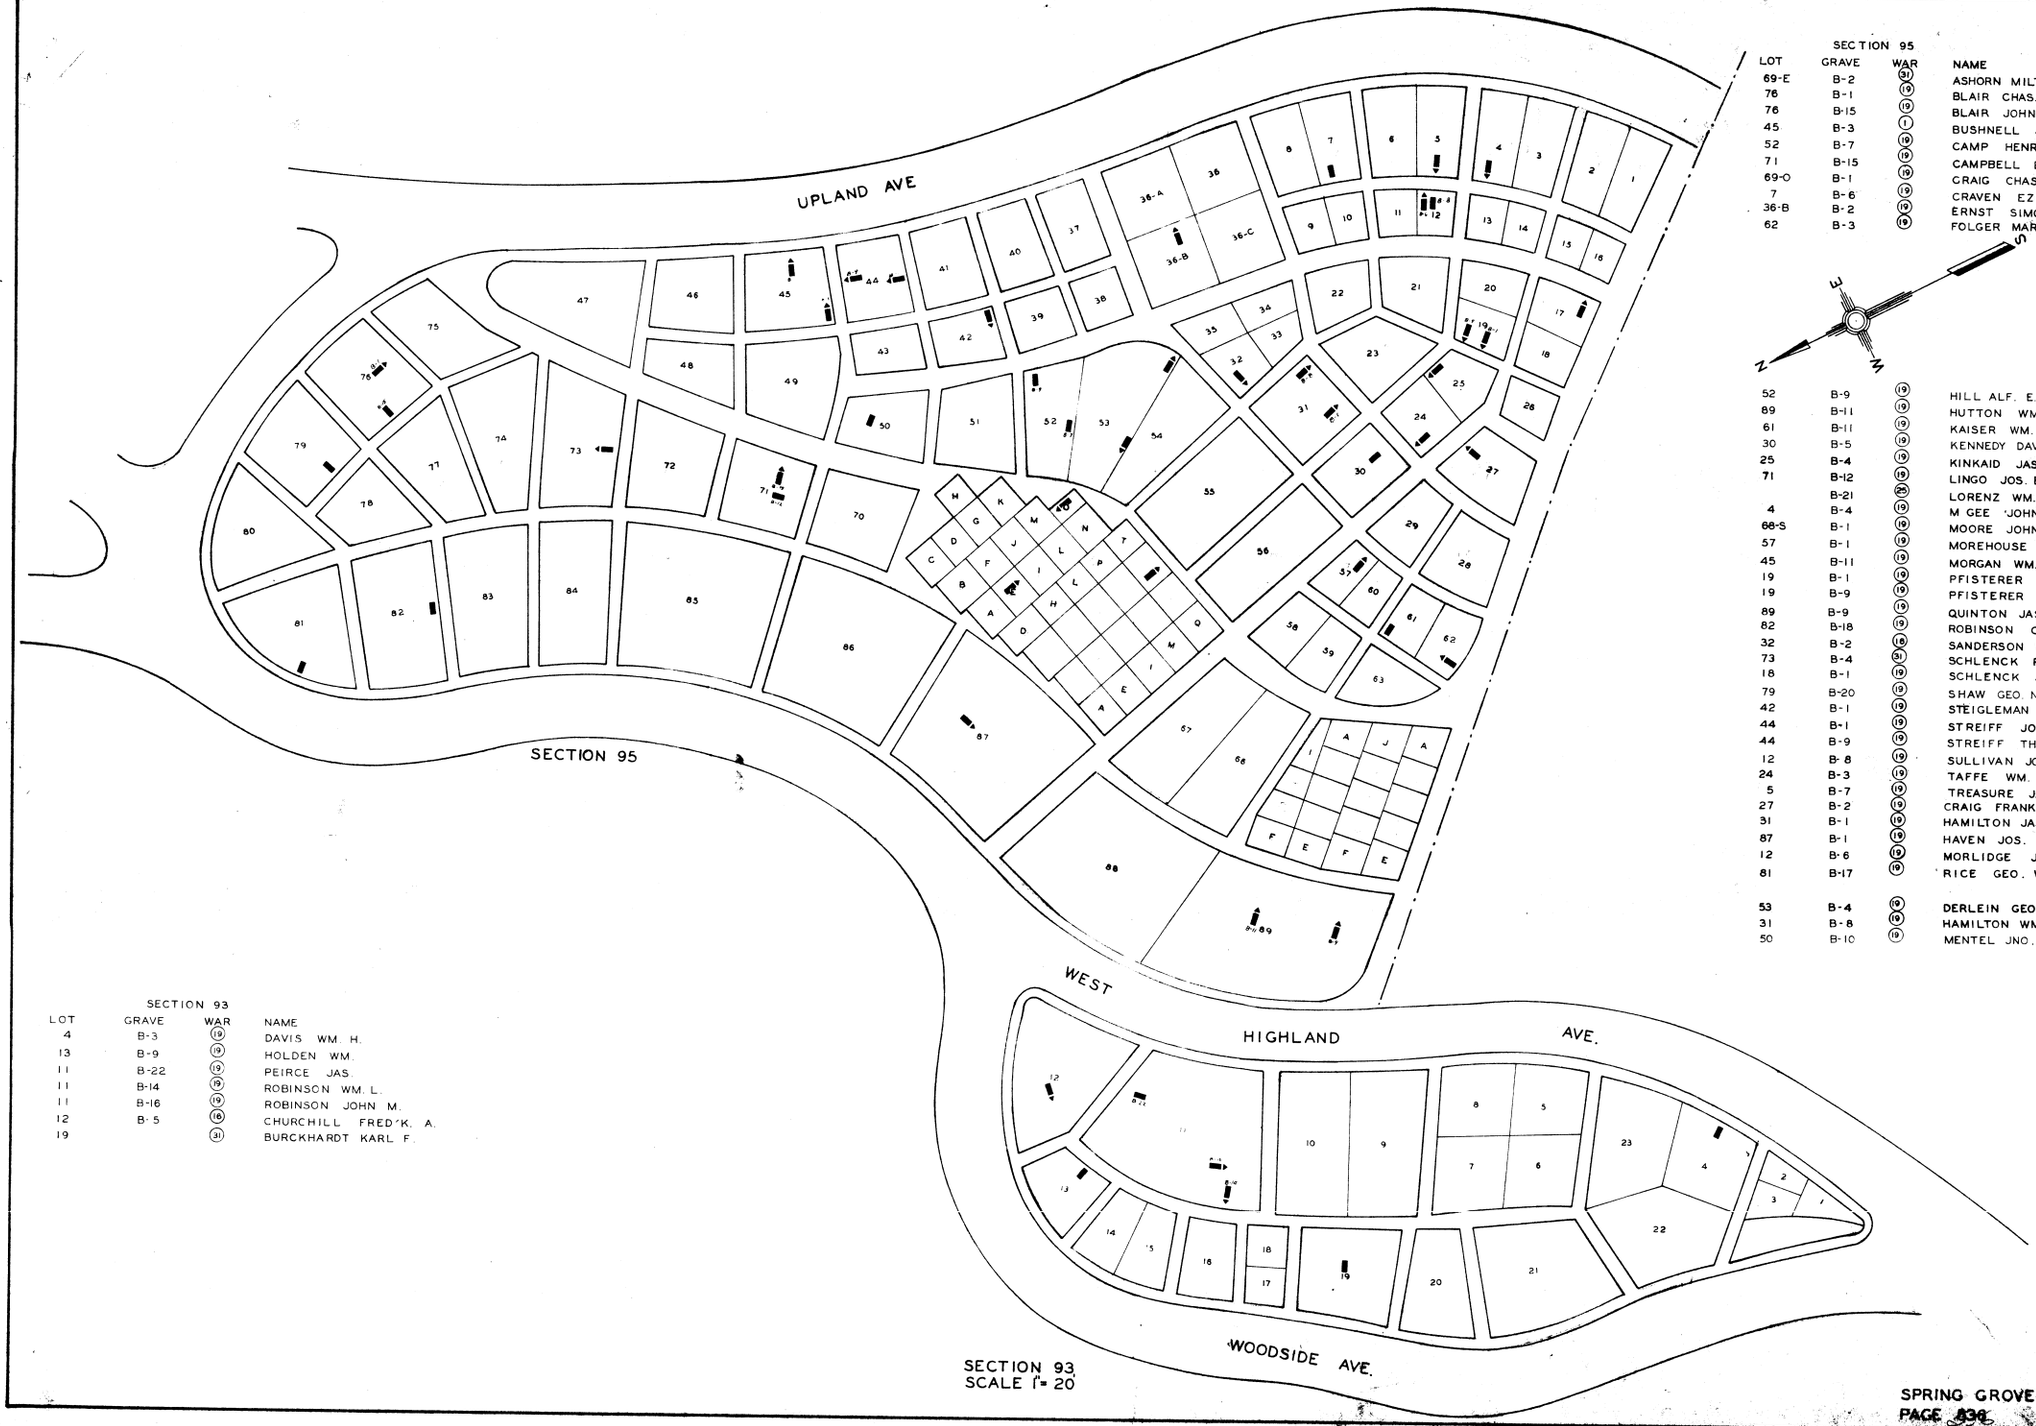

SECTION 95

LOT	GRAVE	WAR	NAME
69-E	B-2	31	ASHORN MILT. J.
76	B-1	19	BLAIR CHAS. T.
76	B-15	19	BLAIR JOHN M.
45	B-3	1	BUSHNELL JASON.
52	B-7	19	CAMP HENRY
71	B-15	19	CAMPBELL E. B.
69-O	B-1	19	CRAIG CHAS.
7	B-6	19	CRAVEN EZEKIEL
36-B	B-2	19	ERNST SIMON
62	B-3	19	FOLGER MARSHALL H.
52	B-9	19	HILL ALF. E.
89	B-11	19	HUTTON WM. E.
61	B-11	19	KAISER WM.
30	B-5	19	KENNEDY DAV.
25	B-4	19	KINKAID JAS.
71	B-12	19	LINGO JOS. B.
	B-21	20	LORENZ WM. H.
4	B-4	19	M GEE JOHN F.
66-S	B-1	19	MOORE JOHN H.
57	B-1	19	MOREHOUSE JOHN M
45	B-11	19	MORGAN WM. H.
19	B-1	19	PFISTERER JOHN
19	B-9	19	PFISTERER JOS.
89	B-9	19	QUINTON JAS. I.
82	B-18	19	ROBINSON CHAS.
32	B-2	19	SANDERSON WM. M.
73	B-4	31	SCHLENCK PAUL W.
18	B-1	19	SCHLENCK JAC.
79	B-20	19	SHAW GEO. N.
42	B-1	19	STEIGLEMAN JAC. W.
44	B-1	19	STREIFF JOHN B.
44	B-9	19	STREIFF THOM.
12	B-8	19	SULLIVAN JOHN
24	B-3	19	TAFFE WM.
5	B-7	19	TREASURE JAS. W.
27	B-2	19	CRAIG FRANK
31	B-1	19	HAMILTON JAS. B.
87	B-1	19	HAVEN JOS.
12	B-6	19	MORLIDGE JOS.
81	B-17	19	RICE GEO. W.
53	B-4	19	DERLEIN GEO.
31	B-8	19	HAMILTON WM.
50	B-10	19	MENTEL JNO. A.

SECTION 93

LOT	GRAVE	WAR	NAME
4	B-3	19	DAVIS WM. H.
13	B-9	19	HOLDEN WM.
11	B-22	19	PEIRCE JAS.
11	B-14	19	ROBINSON WM. L.
11	B-16	19	ROBINSON JOHN M.
12	B-5	16	CHURCHILL FRED'K. A.
19		31	BURCKHARDT KARL F.

SPRING GROVE
PAGE 836



LOT	GRAVE	WAR	NAME
36	B-13	(19)	ADAMS JAS. G. W.
114	B-2	(19)	ALDEN LEONARD B.
151	B-1	(19)	ANDERSON SAML. K.
170	B-3	(19)	ANGE THEO.
38	B-10	(19)	ASHMAD CHAS.
110	B-11	(19)	BABCOCK JOHN H. H.
180	B-2	(19)	BECK JAC.
56	B-18	(19)	BECKER JUL.
212	B-1	(19)	BEILER JOHN B.
47	B-20	(19)	BEYER MICHL.
163	B-11	(19)	BIRNBAUM JOHN
58	B-22	(16)	BOWMAN HENRY
34	B-1	(19)	BRIDGE GEO. W.
205	B-18	(19)	BROWN TIM. D.
17	B-16	(19)	CAMPBELL JAS. C.
122	B-9	(19)	CRITCHELL BRIAN P.
182	B-6	(19)	CUMMINS JAS. I.
154	B-8	(19)	DAVIS WALLACE M.
110	B-7	(19)	DEBUTTS CHAS. S.
34	B-10	(19)	FERRIS JAS.
136	B-2	(19)	FIDLER JOHN W.
78	B-14	(19)	FISHER HENRY
2	B-13	(19)	GARRARD JEPTHA
2	B-8	(19)	GARRARD KENNER
180	B-8	(31)	HALL STAN. W.
57	B-12	(19)	HANNAFORD EBENEZER
258	B-12	(19)	HARRISON WM. H.
70	B-8	(19)	HEGELE GEO.
17	B-21	(19)	HICKMAN JOHN B.
33	B-21	(19)	HIGDON BENJ.
186	B-5	(19)	HOLMES WM.
171	B-7	(19)	HULVERSHORN CHAS. A.
55	B-6	(19)	JOHNSON JAC. R.
75	B-8	(19)	LATTA LEONIDAS L.
32	B-3	(19)	LOWRY WM. J.
142	B-1	(19)	MAYHEW THOM. M.
27	B-6	(19)	MEYERS EDW.
127	B-7	(19)	MILLER DAV. W.
173	B-5	(19)	MILLER GEO.
171	B-6	(19)	MILLER JOHN
72	B-9	(19)	MURDOCK LUKE H.
40	B-36	(19)	OBERDING RUDOLPH
40	B-34	(19)	OBERDING WM.
38	B-14	(19)	OWENS GEO. W.
38	B-1	(19)	OWENS WM.
95	B-6	(19)	PHELPS CATHEL H.
158	B-5	(19)	ROUSE GEO. L.
169	B-3	(19)	RUSSELL A. R.
113	B-2	(19)	RYAN JOS.
35	B-4	(19)	SCHMIDTHROST F. G.
78	B-10	(19)	SWENKER FRED. W.
177	B-3	(19)	SKARDON JAS. M.
3	B-19	(19)	SPENCER WM.
126	B-1	(19)	TRAXEL WM. ALIAS TROXELL WM.
165	B-2	(31)	WALDMAN CARL J.
175	B-8	(19)	WALTER GEO. F.
83	B-8	(19)	WEBB GEO.
10	B-6	(19)	WHITEHOUSE THOM. H.
3	B-13	(19)	WILLIAMSON JAS. T.
205	B-17	(19)	HUNT MARCUS A.
36	B-9	(19)	AUSPERGER HENRY
97	B-2	(19)	BECKWITH JOHN H.
71	B-9	(19)	GOBLE EDW.
57	B-14	(19)	HANNAFORD ROGER
48	B-13	(19)	HOELTZE AUG
178	B-2	(19)	INNIS ROB'T. B.
178	B-8	(19)	MARSHALL WM. G.
72	B-27	(19)	MURDOCK JAS. JR.
88	B-11	(19)	RITT JOHN M.
145	B-5	(19)	WHITCOMB GEO. E.
107	B-6	(31)	YOUTSEY RALPH. H.
107	B-3	(19)	YOUTSEY THOS. B.
35	B-9	(25)	SCHMIDTHORST FRED'K. G.
116	B-2	(10)	JELLEFF BENJ.
169	B-8	(31)	JONES JEAN PAUL

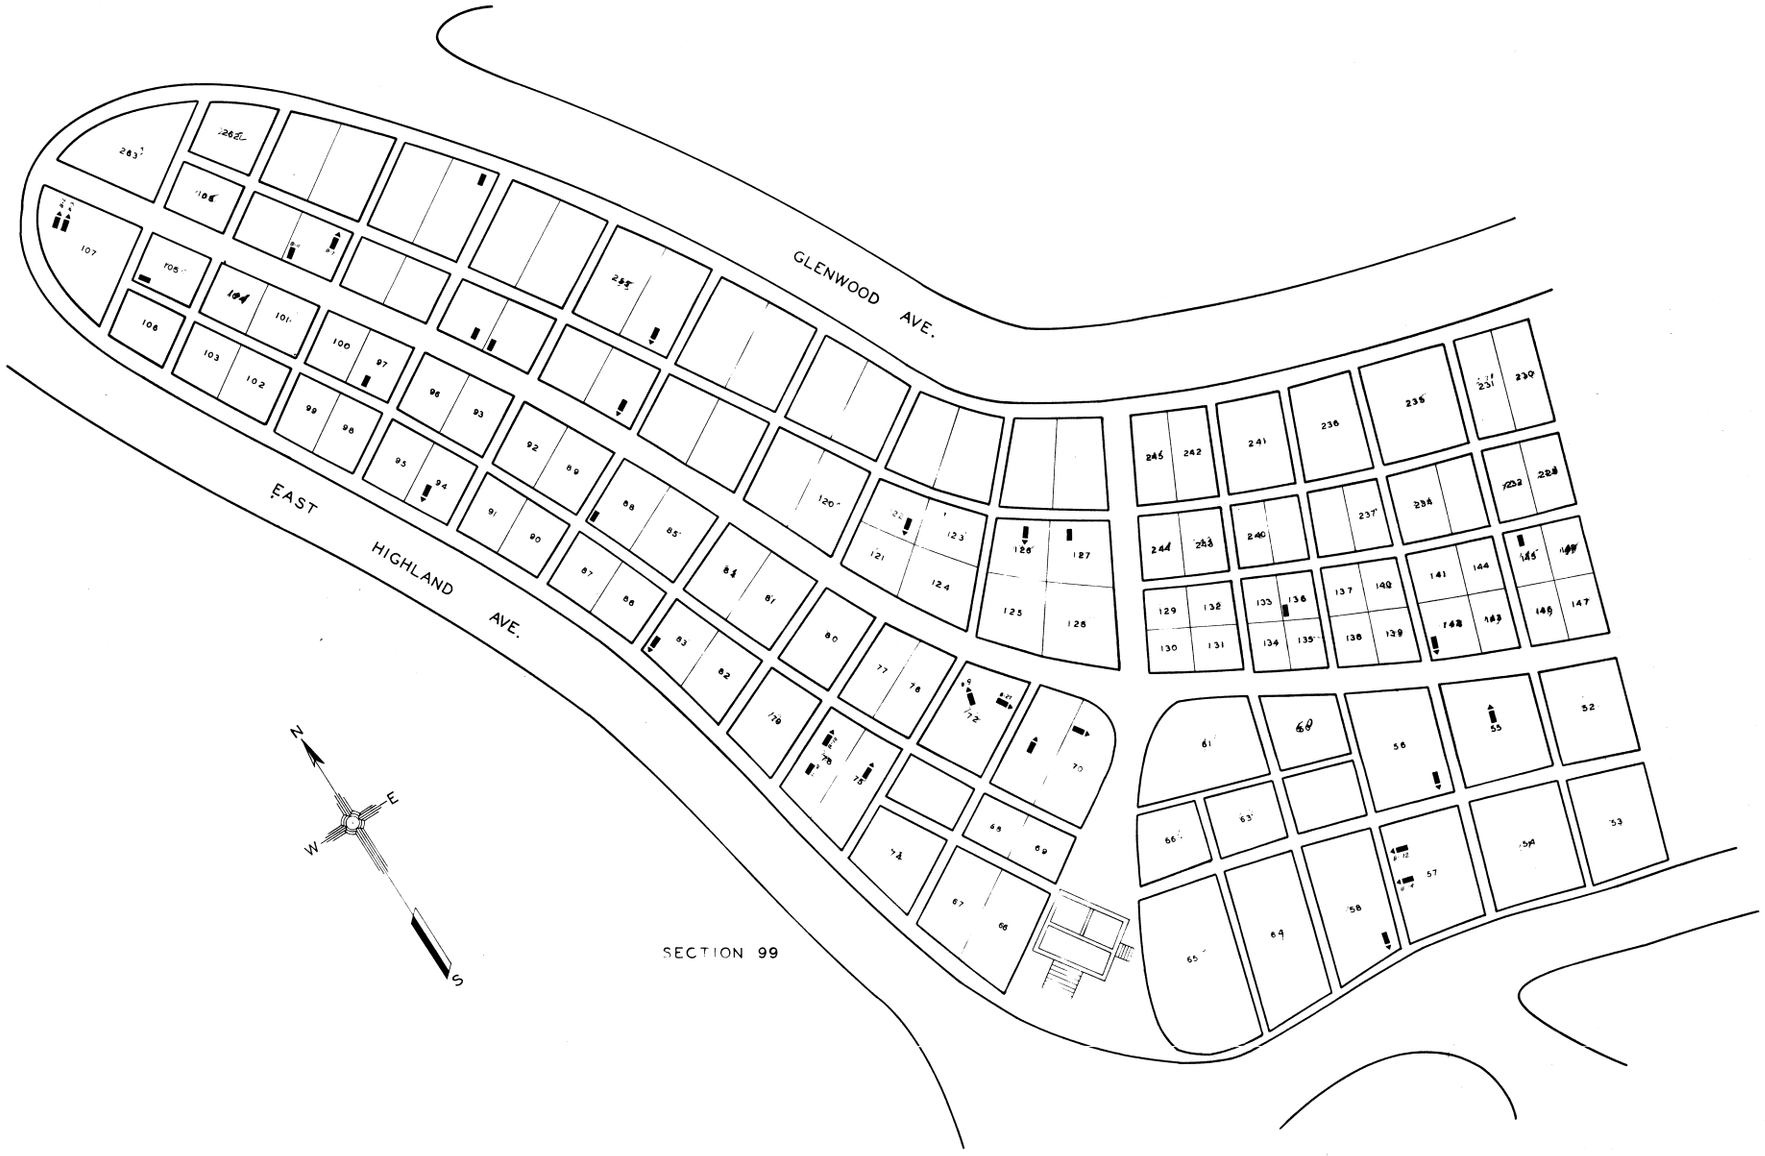

SCALE 1" = 20'

SPRING GROVE
PAGE 538

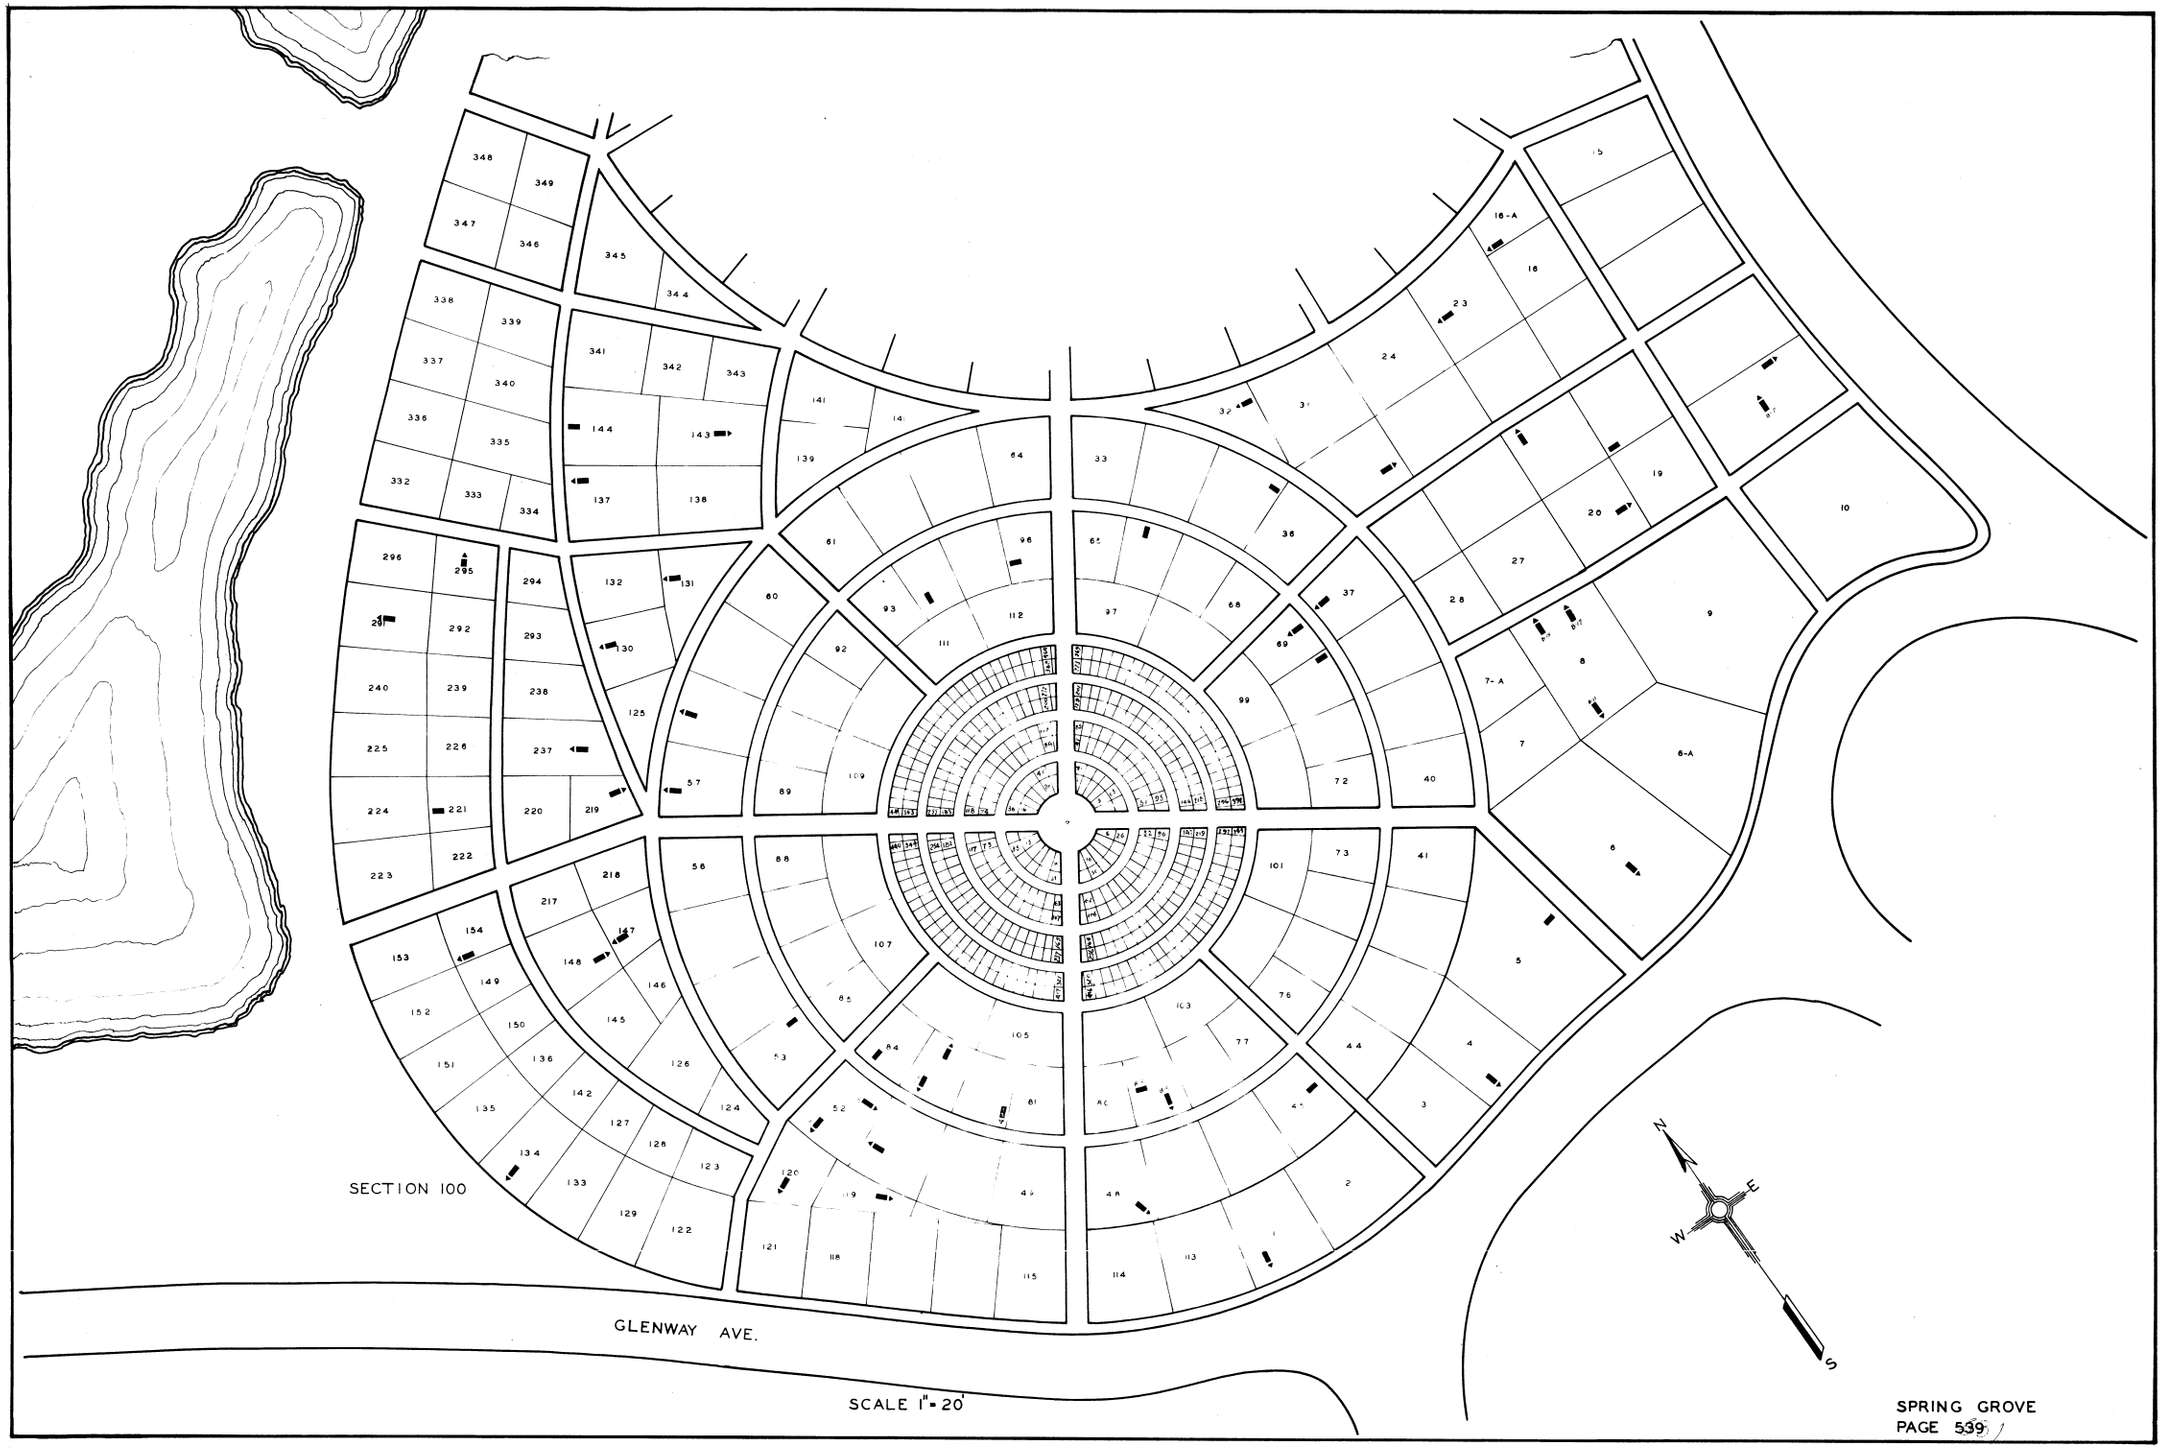

SPRING GROVE
PAGE 539



SCALE 1"=20'

SPRING GROVE
PAGE 5340

LOT	GRAVE	WAR	NAME
175	B-5	(18)	ADAMS WM. H.
	314	(19)	ARCHER WM.
148	B-8	(19)	BARTLETT EDW.
306	B-15	(19)	BAUER GEO.
283	B-7	(19)	BELLINGHAM DANL H.
283	B-15	(31)	BELLINGHAM HARRY D.
51	B-10	(19)	BICE EDW.
170	B-5	(19)	BRADFORD THOM. J.
289	B-1	(19)	BRADY GEO. K.
30	B-5	(19)	BRANNER GOTTLIEB
	84-A	(19)	BRUCE JAS.
37	B-5	(19)	BURCKHARDT PET. J.
	140	(19)	BENDER A. F.
305	B-5	(19)	BRAND JOHN A.
5	B-7	(19)	BRUNNER F.
221	B-2	(19)	BELLVILLE AUG. B.
	264	(19)	CAIN WM. H.
	B-1	(19)	CALDWELL WM. G.
82	B-8	(19)	CAMERRER WM.
261	B-5	(19)	CAREY GEO. W.
290	B-6	(25)	CHAMBERLIN LOU.
21	B-6	(19)	CLARK WM.
	365	(19)	CRANE JOHN C.
	67	(19)	CRAWFORD DAV.
247	B-3	(19)	CLEMONS FRANK C.
8	B-17	(18)	DEWAR ROBT.
8	B-15	(18)	DEWAR THOM. S.
182	B-1	(19)	DUERR CHRISTIAN
16-A	B-2	(19)	EAKLE WM. P.
	50	(19)	EDGAR SAML.
180	B-6	(19)	ELSTURE GEO. W.
32	B-4	(18)	EVANS JOHN G.
188	B-1	(19)	FERGUSON JOHN
188	B-2	(19)	FERGUSON ROBT.
244	B-5	(19)	FINLEY FRED. B.
182	B-10	(19)	FUCHS JAC.
270	B-5	(19)	FOSTER FRANK T.
281	B-6	(25)	GOODWIN JAS. H.
178	B-4	(19)	GLOVER SAML.
167	B-1	(19)	GROSS JOHN C.
96	B-7	(19)	GRIMES JAS. R.
308	B-4	(19)	GUY WM. J.

LOT	GRAVE	WAR	NAME
169	B-4	(19)	HAYNE HENRY F
66	B-7	(19)	HILL WM. T
52	B-13	(19)	HOCK HENRY
	258	(19)	HOPKINS GEO. A.
	172	(19)	HORNING W. LOUGHBY F.
248	B-1	(19)	HUNGLER JOHN
69	B-2	(19)	HUNT JESSE C.
	300	(19)	HAGEN AUG.
	203	(19)	HERRING CONRAD
131	B-2	(19)	HETTESHEIMER WM.
35	B-13	(31)	HORSTMAN OSCAR W.
147	B-2	(33)	HAWKINS WM. R.
	404-A		HEDDEN GEO. C.
11	B-7	(31)	HAWKINS FLOYD L.
	52-A	(19)	JACKSON THOM.
23	B-10	(19)	JEWETT FRANCIS
	355	(19)	JONES ISAAC
	499	(19)	KING JOHN B.
306	B-12	(19)	KLEIN CHAS.
	28	(19)	KLEIN WM.
171	B-4	(19)	KOOPS WARNER
323	B-3	(31)	KREIS STAN A.
286	B-9	(19)	KREUZMANN HENRY
78	B-4	(19)	KROHME JOHN F.
78	B-2	(19)	KROMER WM. C.
260	B-1	(19)	KUMMER PET.
83	B-7	(19)	KLOSTERMEYER CHAS. W.
130	B-3	(19)	KUMMER ANDREW
165	B-11	(25)	KELLNER FRED K. J.
154	B-6	(31)	LAKEMAN W. E.
	285	(19)	LAMB THOM.
	310	(19)	LEMMON ABRAM R.
1	B-2	(19)	LEWIS WM. H.
57	B-3	(19)	LONG ALF.
309	B-5	(19)	LOTZ HENRY
143	B-1	(19)	MANDERS JA.
94	B-2	(19)	MARSHALL A.
	465-A	(19)	McDANIEL JOHN W.
	122	(19)	MITCHELL GEO.
52	B-10	(19)	MC RWOOD JOHN
360	B-1	(31)	McMILLIN FRED'K. N.
324	B-1	(19)	MILLER WM.
6	B-2	(19)	MILLER WM.
	298-A	(19)	NASH WM. D.
254	B-8	(31)	NASHOLD WILFRED C.
	416	(19)	NICHOLAS WM.
206	B-7	(19)	NIEMAN FRED H.
219	B-1	(19)	NOBLE DAVID
177	B-8	(25)	NOLL FRED'K. J.

LOT	GRAVE	WAR	NAME
359	B-12	(19)	OLDRIEVE SYLV. B.
	294-A	(19)	ONG AL O.
83	B-6	(19)	PAULUS JOHN
196	B-10	(19)	PETERSON JAC.
229	B-9	(19)	PIEPHO WM.
54	B-7	(19)	PIERCE JOHN
70	B-6	(19)	PRICE JOHN T.
229	B-8	(19)	PIEPHO CARLO
279	B-1	(19)	RANSOM ED P.
45	B-12	(19)	ROBINSON SAML.
215	B-2	(19)	ROMANOWITZ LUCAS
[illegible]	B-4	(19)	ROSS WM. G.
351	B-8	(19)	REID JAS.
58	B-9	(19)	SCHMIDT PETER
359	B-9	(19)	SHEPARD HERB. L.
	251-A	(19)	SIEBER CARL A.
252	B-1	(19)	SIERING GEO.
244	B-1	(19)	SMITH RUSSELL F.
183	B-2	(19)	SPENCER WM.
16	B-4	(19)	STECKER ALBIN
144	B-6	(19)	STEWART HENRY C.
	17	(19)	SWETFAGE HENRY
84	B-16	(19)	SIMPSON JOS.
119	B-2	(19)	STOUT E. B.
295	B-5	(33)	SCHWARTZ HENRY
302	B-4	(19)	TEACHNOR GREENLEAF N.
66	B-2	(19)	TEALBOYLE HENRY L.
243	B-7	(19)	THEDE WM.
	293	(19)	THOMAS MORRIS
	442	(19)	THROPP EVERETT S.
48	B-3	(19)	TUETING LOU. H.
137	B-3	(19)	TOWNLEY CHAS. E.
237	B-1	(19)	ULERY CHAS. M.

LOT	GRAVE	WAR	NAME
272	B-3	(19)	VAN SCHAACK BENJ.
11	B-4	(31)	WEIL HERB. P.
120	B-3	(19)	WELCH JAS. D.
	132	(19)	WETJOHN GEO. W.
134	B-4	(19)	WILLIAMS JAS. F.
8	B-11	(18)	WILSON JAS.
4	B-3	(19)	WIRTH JAC.
	328	(19)	WOLF JOHN
255	B-1	(19)	WOOD JAS.
307	B-10	(19)	WUNDER GEO.
287	B-1	(19)	WITZENBACHER ANDREW
209	B-11	(31)	ZIMMER GEO. J.

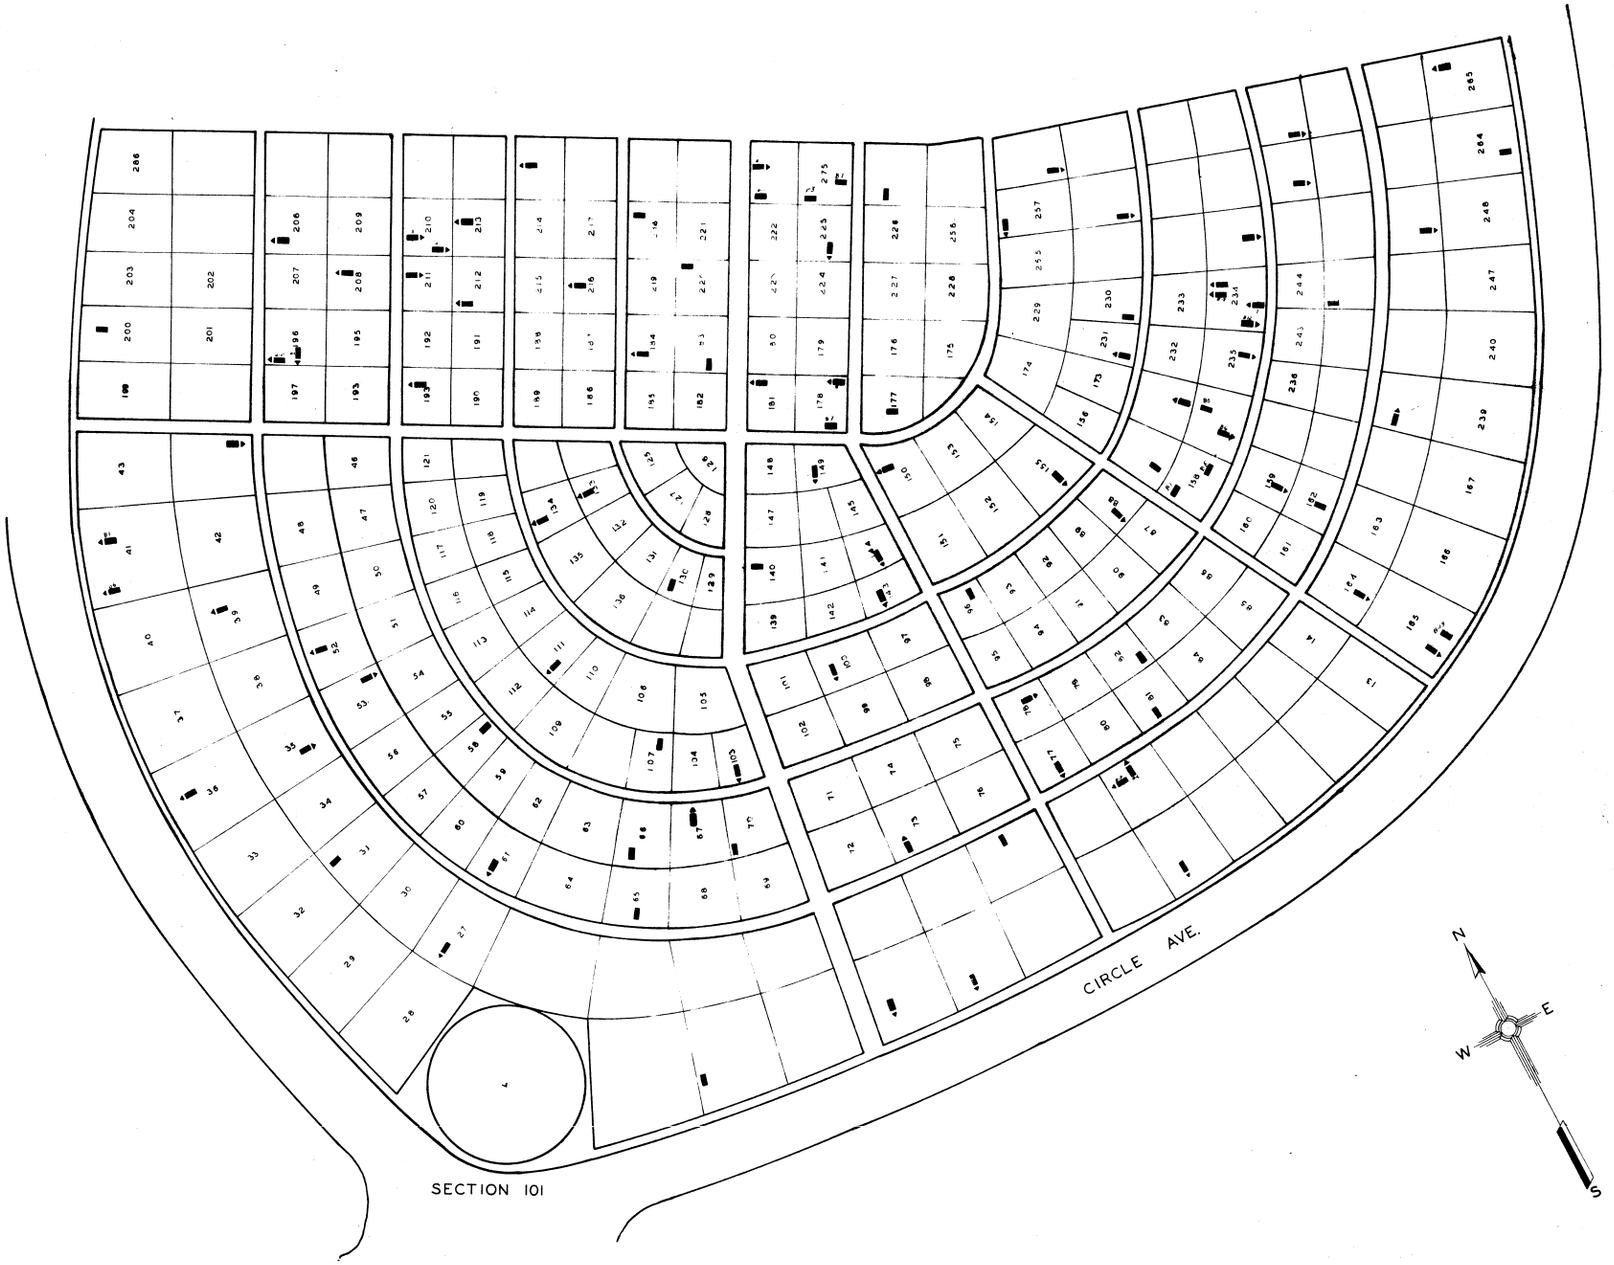

SECTION 101

SCALE 1" = 20'

SPRING GROVE
PAGE 5542

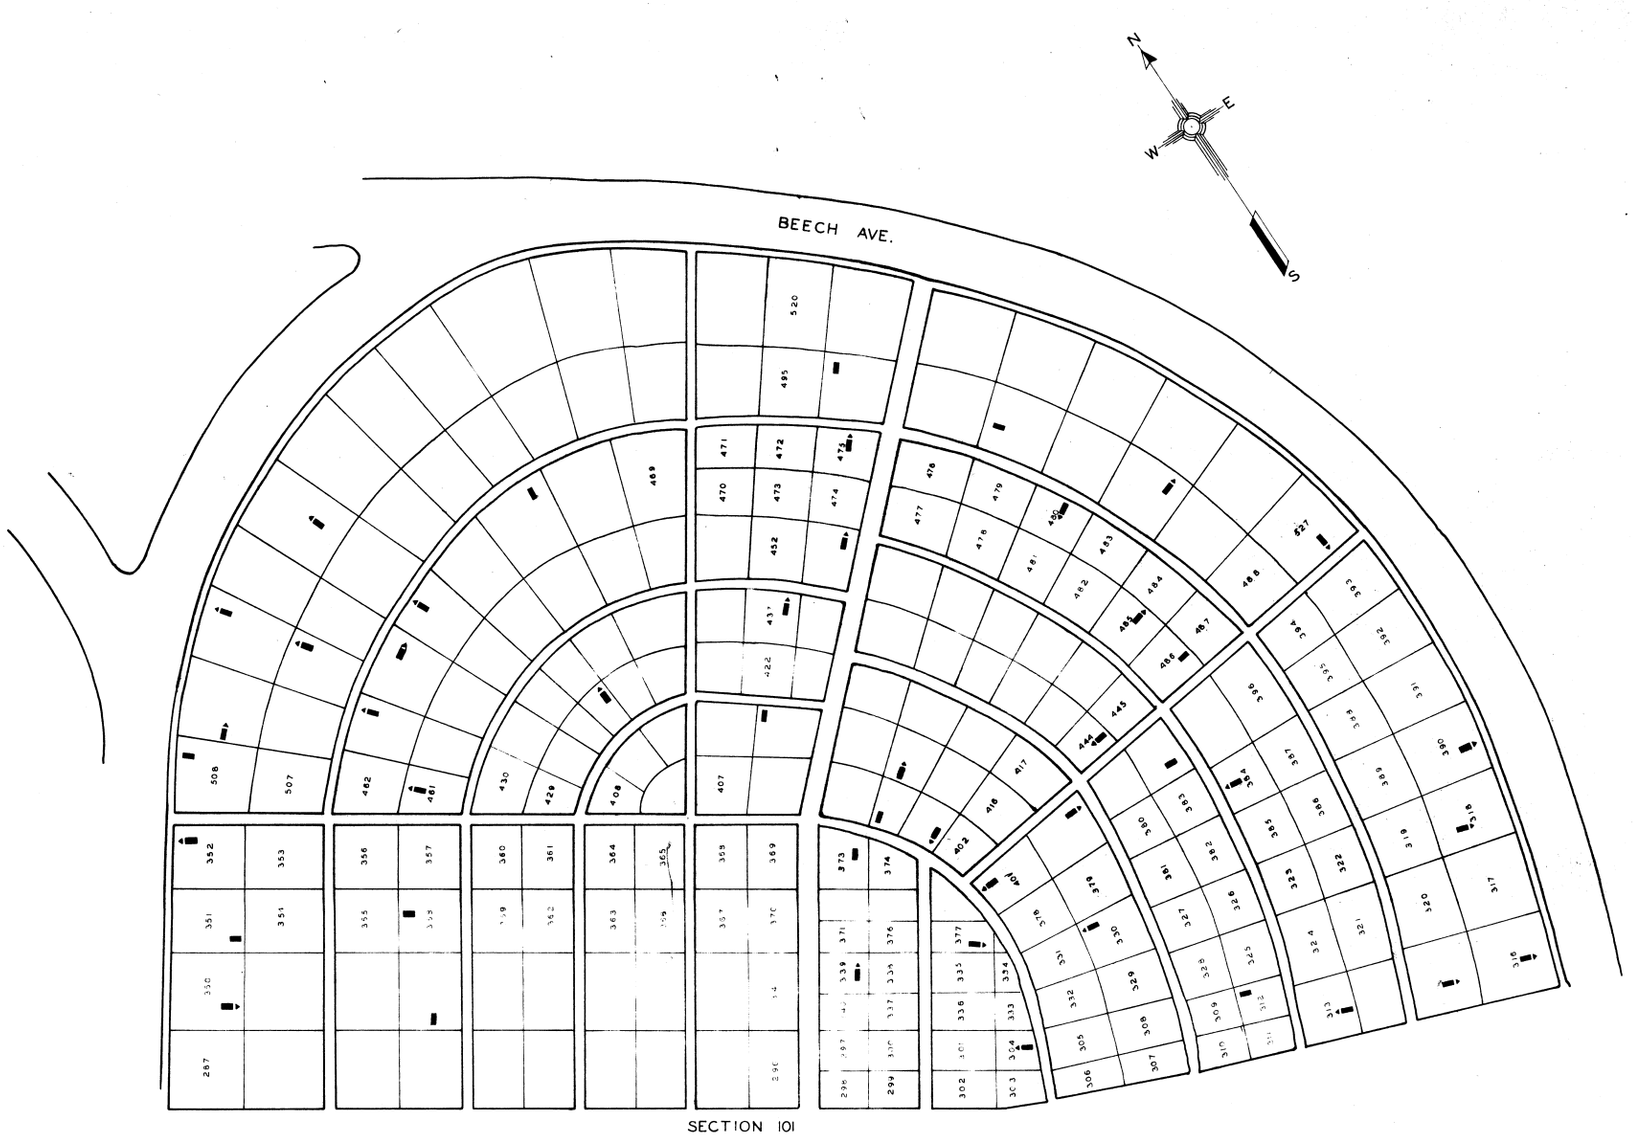

SCALE 1" = 20'

SPRING GROVE
PAGE 543

LOT	GRAVE	WAR	NAME
509	B 3	19	ALT JOHN
390	B 7	19	AHREN CHRISTIAN
352	B 6	19	ARCHIBALD JAS.
206	B 4	19	BASSETT CHAS. F.
39	B 1	19	BATEMAN JAS. W.
178	B 7	25	BAUER CHAS. F
352	B 5	19	BENNINGER CHAS.
426	B. 2	19	BENTZ JOHN
358	B 6	19	BLAIR JOHN M.
73	4	19	BRAMKAMP LEWIS.
350	B 9	31	BURDORF WALTER L.
211	B 1	19	BORCK WM. F.
234		19	CARPENTER LUTHER
61		16	CRAIG ROBT. G.
265	B 4	19	CRAWFORD JOHN M.
58	B 4	19	CAMPBELL ALBT.
67	B 6	19	CRIPPEN ANDREW J.
234	B12	31	DAVIS FRANK T.
41	B 1	19	DAVIS HIRAM W.
66	B 5	19	DIBBLE WM. E.
213	B 1	19	DICK CHRISTIAN
5	B 5	19	DIEMER FREDK. J.
44	B 9	31	DIETZ WALT. A.
155	B11	19	DIRR. EARHARD.
31	B 1	19	ECKERT GEO.
505	BB	19	EVANS JAS.E.
82	B 3	19	FISCHER GEO.
143	B 3	19	FOOTE FRANK
464	B 3	31	FOX GILBT. M.
414	B 2	19	FRANKE ALBT.
249	B 1	19	FRINTZ LEWIS C.
234	B 8	25	FRYBURGER RILEY.
512	B 5	33	GRAY JOS. L.
230	B 1	19	GARNOHR ERNEST
20	B17	19	GASSMAN FRANCIS
398	B 5	19	GEIGER CHAS F
27	B 1	19	GIEBEL HENRY
210	3	19	GLUCHOWSKY JACOB
36	B 1	19	GROSSIUS JOHN
149	B 3	19	HARRIS HENRY
245	B 3	19	HALLER JOHN
316	B 1	19	HARFF FRANCIS
181	B-4	19	HARWOOD JAS.
41	B 6	25	HEDGES ROBT. L.
318	B 3	19	HESS A.J.
235	B 2	19	HIGHT JOHN J.
403	B 6	31	HINES THOS. A.
510	B 3	19	HOWEKOTLE GEO F.
158	B 5	19	HUNTER CHAS.W.
130	B 4	19	HYNDMAN JOHN
52	B 9	19	JOHN HELLMUTH
144	B 2	19	JOHNSON GEO. H.

LOT	GRAVE	WAR	NAME
111	B 5	19	KING WM. H.
404	B 7	19	KOEHLER WM.
276	B 7	19	KOEHLER JOHN J.
492	B 6	19	LEE JAS. M.
212	B 5	19	KANE BART
276	B 1	19	KOLL JOHN
3	B-10	25	KIECHLER CHAS.
9	B 1	19	LEONARD GEO. W.
165	B 1	19	LEONARD LOUIS
400	B 7	19	LINN HARRISON
53	B13	19	LISHAWA CHAS M.
171	B 6	19	LYON HENRY W
157	B 3	19	LYTLE JAS P.
312	B 8	19	MARTIN JOHN B.
70	B 2	19	LEESMAN FREDK W
17	B 10	19	LIEBTAG FERDINAND
465	B- 1	19	MAUS JOS.
218	B 3	19	MARTIN WM H
150	2	19	MASSOTH MELCHIOR
272	B 1	19	MSCOLGIN WM. W
100	B 1	19	METZGER J
220	B 1	19	MILLER JOHN
184	B 2	19	MILNER SIDNEY A
279	B 1	19	MISCHLER LEWIS
65	B 5	19	MONTGOMERY WM. H.
463	B 6	19	MOORE BENJ B
461	B 1	19	MOORE GEO H.
313	B 1	19	MORGAN THOMAS J.
527	B 2	19	MOSSMAN JOHN
140	B 6	19	MUELLER OTTO E.
437	B 2	19	MULLER WM. C.
134	B 1	19	MOESTA HY.
6	B 4	19	MUELLER CHAS. H.
107	B 3	19	NAGEL LOUIS
216	B 12	19	NEALEANS JOHN T.
274	B 8	19	OVEREMD EDW. C.
268	B 2	19	ORMSTON WALT
35	B 4	19	PISTOR CHAS
467	B 1	19	PAPE EDW.W.
339	B 1	19	PATTERSON HENRY H.
145	B 1	19	PERKINS WM. C.
315	B 2	19	PINE WM
234	B 4	19	PORTER HENRY E.
373	B 2	19	RAYMOND JOHN
16	B 13	19	ROBINSON LOUIS C.
227	B 2	19	ROBERTMUSEUS
27	1	19	ROBINSON WM H.
[illegible]	[illegible]	19	ROBINSON WM
2	B 6	19	SCHULZMAN [illegible]
444	B 2	19	SCHULZMAN JOH.
96	B 5	25	SCHMIDT GEO
8	B 6	25	SHINKLE EUGENE M
85	B 4	19	SHOPPE HY
196	B	19	SMITH GEO
466	B 6	19	SHAUDING THOS F
131	B 3	19	STEWART BENJ. M.
401	B 2	19	SEAMAN GEO W
178	B 5	25	SCHMIDT CARL H
153	B 1	19	SCHROEDER JOHN H.
215	B 3	19	SCHAEFER BENJ.
412	B 5	19	SMITH ENOCH
490	B 2	19	SMITH JOS
103	B 7	19	STONE JAS
258	B 5	19	STRUVE HENRY H
304	1	19	STUBERT BARTLETT T.
171	B 5	19	SULLIVAN GEO
225	B 1	19	SULLIVAN HERBT.
508	B 5	19	TAYLOR WM F

LOT	GRAVE	WAR	NAME
18	B 9	19	THOMAS WM.A.
347	B 8	19	THOMPS JOHN P.
475	B 1	19	THOMPSON WM N.
485	B 3	19	TRUSH JACOB
165	B 13	16	TIDBALL CARL W.
96	B 2	31	WAHL CLIFF.
494	B 5	25	WAGNER WM.
162	B 3	19	WELSH PINCKNEY J.
172	5	19	WENDE HERMAN F.
183	B 11	31	WENTWORTH DONALD
377	B 1	19	WALTZ LOUIS
78	B 1	19	WASSENICH EMANUEL
200	B 1	19	WATSON JOHN
384	B 2	19	WILLIAM DAVID
238	B 2	19	WOODRUFF EDW.
59	B 2	19	WOODS REUBEN
261	B 2	19	WRIGHT JAMES C.
351	B 5	31	WHITE JAS. C.
210	1	19	YOCUM JOHN M.
330	B 2	19	YOUNG CHAS. H.
480	4	19	ZIEGENHARDT MARCUS
164	B 1	19	ZINS JACOB
81	B 3	19	SCHNEIDER PETER
257	B 7	19	SNYDER JUL.

LOT	GRAVE	WAR	NAME
25	B- 4	(19)	ARMSTRONG F. W.
94	B- 1	(19)	BIELER GEO.
117	B- 6	(19)	BURDSALL AL.
68	B- 4	(19)	CARR JAMES C.
191	B-10	(19)	CHAPMAN THOMS. J.
171	B- 4	(19)	COCHRAN JOHN A.
119	B- 1	(19)	CROCKER SAMEL. A.
18	B- 1	(19)	DE. BUSHENRY
68	B- 5	(19)	DORE JAMES
34	B- 3	(19)	EDWARDS ABSOLOM
7	B -4	(19)	EGAN JAMS E.
7	B-14	(31)	EGAN JOHN C.
182	B- 9	(19)	FISHER WM. E.
109	B- 4	(19)	FRAZIER JAMES G.
22	B- 4	(19)	GOSHORN AL. T.
36	B- 11	(19)	GRIFFITH JOHN R.
160	B- 1	(19)	HARRIS LEN. A.
4	B- 4	(23)	HASSAUREK FRANK
26	B- 2	(19)	LEWIS CHAS. A.
4	B- 5	(19)	MARKBRIET LEOPOLD
96	B- 3	(19)	MC LEAN EDWIN F.
212	B- 1	(19)	MILLER CHAS. A.
212	B- 8	(19)	MILLER ISAAC J.
38	B- 6	(19)	MILLER JOHN W.
212	B- 4	(19)	MILLER SAML.
213	B- 9	(19)	MILLS EDW. D.
52	B- 4	(19)	MOSER CHAS.
50	B- 4	(19)	MUNSON GEO. R.
110	B- 3	(19)	MURPHY JOHN P.
64	B- 7	(19)	NICHOLSON GEO. B.
63	B -10	(31)	OBERHELMAN GEO. O.
11	B- 5	(19)	PARKER JAMES
58	B- 1	(31)	PREYER AL. P.
78	B- 4	(19)	RADWAY EDW. M.
163	B- 2	(19)	RAMSEY WM. M.
70	CATACOMB A	(19)	ROBBINS SABIN
90	B- 2	(19)	SCHNEIDER CHAS. F.
36	B- 2	(16)	SCOTT GEO. H.
36	B-14	(19)	SCOTT SAMEL.
3	B-10	(19)	SHIPLEY CHAS. J.

LOT	GRAVE	WAR	NAME
147	B- 1	(31)	STEPHENSON EDW. L.
19	B- 9	(19)	THOMAS ANDY E
208	CATACOMB - 8	(19)	THOMAS JOE C.
114	B- 6	(19)	WALKER WM.
155	B- 10	(19)	KENT AL
34	B- 5	(25)	SMITH ROY E.
130	B- 7	(31)	STEVENS CHAS. W



10	B-14	(19)	BAILEY ALF. E.
74	B- 6	(19)	CROSS FELIX G.
181	B- 6	(28)	DANA EDW.
13	B- 5	(19)	GOEBEL CHRISTIAN
186	B- 6	(31)	JENNEY HERBERT R.
157	B- 3	(19)	KERPER GEO. B.
23	B- 3	(19)	MARCEY JAMES W.
81	B- 2	(19)	MORRIS THOS.
77	B- 4	(19)	RICKEL WILHELM
3	B- 2	(19)	SHIPLEY WM.

SCALE 1" = 20'

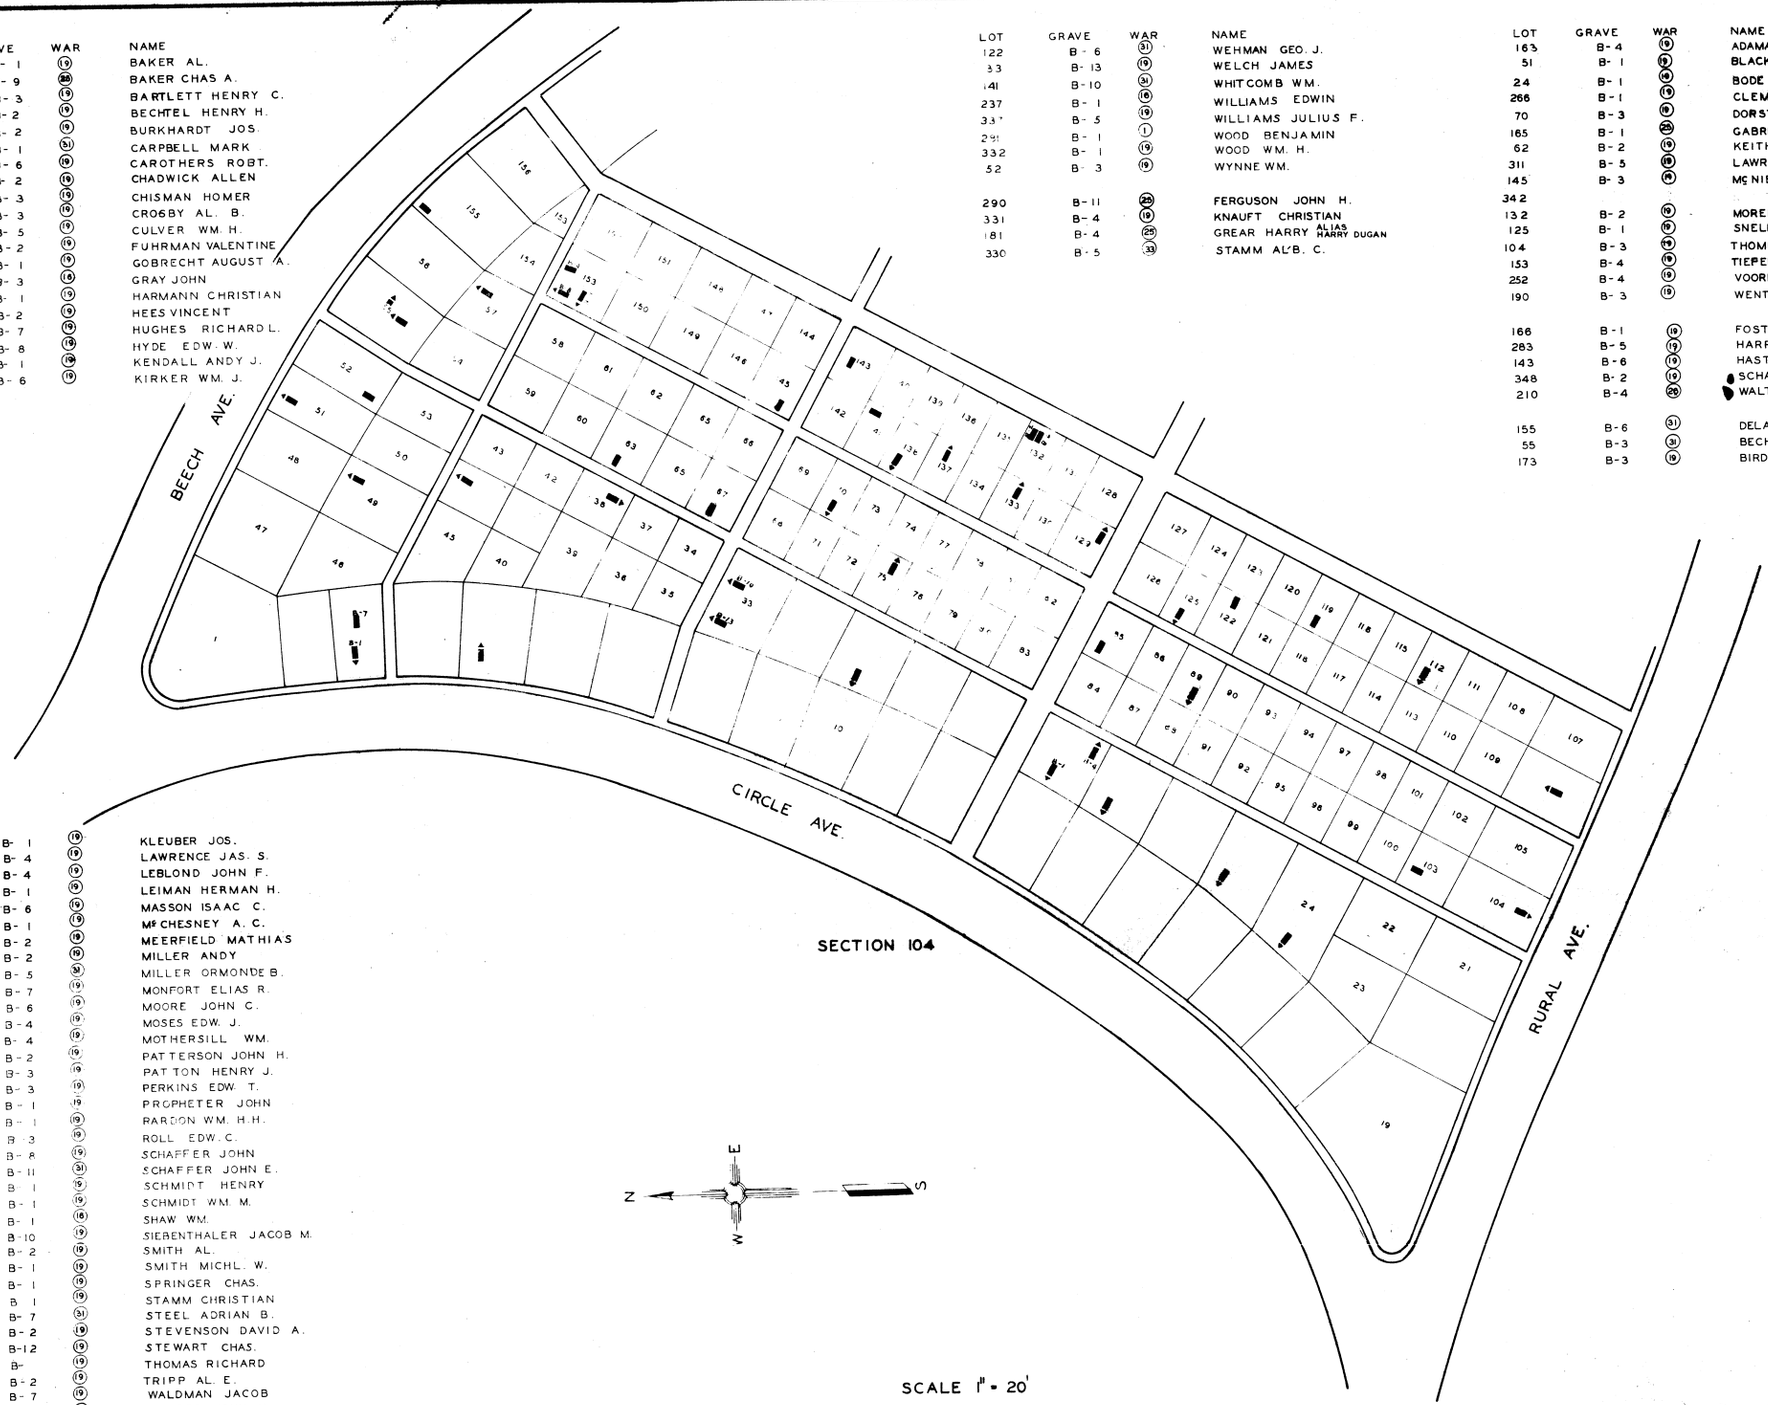

LOT	GRAVE	WAR	NAME
238	B- 1	19	BAKER AL.
238	B- 9	28	BAKER CHAS A.
203	B- 3	19	BARTLETT HENRY C.
55	B- 2	19	BECHTEL HENRY H.
268	B- 2	19	BURKHARDT JOS.
310	B- 1	31	CARPBELL MARK
132	B- 6	19	CAROTHERS ROBT.
133	B- 2	19	CHADWICK ALLEN
164	B- 3	19	CHISMAN HOMER
294	B- 3	19	CROSBY AL. B.
280	B- 5	19	CULVER WM. H.
44	B- 2	19	FUHRMAN VALENTINE
112	B- 1	19	GOBRECHT AUGUST A.
295	B- 3	19	GRAY JOHN
243	B- 1	19	HARMANN CHRISTIAN
31	B- 2	19	HEES VINCENT
290	B- 7	19	HUGHES RICHARD L.
185	B- 8	19	HYDE EDW. W.
210	B- 1	19	KENDALL ANDY J.
38	B- 6	19	KIRKER WM. J.

LOT	GRAVE	WAR	NAME
122	B- 6	31	WEHMAN GEO. J.
33	B- 13	19	WELCH JAMES
141	B-10	31	WHITCOMB WM.
237	B- 1	19	WILLIAMS EDWIN
33?	B- 5	19	WILLIAMS JULIUS F.
291	B- 1	1	WOOD BENJAMIN
332	B- 1	19	WOOD WM. H.
52	B- 3	19	WYNNE WM.
290	B-11	28	FERGUSON JOHN H.
331	B- 4	19	KNAUFT CHRISTIAN
181	B- 4	25	GREAR HARRY ALIAS HARRY DUGAN
330	B- 5	33	STAMM AL'B. C.

LOT	GRAVE	WAR	NAME
163	B- 4	19	ADAMAS JOHN
51	B- 1	19	BLACKBURN HARRY D.
24	B- 1	19	BODE HENRY
266	B- 1	19	CLEMMER NATHAN
70	B- 3	19	DORST ADAM
165	B- 1	25	GABRIEL ARTHUR R.
62	B- 2	19	KEITH ROBT.
311	B- 5	19	LAWRENCE SYLVESTER
145	B- 3	19	MC NIEL JOHN
342			
132	B- 2	19	MOREHEAD SAMUEL
125	B- 1	19	SNELBAKER THOS. E.
104	B- 3	19	THOMPSON GEO.
153	B- 4	19	TIEPENBACH FREDK.
252	B- 4	19	VOORHES GEO.
190	B- 3	19	WENTZEL CHAS. H.
166	B- 1	19	FOSTER ABR'M.
283	B- 5	19	HARPER EDW.
143	B- 6	19	HASTING HENRY
348	B- 2	19	SCHAPPELL WM. H.
210	B- 4	20	WALTER RUDOLPH
155	B- 6	31	DELANEY HUBERT B.
55	B- 3	31	BECHTEL JNO. A.
173	B- 3	19	BIRD CHAS.

341	B- 1	19	KLEUBER JOS.
311	B- 4	19	LAWRENCE JAS. S.
28	B- 4	19	LEBLOND JOHN F.
67	B- 1	19	LEIMAN HERMAN H.
129	B- 6	19	MASSON ISAAC C.
5	B- 1	19	MC CHESNEY A. C.
243	B- 2	19	MEERFIELD MATHIAS
320	B- 2	19	MILLER ANDY
137	B- 5	31	MILLER ORMONDE B.
342	B- 7	19	MONFORT ELIAS R.
25	B- 6	19	MOORE JOHN C.
75	B- 4	19	MOSES EDW. J.
27	B- 4	19	MOTHERSILL WM.
119	B- 2	19	PATTERSON JOHN H.
293	B- 3	19	PATTON HENRY J.
158	B- 3	19	PERKINS EDW. T.
3	B- 1	19	PROPHETER JOHN
28	B- 1	19	RARDON WM. H.H.
163	B- 3	19	ROLL EDW. C.
153	B- 8	19	SCHAFFER JOHN
153	B- 11	31	SCHAFFER JOHN E.
49	B- 1	19	SCHMIDT HENRY
204	B- 1	19	SCHMIDT WM. M.
106	B- 1	19	SHAW WM.
33	B-10	19	SIEBENTHALER JACOB M.
85	B- 2	19	SMITH AL.
301	B- 1	19	SMITH MICHL. W.
261	B- 1	19	SPRINGER CHAS.
330	B 1	19	STAMM CHRISTIAN
89	B- 7	31	STEEL ADRIAN B.
293	B- 2	19	STEVENSON DAVID A.
234	B-12	19	STEWART CHAS.
138	B-	19	THOMAS RICHARD
57	B- 2	19	TRIPP AL. E.
3	B- 7	19	WALDMAN JACOB
210	B- 2	19	WALTER JOHN N.

SCALE 1" = 20'

SPRING GROVE
PAGE 548



SCALE 1" = 20'

SPRING GROVE
PAGE 547

LOT	GRAVE	WAR	NAME
83	B-4	(19)	ALDEN EDWIN
2&5	B-3	(19)	ALEXANDER AMOS
52	B-5	(19)	CARRUTHERS WM. H.
25	B-5	(19)	CLARK KAMPTON O.
62-H	B-2	(19)	CLARK JOHN W.
83	B-1	(19)	FERGUSON JAS.
41	B-7	(19)	FIFIELD WM. H.
63-S	B-2	(19)	FULKERSON CHAS. H.
47	B-14	(19)	HENSHAW WM.
54	B-6	(19)	HESS CHAS.
54	B-10	(19)	HESS LEW. F.
88	B-19	(19)	HOLTHOF AUG.
10	B-3	(19)	JOHNSON GEO. B.
90	B-4	(19)	KNAGI JOHN
60-R	B-1	(19)	LAKE ROSCO W.
58-D	B-2	(19)	LEWIS WM. C.
19	B-10	(19)	MARSH L. A.
88	B-18	(25)	MEINZE FRED.
57	B-2	(19)	NICHOLS GEO. B.
20-D	B-1	(19)	OWENS ROBT.
24	B-14	(19)	RANDOLPH JOHN T.
34	B-1	(21)	REICHERT CARL. C.
59	B-4	(19)	RYAN WM.
7	B-4	(16)	SAMPSON WM. H.
21-C	B-2	(19)	SCHWENINGER HENRY
21-C	B-1	(26)	SCHWENINGER WM. H.
24	B-16	(19)	SHAW WM. H.
63-M	B-1	(19)	WADDELL ROBT. R.
33-B	B-2	(19)	WALDRISS JAS. M.
55	B-8	(19)	WILD JOHN
87	B-6	(19)	YOUNG CHAS.
13	B 7	(19)	HANNA JOHN H.
88	B-9	(19)	MEINZIE H.
20-H	B-1	(31)	SIMCOE JOHN W.
19	B 9	(10)	HASKELL PHINEAS B.
41	B 14	(19)	PUMMILL L. H.
82	B 5	(10)	LININBRINK FRED'K.



SCALE 1" = 20'

SPRING GROVE
PAGE 548



LOT	GRAVE	WAR	NAME
61	B-2	(19)	BRENNER AUGUSTAVE A.
61	B-7	(19)	BRENNER WM.
18	B-6	(19)	DUDLEY ADOLPHUS S.
67	B-1	(19)	GILLETT CHAS. A.
13	B-3	(19)	GRAF LEONARD
66	B-3	(19)	GRIFFITH DAVID
10	B-4	(19)	HESSE WM.
18	B-5	(19)	MANSFIELD CHAS. D.
18	B-3	(19)	MANSFIELD EDW. J.
15	B-9	(19)	MILLIGAN JOHN W.
83	B-6	(25)	PFEIFFER THOMAS H.
69	B-7	(19)	SCHNEIDER GEO. A
15	B-1	(19)	SCHWAR JUSTUS
64	B-2	(19)	SHIELOS GEO. W.
69	B-5	(19)	LUEBBERT HERMAN C. W.

SPRING GROVE
PAGE ~~549~~

SECTION - 108

LOT	GRAVE	WAR	NAME
11	B-3	(19)	JOHNS GEO. W.

SECTION-109

LOT	GRAVE	WAR	NAME
9	15	(19)	McKIM CHAS.

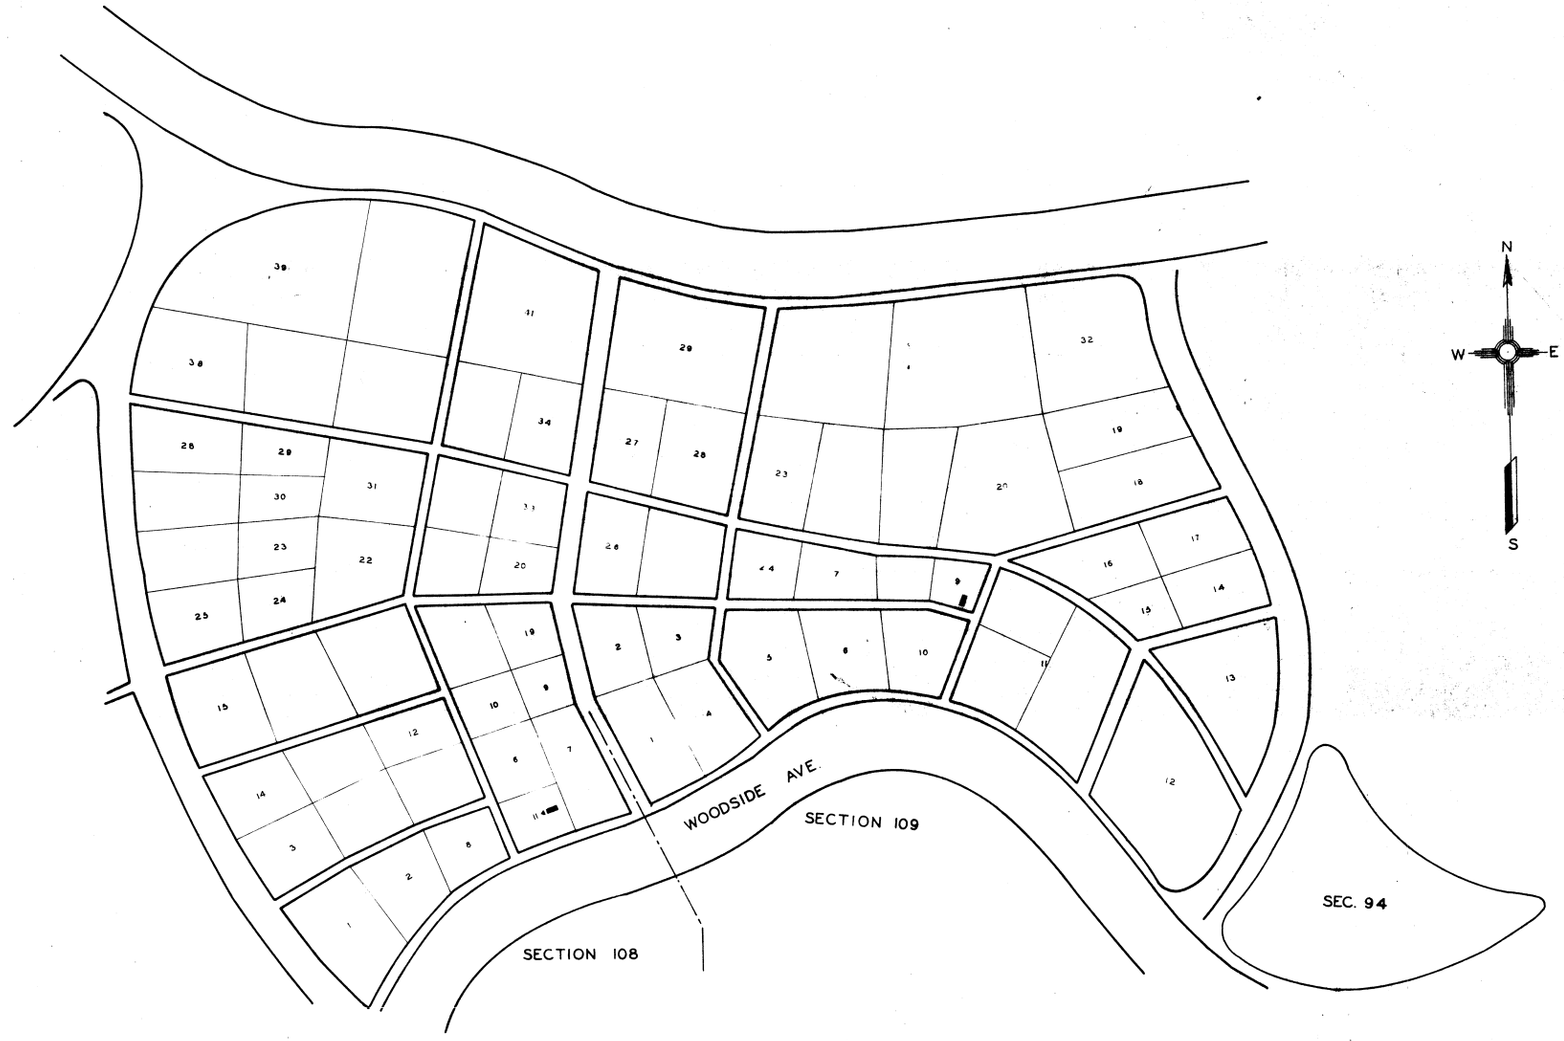

SCALE 1"=20'



LOT	GRAVE	WAR	NAME
227	B-6	19	AICHLES WM. F.
236	B-3	19	ARCHER WM.
424	B-6	19	BASTIAN FREDR. H.
384	B-4	19	BEALL EDW. J.
8	B-3	19	BELTZ CHAS. S.
48	B-3	19	BORN PHIL.
284	B-5	21	BROCKMEYER FRED.
431	B-2	19	BROWN ISAAC F.
390	B-3	19	BROWN JOHN H.
33	B-3	19	BULLOCK JAS. K.
237	B-4	19	CALLAHAN JOHN E.
23	B-9	19	CAREY MILT. T.
169	B-2	19	COLE THOM. J.
382	B-2	19	COX GEO. G.
305	B-3	19	CRAWFORD GEO. S.
203	B-13	19	DAVIS ART.
419	B-2	19	DAVIS WM. C.
290	B-6	19	DILG HENRY
331	B-5	19	DOWDELL JOHN R.
152	B-1	19	EDWARDS JOHN A.
358	B-2	19	EHRMANN FRANK H.
5	B-4	19	FLY GEO. A.
238	B-3	19	ESTEP WM. H.
127	B-3	19	FINN EDM.
295	B-6	19	FLOYD GEO. B.
408	B-8	19	FULTON ROBT. S.
44	B-3	19	GADDIS MAX. P.
232	B-3	19	GEISENHOFER JUL.
393	B-2	19	GRAVES HIRAM. S.
161	B-7	19	GSCHWIND LOU
447	B-3	19	HANNAH THOM. C.
46	B-5	19	HARTWELL GEO. W.
146	B-8	19	HILL JAC.
150	B-8	19	HOLMES F. C.
156	B-2	19	HOENDORF LOUIS
330	B-5	19	IRVING JOHN M.
326	B-6	19	IRVING WASH.
72	B-1	19	JENKINS WM. H.
239	B-3	19	JONES JASPER N.
239	B-1	19	JONES WM. B.
165	B-4	19	KENTNER CHRISTIAN
210	B-3	19	KIRMAN ED. B.
266	B-2	19	KNEPPER J.
465	B-4	19	KRAHER PHIL.
244	B-6	19	LAPP ABE.
448	B-10	19	LEWIS JOHN J.
448	B-7	19	LEWIS THOM. A.
50	B-11	19	LOOKER THOS H.
255	B-9	19	LUCAS WM.
273	B-6	19	LUKENS THOM.
130	B-3	19	McDONALD DAN.
376	B-8	21	McKINLEY STAN.
400	B-1	19	MEINHARDT ERNST.
400	B-4	19	MEINHARDT RICH.
179	B-1	19	MESSER WM.
179	B-5	19	MEYERS H. C.
179	B-7	20	MEYERS HENRY
429	B-10	19	MILLER EDW. D

LOT	GRAVE	WAR	NAME
453	B-5	19	MILLER HARVEY A.
228	B-3	19	MITCHELL GEO
441	B-9	19	MOORE AUG. W.
388	B-3	19	MOORE DAN W.
454	B-9	19	MOORE THOM W.
92	B-2	19	MOREHEAD JAS. E
201	B-9	19	MORRISON J. S
193	B-5	19	MUELLER CHAS. S.
19	B-16	19	MULLENS JAS.
19	B-10	19	MULLENS JONATHAN
319	B-6	19	NAYLOR JOHN M.
442	B-8	21	POPP CHAS. F.
391	B-3	19	REED EDWN O. G.
460	B-3	19	ROBERTS NIC.
351	B-6	19	ROBINSON ISAAC B.

LOT	GRAVE	WAR	NAME
190	B-3	19	ROSS ROBT. J.
81	B-10	19	ROTH JOHN
315	B-7	19	ROWE GEO.
404	B-9	19	SANBORN GEO. W.
84	B-1	1	SEDAM C. R.
40	B-4	19	SHANNON EDW. P.
439	B-5	19	SHEARER JOHN L.
330	B-2	19	SHROYER EDW. L.
196	B-5	19	SIGMUND TONY.
296	B-1	19	SMITH WM.
5	B-13	20	STANBERY STANFORD B.
10	B-11	21	STEWART MORGAN L.
173	B-5	19	STRUBE WM. F.
178	B-3	19	STRUBE C. C.
254	B-4	19	TAFEL GUSTAN
268	B-4	19	TYLER RUB.
43	B-4	19	URNER EDW. C.

LOT	GRAVE	WAR	NAME
353	B-2	19	VAN DYKE HENRY N.
129	B-8	19	WAGNER FRED.
363	B-7	19	WALTERS M. L. F.
275	B-3	19	WATSON JOS.
230	B-3	19	WARREN LEANDER
279	B-6	19	WEAVER JOHN.
306	B-10	19	WEBER CHAS.
463	B-1	19	WESTENDORF JOS.
11	B-5	19	WHITE ANDW. J.
441	B-10	19	WHITSON C. S.
184	B-1	19	WORST AUG.
184	B-6	20	WORST OLIVER
346	B-9	19	YINGLING JOHN

LOT	GRAVE	WAR	NAME
74	B-3	19	ADAM WENZEL
97	B-14	19	APPENFELDER WM. F.
248	B-8	20	BAUER LEO'N.
242	B-10	19	BOUTET EDW.
80	B-11	19	CRAWFORD GEO.
303	B-3	19	CROSS CHAS.
445	B-6	19	GEBHARDT JOHN N.
352	B-10	19	HAMILTON JOHN B.
309	B-6	19	HESS AUG. C.
21	MEM'O.	19	KAUTZ JAC.
5	B-14	19	LITTON JERRY
340	B-6	19	MAEGLY JAC.
101	B-5	19	NICHOLS L. P.

LOT	GRAVE	WAR	NAME
419	B-3	20	DAVIS CHAS. B.
294	B-2	19	RICKER WM. W.
153	B-7	19	RUSK JAS. B.
174	B-1	19	SAAL GERHARD
438	B-2	19	SCHUMACHER ADAM
129	B-3	20	WAGNER ELM. E
5	B-10	19	WALLACE JARED
293	B-4	19	WORMS ISADORE
280	B-7	19	YOST HENRY
403	B-13	19	YOST JAS.
133	B-2	33	FORMAN WILLIS D.
123	B-4	19	ABEL JOHN
79	B-8	21	HUNTER WM. N.
327	B-2	19	LOWES C. E.
122	B-11	19	SERENA JAC.
456	B-3	19	SMITH OLIVER H.
14	B-9	19	SQUIER JNO. M.
182	B-3	19	WILLIAMS GEO. T.
405	B-9	31	POTTEBAUM OMAR H.
177	B-4	31	MANSON DAVID C.

SPRING GROVE



SECTION 110

SCALE 1" = 20'

SPRING GROVE

LOT	GRAVE	WAR	NAME
164	B- 6	(19)	ADAMS HENRY
157	B- 11	(31)	ANDERSON DOUGLAS M.
163	B- 3	(19)	BARRY WM. H.
68	B- 4	(25)	BECKER AL. J.
83	B- 3	(19)	BERRY JAMES H.
94	B - 1	(18)	BOSS GEO. A.
25	B- 7	(19)	BOOTH EDWIN
179	B- 3	(19)	BRENNER FREDK.
161	B- 10	(19)	BROWN FRANK
178	B- 3	(19)	CHILD CHAS. B.
157	B- 5	(19)	DOUGLASS ROBT. N.
202	B- 4	(31)	FINN ROBT. M.
132	B- 5	(19)	FLEMMING ROBT. H.
25	B- 5	(19)	FOLEY WM.
59	B -10	(19)	GABRIEL MICHAEL
175	B- 3	(19)	GALLIGHER THOMAS
62	B 10	(31)	ATTENHORN ROY C.
143	B- 4	(19)	HENRY GEO. C.
48	B 1	(19)	KIEPE AUGUSTUS
5	B- 2	(31)	HILL DONALD Y.
87	B- 2	(19)	KILPATRICK ROBT. L.
15	B- 4	(31)	CROGER BERNARD H.
150	B - 2	(19)	LYONS JACOB W.
25	B - 2	(19)	MADDOCKS JOHN B.
90	B- 1	(19)	BAYER NICHOLAUS
186	B- 2	(19)	EICHHORN GEO.

LOT	GRAVE	WAR	NAME
26	B- 5	(19)	FEIN GEO. H.
74	B- 4	(19)	FINSTEWALD HENRY
73	B- 4	(19)	GESSERT HENRY
27	B- 3	(19)	HECK ADAM
46	B- 1	(19)	JONES AMBROSE E
98	B- 4	(19)	KELLY AMOS
86	B- 2	(19)	POWELL JOHN D
62	B - 3	(19)	PRINZ VALENTINE
64	B - 2	(19)	SQUIRE ALF.

LOT	GRAVE	WAR	NAME
114	B- 6	(19)	SMITH ROBT. M.
57	B- 1	(19)	STRAUB JOHN
45	B- 3	(19)	WALKER J. C.
66	B- 1	(19)	WALTZ GEO.

LOT	GRAVE	WAR	NAME
25	B- 1	(19)	MAYHOOD JAMES
25	B-4	(19)	HUNTLEY HIRAM H.
156	B- 6	(19)	KING HENRY L.
54	B- 3	(19)	MIGHIE JAMES C.
22	B- 1	(19)	MOHLENHOFF FREDK.
85	B-2	(19)	MULLIN JAMES. H.

NORTHEASTERN AVE.

ALPINE AVE.

OAK AVE.

SECTION 89

ACACIA AVE

BEECH AVE.

SECTION 111

N E S W

SCALE 1"= 20'

197	B-4	(19)	PETERS ORIN E.
176	B- 2	(19)	REES HICHARD
35	B- 6	(19)	REITZEL CHAS
155	B -2	(19)	RENNER FREDK
127	B- 6	(19)	ROGER LEANDER E.
100	B-10	(19)	RUEHREIN WM.
14	B- 8	(19)	SANDER ADOLPH
14	B- 2	(19)	SANDERS HERMAN
161	B -11	(19)	SCHATZMANN PETER
59	B- 6	(19)	SCHWARTZ JACOB
176	B- 6	(19)	SMETHURST LLOYD
100	B- 7	(19)	STEGNER PHIL.
37	B- 2	(19)	WALLACE JAMES
25	B- 6	(19)	WARE WM. W.
184	B- 2	(19)	WILLIAMSON AL. M.
176	B -5	(19)	WILLIAM THOM L.
174	B-4	(19)	WRIGHT PERRY N.
119	B-2	(19)	EATON FRANCIS L.
148	B-4	(33)	RYAN WM. J.

SPRING GROVE

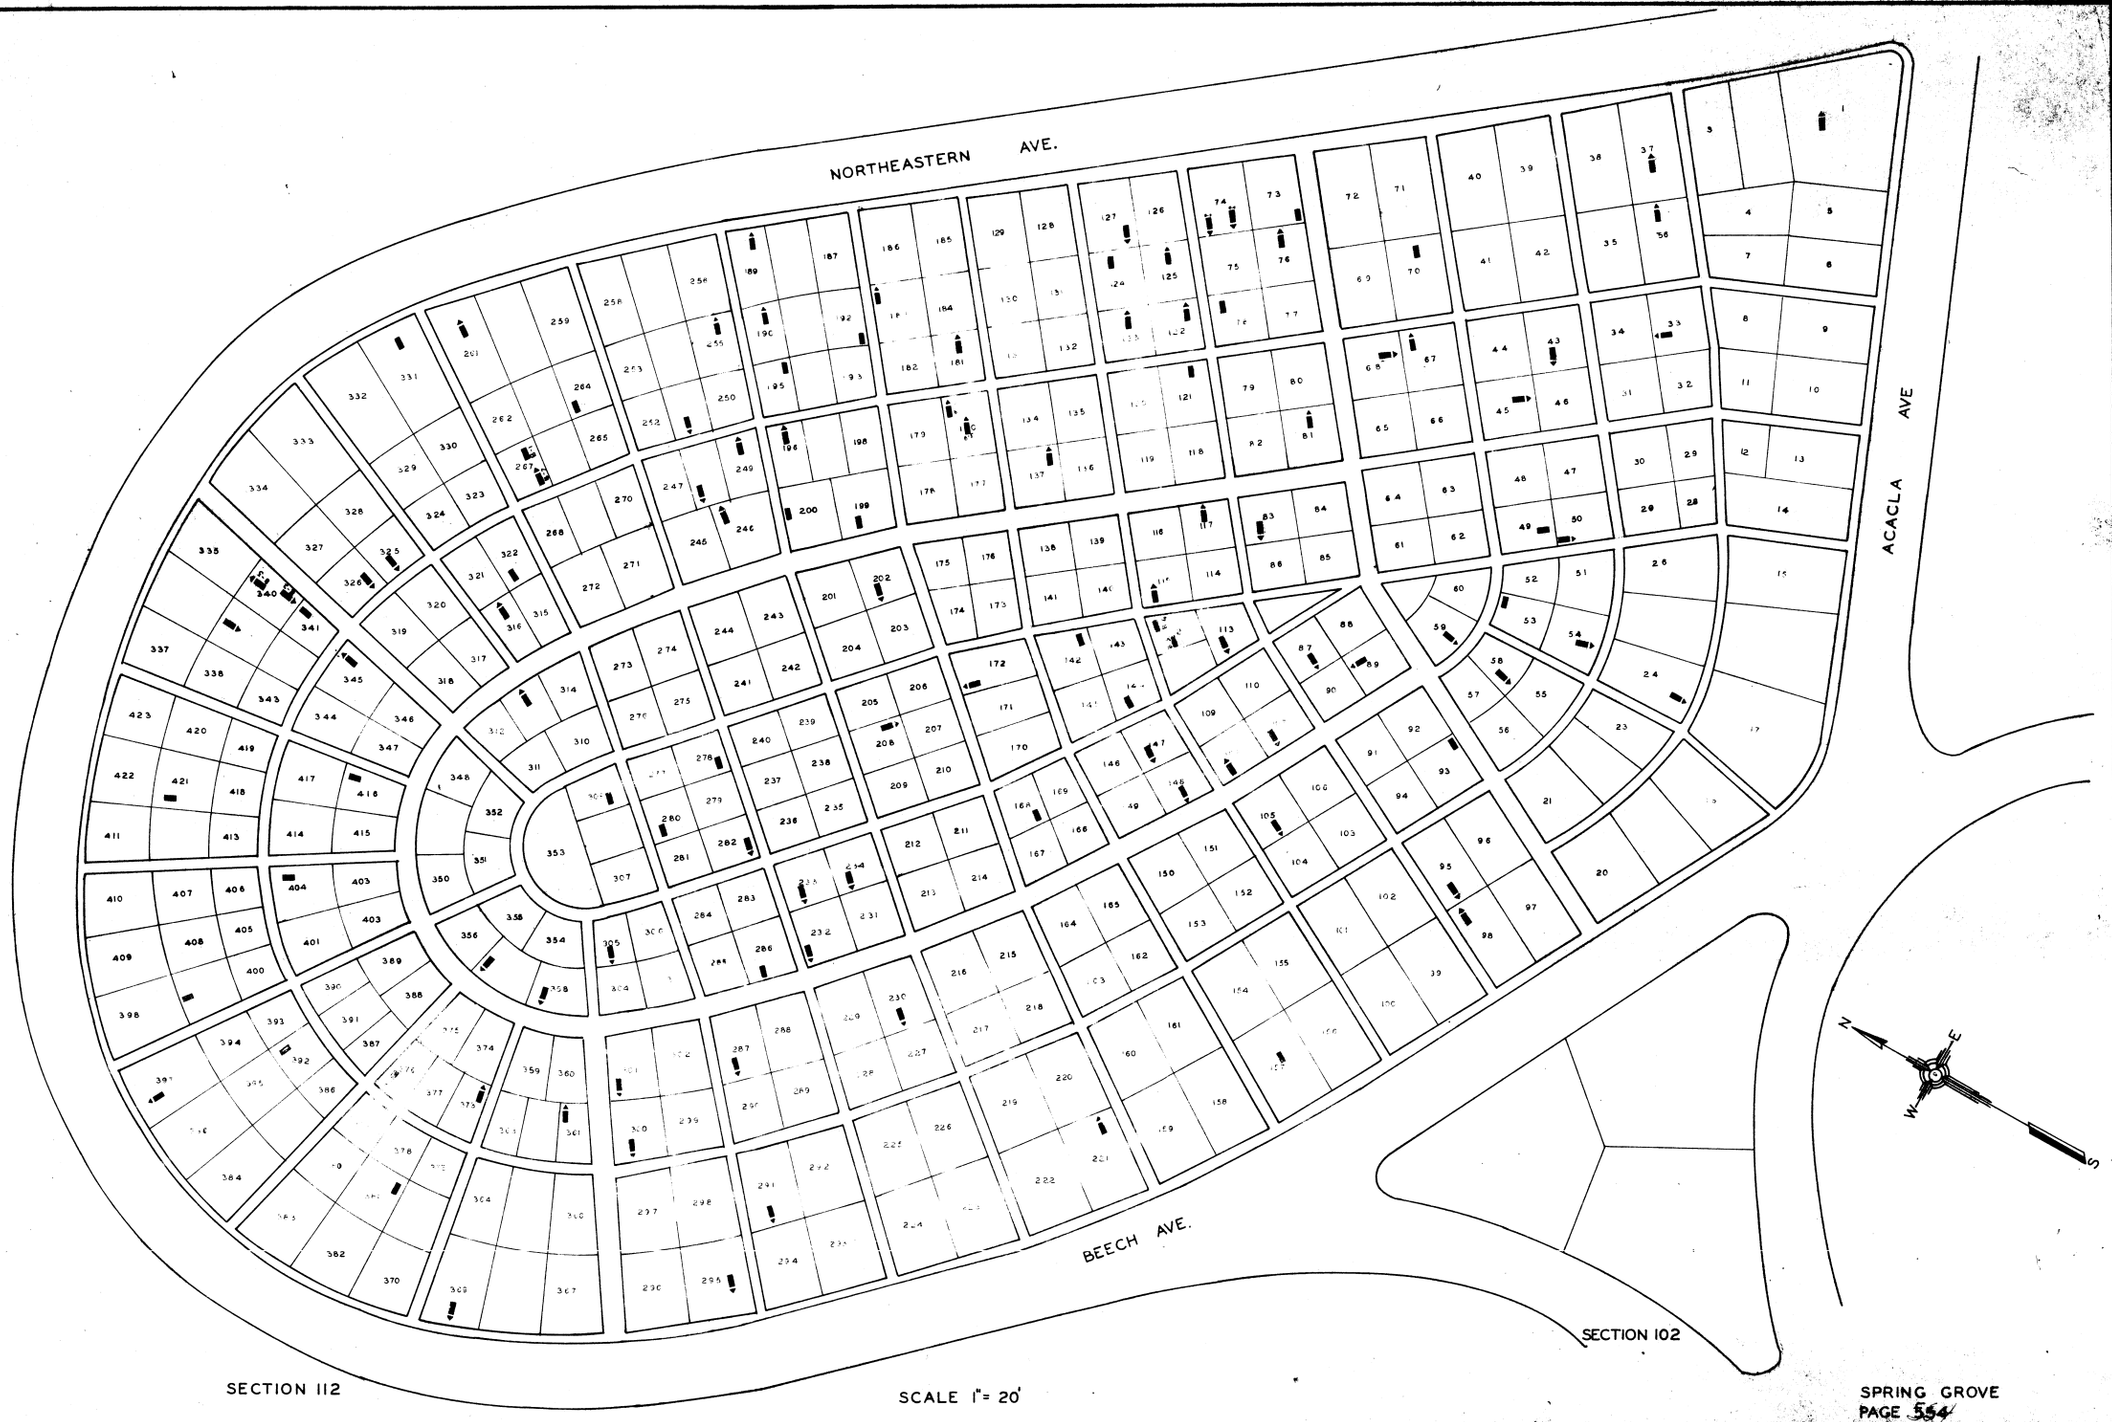

SPRING GROVE
PAGE 554

LOT	GRAVE	WAR	NAME
112	B- 3	19	ALCORN WM. H.
54	B- 1	19	ANDERSON GEO. D.
300	B- 2	19	ARENS CHAS.
389	B- 2	19	AYERS STEPH. C.
340	B- 2	19	BAIRD JEROME E.
249	B- 1	19	BARR GEO. W.
1	B- 4	31	BARTON CLARENCE E.
230	B- 3	19	BARTON JOHN H.
381	B- 5	31	BLACK JOHN
70	B- 1	19	BRAAM MATHEW
37	B- 5	19	BUTLER GEO.
59	B 4	9	BRYAN WASHINGTON
399	B- 1	19	BEYRIESS
340	B- 3	19	CARPENTER LAWRENCE C.
95	B- 4	18	CARROLL RICHARD
112	B- 4	19	CHATTEN DAVID A.
83	B- 2	19	COLLINS HENRY B.
416	B- 4	19	CRIPPEN FRANK A.
301	B- 6	19	CUSHARD FRANCIS H.
121	B- 2	9	CLARK GEO.
208	B- 7	19	DISERENS L.
278	B- 5	19	DRAKE C. W.
24	B- 1	19	DAVIS WM.
195	B- 1	19	DELANATER ISAAC
50	B- 2	38	DETZEL GEO. M.
33	B- 2	19	DUNLAP JAMES W.
78	B- 3	19	EICHELBERGER PETER
313	B- 5	19	EMIGHOLZ FRED.
107	B- 3	19	FAILOR GEO. N.
392	B- 3	19	FORBES DENNIS J.
233	B- 8	19	FOX ANDY. P.
124	B- 2	19	FREY GEO.
67	B- 4	19	FINK HENRY
255	B- 3	19	FLEMMING JAMES
190	B- 3	36	HAMILTON WM. W.

LOT	GRAVE	WAR	NAME
58	B- 1	19	GEORGI ROBT.
37	B- 1	19	GIBSON JOHN
232	B- 5	31	HEINS FRANK W.
286	B- 2	19	HIGHLANDS JOHN S.
117	B- 2	19	HOFFMAN JOS. H.
192	B- 3	19	HORST HERMAN
361	B- 4	31	INGRAM JONAH V.
76	B- 1	19	JOHNSON JOHN E.
280	B- 4	19	KLEIN PHIL.
339	B- 3	19	KNOX SAM L.
267	B- 1	19	KOSTERMAN FREDR.
267	B-	19	KUSTERMAN FREDR.
189	B- 2	19	KENNEDY JOHN J.
180	B- 8	31	KILLOUGH OWEN
81	B- 1	19	LANDMEIER WM.
157	B- 4	19	LAUTENSCHLAGER JOHN
53	B- 1	19	MARSHALL GEO. B.
325	B- 4	25	MARSH CHAS. H.
309	B- 2	19	MAYER ANTON
43	B- 11	25	MEINHARDT FRANK R.
331	B- 6	31	MILLER GEO.
357	B- 2	19	MONROE WM. M.
261	B- 1	19	MOORE JOHN M.
316	B- 1	19	MOORE JAMES
264	B- 1	19	MORRIS AUGUSTUS
295	B- 3	31	MORRELL LESLIE P.
180	B- 5	19	MARPE HENRY
396	B- 3	19	MEIER HENRY
68	B- 3	19	NICKLES SAML
345	B- 2	19	NOURS C. F.
147	B- 1	19	OCHSNER EDW.
125	B- 3	19	OHMAN WM.
87	B- 1	19	OONK J. G.
251	B- 4	19	ORDELMANDT WM.
148	B- 1	19	ORTH REINHARDT
98	B- 2	9	PIERCE JOHN W.
45	B- 5	19	PRESTON DAVID
183	B- 1	9	QUINN PETER
108	B- 1	19	RUDOLPH J. S.
89	B- 9	19	RICHARDS WM. A.
291	B- 3	16	RUND FRED.

LOT	GRAVE	WAR	NAME
326	B- ASHES-UNDER MONUMENT	19	SCHMIDT CARL L.
181	B-	19	SCHMIDT FREDR.
122	B- 4	19	SCHOENBERGER JOS
196	B- 7	19	SCHROEDER CHAS
322	B- 5	19	SCHUMACHER HENRY
246	B- 9	31	SENET FRED
258	B- 2	19	SHANNON CHAS L.
404	B- 7	19	SHAW WM. R.
287	B- 2	19	SHERIDEN JOHN W.
282	B- 6	19	SMITH PETER
132	B- 2	19	SMITH WM. O.
202	B- 5	19	STEINER GEO. W.
144	B- 4	19	STEWART ROBT.
376	B- 1	19	STORY JAMES S.
373	B- 4	19	STRIFE GEO. W.
36	B- 2	9	SABIN WM.
200	B- 2	19	STRETCHER HOWARD
168	B- 3	25	STASSEN JAC.
340	B- 1	19	TAYLOR GEO. K.
199	B- 2	19	TAYLOR JOHN T.
127	B- 3	16	TAYLOR WM.
113	B- 2	19	THOMPSON JOHN H.
105	B- 5	18	TYRRELL EDW. J.
172	B- 4	19	UTTER GEO. L.
93	B- 2	19	VATTER HENRY
421	B- 4	37	VORDENBERG WM. E.
305	B- 3	19	VOIGHT HENRY C.
115	B- 4	19	WALLACE ROBT.
142	B- 1	19	WEBER JOHN C.
248	B- 4	19	WEICHRICH PHIL.
234	B- 3	19	WIEDERECHT JOHN
231	B- 7	31	WOOD CHESTER W.
73	B-	29	WRIGHT WALTER C.
74	B- 4	9	YOUNG WM.
74	B- 3	33	YOUNG WM.
49	B- 2	9	ZULEGER JOS.

LOT	GRAVE	NAME


SEC. 63
PART OF SEC. 113
N
W
E
S

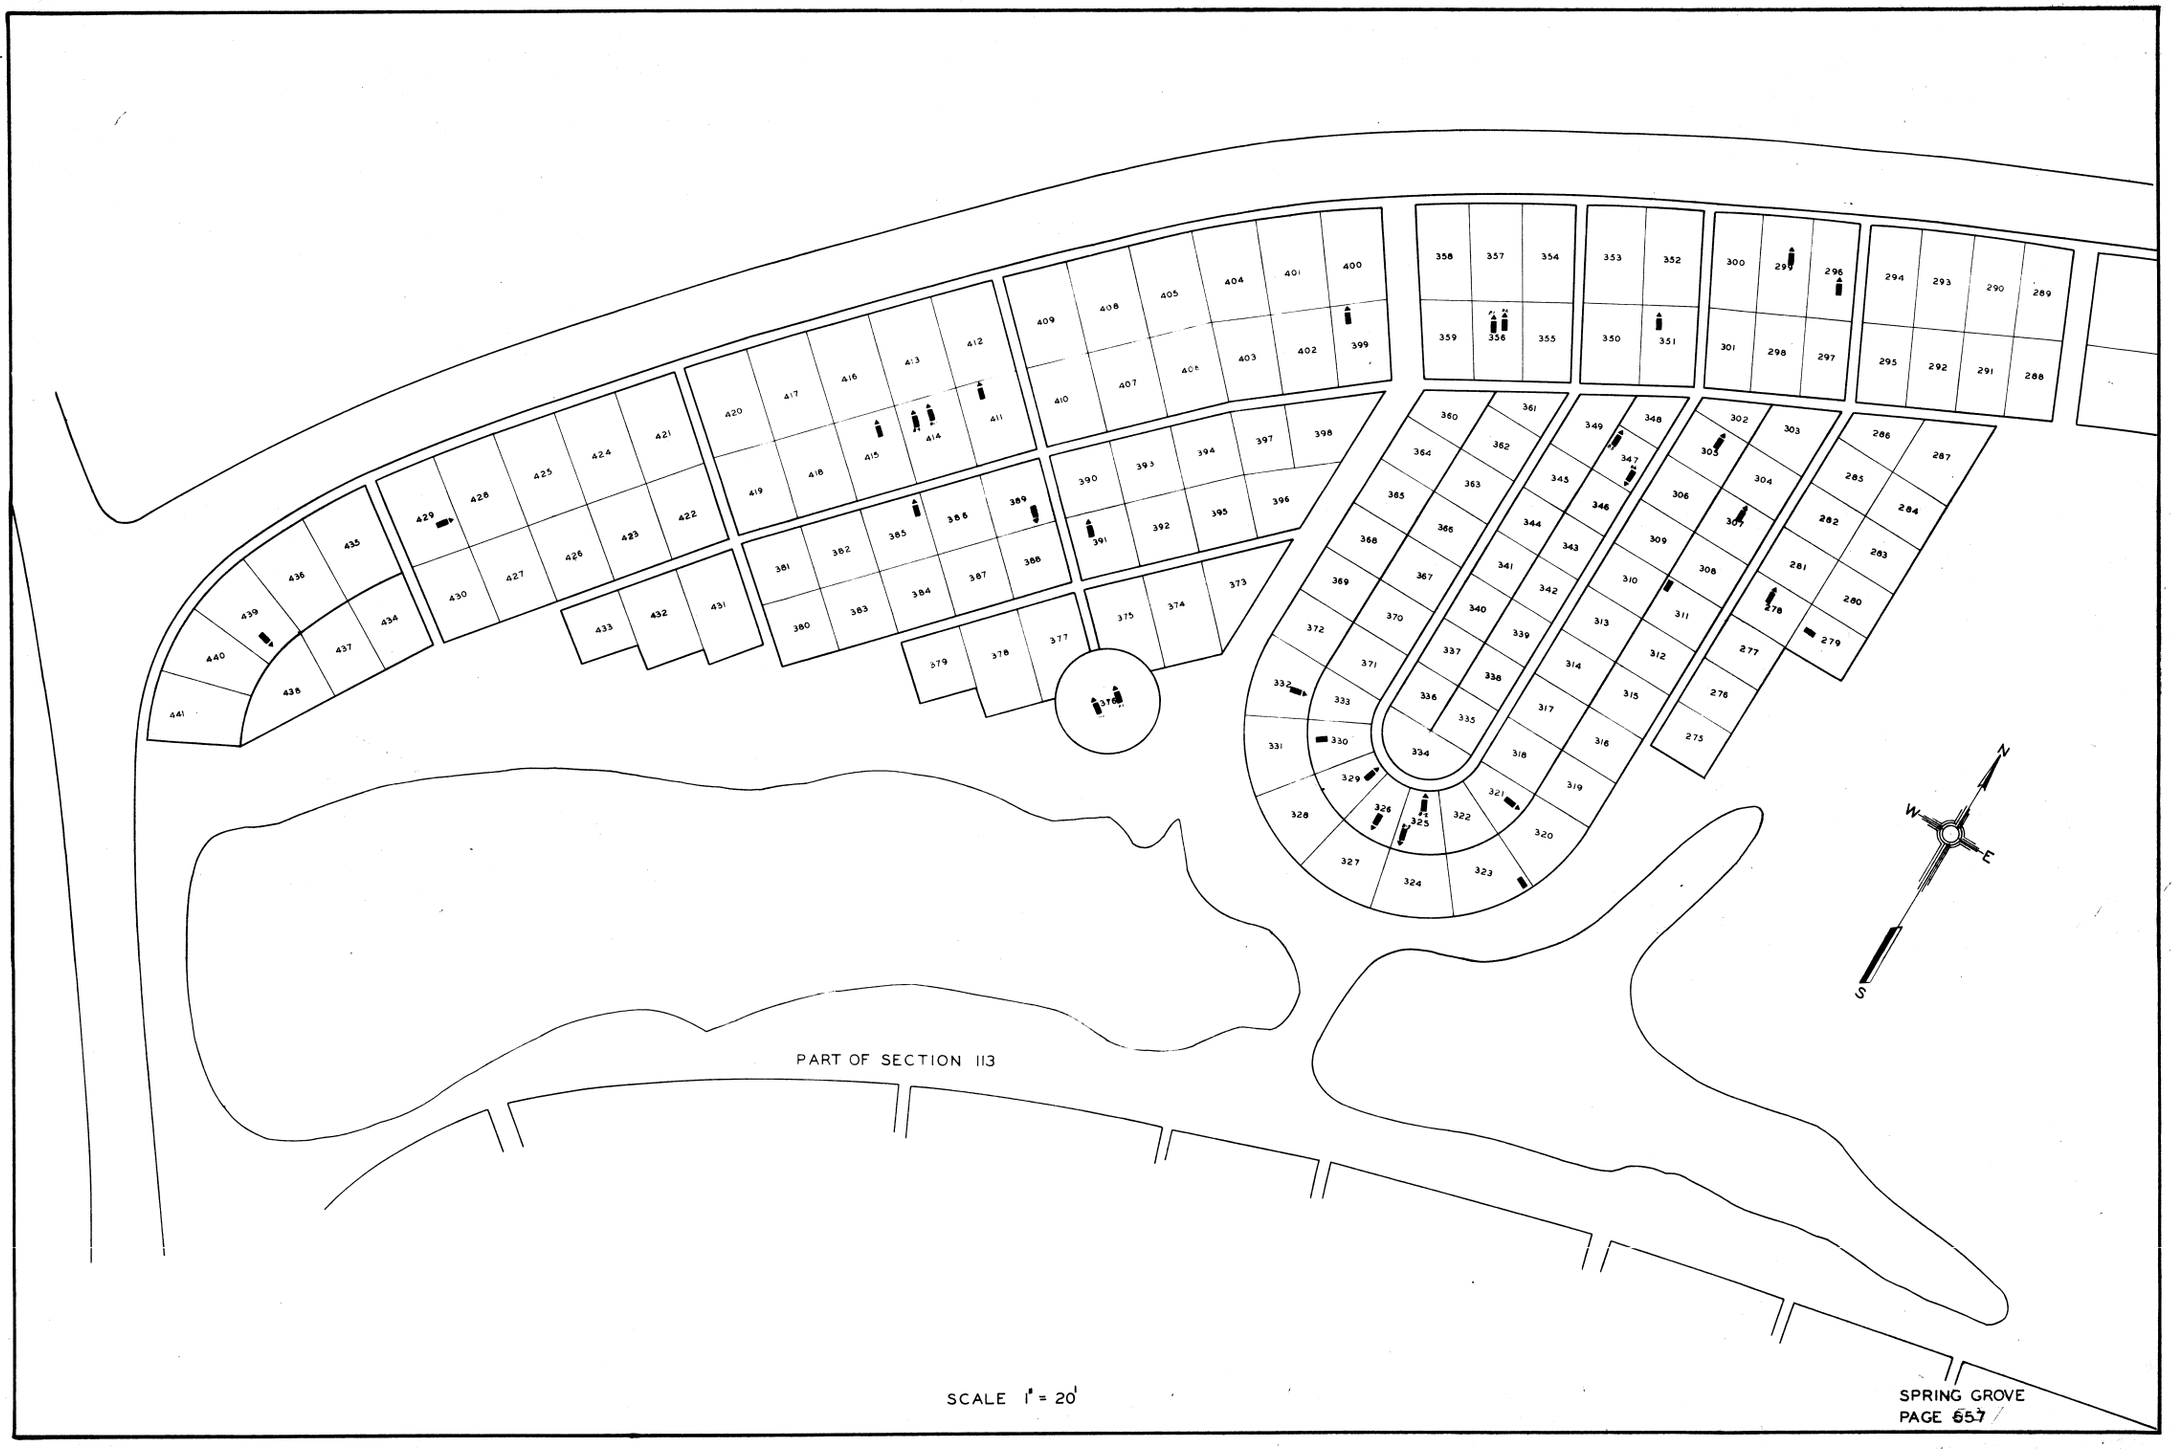

SPRING GROVE
PAGE 557

SPRING GROVE

SECTION 113

LOT	GRAVE	WAR	NAME
278	B 3	(31)	ACKERSON DAVID H
88	B 3	(19)	ALLEN ANDREW
239	B 1	(19)	ARMSTRONG GEO.
42	B 4	(19)	BANCROFT F. C.
239	B 1	(25)	BARBER WM.
389	B 2	(19)	BETTS SAML. O.
305	B 2	(19)	BIERMAN WM. G.
329	B 2	(19)	BLAIR JAS.
167	B 5	(19)	BOYCE WM. H.
228	B 4	(19)	BROWN JOHN P.
225	B 1	(19)	BRUSMAN JOHN H.
235	B 1	(19)	BENTLEY JOHN
230	B 8	(25)	BURL WM. H.
51	B 3	(19)	CALDWELL ALEX. P.
161	B 1	(19)	COOK ISAAC S.
235	B 5	(19)	COOPER WM. T.
98	B 1	(19)	COWIS CHAS. S.
131	B 3	(31)	CUNNINGHAM JOS.
265	B-4	(19)	CUTLER JAS.
26	B 1	(33)	DEITSCH PHIL.
219	B 2	(19)	DELORAC ALEX.
347	B 5	(19)	DENPSTER WILBERFORCE C.
125	B 2	(19)	DIEHL CHAS. M.
307	B 1	(19)	ELLIS SAML N.
64	B 1	(19)	EVANS EVAN J.
356	B 1	(19)	EVANS WM. H.
27	B 5	(19)	FERBER GERHARD
218	B 1	(19)	FLAIG JOHN
321	B 1	(19)	GROSS ALBT. F.
69	B 1	(19)	HELCK MICH'L.
21	B 4	(19)	HAMBLETION JOHN T.
200	B 5	(19)	HARVEY JOHN
260	B 2	(19)	HASTINGS JOHN P.
196	B 1	(19)	HENKE ADAM W.
177	B 6	(31)	HERIER HERBT. P.
414		(19)	HITE JOHN L.
24	B 3	(19)	HODGE WM. M.
332	B 3	(19)	HORST ANDREW.
28	B 1	(19)	HILL SILAS F.
210	B 6		HUGHES HY. E.
347	B 6	(19)	JACKSON E.W.
242	B 3	(19)	JEWETT JOS. F.
183	B 3	(19)	KERNEN RUDOLPH.
143	B 2	(19)	KINDEL JOS. H
192	B 5	(19)	KLATTE JOHN
411	B 3	(19)	KINNEY JOEL F
325	B 3	(19)	LOUCH CHAS. R.
325	B 2	(21)	LOUCH EDW. P.
140	B 1	(19)	MALONEY EBEN B.
376	B 1	(31)	MAXON KIMBALL W.
376	B 3	(19)	MAXON MASON M.
111	B 1	(19)	M CORMICK ANDREW W.
439	B 2	(19)	M CUTCHEON SAML.
257	B 1	(19)	M KEAN WM. H.
131	B 2	(31)	MEIER HARVEY A.
44	B 4	(19)	MILLER JAS
296	B 1	(19)	MILLER JOHN L.
279	B 6	(19)	MINER SAML. L.
260	B 2	(19)	MOORE JACOB
299	B 1	(19)	NIEHAUS HENRYK.
415	B 4	(19)	NIEMAN THEO.
249	B 2	(19)	NIXON WM.
385	B 2	(25)	PARTLOU WM. L.
351	B 3	(19)	PARIS CARLTON
132	B 3	(19)	PIESCHE JOS
97	B 2	(19)	REIS AUG.
264	B 3	(19)	ROBERTS THOS
80	B 8	(19)	RIMPLER WM
4.	B 1	(9)	SAEGER FRED
93	B 1	(19)	SCHOTT JOHN M.
187	B 1	(19)	SCHROEDER CHAS. J.
49	B 2	(19)	SEIDEL FREDERICK
82	B 2	(31)	SILVER BENJ S
110	B 1	(19)	SKEES ROBT. R.
32	B 3	(19)	SMALL JOHN J.
323	B 2	(25)	SMITH CHAS. A
30	B 2	(19)	SPENCER WM. W.
414	B 4	(19)	STOKER ROBT. W.
191	B 1	(19)	STREHLE JOS
399	B 1	(19)	SCHERER JOS
229	B 1	(19)	SEIFERT AUGUST
19	B 1	(19)	SILBERNAGEL CONRAD
154	B-2	(19)	STEVENSON GEO. V.
311		(31)	SENFT MARTIN G.
356	B 4	(19)	THOMAS DAVID T.
240	B 3	(19)	THRALL WM R.
330	B	(19)	TURNER GEO
115	B 6	(31)	TIEMAN LOU G
236	B 4	(19)	WALDEN JNO M.
206	B 2	(19)	WALPLY JOS
79	B 2	(19)	WARD GEO.W
326	B 1	(19)	WHITELY CHAS. W
126	B 2	(31)	WIEMAN WM R
108	B 3	(19)	WIKEL FRANK H.
121	B 2	(19)	WIKOFF JAS
268	B 5	(19)	WILKINSON CHAS A
429	B 2	(19)	WILSON ANSON
205	B 1	(19)	WOODWARD HENRY. L.
74	B 5	(31)	WYDMAN ROBERT. S.
11	B 6	(25)	WHITE RODDY H
74	B 3	(19)	WYDMAN SAML.
202	B-2	(19)	WEISBRODT MICH'L.

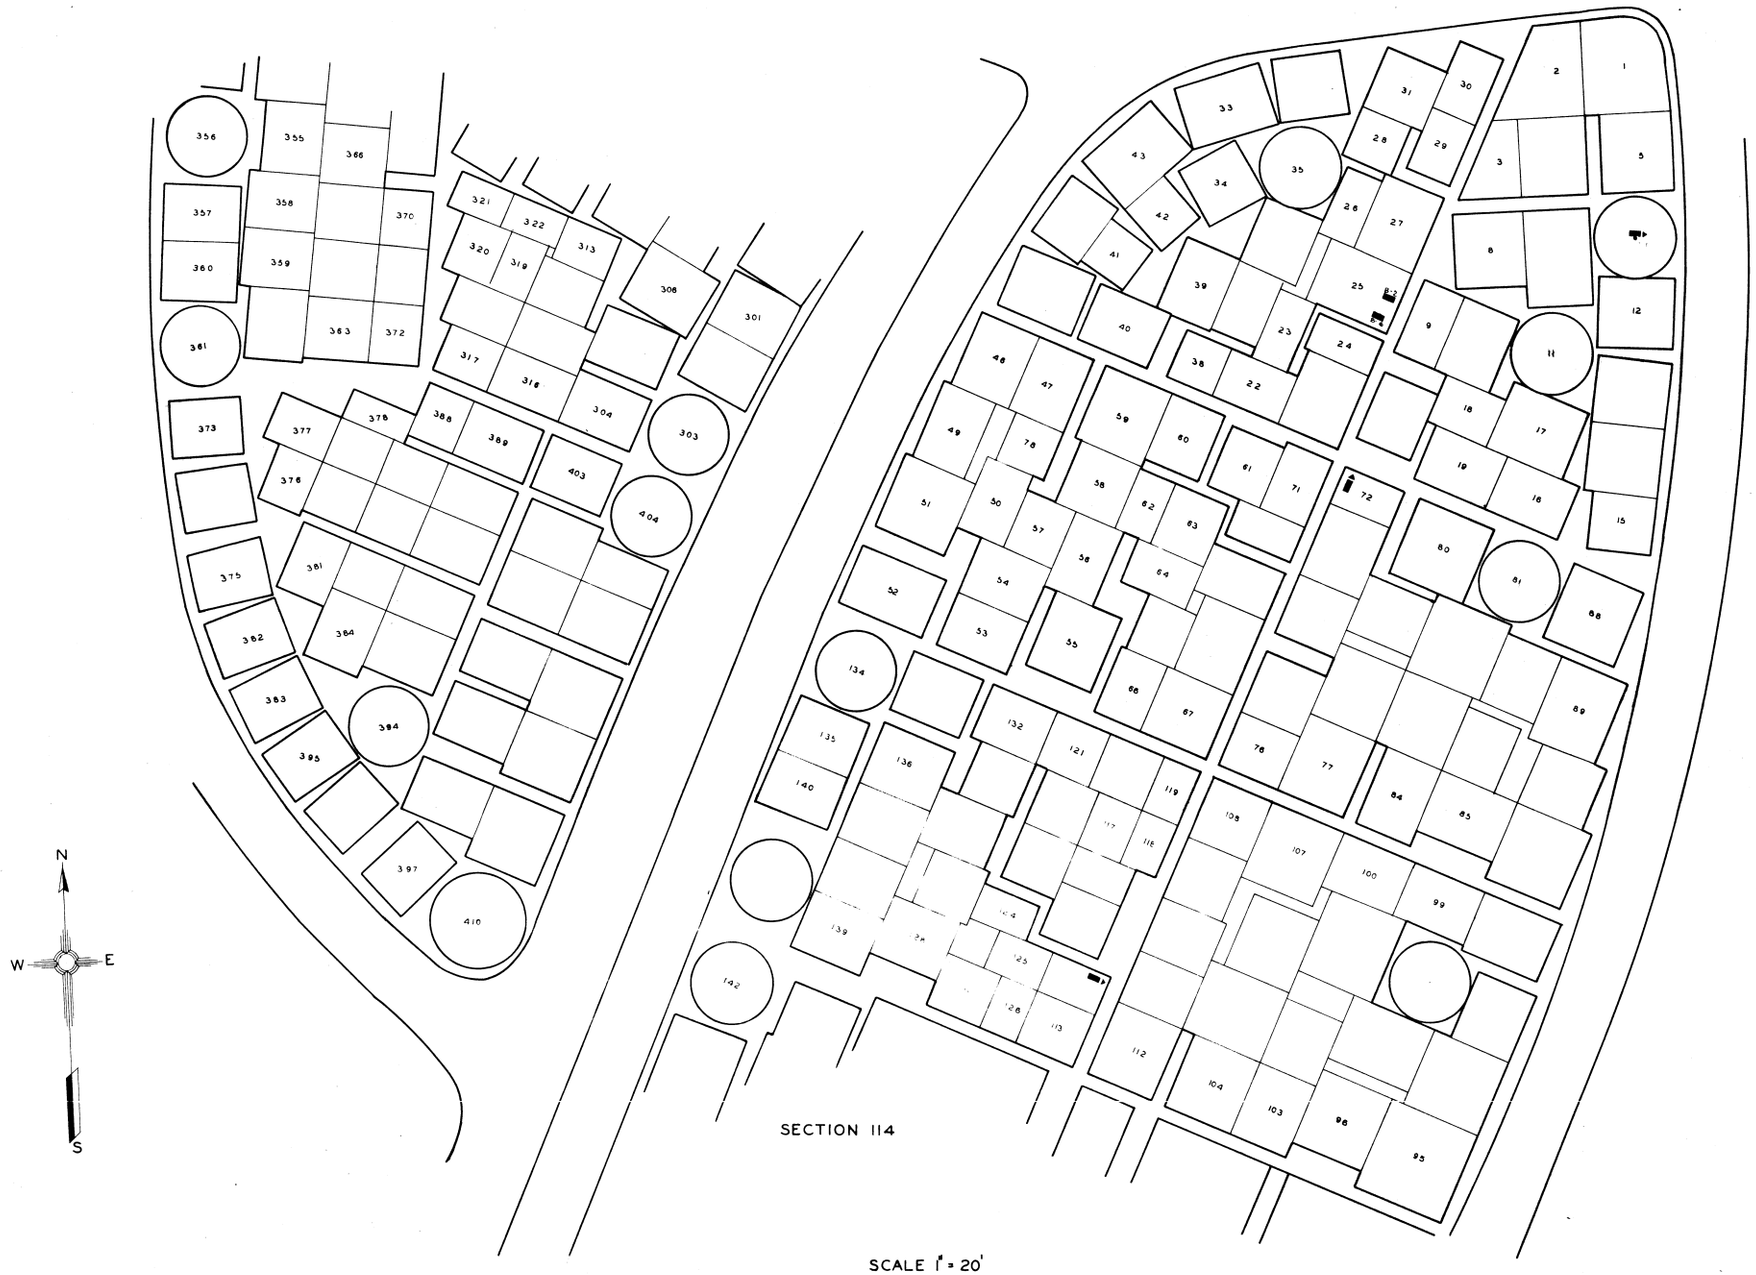

SCALE 1" = 20'

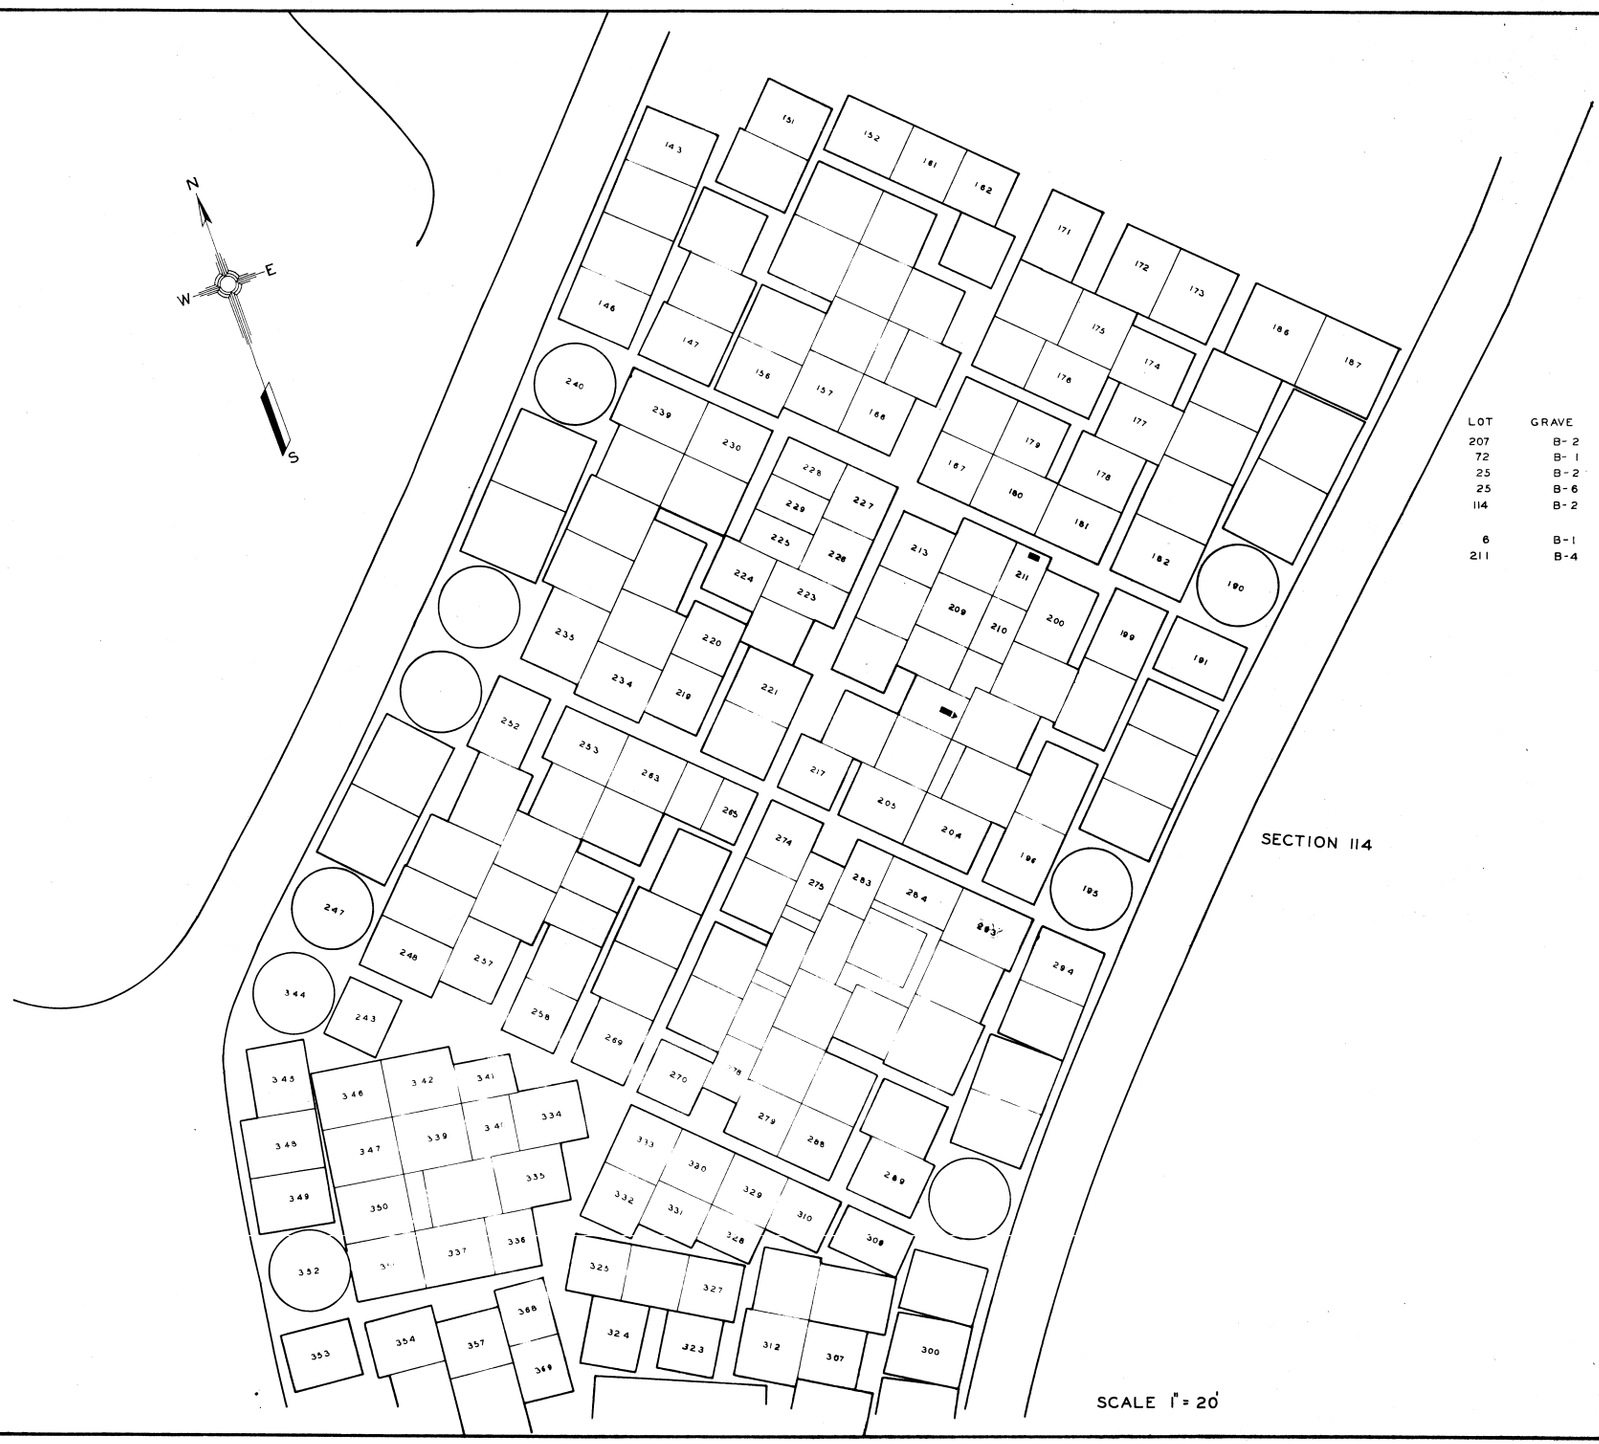

LOT	GRAVE	WAR	NAME
207	B-2	(19)	ARMSRONG BENJAMIN
72	B-1	(19)	BEHNER FREDK.
25	B-2	(19)	HADLEY CALEB
25	B-6	(31)	NELSON JOE. WILLARD
114	B-2	(31)	WANNER MELTON H.
6	B-1	(19)	CALCLESSER WM. K.
211	B-4	(19)	PENNINGTON N. V.



SCALE 1"=20'

SPRING GROVE
PAGE 381

LOT	GRAVE	WAR	NAME
365	B- 2	31	ALTAMER HAROLD M.
$54	B- 2	34	AUG. THOMAS P.
418	B- 2	18	BILLING CHAS.
8	B- 2	34	BLACKHAM RUSSELL P.
547	B- 2	31	BOLLINGER LOUIS A.
498	B- 3	31	BRENT WALTER B.
369	B- 2	19	BURDGH ALONZO G.
433	B- 1	31	CURTIS ARTHUR
245	B- 2	19	DAVIS GEO. W.
560	B- 1	19	DONLEY JOHN
351	B- 1	19	ECKSTEIN ANTHONY
257	B- 3	34	GEHRIN HENRY J.
254	B- 2	34	GUTZWILLER J.
320	B- 1	31	HILL STANLEY J.
302	B- 1	31	HEINLEN ARTHUR P.
136	B- 1	19	HUFFMAN JOHN B.
104	B- 2	19	KELLY JOHN P.
505	B- 1	31	KNOPP HAWARD G.
220	B- 1	31	LA-MONT BERT L.
523	B- 3	19	LAPHAM PETER F.
382	B- 2	31	LAPTHORN JOHN WM.
484	B- 2	31	LAW EDW. B:
557	B- 3	31	LURING WM.
106	B- 2	19	LUTTERBEIN WM. H.
589	B- 1	31	MATHERS WM. H.
291	B- 1	31	MELCHER WALTER C.
530	B- 1	19	MILLER LOUIS J.
429	B- 1	34	MILLER LLOYD I.
246	B- 1	19	MYERS PHILIP V.
597	B- 1	19	PEASE WM. P.
328	B- 2	31	PROCTOR WM. B.
171	B- 1	19	ROBERTS EDW.
559	B- 1	19	ROBERTS RICHARD
67	B- 2	19	ROBINSON THOMS. G.
499	B- 1	31	SCHEVE LESTER G.
33	B- 1	31	SEALMAX E
213	B- 1	19	SMITH CLAYTON C.
14	B- 2	34	STRUBBE LOUIS H.
289	B- 2	19	STUDER EDW.
369	B- 3	19	SUNDERMAN CASPER
30	B- 2	34	TERHUNE LOUIS L.
39	B- 1	19	TOWSLEY JOHN T.
227	B- 1	31	UNDERWOOD WM.

LOT	GRAVE	WAR	NAME
70	B- 1	19	BUTZ RUDOLPH.
278	B 2	31	DICK WM. F.

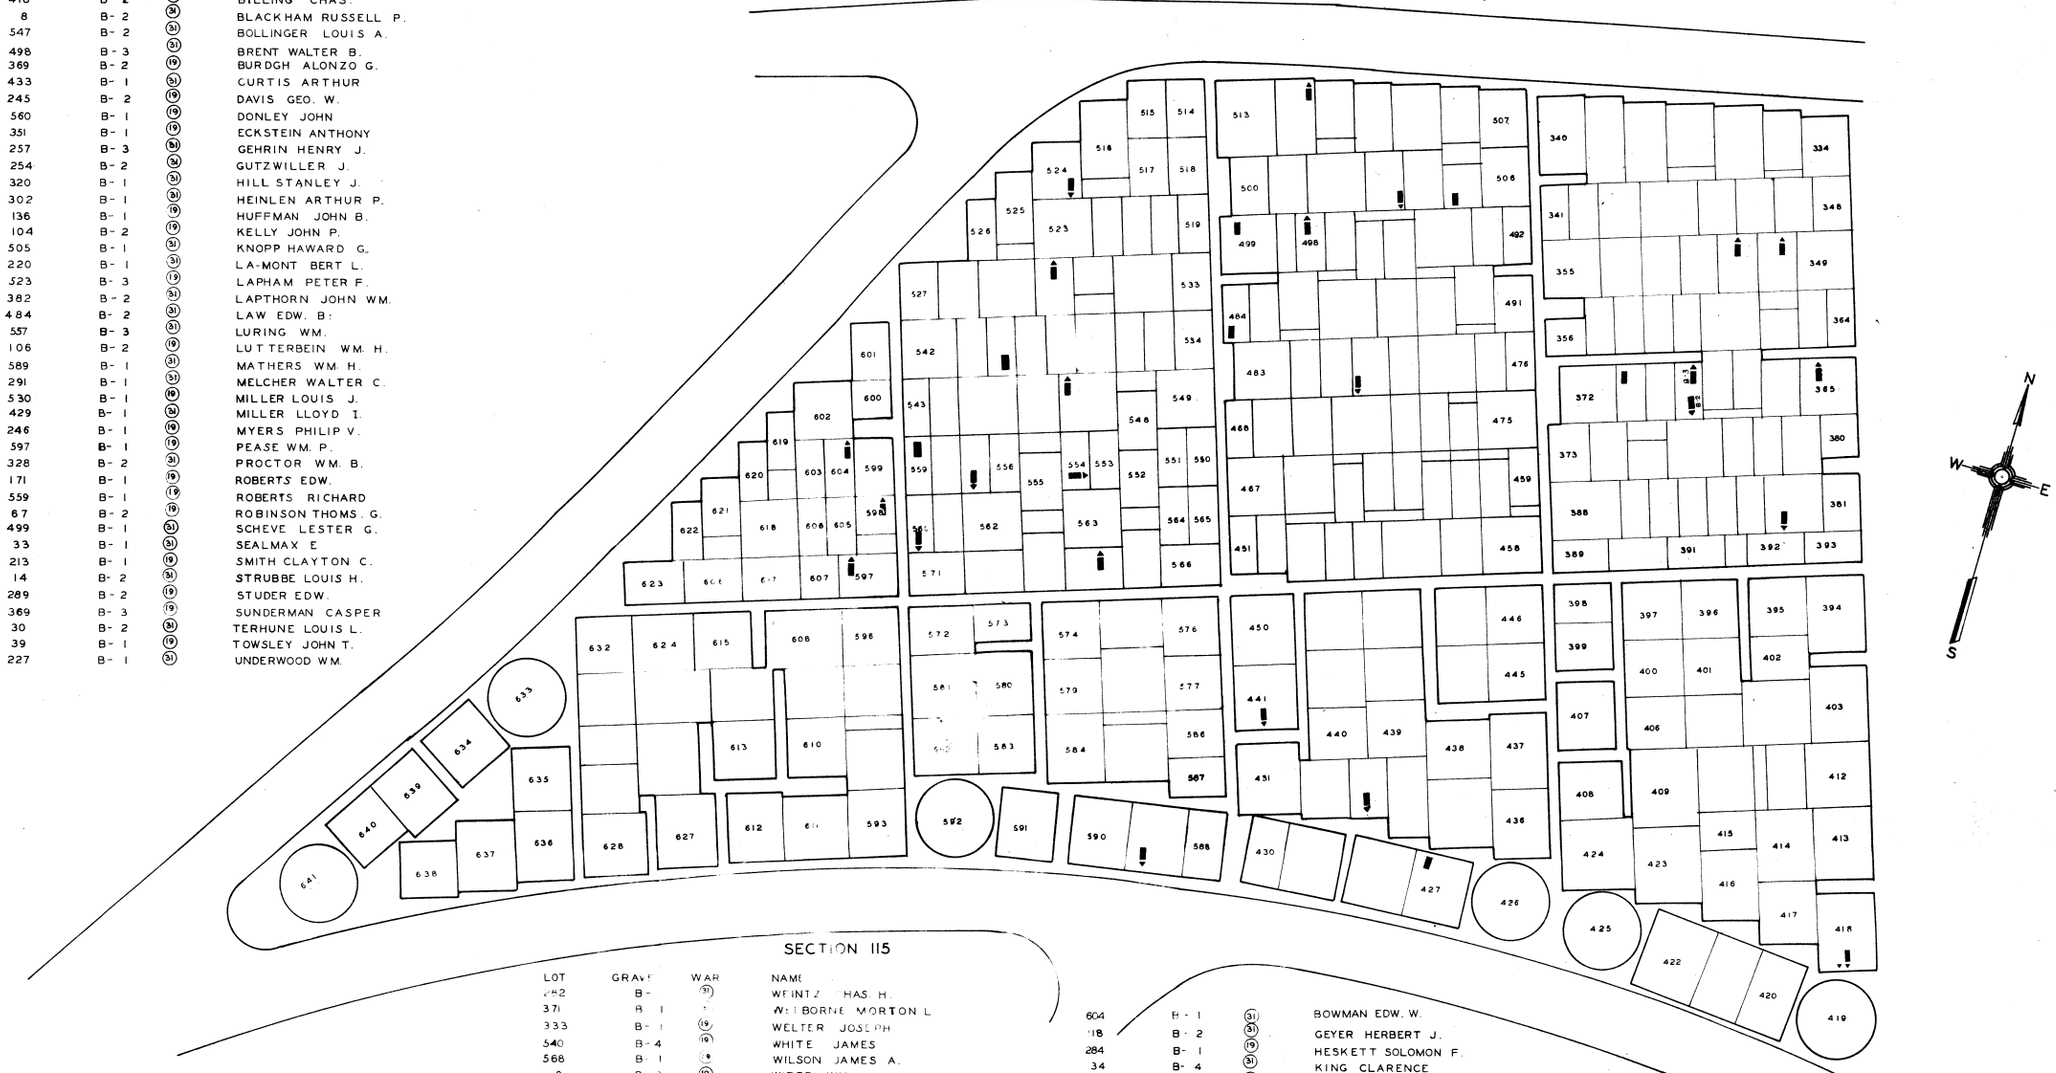

SECTION 115

LOT	GRAVE	WAR	NAME
282	B-	31	WEINTZ CHAS. H.
371	B- 1		WELBORNE MORTON L.
333	B- 1	19	WELTER JOSEPH
540	B- 4	19	WHITE JAMES
568	B- 1	19	WILSON JAMES A.
9	B- 3	19	WITTE WM.
129	B- 1		WUEST GEO G.
175	B- 3	19	ZIEFLE JOS.
208	B- 1	25	HARDEN ALVA G.
239	B- 2	19	IRVING WM.
480	B- 4	31	PLATZ HAROLD E.
598	B- 1	19	CULLUM EDW. H.
441	B- 1	31	KING JOHN R.
76	B- 1	19	LAY ANDREW
512	B- 1	28	MARQUA WM.
230	B- 1	31	SHIVLER BERTRAM F.

LOT	GRAVE	WAR	NAME
604	B- 1	31	BOWMAN EDW. W.
118	B- 2	31	GEYER HERBERT J.
284	B- 1	19	HESKETT SOLOMON F.
34	B- 4	31	KING CLARENCE
350	B- 4	19	MILLER CHAS
172	B- 1	34	MILLER LAWRENCE D.
29	B- 1	31	MILLER MORRIS L.
38	B- 1	34	OKER CLIFFORD E.
155	B- 2	19	PERRY JOHN
5	B- 1	34	PETERSON JENS C.
328	B- 1	25	PROCTOR JOHN
293	B- 2	31	SCHEOONE HARVEY C.
229	B- 1	31	SCHUSTER GEO J.
33	B- 4	31	SEAL HERBERT J.
218	B- 2	25	THOMPSON FRANK P.
503	B- 1	19	VAN BENSCHOTEN THEO.
143	B- 5	28	WILLIS ALF. B.
284	B- 2	31	ZIMMERMAN ALF.

SCALE 1"=20'

SPRING GROVE
PAGE 562

LOT	GRAVE	WAR	NAME
63	B-2	(19)	GUSLETTER HENRY G.
24	B-2	(19)	HUGHES JAMES M.
32	B-2	(19)	KANE MICHAEL
41	B-2	(31)	McCLURE HENRY D.
17	B-3	(31)	PUCHTA LAWRENCE GEO.
40	B-3	(31)	VALENTINE FREDR. O.
14	B-3	(31)	BOUTET JOHN B.

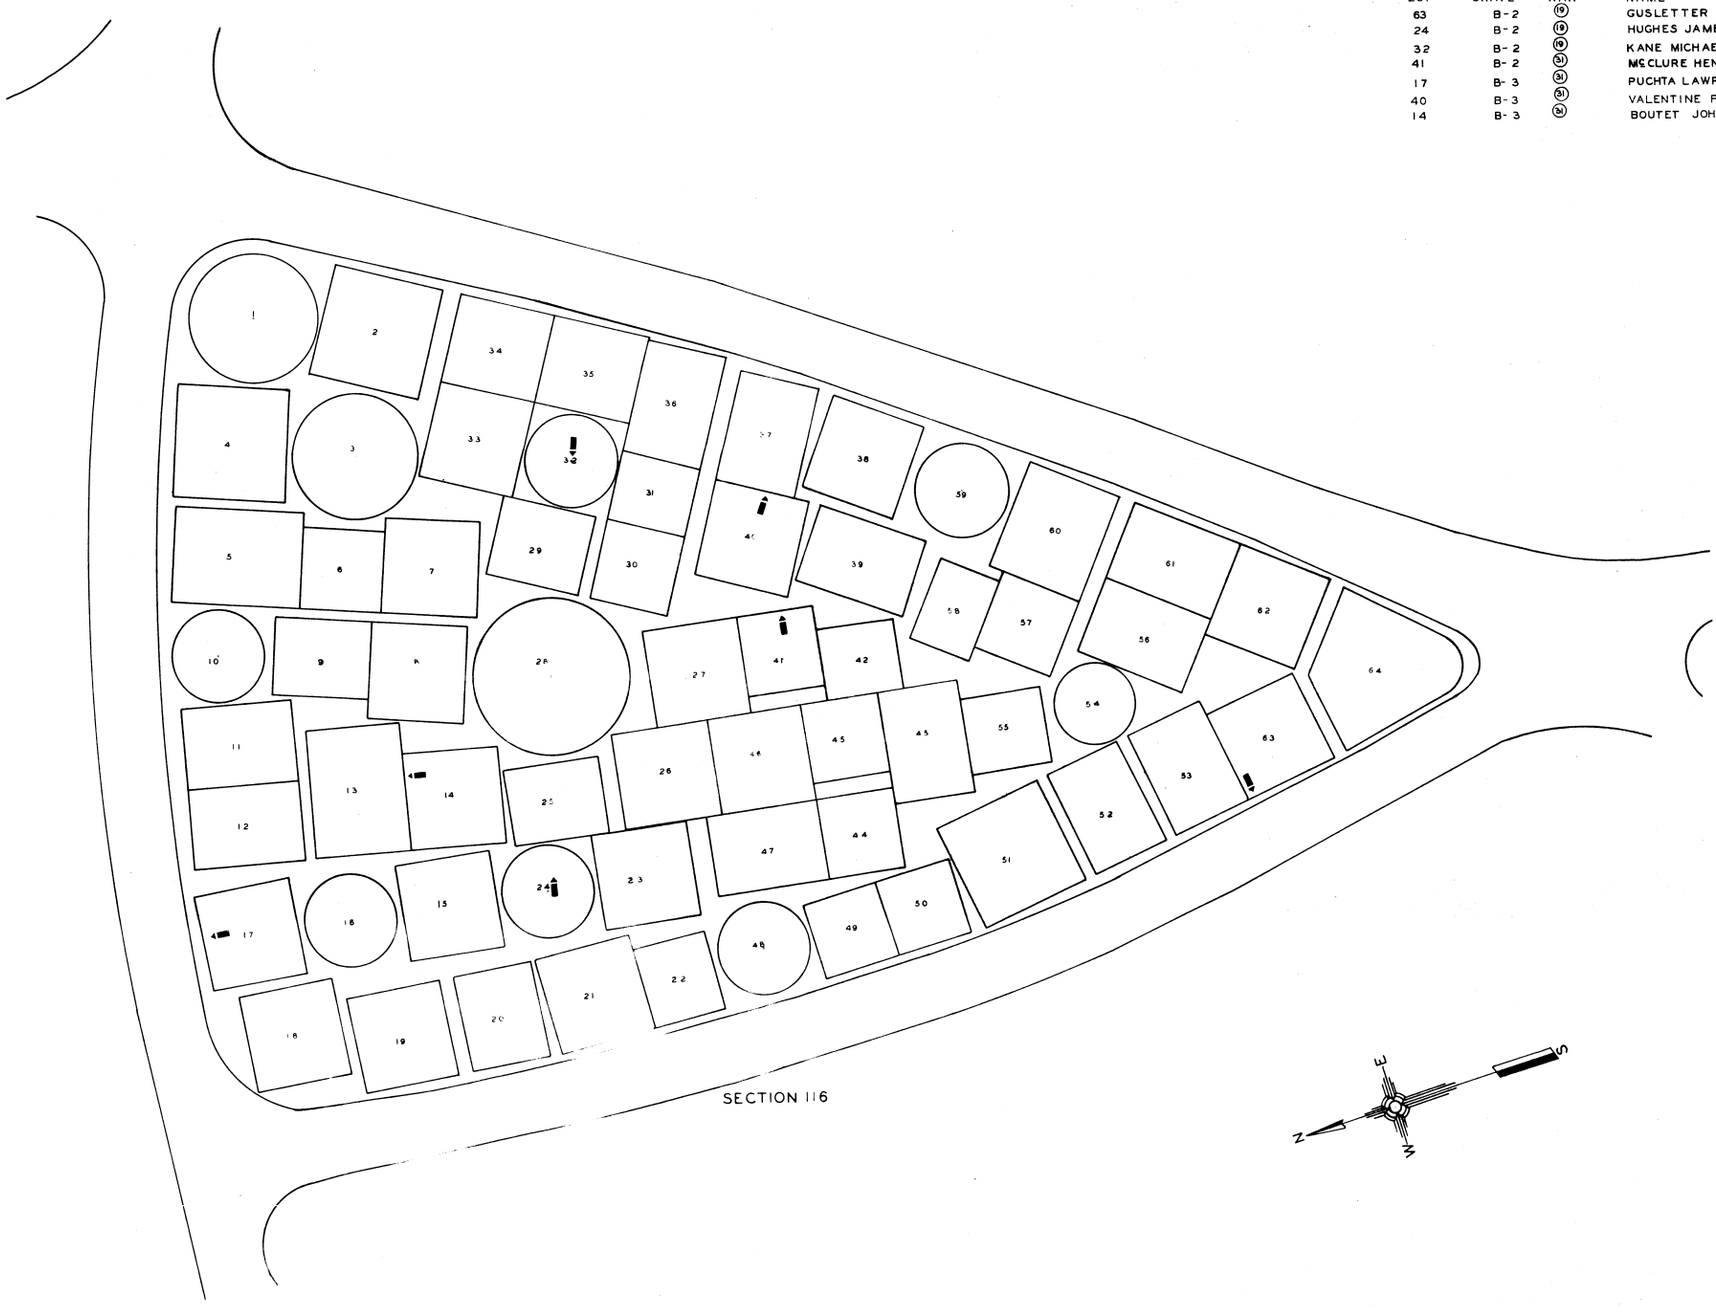

SECTION 116

SCALE 1" = 20'

SPRING GROVE
PAGE 363

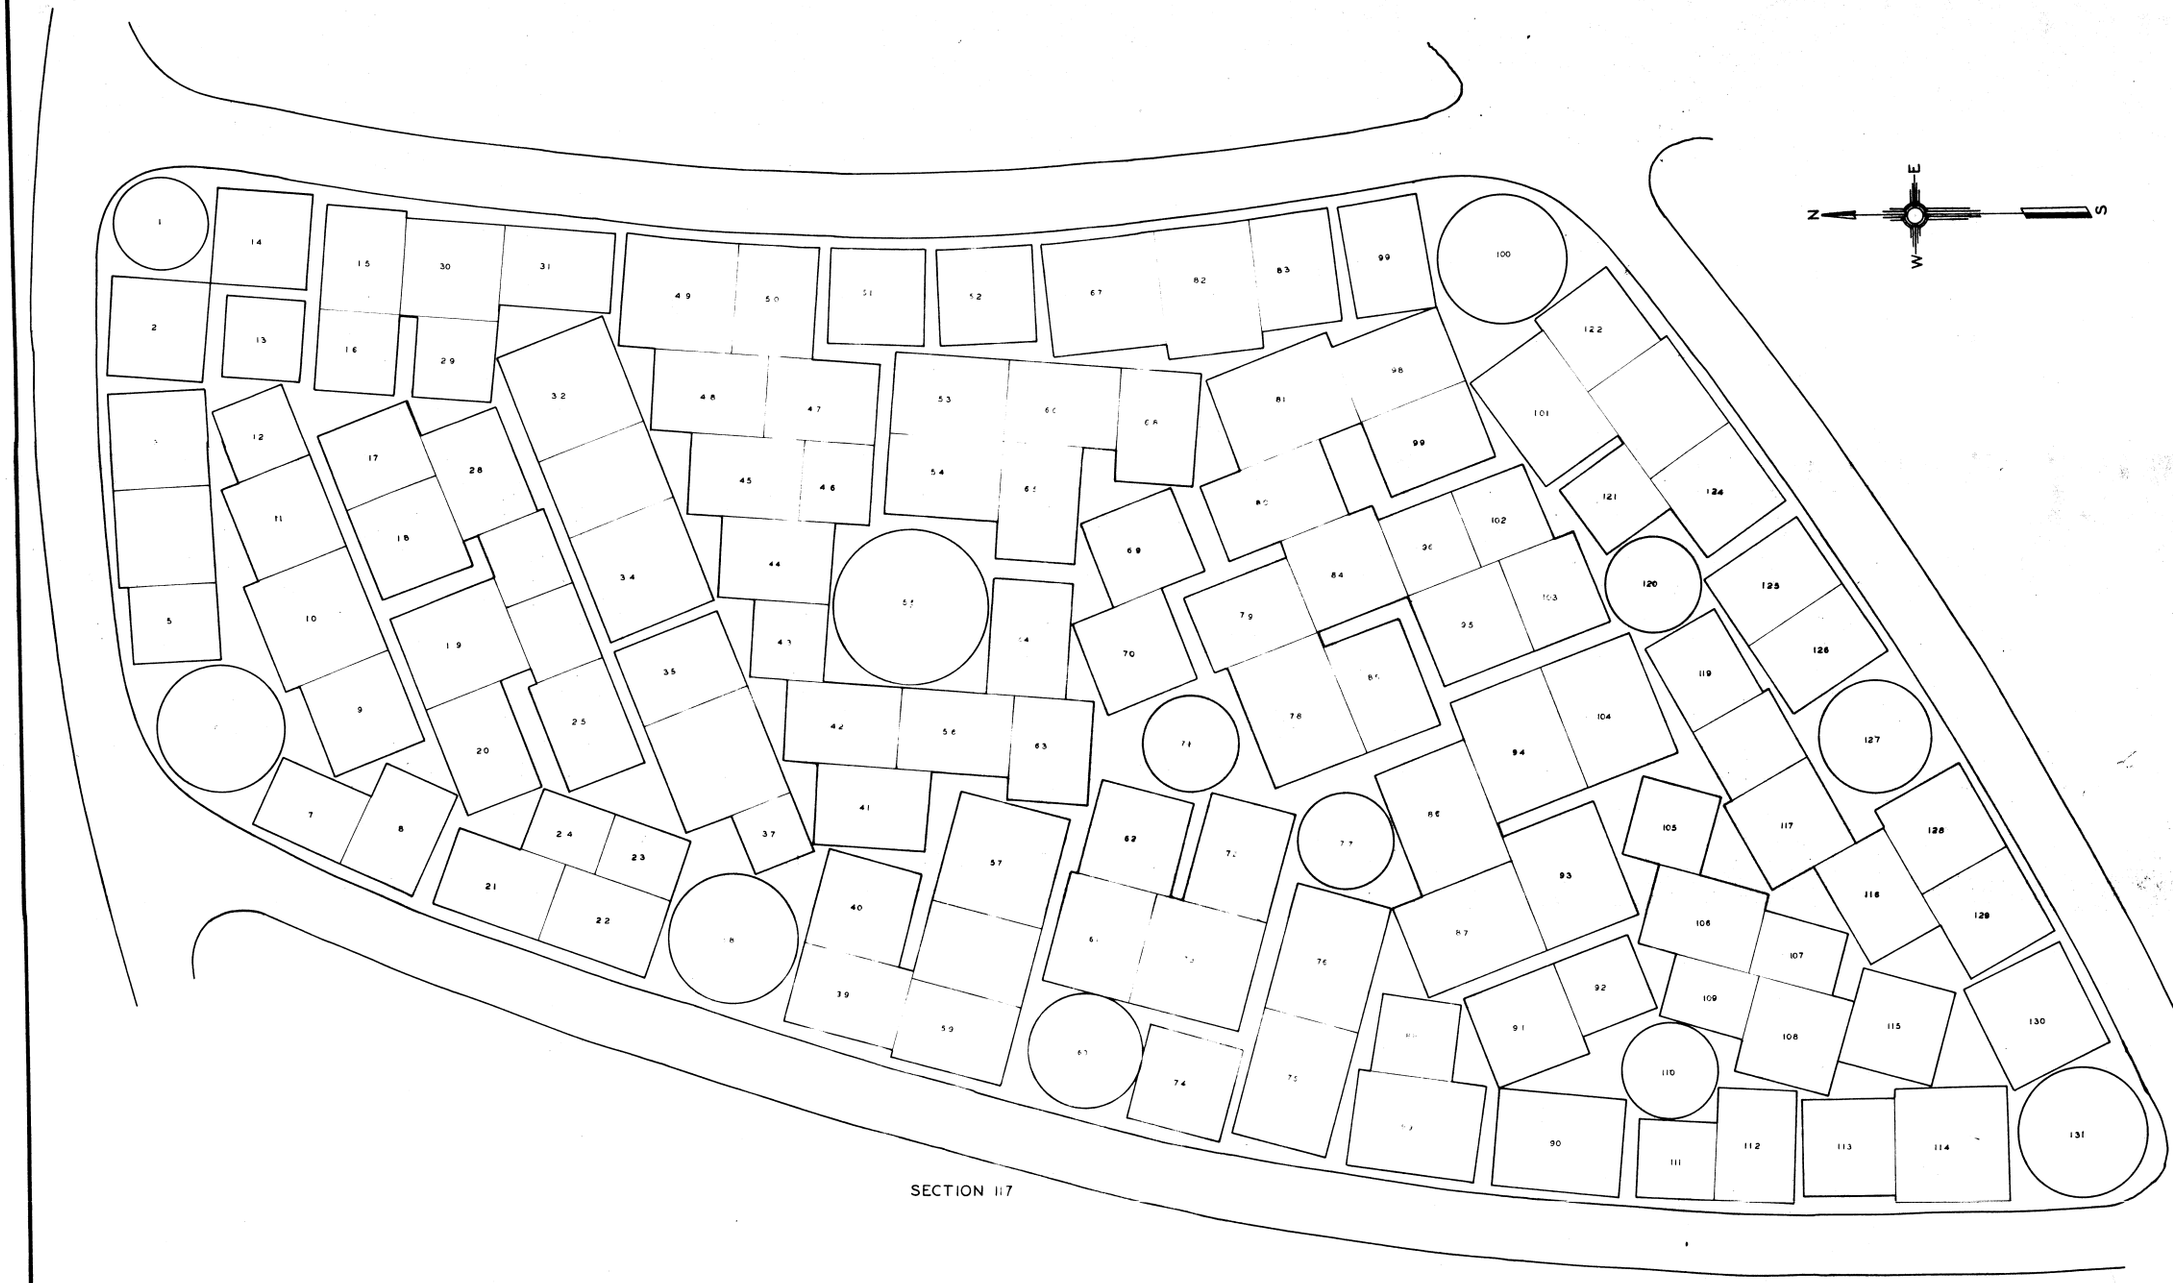

SECTION 117

SCALE 1" = 20'

SPRING GROVE
PAGE 564

LOT	GRAVE	WAR	NAME
172	B 1	19	ADAMS WM. H.
18	B 4	19	BAKER JAS W.
165	B 2	31	BARNETT L. M.
122	B 1	19	BODEMER JOHN
20	B 7	31	BRENNER WM. H.
104	B 1	19	CORMAN GEO. W.
287	B 3	19	COTTLE SIMON H.
2	B 10	19	COY ELISHA W.
36	B 1	19	DAVIDSON WM. H.
43	B 1	19	DECAMP CALEB
195	P 3	19	DEVORE WM.
12F	B 1	19	DOUGLAS J.
30F-A	B 1	31	FORD COLLIN
123	B 5	31	GERARD STEP.
314	B 1	31	GREGG WM. A
48	P 1	19	HAMILTON JAS.

LOT	GRAVE	WAR	NAME
67	B 2	19	HAMILTON WM.
134	B 2	31	HELFFERICK E. J.
42	B 1	19	HIGH GEO. H.
114	B 1	19	HOFFMAN LOUIS G.
16	B 2	31	JEWELL EDWIN W.
153	B 4	19	JOHNSON ELIJAH
295	B 3	19	LIEBICK MARTIN
273	B 6	19	MARTIN ABSALOM
105	B 1	19	MILLER WALT.
159	B 1	19	MILLS JAS.
88	B 2	19	MOORE JOHN D.
151	B 1	19	PALMER WALT. R.
286	B 1	19	ROBERTS HARRY C.
236	B 2	19	ROBERTSON LUCIUS
291	B 3	25	RYDER FREDR. B.
49	B 2	31	SANDER FRED. W.
37	B 4	19	SANDERS FRANK H.
261	B 4	19	SMITH JOHN M.
294	B 2	19	WALKER JOHN H.
103	B 2	19	WELLER JAC.
170	B 2	19	WEST CHAS.
138	B 1	19	WIEDERSTEIN ADOLPH
193	B 1	19	WILLIAMS ROBT.
119	B-1	19	BALTZELL ISAAC N
218	B-1	31	CLEVELAND STAN. M.
264	B-2	19	DE MAR JAS. T.
76	B-1	25	GRADEL JOHN
178	B-5	21	HALL JOS. A.
262	B-1	19	KLINKE FLORIEN
231	B-1	31	SCHWEIN WM. G.
11	B-3	19	STREIT CHAS. F.
234	B-1	19	VOELKER JAC.

LOT	GRAVE	WAR	NAME
12	B-5	31	BURNS FRANK M.
195	B-2	19	DEVOER JOHN
247	B-3	31	GASSNER LOU. F.
282	B-1	25	HAKE CHAS. F. JR.
48	B-4	25	HAMILTON JOHN W.
124	B-1	19	JOCKERS F. G.
210	B-1	31	JOEST ELM. J.
270	B-1	19	KAISER CHRIS.
81	B-3	31	OSMOND ART. E.
116	B-3	25	SMITH CHARLES H.
83	B-4	31	WARE HOWARD J
207	B-5	19	WEITZEL GEO.
39	B-1	19	WINTER CONRAD
6	B-2	19	WRIGHT JOS.



SECTION 118

SCALE 1" = 20'

SPRING GROVE
PAGE 563



SCALE 1" = 20'

SPRING GROVE
PAGE 586



SECTION 119

SCALE 1" = 20'



LOT	GRAVE	WAR	NAME
168	B 1	(31)	BYERS ART. H.
97	B 1	(31)	BUECHE FRANK W.
308	B 2	(31)	CAMPBELL JOHN F.
308	B 1	(19)	CAMPBELL JOHN H.
310	B-2	(31)	CARR LUCIEN S.
310	B 1	(31)	CARR THOM. M.
229	B 3	(31)	DAVIS CHAS. M.
296	B 1	(19)	CHAPMAN ALF
114	B 5	(25)	CONZETT JOHN J.
13	B-1	(19)	DAUBENBIS JAC.
13	B 2	(19)	DAUBENBIS FRED.
73	B 2	(31)	DICKERSON OWEN H.
124	B 2	(31)	DIXON WALT. A.
16	B 1	(19)	EDWARDS WM.
369	B 1	(31)	ERWIN JAS. C.
85	B 3	(31)	GRIMM FRANK L.
90	B-1	(25)	HACKMAN H.
358	B 2	(19)	HEATH PHIL N.
325	B 4	(31)	HOLLER ART. L.
33	B 3	(19)	HUBER LEO.
7	B 2	(19)	ISGRIGG WM. H. H.
185	B 2	(19)	JONES JOHN A.
89	B 1	(31)	KAUTZ D. WM.
43	B 1	(19)	MARTIN JAS.
70	B 1	(19)	MASON THOM.
132	B 3	(31)	McCAMMON JOHN W.
193	B 2	(19)	MILLER JOHN A.
343	B 1	(19)	MILLER HENRY
288	B 1	(31)	MITCHELL PRESCOTT T.
275	B 2	(31)	MORRISON LLOYD R.
72	B 2	(19)	MORTIMER JOHN
269	B 4	(31)	MYERS EDW. J.
91	B 8	(31)	PHILLIPS SAML. W.
352	B 1	(19)	PINGER LOUIS
318	B 2	(19)	QUIGLEY WM. C.
220	B 4	(19)	ROBERTS WM. G.
226	B 1	(19)	RUTTER JAS. G.
38	B 4	(31)	WEBBER OSCAR W.
25	B 3	(31)	SCHLESSELMAN CARL G.
366	B 2	(31)	SCHOLLE CLIF. W.
39	B 1	(19)	WILDER HENRY C.
30	B 1	(19)	WOOD EDMOND E.
61	B 3	(19)	WULFECK EDW.
229	B-2	(19)	TROUTS MICHAEL
267	B-3	(31)	BECKER WM. R.
371	B-2	(19)	BORCHERDING HENRY
350	B-3	(19)	FAHNESTOCK JAS. D.
342	B-4	(19)	KIRSCHBAUM MORTZ
248	B-5	(25)	LANE GEO. N.
337	B-1	(19)	THAYER GEO. A. REV.
38	B-2	(19)	WEBBER CHAS.
350	B-2	(19)	FAHNESTOCK JAS. D.
166	B-1	(19)	THAYER NELSON W.

SPRING GROVE
PAGE 568

LOT	GRAVE	WAR	NAME
216	B - 3	19	BRIBIN JOHN V.
132	B - 2	31	BUYSSE CYRIEL
272	B- 3	19	CHAMBERS EARL E.
272	B- 2	19	CHAMBER SAMUEL
71	B- 1	31	DAVIS HENRY M.
172	B - 3	19	EAGLE JAMES
178	B- 1	31	FEHL MORTON
7	B- 3	19	FILEX CLIFFORD J.
50	B- 3	23	FISHER CHAS. T.
53	B- 2	19	GRAHM THOMAS P.
		19	
275	B - 1	19	HALLTHOMAS J.
211	B- 1	19	HEISEL FILIP
241	B- 6	23	HULLB AL. B.
63	B- 1	19	JOHNSON WM. H.

LOT	GRAVE	WAR	NAME
189	B- 1	19	BURGESS JAMES J.
6[illegible]	B 1	19	CHAMBERLIN NORWOOD J.
70	B 2	19	ESPACH SERAPHIN
49	B- 2	19	GILSON WM. H.
206	B- 4	19	HAZARD EBENEZER M.
189	B- 2	19	KEEPERS SAMUEL
173	B- 1	19	ROBSON JAMES E.
181	B- 2	19	ROSER CHRSTIAN
90	B- 2	19	SHINER HENRY G.
12	B- 1	19	TURRELL ISAAC H.
54	B 2	19	WOOLEY THOMSON N.
289	B- 1	19	YOUNGSON WM. W.
204	B 1	31	DAVIS FRANCIS E.
30	B- 4	31	FOSTER ROB'T. A.
6[illegible]	B- 2	19	REGNIER CHAS.
90	B- 4	19	SHINER JESSE
184	B- 2	19	TAYLOR BLANTON B.
15[illegible]	B- 1	31	WEICOLD CLARENCE C.



172	B- 2	19	CHABERS SAMUEL
104	B- 1	19	KANEY JOS.
111	B- 3	19	KELLER JOHN
240	B - 2	19	KOCH JOHN L.
179	B- 2	19	LEONARD JOHN
250	B- 2	19	MALONE JOHN W.
14	B - 3	19	MC DONALD SAML. M.
77	B - 3	23	MEISTER EDW.
29	B- 1	19	MOESTA MICHAEL
21	B- 1	19	MYERS THOMS. J.
122	B- 1	19	POWERS JAMES
297	B- 2	31	PEARSON RICHARD C.
244	B - 4	19	PETERS WM.
288	B- 1	19	SHEPHERD JAMES
112	B- 2	31	SKINNER AL. L.
149	B - 3	19	STERLING HENRY L.
5	B- 2	19	TICHMAN HERMAN
287	B- 1	19	WILSON ALEX.
139	B- 1	19	YORSTON MATHEW

SECTION 120

SCALE 1" = 20'

SPRING GROVE
PAGE 569

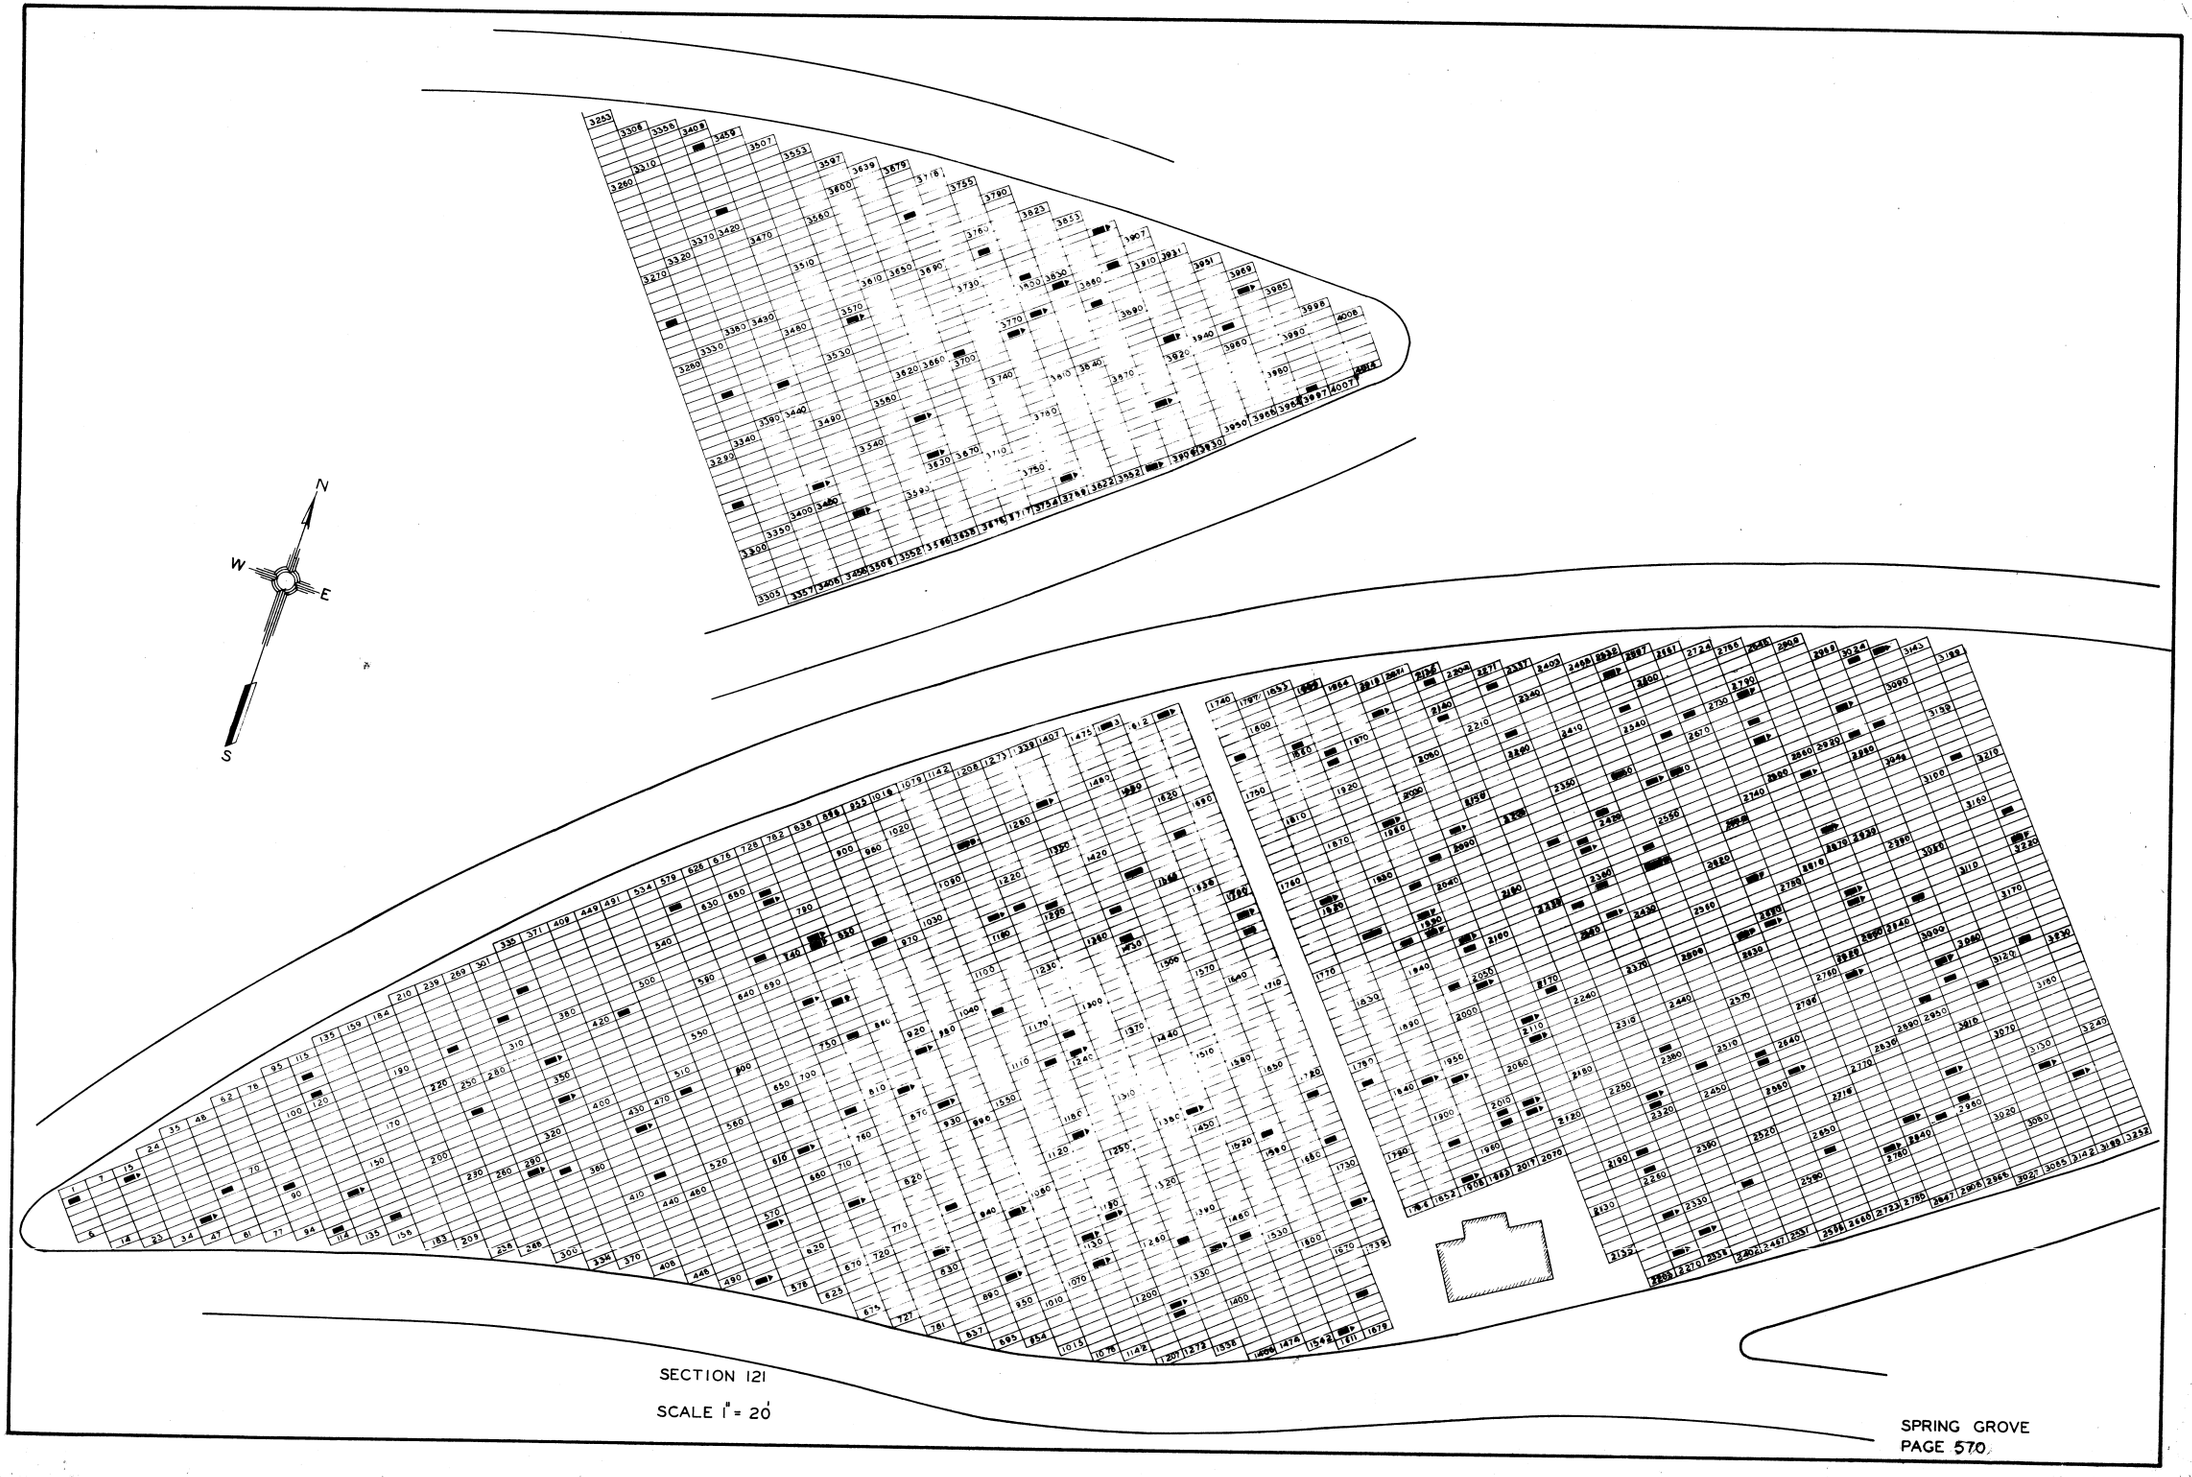

SECTION 121

SCALE 1" = 20'

SPRING GROVE
PAGE 570

LOT	GRAVE	WAR	NAME
	1903	(19)	ADAMS WM. H.
	1223	(19)	ADAMS WM. H.
	1986	(31)	ALLEN JOHN
	45	(33)	ALLGEIER MATHIAS
	1675	(19)	ANDERSON WM. H.
	352	(19)	ARNOLD CHAS. R.
	2794	(19)	ARRICO LOU.
	2297	(19)	BARNES JAS. M.
	3571	(19)	BARNES JOHN R.
	2779	(19)	BENNETT WM. H.
	1722	(19)	BIRCH CHAS.
	2876	(31)	BLUEMEL ERNEST
	2875	(31)	BLUEMEL W.
	3500	(31)	BLYTE CLARENCE B.
	3771	(31)	BOLSER CHAS. W.
	733	(19)	BOYER CHAS. W.
	1394	(19)	BRASHEARS CHASE E.
	3683	(31)	BURKE ROBT. L.
	867	(19)	BURKHARDT FRED.
	2576	(19)	BOLSER GEO. T.
	246	(19)	BOZMAN JAS. F.
	2652	(26)	BRANDENBURG EFFORD
	3862	(31)	BRANDSTETTER F. J.
	2171	(31)	BIBLE CHAS. F.
	947	(19)	CARVER GEO. W.
	3411	(31)	CARTWRIGHT JOHN B.
	2046	(31)	CASTOR WM. F.
	2836	(31)	CHANNELL L. L.
	928	(19)	COATES SETH. W.
	1182	(19)	COPELAND WM. E.
	3629	(31)	CUNNINGHAM JOHN
	3881	(26)	COOPER LLOYD
	1782	(25)	COX EDW. S.
	2460	(19)	DAVERT CHAS.
	2361	(19)	DEAN NORMAN F.
	2643	(19)	DINGLER WM. H.
	2868	(31)	DEVINNEY JERRY O.
	2948	(31)	DURY CHAS. W.
	687	(31)	DYASSEN ELM.
	2691	(19)	DUNN CLARENCE T.
	2538	(19)	DEVENEAU CHAS.
	1859	(19)	DISS ROB'T. O.
	3918	(19)	DIETZ JOS.
	1680	(31)	EDINGER JAC. D.
	2822	(19)	ELLIOTT MILES W.
	2047	(31)	ELWERT WM.
	2257	(31)	ERNST EMIL V.
	1702	(31)	EUBANKS ROY.
	2318	(31)	EUTH C. K.
	1610	(31)	FALKENBERG ALB. J.
	571	(19)	FAITH ADAM
	3448	(31)	FEITH JOHN B.
	2065	(31)	FISHER C.

GRAVE	WAR	NAME
3032	(19)	FLATLEY THOM.
1448	(19)	FOSTER SAM B.
910	(19)	FRANKLIN SAM. S.
307	(19)	FUNK FREDR.
1543	(26)	FELDKAMP HARRY
804	(19)	GORDON SAM. J.
348	(19)	GRAY OLIVER P.
1267	(31)	GROB WM.
340	(31)	HARRET PETER
3003	[illegible]	HAUCK FREDR. J.
1907	[illegible]	HELMAN HARRY N.
2959	[illegible]	HENRY JOS. R.
1104	[illegible]	HEWITT WM. C.
2534	[illegible]	HILL JOHN D.
2268	[illegible]	HODGE JOHN E.
2796	[illegible]	HODGSON GEO. B.
1989	[illegible]	HOGSTEN FOREST F.
1426	[illegible]	HOFFMAN JOHN
828	[illegible]	HOPKINS CHAS. C.
2975	[illegible]	HOWELL GEO. W.
3005	[illegible]	HYMAN AARON
156	[illegible]	HENSON CLARENCE
16	[illegible]	HOTTEWITZ LOUIS
3086	[illegible]	HUTCHINS L. H.
3831	[illegible]	HUFFENDSAM GEO
1746	[illegible]	JACKSON ZAC'R. F.
2996	[illegible]	JOHN JOHN W.
3971	[illegible]	JOHNSON CHAS
1429	[illegible]	JONES PRICE J.
2862	[illegible]	JOHNSON FRANK
2364	[illegible]	JONES JOHN W.
3216	[illegible]	JONES WM R.
117	[illegible]	KEHREN THEO.
1896	[illegible]	KISSANE JON
582	[illegible]	KEMPER HENRY
1979	[illegible]	KOHNLE FRANK
1000	[illegible]	KUMMER JAS.
432	(19)	LOTS OTTO
119	[illegible]	LAYLAND WM G.
793	[illegible]	LEPERE FREDR
3787	[illegible]	LICHTENFELS JOHN A.
794	[illegible]	LIVINGSTON J. B.
1345	[illegible]	LLOYD GEO A
3625	[illegible]	LUCAS WM. E.
2356	[illegible]	LUCTON JAS
3739	[illegible]	LEYENDECKER FRED. M.
2480	[illegible]	LITTLEHALE FREDK L.
2978	[illegible]	MALINKOWSKI ART
2610	[illegible]	MALEY GEO. C.
2319	[illegible]	MARSH ALF.
922	[illegible]	MARTIN JOHN D.
2012	[illegible]	MAYER H. J.
2	[illegible]	MAYER JOHN L.
1239	[illegible]	MCALPIN ANDR.
1727	[illegible]	MCHEL GEO
3880	[illegible]	MILLER JOHN
1268	[illegible]	MORRIS CHAS. A.
2278	[illegible]	MORRIS EDWIN
2037	[illegible]	MOSER WILHELM
1704	[illegible]	MURDOCK TOM. A.
56	[illegible]	MURPHY ANDR.
89	[illegible]	MURPHY JUSTIN
1937	[illegible]	MURRAY WALT. T.

GRAVE	WAR	NAME
2273	(19)	McDONALD JERRY P.
115	(20)	MEYER C.
3155	(31)	MEYER FRANK
1880	(19)	MEYERS CHAS.
2080	(25)	MOELLER HERMAN O.
2137	(31)(25)	MULLINS JNO. H.
3958	(19)	NOEL WM.
460	(19)	NOLAN JOS.
1624	(19)	NUNN JOHN W.
2141	(31)	PETE GEO H.
800	(25)(31)	PEOPLES JAS. K.
1917	(19)	PARTHEMOS THEO.
845	(19)	PACEY JOHN
533	(25)	PINKERTON WM. D.
3065	(19)	PLYMESSER SAML.
745	(19)	PLATE E.
2357	(19)	PODESTA B.
3275	(19)	PRICE SMITH
2900	(31)	PROCTER S. J.
2586	(19)	RAISIG MARTIN
3417	(19)	RANDALL FRANK
2121	(31)	RANSOM JOHN E.
237	(19)	REAGIN REASON
2333	(19)	REED CHAS. D.
1191	(31)	REEL ELMER
130	(19)	RENGERING ANTHONY
2628	(19)(26)	RENO JUL.
1150	(19)	ROBERTS CHAS: E.
291	(19)	ROBERTS WM.
3699	(19)	ROBINSON THOM. J.
3172	(31)	RODENBERG RICH. L.
1326	(19)(31)	ROSS AL.
3684	(19)(31)	ROST GEO
2490	(19)(31)	ROWALT DAN. H.
1588	(19)(31)	ROBERTS EDW.
2611	(19)(31)	ROCKEL FRED'K. C.
1997	(25)(19)	RUMINGER JOHN.
2486	(19)	RUSSELL WM.
1462	(19)	RAMSDELL WM. C.
3175	(19)	SCHMIDT LOU.
2379	(19)	SCHOFIELD WM.
2111	(19)	SCHRAER ROBT. S.
2051	(19)	SHEA WALT. J.
2419	(19)	SMITH E. F.
3685	(19)(31)	SMITH HARRY
2447	(19)	SMITH HARRY E.
3026	(19)	SMITH JAS. S.
757	(19)	SNYDER HENRY
3910	(31)	STEINBECK ROBT. L.
2490	(19)	SULLIVAN GEO. D.
324	(19)(31)	SMITH GEO. W.
2264	(31)	SMITH WM H.
2109	(31)	TATE HERB.
652	(19)	TAYLOR SAM. L.
1152	(19)	THOMPSON JOHN
916	(19)	THOMPSON GEO
2668	(19)	THOMPSON WALT.
714	(19)	TOZZER FRANK
437	(19)	TRAINER JOHN
3190	(31)	TUCH SAM.
3295	(19)	TURNPAUGH JOS. H.

GRAVE	WAR	NAME
1490	(19)	UPP JESS. M.
2791	(31)	UPTON U. W.
1174	(19)	VANCE JAS. W.
1289	(19)	VICKKOY WM.
2159	(19)	VOGELSANE BERNARD
1734	(33)(25)	VAN ZANT CALVIN
2606	(25)	VESPER HENRY
2577	(31)	WATKINS CLARENCE L.
3418	(31)	WARNER CHAS.
512	(19)	WEAVER JAC.
2064	(31)	WEIL CLINT. O.
2956	(31)	WEIL EDW. F.
3219	(19)	WHEELER CHAS. C.
1991	(31)	WILLIAMS CHAS. B.
657	(19)	WILLIAMS JOS.
1952	(19)	WINALL JAS. W.
1588	(19)	WOOD JOHN
1129	(19)	WOOD JAS. C.
3546	(19)	WRENCH WM. D.
1819	(31)	WURTZ FRED.
253	(19)	WRENN WM.
734	(19)	WILLIAMS WM. (PAT. ALIAS J. MACOY)
3535	(19)	WELLS ABRAHAM
3762	(19)	WHITMAN DAN'L. E.
3996	(33)	WILSON JAS. P.

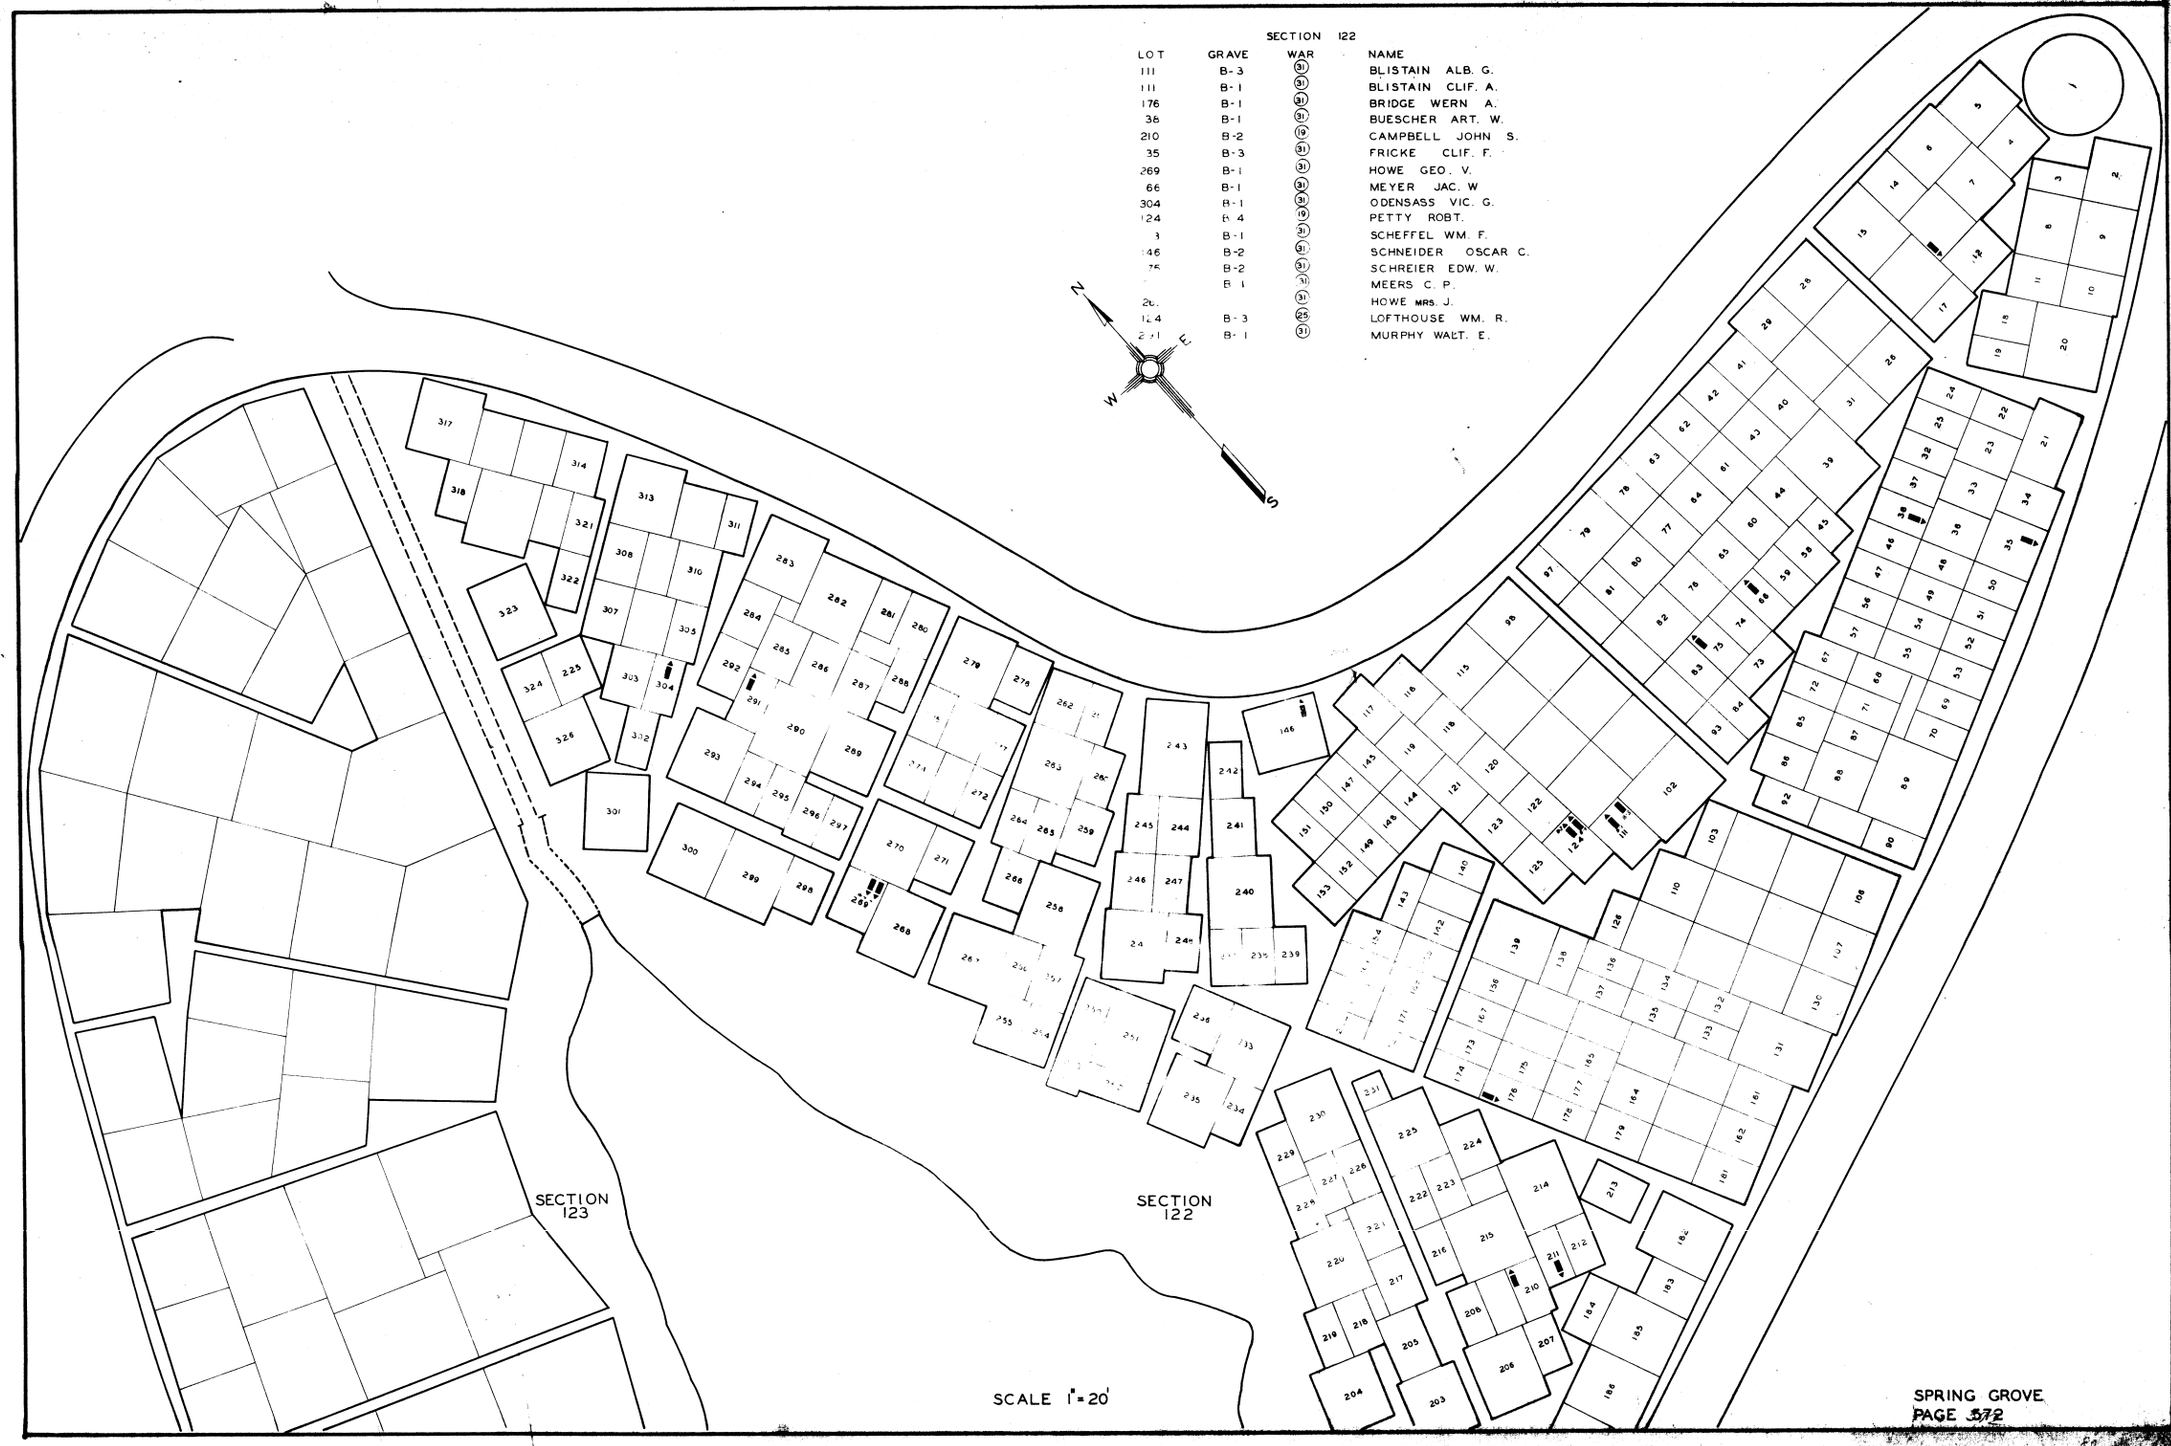
SECTION 122
LOT GRAVE WAR NAME
111 B-3 (31) BLISTAIN ALB. G.
111 B-1 (31) BLISTAIN CLIF. A.
176 B-1 (31) BRIDGE WERN A.
38 B-1 (31) BUESCHER ART. W.
210 B-2 (19) CAMPBELL JOHN S.
35 B-3 (31) FRICKE CLIF. F.
269 B-1 (31) HOWE GEO. V.
66 B-1 (31) MEYER JAC. W
304 B-1 (31) ODENSASS VIC. G.
124 B-4 (19) PETTY ROBT.
3 B-1 (31) SCHEFFEL WM. F.
146 B-2 (31) SCHNEIDER OSCAR C.
75 B-2 (31) SCHREIER EDW. W.
B-1 (31) MEERS C. P.
(31) HOWE MRS. J.
124 B-3 (25) LOFTHOUSE WM. R.
241 B-1 (31) MURPHY WALT. E.
N
E
W
S
SECTION 123
SECTION 122
SCALE 1"=20'
SPRING GROVE
PAGE 372

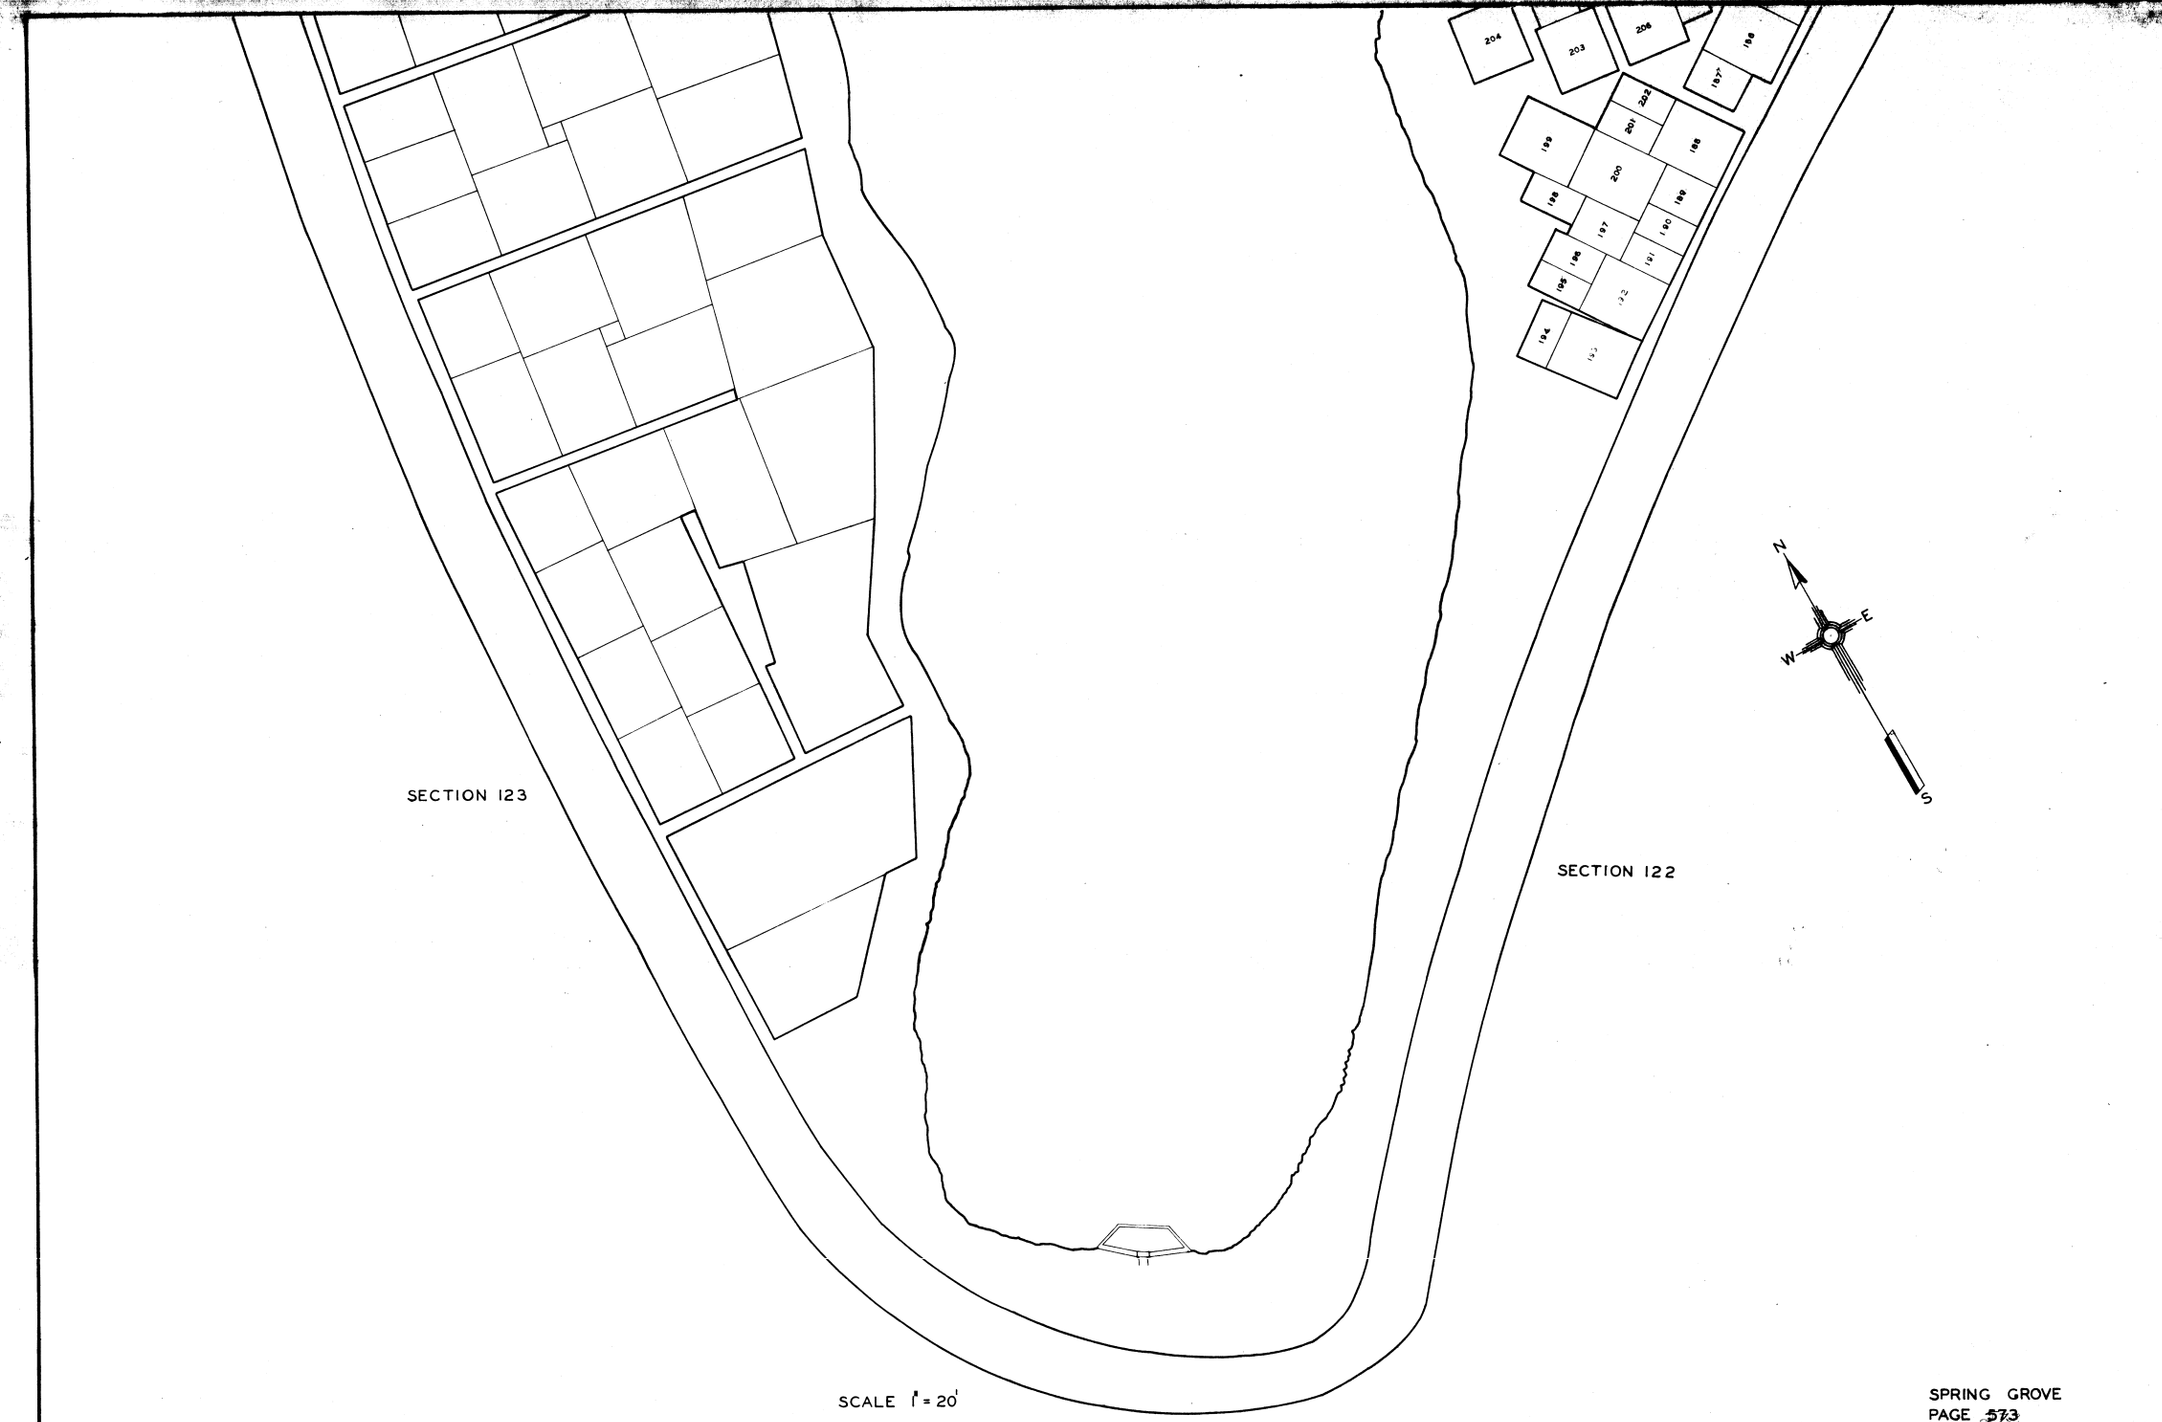
SECTION 123
SECTION 122
N
E
W
S
SCALE 1" = 20'
SPRING GROVE
PAGE 573

LOT	GRAVE	WAR	NAME
443	B-1	(31)	BAXTER ERNST H.
356	B-1	(31)	BERTING HENRY H.
355	B-1	(31)	FOX ALLEN J.
160	B-1	(31)	HAMER STAN.
367	B-3	(31)	HENRIE M. E.
442	B-1	(31)	HERBES FRANK
180	B-2	(31)	LYONS JAS. H.

LOT	GRAVE	WAR	NAME
84	B-4	(19)	MILLER CHAS. A.
147	B-1	(31)	MINION CARL F.
299	B-1	(31)	MOERLEIN WM. C.
127	B-2	(31)	RYBOLT GEO. E.
274	B-2	(31)	SCHWAAB WALT. W.
141	B-3	(31)	WARD WM. C.
428	B-1	(31)	WEIGEL WM.
381	B-2	(31)	WILKS WOODWARD
283	B-1	(26)	AUSTIN MAURICE C.
39	B-1	(31)	BOWSHER IVAN P.
367	B-2	(19)	HENRY THOS. P.
10	B-1	(26)	STOLL HENRY
102	B-1	(31)	MOHR RAY. F.



SCALE 1"=20'

SPRING GROVE
PAGE 574



LOT	GRAVE	WAR	NAME
422	B-1	(19)	BURT EVERETT W.
53	B-2	(19)	HOWELL GEO. S.
20	B-1	(19)	MATTHEWS JOHN W.
347	B-1	(19)	PATTERSON SYLVIA
343	B-1	(25)	RAIN FRED
56	B-3	(19)	REMLEY RALPH. M.
415	B-1	(19)	SCHROEDER WALT.
488	B-1	(19)	SIMPSON LEONARD
286	B-1	(19)	TOWE ALLEN G.
492	B-1	(31)	GASTON RAY. E.
54	B-1	(31)	DOM WAL'T. E.
278	B-2	(33)	BAUER JOHN

SCALE 1" = 20'

SPRING GROVE
PAGE 575

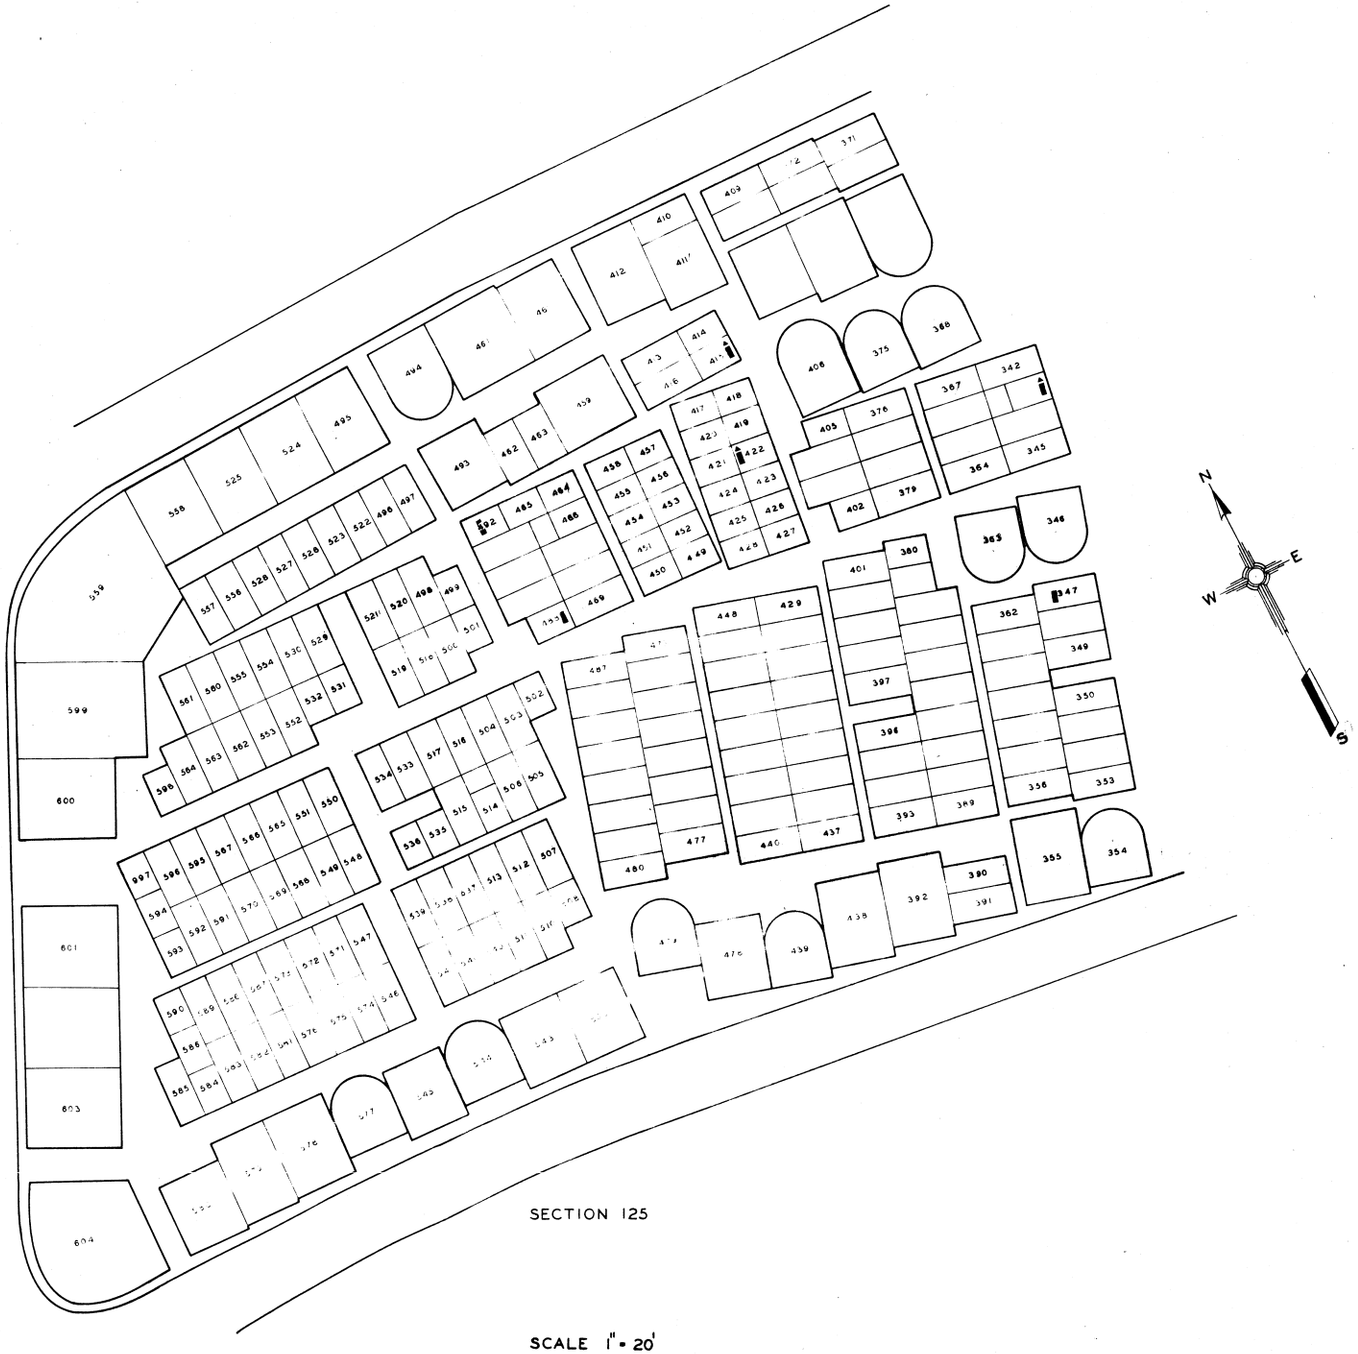

SECTION 125

SCALE 1" = 20'

SPRING GROVE
PAGE 376



LOT	GRAVE	WAR	NAME
179	B-1	(31)	MEYER EDWIN J
4-B	B-1	(31)	LAYMAN KIRBY E
9-C	B-1	(31)	NONA HOWARD R.
3-D	B-1	(31)	GOEBEL GEO A
4-J		(25) (31)	STEVENSON JOS. W.

SECTION- 126
SCALE 1"-20'

SPRING GROVE
PAGE 5777

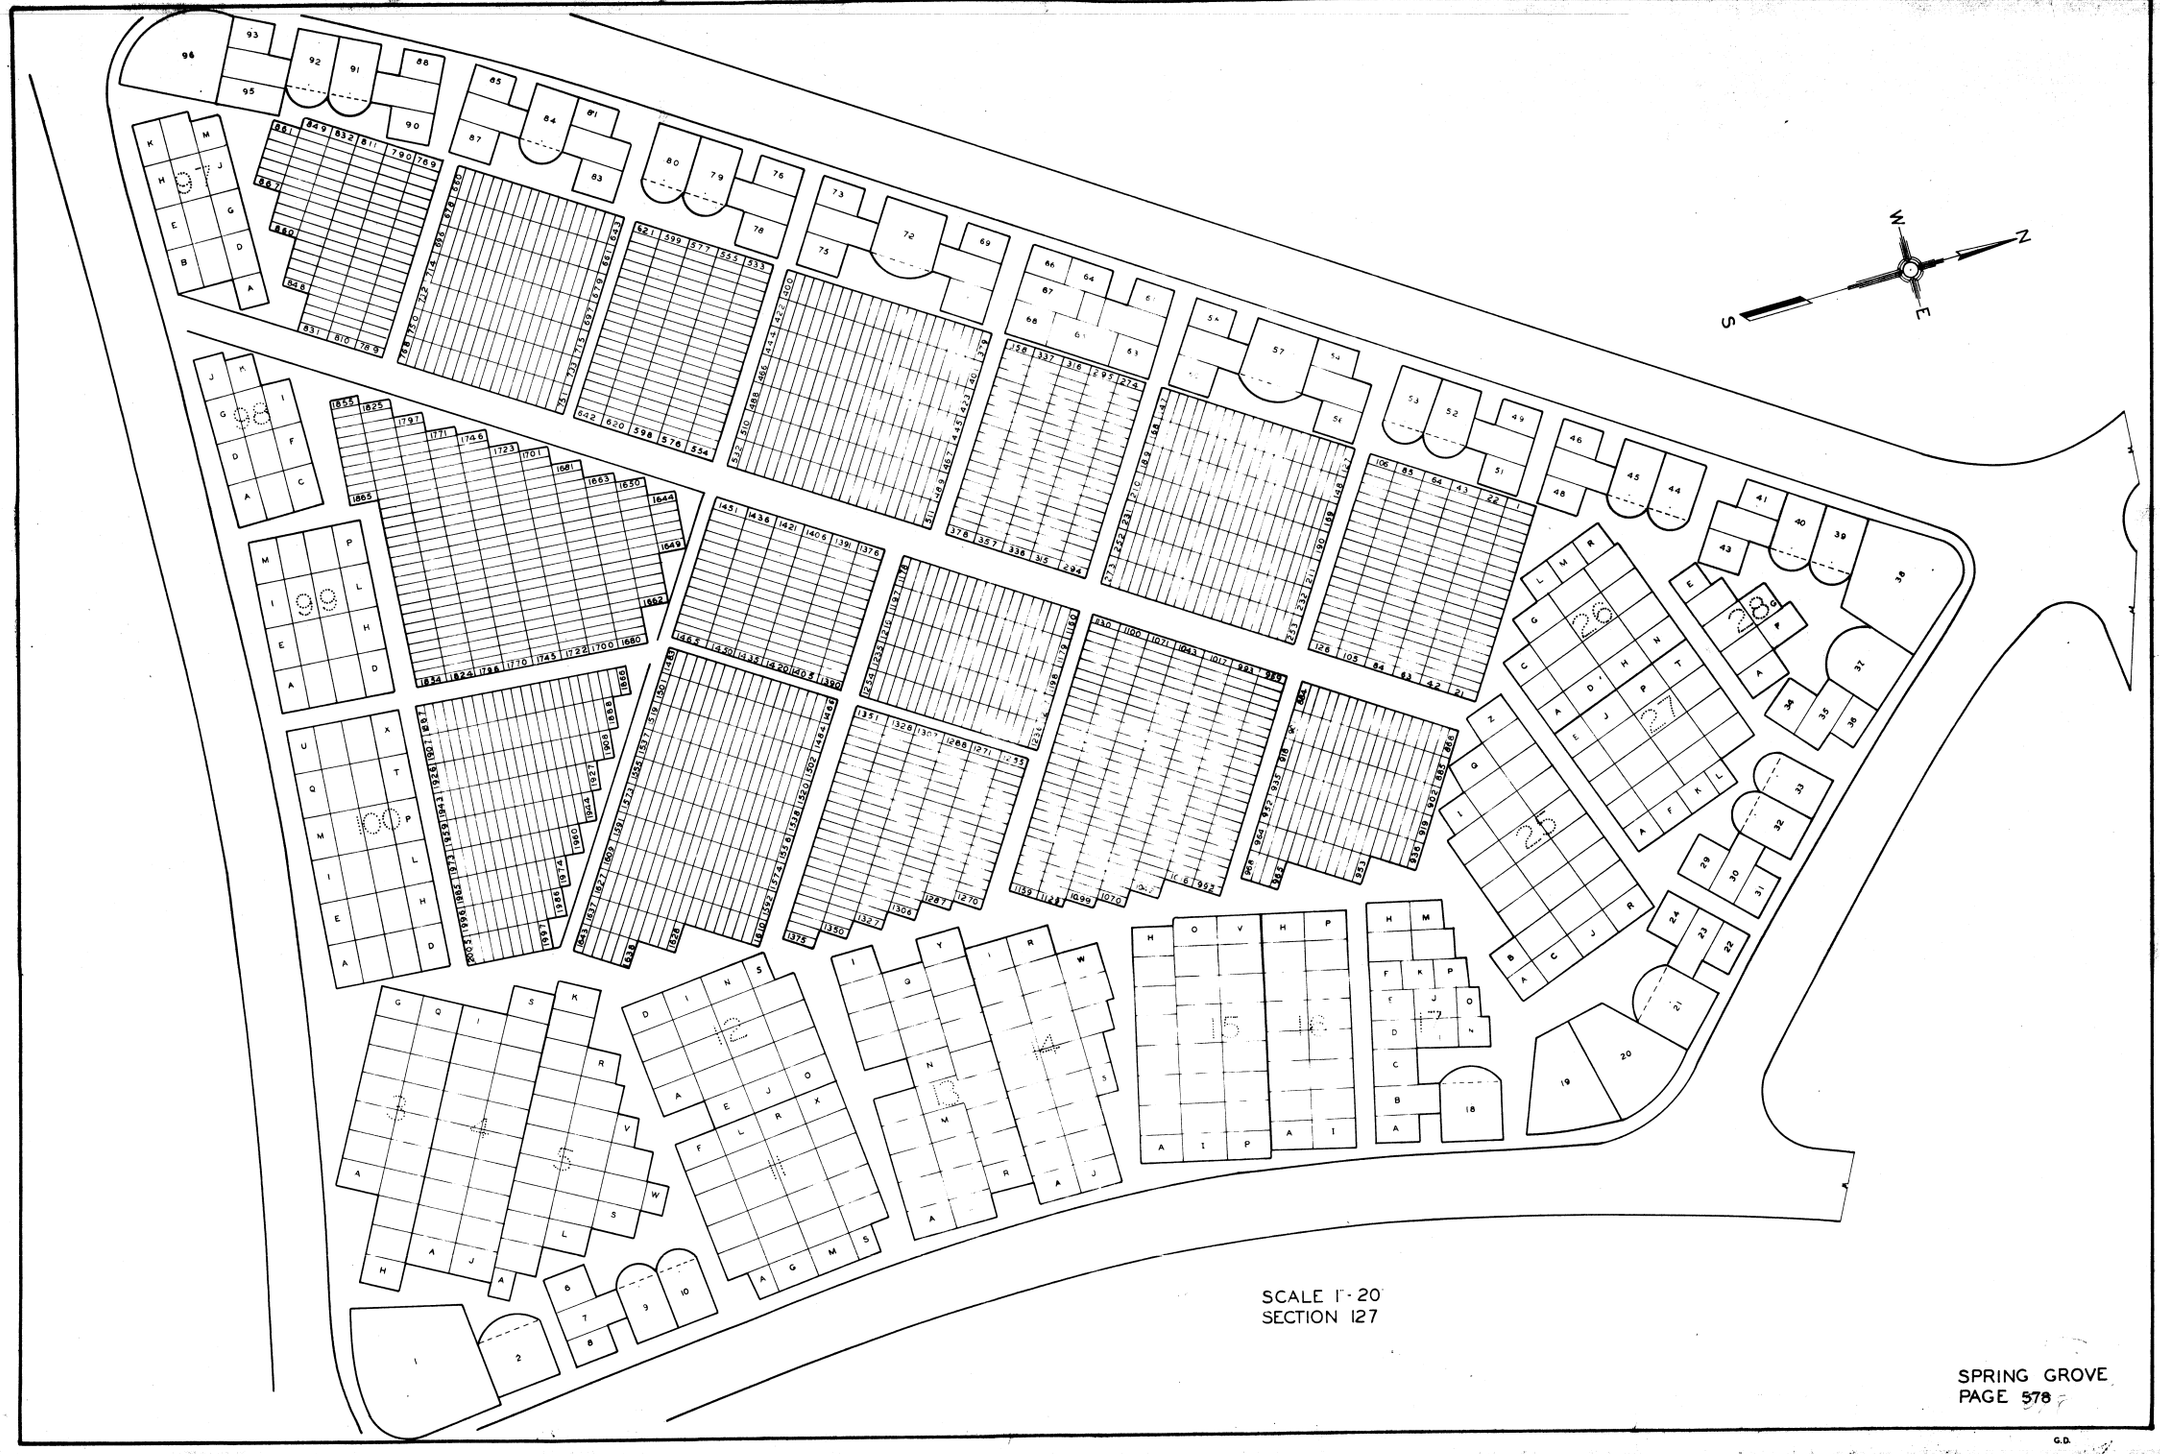
SCALE 1"-20'
SECTION 127
SPRING GROVE
PAGE 578

GRAVE	WAR	NAME
336	31	ART ANDREW H.
B1673	31	ALHAND LESTER
2584	25	ADAMS JOHN
1474	31	BAKER HENRY A
979	31	BATCHER AUGUST
1934	31	BHSCHLE THEO. F.
1697	31	BOLSER ALBERT J.
342	33	BREWER OSCAR
2136	31	BOSSE ERV. C.
903	31	BUEHRIE ADOLPH
2545	31	CALDWELL THOMAS
1806	31	CANN WM. P.
1912	25	CLEAVE LEE
368	31	COWAN LESTER
2199	31	CLARK CHRIS. J.
1245	33	COLBURN THAD. J.
2293	31	DOWNES FRANKLIN J.
2241	31	DUGAN CHESTER B.
1709	31	EDER ART.
630	19	EVANS CHARLEA
1222	31	FLEISCH ANDRE G.
2020	31	FRANKHAUS HARRY W.
1881	31	GATH PHIL.
2389	31	HAIGH FRANK A.
1150	31	HALDEMAN HARRY E.
103	31	HEMLER HARRY B.
753	25	HENN CHARLES M.
1647	31	HUGHES DEWEY
1038	31	HESS FRANK
2660	31	KNOST FRED.
1618	31	KESSEN JOS. H.
1479	31	KOZOROWSKI JOS. (ALIAS JOS. RYAN)
2603	31	LANSDALE RICHARD A.
1875	33	LINTON WALT.
552	31	MARHALL CLARENCE
2068	25	MEDECKE JOHN E.
827	25	MEEKS WM. L.
489	31	MERRYMAN RALPH E.
203	31	MILLER WALTER J.
515	31	MORRIS GEO.
2065	33	PUFALL ROBT.
1139	31	ROBERTS CLIFFORD J.
634	31	RUBENOW ERNEST.
467	31	RUCK OSCAR W.
2465	31	SCHWEITZER WM.
2245	31	SIEVERLING, CHAS. E.
1516	31	SONNTAG HENRY
425	25	STEWART HARRY
380	25	SIMON WM.
873	25	SMITH WM.
471	31	TAYLOR DAVID
875	25	TENNYSON JACOB
254	31	TOWLES CLAUDE
	25	TEBBENHOFF JOHN W.
633	31	WELLER ALBERT
1079	31	WILLIAMS CLIFFORD
141	19	WOLF THOMAS
1589	31	WORMUS GEO. J.
992	31	WUERTH ERNEST E.
2555	33	BRADLY WM. G.
648	25	SOKUP HERMAN J.
2324	25	ERWIN GEO
1685	31	LAMPE WESLEY M.
2444	25	SCHWAB C. F.
909	31	PATTERSON FRANK MD
2314	31	SHAFER WM. A.
725	33	TORRENCE RAY. H.

GRAY ROAD

NORTHEASTERN AVE.

SECTION "A"

SCALE 1"=20'

SPRING GROVE
PAGE 579

GRAVE	WAR	NAME
	SEC. - B	
268	(31)	BOYCE GEO. W.
35	(28)	GOEDDEL ALB. J.

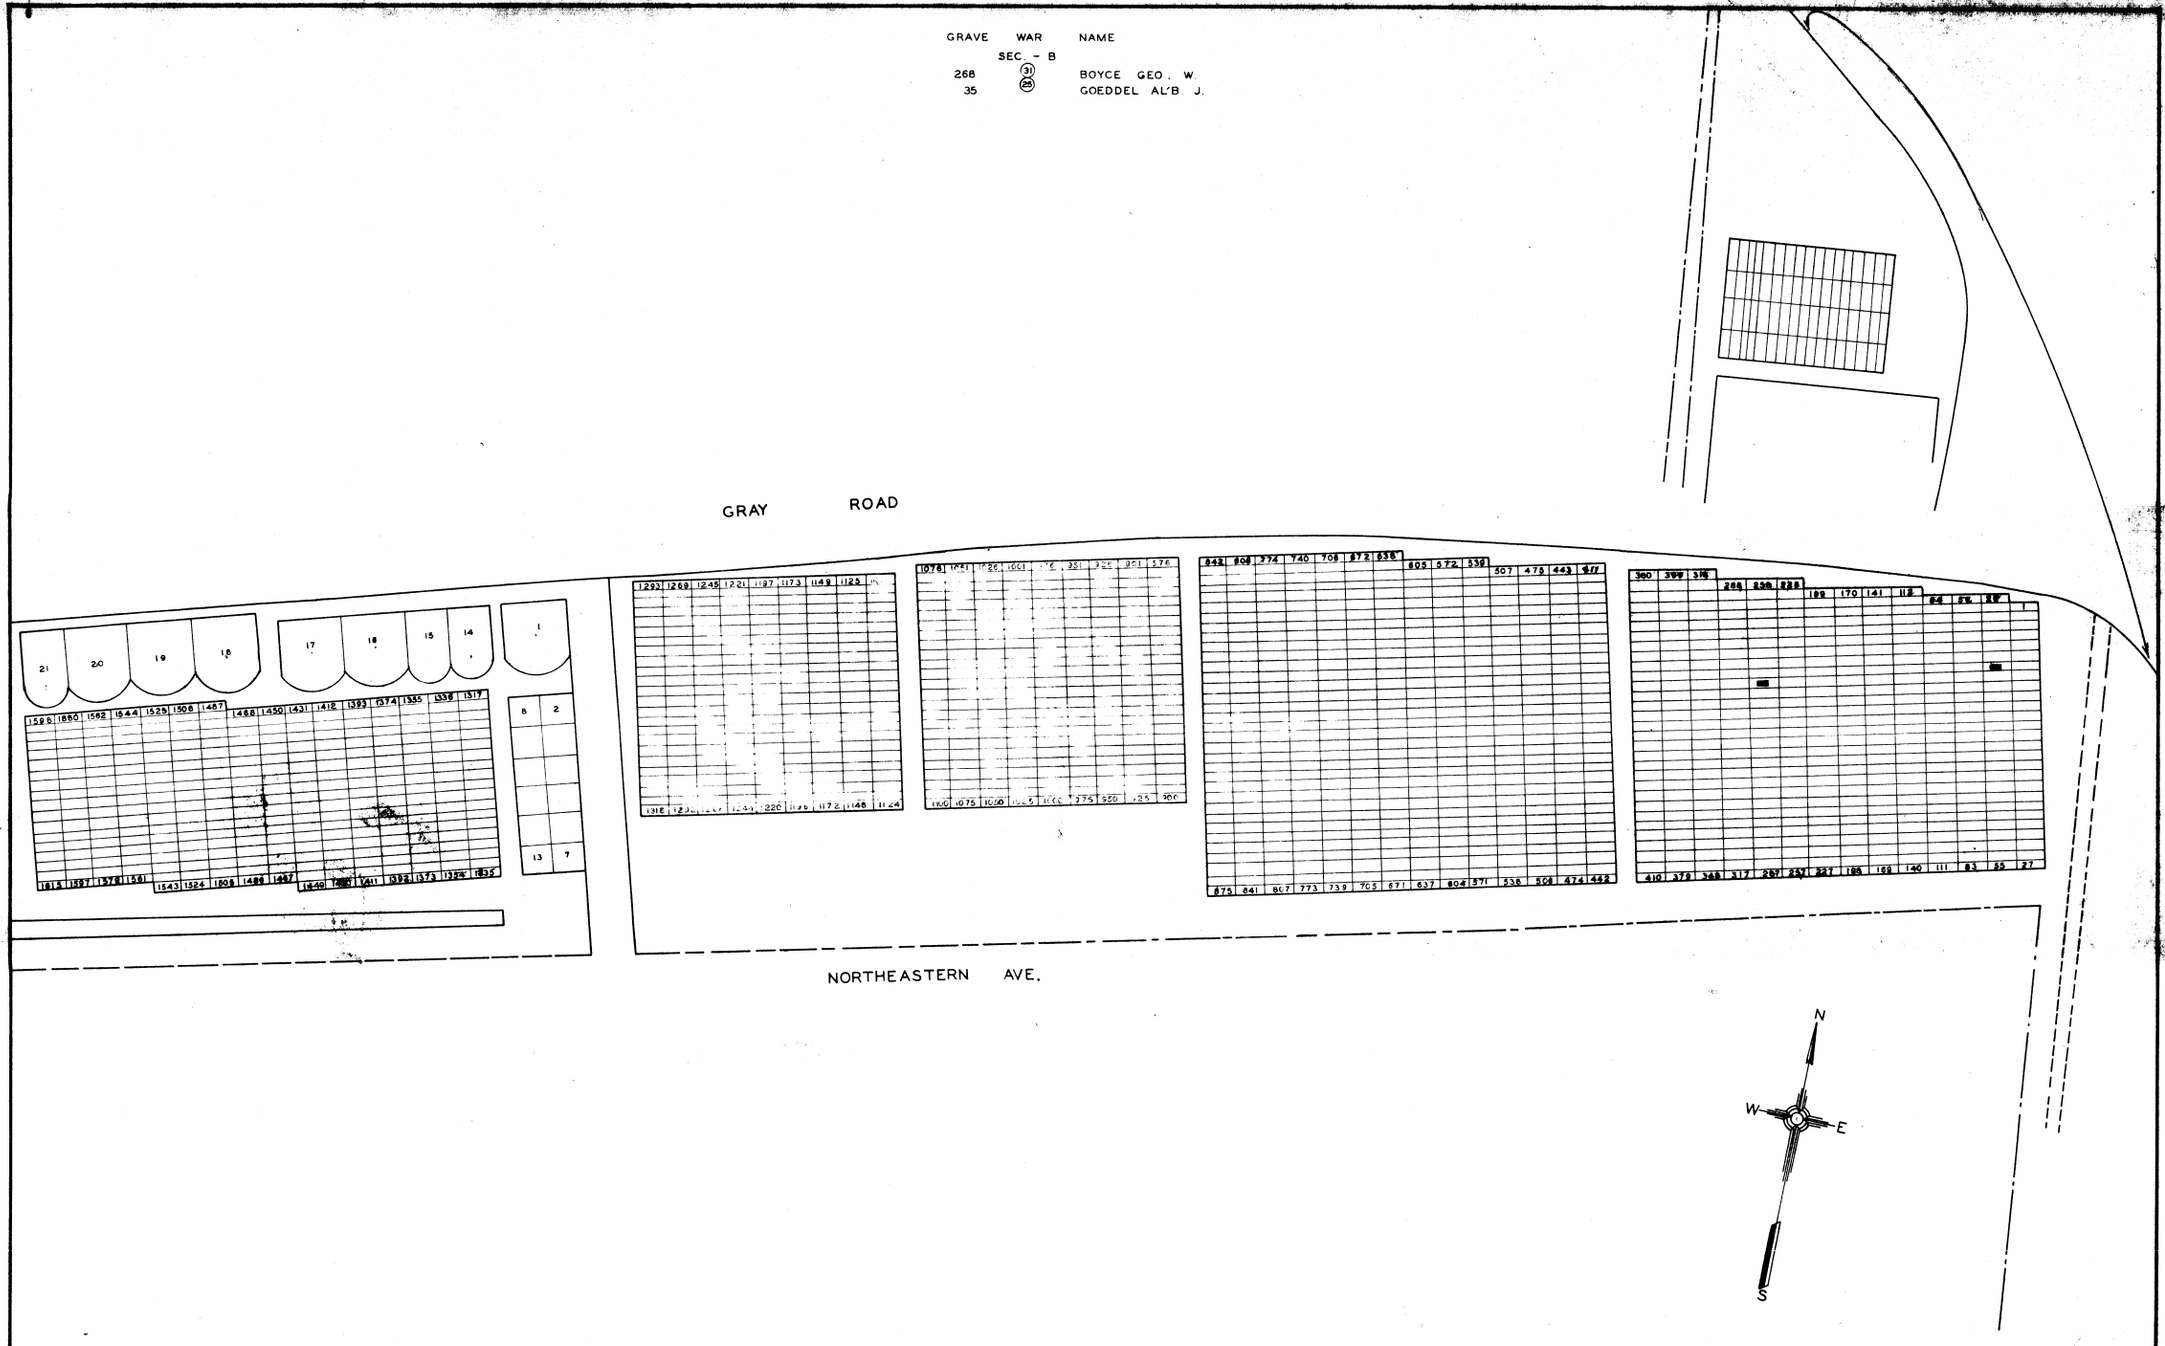

SCALE 1" = 20'

SPRING GROVE
PAGE 58082

VETERANS' BURIALS IN HAMILTON COUNTY
LOCATION OF GRAVE UNKNOWN
VERIFIED BY ROSTERS OR HISTORIES

WAR	NAME	
1	ALSTON THOMAS	BURIED IN READING O.
1	BAXTER SCHUYLER	BURIED NEAR BLUFF AT MOUTH OF DEER CREEK.
1	BELL JOHN	BURIED ON FARM AT MONTGOMERY O.
1	BOWEN THOMAS	BURIED ON FARM NEAR PLEASANT RIDGE, O.
1	BROADWELL JACOB	BURIED ON HAMILTON COUNTY LINE
1	BUCKINGHAM LEVI	BURIED IN REMINGTON CEMETERY
1	CAMERON ALEXANDER	BURIED NEAR MONTGOMERY, O.
1	CHARLTON JOHN	BURIED AT NEWTOWN, O.
1	CLARK DANIEL	BURIED IN PIONEER CEMETERY
1	CLARK GEORGE	BURIED IN CINCINNATI, O.
1	COVALT ABRAHAM	BURIED ON FATHER'S FARM, AT FORT COVALT, NEAR MILFORD, O.
1	COX JAMES	BURIED IN COLUMBIA CEMETERY
1	COX TUNIS	BURIED IN PIONEER CEMETERY
1	CUNNINGHAM JAMES	BURIED ON FARM ONE MILE FROM READING O
1	EATON ALEXANDER	BURIED ON FARM AT CLEVES, O.
1	EBERSOLE SOLOMON	BURIED AT COLUMBIA, O.
1	FELTER ISAAC	BURIED IN MONTGOMERY, O.
1	FELTER MATTHIAS	BURIED NEAR MT. CARMEL
1	FERGUSON WILLIAM	KILLED BY INDIANS NEAR FT. RECOVERY, O.
1	GOLDTRAP JOHN	BURIED NEAR READING O.
1	GUEST MOSES	GRAVE LOCATED IN WASHINGTON PARK CINTI, O

WAR	NAME	
1	HARRIS JOSEPH	BURIED ON SONS FARM LOCATED ON COMPTON ROAD- GRAVE NOW OBLITERATED
1	HIGGINS JOHN	BURIED IN READING, O.
1	HOSBROOK JOHN	BURIED ON THE HOSBROOK FARM AT MADEIRA, O.
1	KENNEDY FRANCIS	BURIED UNDER THE FIRST PRESBYTERIAN CHURCH, BODY- WAS NEVER REMOVED
1	KITCHELL MOSES	BURIED UNDER THE FIRST PRESBYTERIAN CHURCH
1	McCRACKIN WILLIAM	BURIED BY BLOCK HOUSE OPPOSITE THE MOUTH OF THE LICKING RIVER.
1	NICHOLS FRANCIS	BURIED AT PLAINFIELD AND COOPER ROADS
	NORRIS BETHUEL	BURIED IN OLD PRESBYTERIAN CEMETERY ADJOINING HIS- PROPERTY 2MI W OF THE S.E. CORNER OF BUTLER COUNTY
1	PHELPS ABIJAH	BURIED IN SYCAMORE TWP.
3	PALFREY G	BURIED 1-4 MI. N. OF THE OHIO RIVER & 1 1-2 MI. E. OF GREAT MIAMI R.
1	PITMAN JONATHAN	BURIED ON FARM NEAR READING, O.
1	ROSS JOSEPH	BURIED AT THE M.E. CEMETERY MADISONVILLE O
1	RUDE ZELAH	BURIED ON HIS FARM RANGE SEC 33 SYMMES TWP NEAR- REMINGTON, O.
1	RYNIERSON JOHN	BURIED IN READING, O.
1	SAYRE EZEKIEL	BURIED IN READING, O.
1	SKILLMAN JACOB	BURIED ON SKILLMAN FARM SPRINGFIELD TWP. STONE MARKER- S STILL STANDING

WAR	NAME	
1	SMITH BALLARD	BURIED AT FORT WASHINGTON, O
1	SPRINGER JACOB	BURIED NEAR MT. WASHINGTON, O
1	STOUT ANDREW	BURIED IN COLERAIN TWP.
1	TUCKER JOHN	BURIED IN SPRINGFIELD TWP.
1	VAN VOORHEES ABRAHAM SR.	BURIED ON FARM WHOSE SITE IS- NOW LOCKLAND, O.
1	VOORHEES MINUE	BURIED IN READING, O.
1	WARD JOSEPH	BURIED AT FOOT OF NORTH INDIAN HILL MADI- SONVILLE CINCINNATI, O.
1	WELLER LODOWICK	BURIED IN MONTGOMERY, O

VETERANS' BURIALS IN HAMILTON COUNTY
LOCATION OF GRAVE UNKNOWN
VERIFIED BY ROSTERS OR HISTORIES

WAR	NAME
1	ANDREW JOHN
31	BAKER GEORGE D.
1	BACH JUDAH
1	BABBS JOHN
1	BALDWIN ELEAZER
1	BARTLE JOHN
1	BIGHAM WILLIAM
1	BONNELL JAMES
1	BOSS ADAM
3	BOWMAN GEORGE
1	BRASHER JOHN
1	BREWSTER WILLIAM
1	BROACHER HENRY
1	BROWN WILLIAM
1	BROWN WILLIAM
1	BRUEN JABEZ
1	BRYSON JAMES
1	BUELL EPHRAIM
1	BURNHAM JOHN
1	BURROWS JEREMIAH
1	CALDWELL ROBERT
1	CHILDERS MOSBY
1	CLARK DENNIS
1	CLARK NATHANIEL
1	CAMPBELL JOHN
1	CAMPBELL WILLIAM
1	CARLE JOHN
1	CAVENDER JOHN
1	COKE PHILP
16	COOPER JOHN H.
1	CRANE CALEB
1	COX ANDREW
1	CRANMER JOHN
1	CRARY JOHN
1	CUTTER JOHN
1	CUTTER SETH
1	DAVIS DANIEL
31	DAVIS GEORGE
31	DAVIS WILLIAM
25	DELANO FRANK
1	DEATS HENRY
1	DELZELL WILLIAM
1	DOUGLAS JAMES
1	DRAKE JOSEPH
1	DOWNS JESSE
1	DOUGLASS RANDALL
1	DRAKE JOSHUA
1	DRYDEN WILLIAM
1	DUGAN HENRY
1	DUNN ABNER M.
1	DUNN DUNCAN

WAR	NAME
1	EMEMS JOHN
1	ENGART BENJAMIN
1	FAULKNER ROBERT
1	FENTON SOLOMON
1	FERGUSON JOHN
1	FERGUSON JAMES
1	FILSON JOHN
1	FINDLEY ROBERT W.
1	FLINN BENJAMIN
1	FLINT HEZEKIAH
1	FOSTER ASA
1	GAGE REUBEN
1	GANNON WILLIAM
1	GLOYD ASA
1	GOFORTH WILLIAM
1	GRANT WILLIAM
1	GRAY JAMES 2ND
1	GREEN JOEL
1	GREEN CHARLES
1	GRIFFIN DANIEL
1	GRIFFIN ROBERT
1	GUNSALUS HENRY
1	GWINNUP GEORGE
1	HALSEY JOSEPH JR.
1	HALSTEAD JOHN
1	HAMILTON JOHN
1	HAMOND JOHN
1	HAGEMAN ADRIAN
1	HAHN MICHAEL
1	HARNER JAMES
16	HARRIS JOHN
1	HARRIS WILLIAM
1	HARTHORN JAMES
1	HARVEY ALA
1	HARVEY EDWARD
1	HATHORN JAMES
1	HAYS OLIVER
1	HICKS DURFEE
1	HILLYER JAMES
1	HIPSHER ANDERSON
1	HOLDEN RICHARD S
1	HOWARD SOLOMON
1	HOWELL SILAS
1	HUBBELL GERSHOM
1	HUDDLESTON THOMAS
1	HUDSON JOHN
1	INGALLS ISRAEL

WAR	NAME
1	ISHAM GEORGE
1	JACKSON MATTHEW
1	KELLY WILLIAM
1	KELSIMERE FRANCIS
1	KERR JOHN
1	LACY THOMAS
1	LAFLER JOHN
1	LEIBY GEORGE
1	LEMON ALEX
1	LEMOND WILLIAM
1	LEMMING SAMUEL
1	LEMRICK PATRICK
1	LEWIS ISAAC
1	LIVINGSTON DAVID
1	LOAR HENRY
1	LOGAN JOHN
1	LOVE HENRY
1	LOWE DERRICK
1	LYNCH PETER
1	MADDOCK MOSES
1	MARSH JOHN
1	MARTIN OLIVER
1	MATSON JOHN
1	MCCRACKIN CYRUS
1	MCCULLOUGH ROBERT
1	MCKNIGHT DAVID
1	MILLER EDWARD
1	MORGAN JACOB
1	MORRIS JACOB
1	MORRIS JOHN
1	MOSS DANIEL
1	PACK WILLIAM
1	PARMETTER ABRAHAM
1	PARKER JOHN
1	PARSONS OSBORN
1	PECK WILLIAM
1	PIERCE SAMUEL
1	PIERSON ABRAHAM
1	PIERSON DAVID
1	PIERSON MATTHIAS
1	POSEY ZEPHANIAN
1	PRESTON ABIAH

WAR	NAME
1	PURVIANCE SAMUEL
19	PHILLIPS HORACE
1	REEDER JACOB
1	REEDER STEPHEN
1	REEDER WILLIAM
1	REYNOLDS JUSTUS
1	RICHARDSON JACOB
1	RICHARDSON JOHN
1	RICKETTS WILLIAM
1	RIGGS BETHUEL
1	ROBINSON JOHN
1	ROSS REUBEN
1	SEWARD DANIEL
1	SHEPHERD ELISHA
1	SHERMAN EZRA
1	SHIPMAN JOHN
1	SILVER JOHN
1	SKEEL NATHAN
1	SLAYBACK WILLIAM
1	SMILEY JOHN
1	SMITH ABRAHAM
25	SMITH CHARLES
1	SMITH NATHAN
1	SMITH PHILLIP D.
1	SMITH WILLIAM
1	STACY THOMAS
1	STARR RICHARD
1	ST. JOHN JOHN
1	STEPHENS NICHOLAS
1	STONE CHARLES
1	STRONG BARNABAS
1	STRONG DAVID
1	STURGIS JEDEDIAH
1	SULLIVAN PATRICK
1	TIBBETTS ISAAC
1	TICHINOR JONATHAN
1	TUCKER WILLIAM
1	TURNER JOHN B.
1	VOORHEES STEPHEN
1	VOORHEES ABRAHAM JR.

WAR	NAME
19	WAGNER CHARLES
1	WALKER CHRISTOPHER
1	WALLACE WILLIAM
1	WARD AMOS
1	WARING JONATHAN
1	WHELLER STEPHEN
1	WELLER WILLIAM
1	WHITCOMB ANTHONY
1	WHITE THOMAS
1	WHITE WILLIAM
1	WILLIAMS BENJAMIN
1	WILLIAMS MILES
1	WILLIAMS THOMAS
1	WILLIAMSON JOSEPH
1	WILLYARD HENRY
1	WOOD EBENEZER
1	WOOD LEVI
1	WOOD ISRAEL
1	WORTHINGTON WILLIAM